


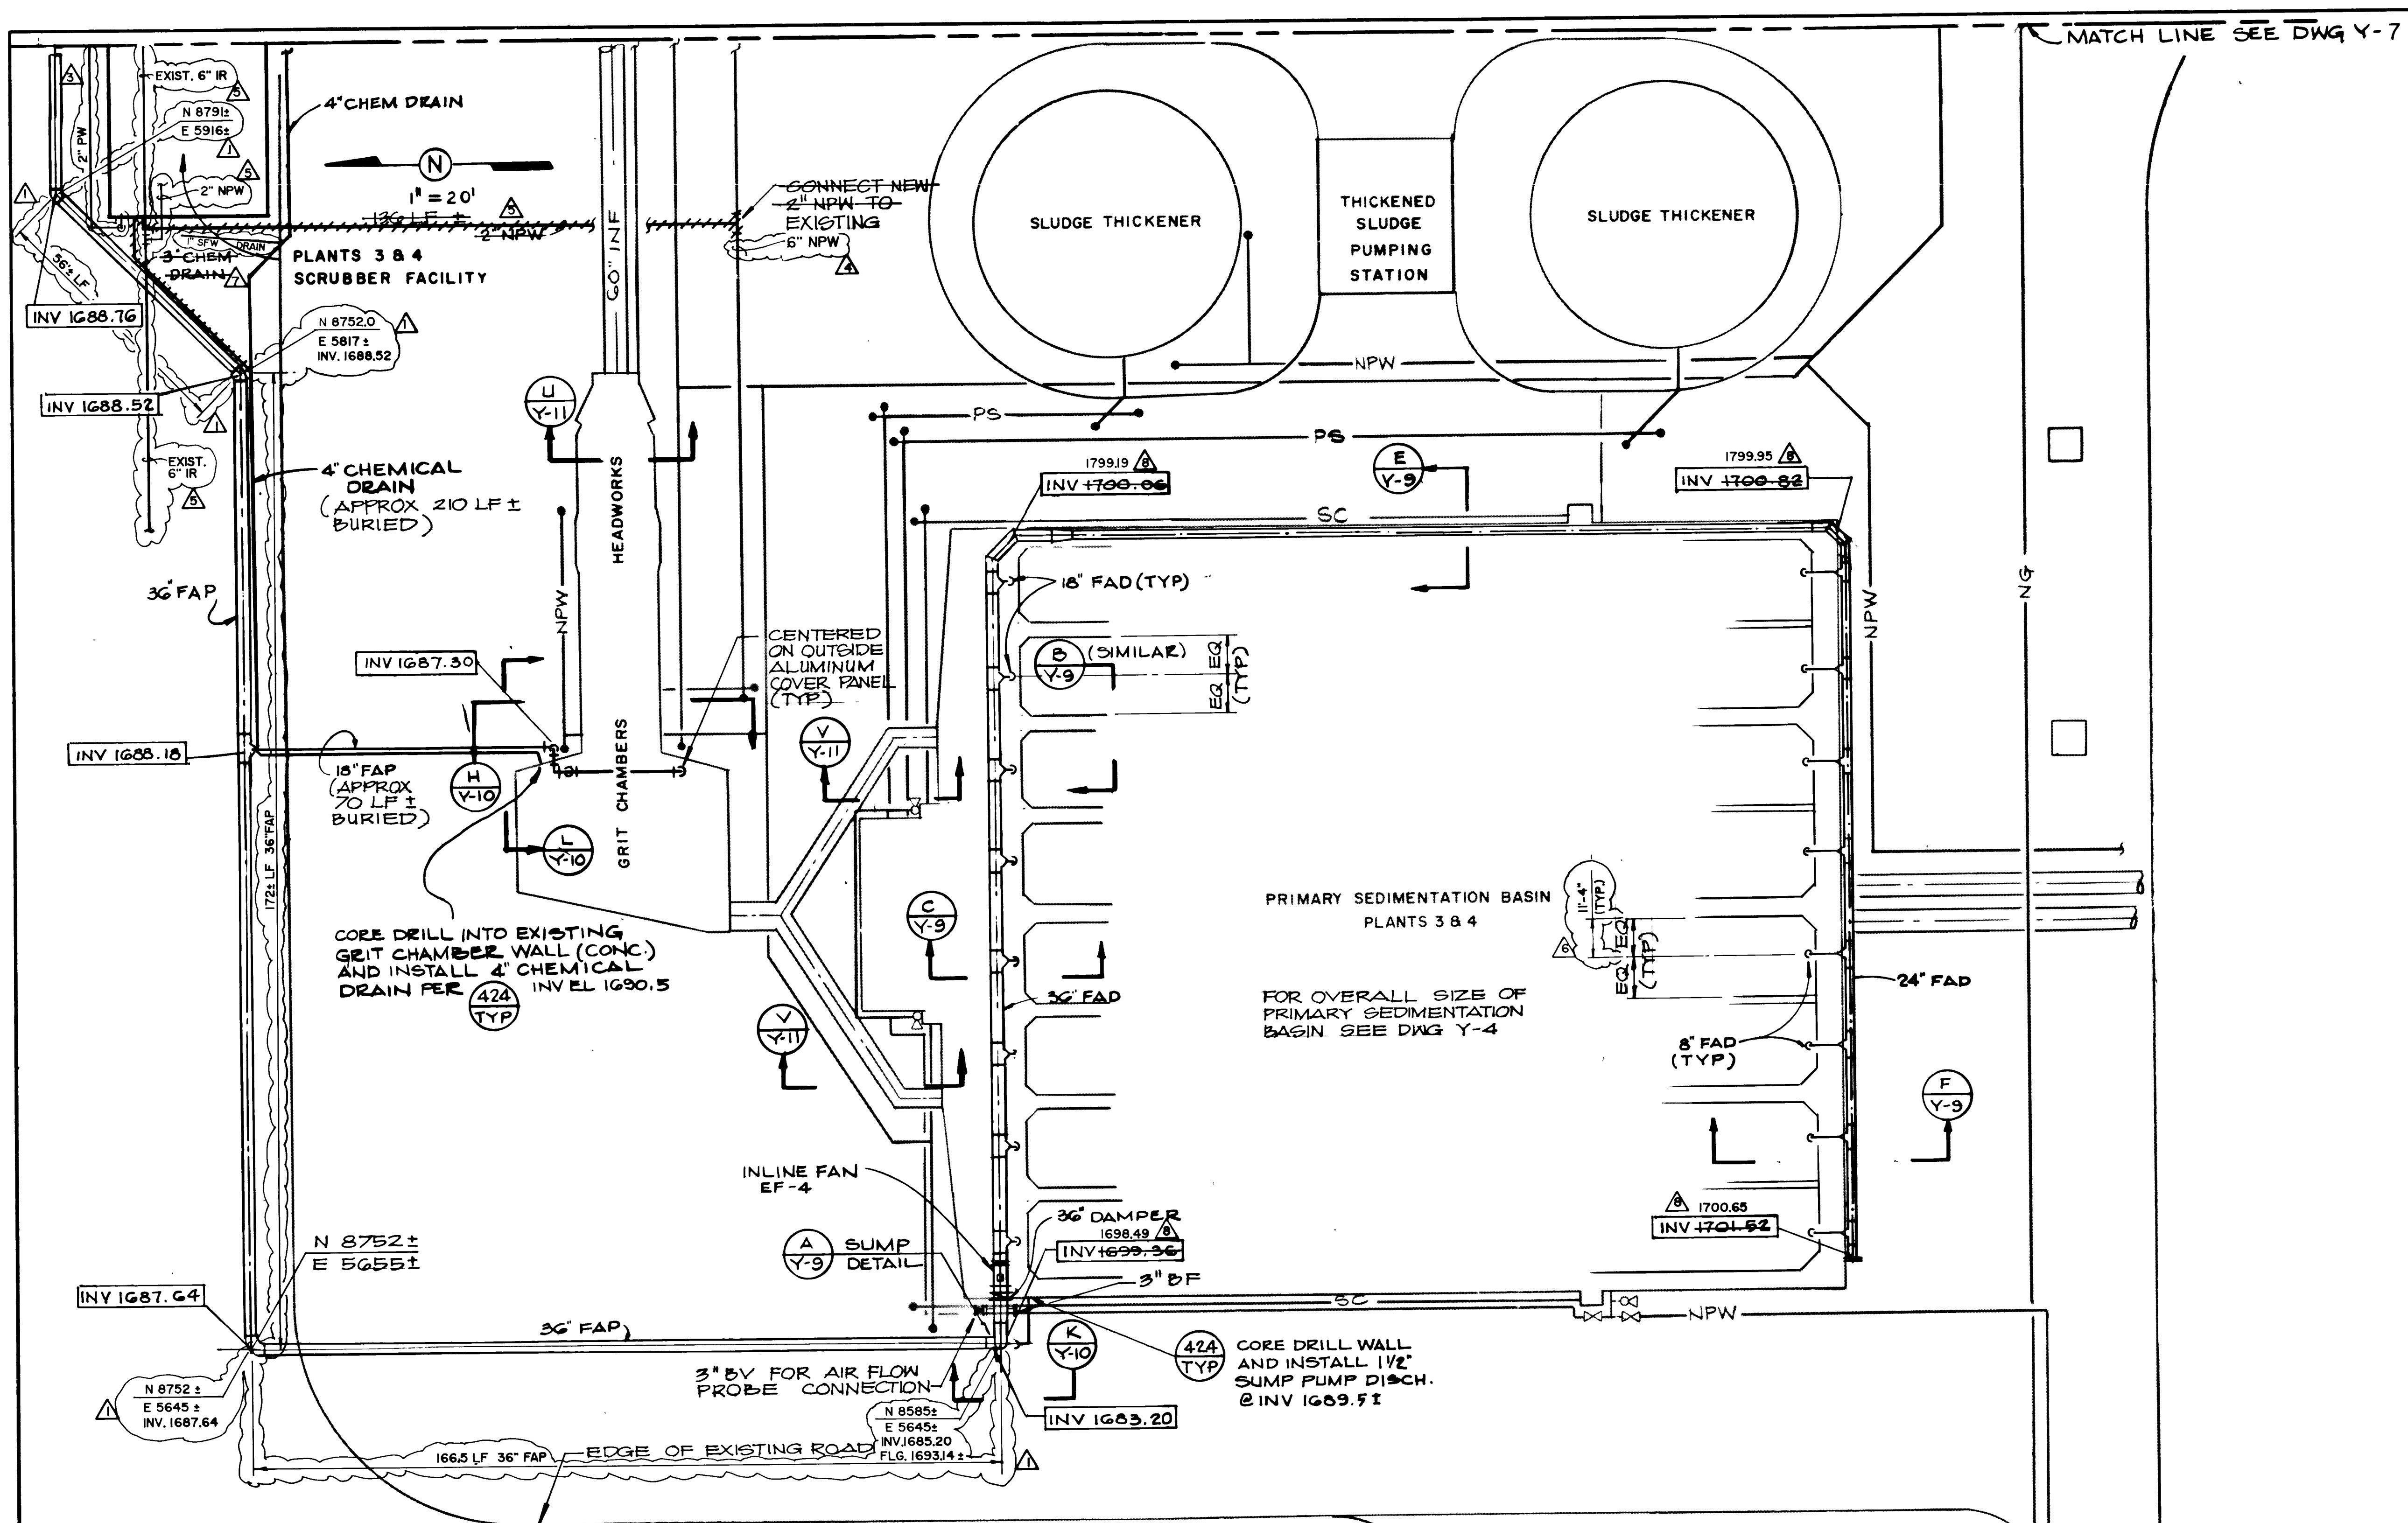

RECORD DRAWING

THESE RECORD DRAWINGS HAVE BEEN PREPARED BASED ON PARTIAL INFORMATION PROVIDED BY OTHERS.



THIS DRAWING WAS PREPARED ONLY FOR THE PROJECT AND SITE SPECIFICALLY IDENTIFIED HEREON AND IS NOT TO BE USED ELSEWHERE.

Date: 7/14/95
By: [Signature]

REV	DATE	BY	DESCRIPTION
1	3/95	AMS	CONSTR. REV.
2	3/95	AMS	PCH #15 - DELETE 3\" CHEM. DRAIN
3	3/95	AMS	RFI #09 - GIVE DIMENSION
4	3/95	AMS	EXIST. 6\" IR PIPING SHOWN - REVISE NPW CONNECTION TO IR
5	3/95	AMS	RFI #02 - SIZE EXIST. NPW PIPING
6	3/95	AMS	PCH #33 - ADD 2\" PW TO SCRUBBER
7	3/95	AMS	ADD LAYOUT OF FAP

DESIGNED
KK
DRAWN
RES
CHECKED
THC
DATE
SEP '93

VERIFY SCALES
BAR IS ONE INCH ON ORIGINAL DRAWING
0 1"
IF NOT ONE INCH ON THIS SHEET, ADJUST SCALES ACCORDINGLY

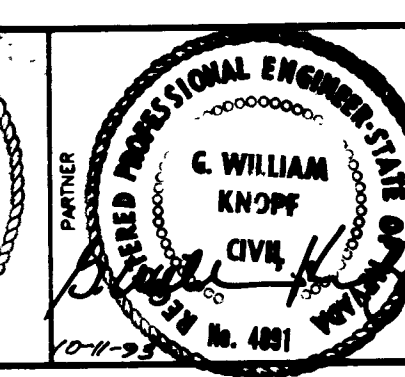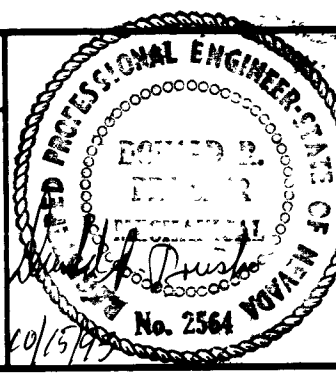

JOHN CAROLLO ENGINEERS
PHOENIX, AZ WILMINGTON, CA
SANTA ANA, CA TUCSON, AZ
SAN BERNARDINO, CA SAN DIEGO, CA
FRESNO, CA EL PASO, TEXAS



Las Vegas Water Pollution Control Facility	JOB NO. 3752B.10
ODOR CONTROL AT HEADWORKS AND PRIMARY CLARIFIERS	DRAWING NO. Y-8
YARD PIPING - AREA IV	SHEET NO. 26 OF 72

