
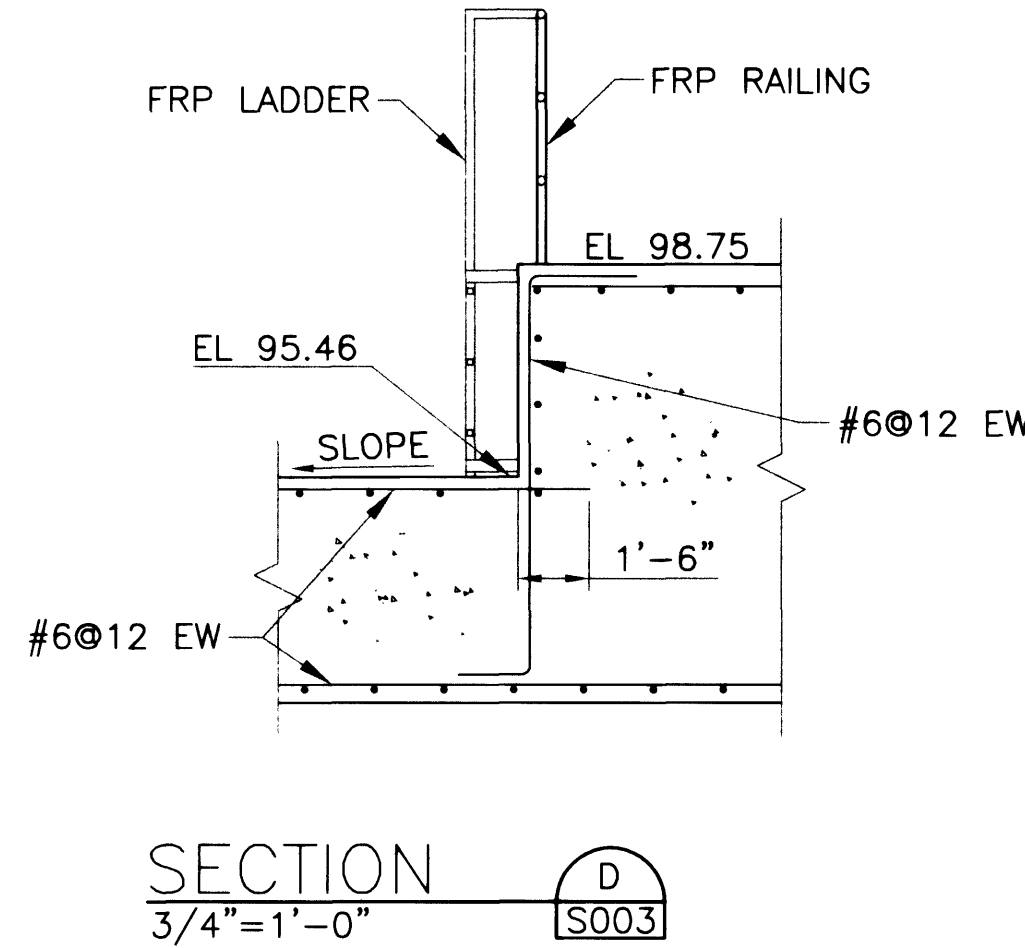
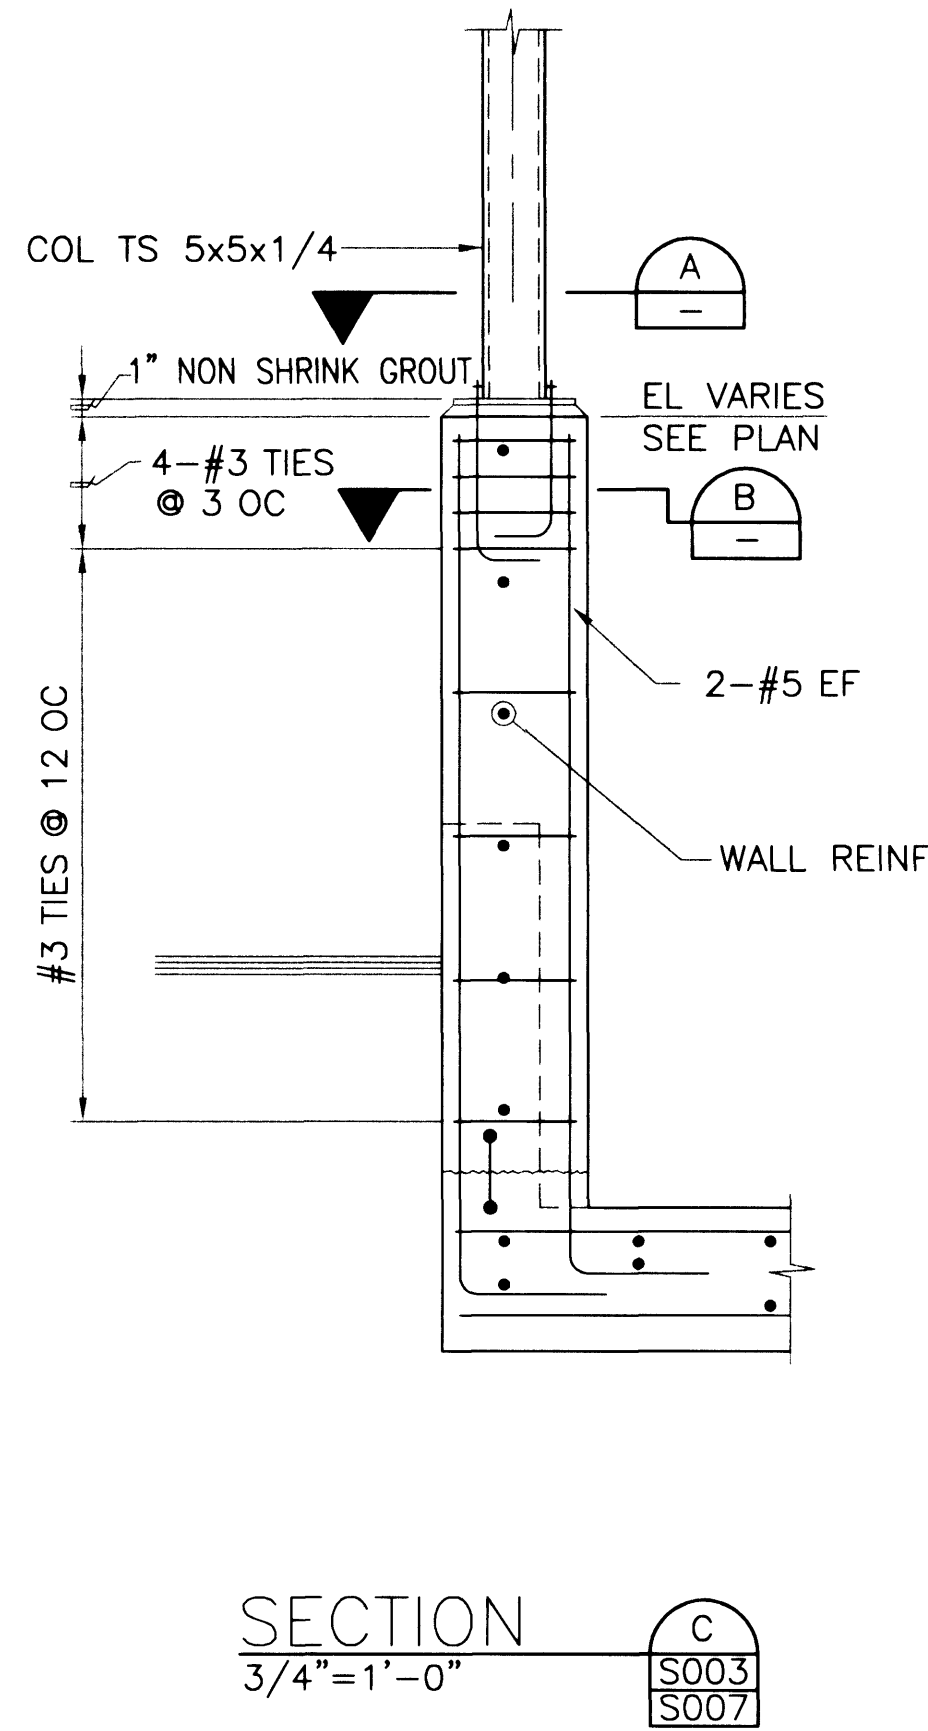
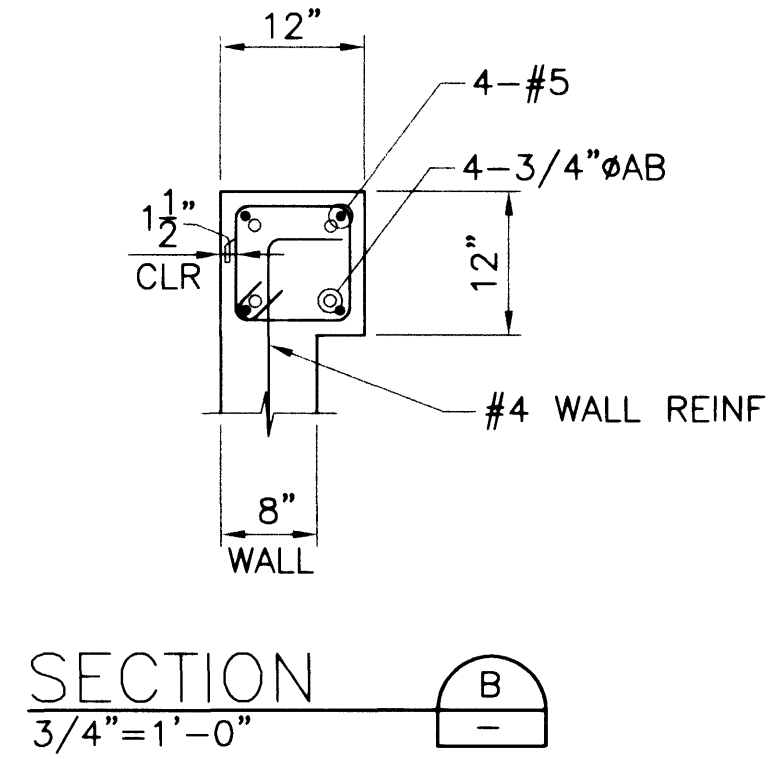
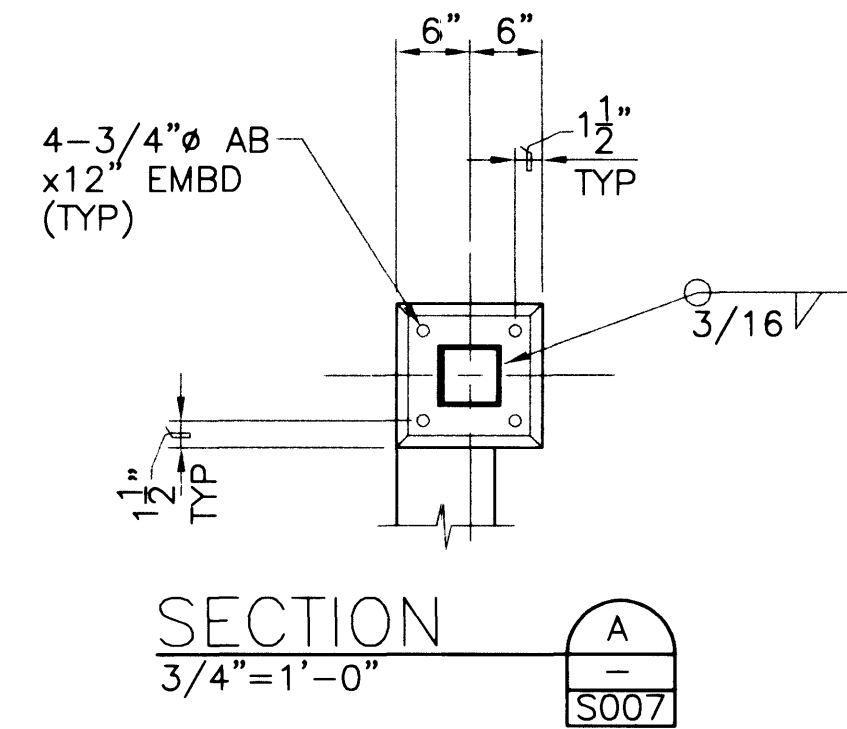


A B C D E F G H I J K L M N O P

10
9
8
7
6
5
4
3
2
1

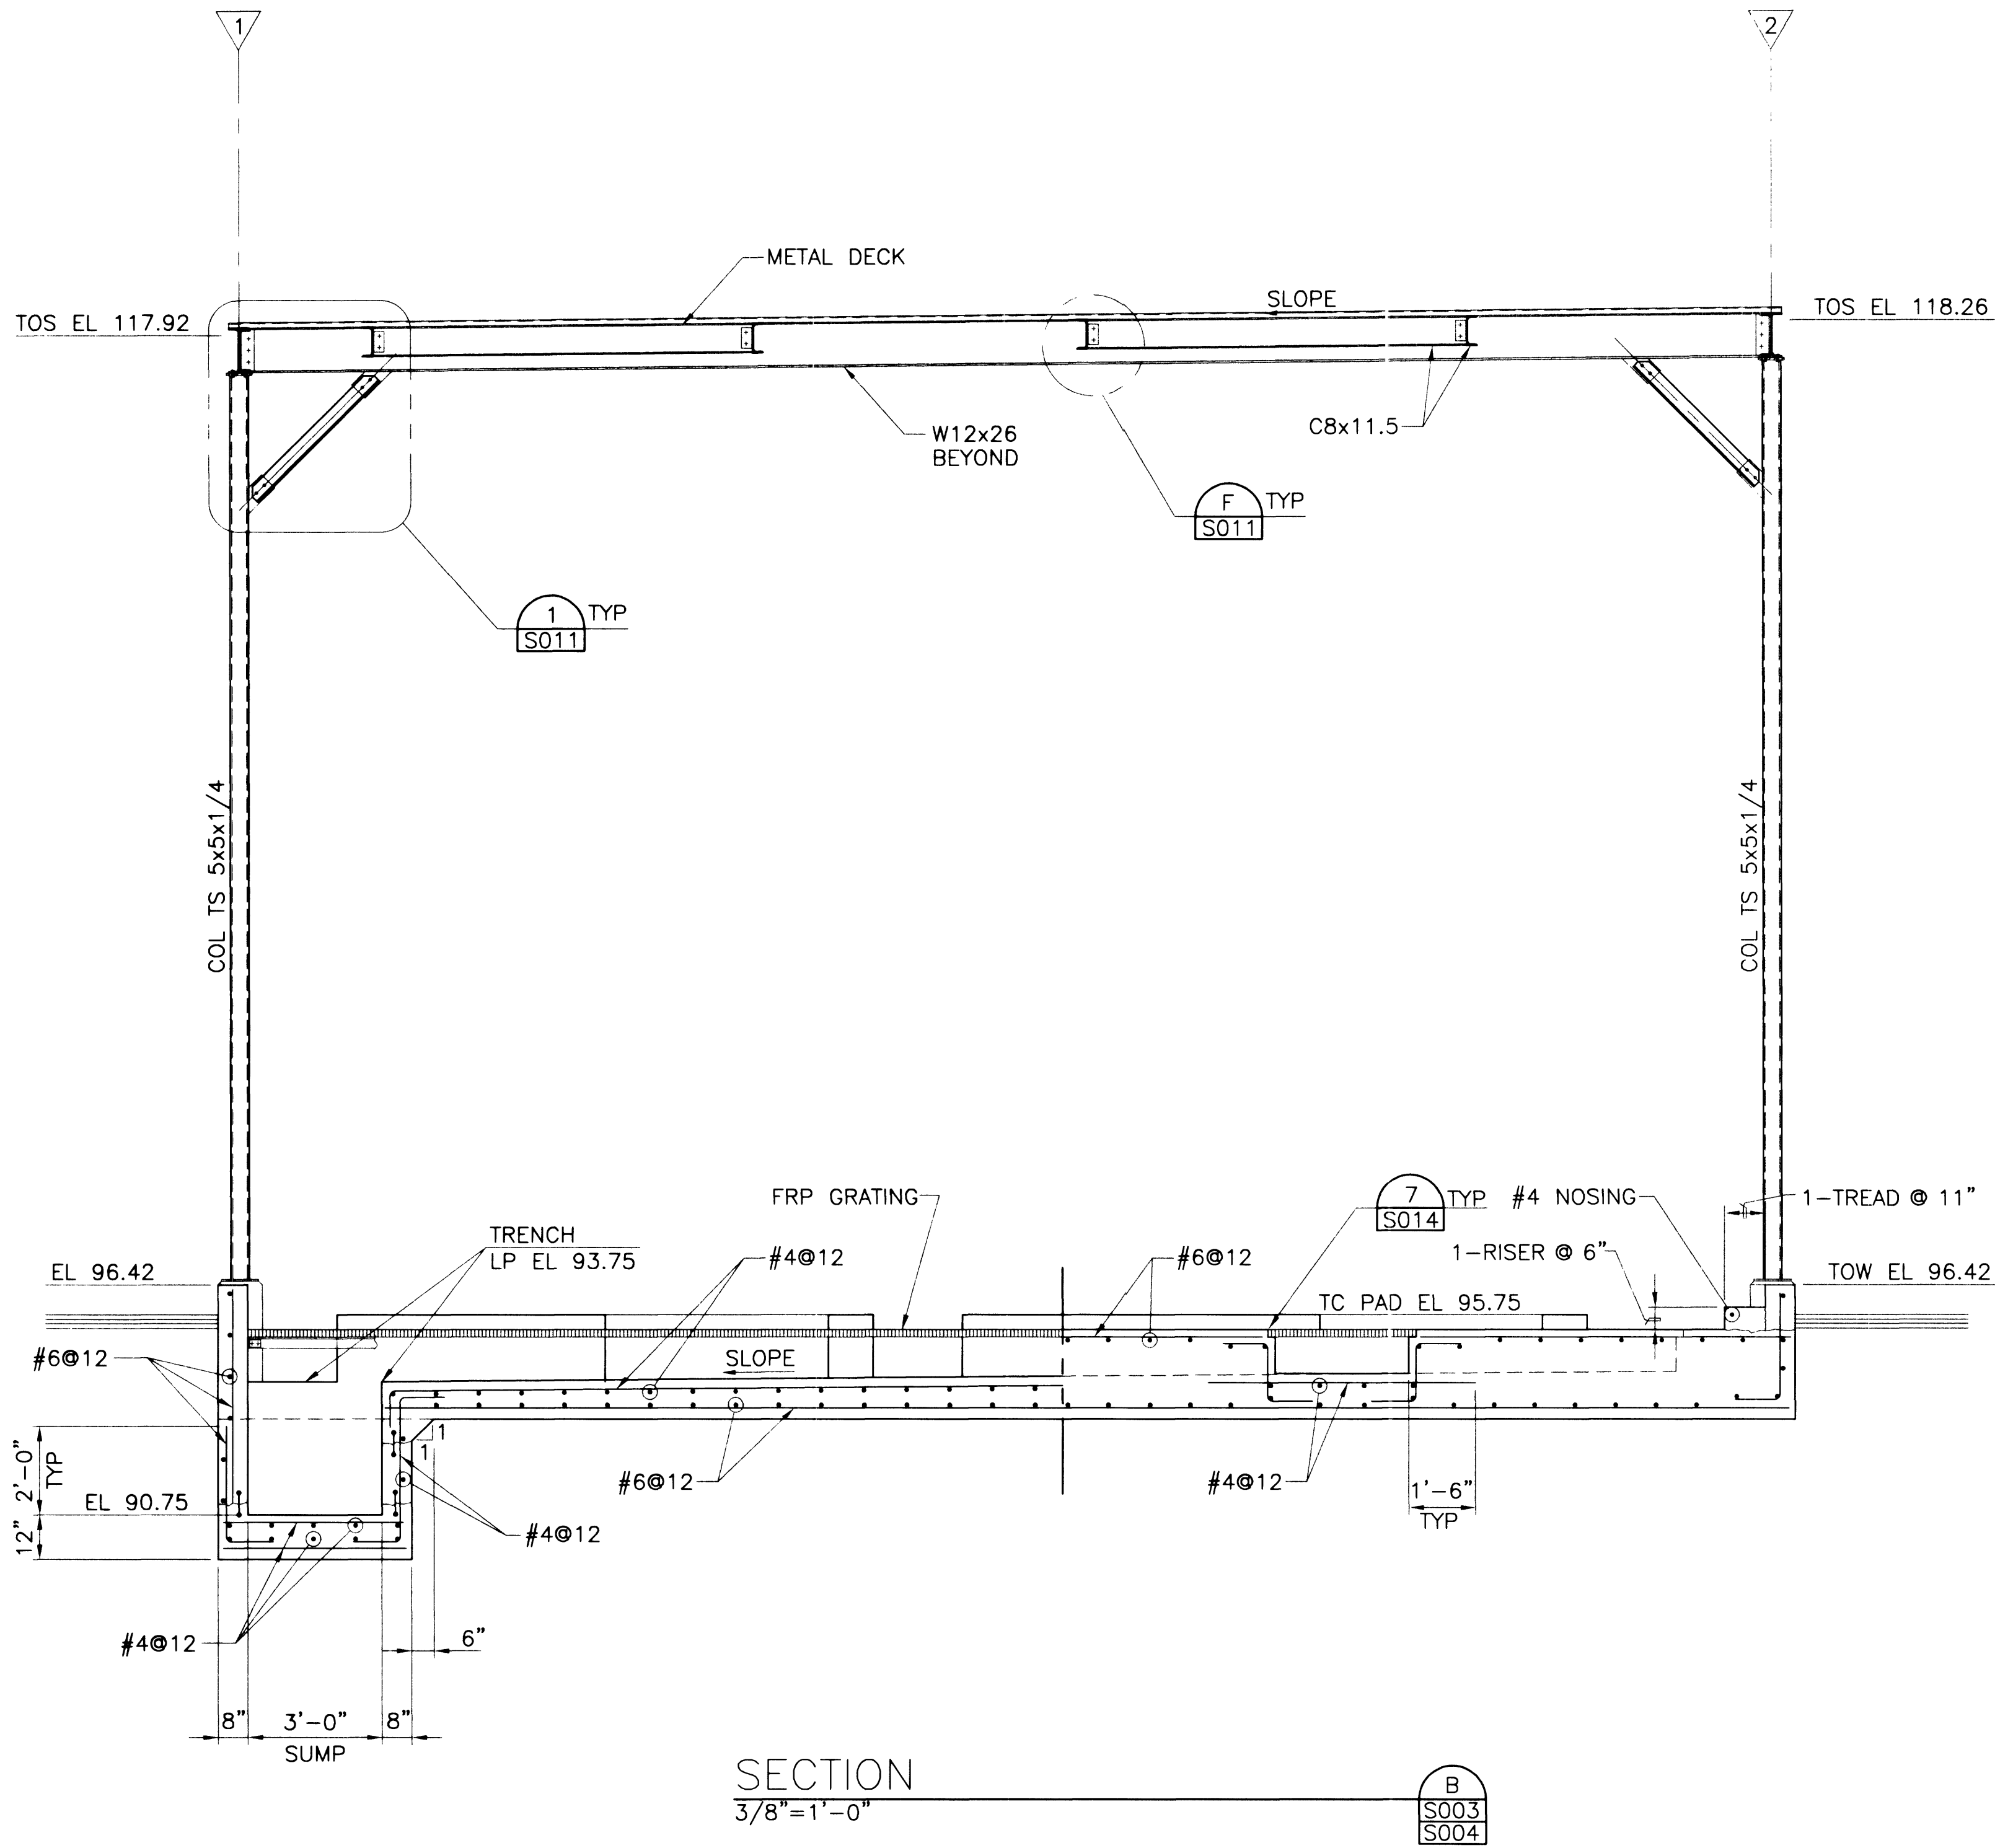

C20-S006.DWG
28.16.98 5:02 PM ADW

Issue No.	Description	Date	Drawn	Chkd.	Resp. Engr.	Proj. Mgr.
39/30	RECORD DRAWING	8/01/01	TUY	BJ		BJ

POGGEMEYER
DESIGN GROUP INC.
2601 NORTH TENAYA WAY
LAS VEGAS, NEVADA 89126 (702) 255-8100

HDR
HDR Engineering, Inc.
5280 S. EASTERN AVE., D1
LAS VEGAS, NV 89119
702.256.4895

Project Manager
B. JOHNSON
Designed
M. SATTARZADEH
Designed
M. STEELE
Checked
M. STEELE
Drawn
S. GUERZON

City of Las Vegas
**Water Pollution Control Facility
Plant Expansion
Contract 20 - Odor Control**

STRUCTURAL
ODOR CONTROL FACILITY NOS. 1 AND 2
SECTION AND DETAIL

Date	Project No.	Scale	Drawing No.	Sheet No.
SEPTEMBER 1998	00120-154-141	AS SHOWN	S006	25 of 76

3/1.48