



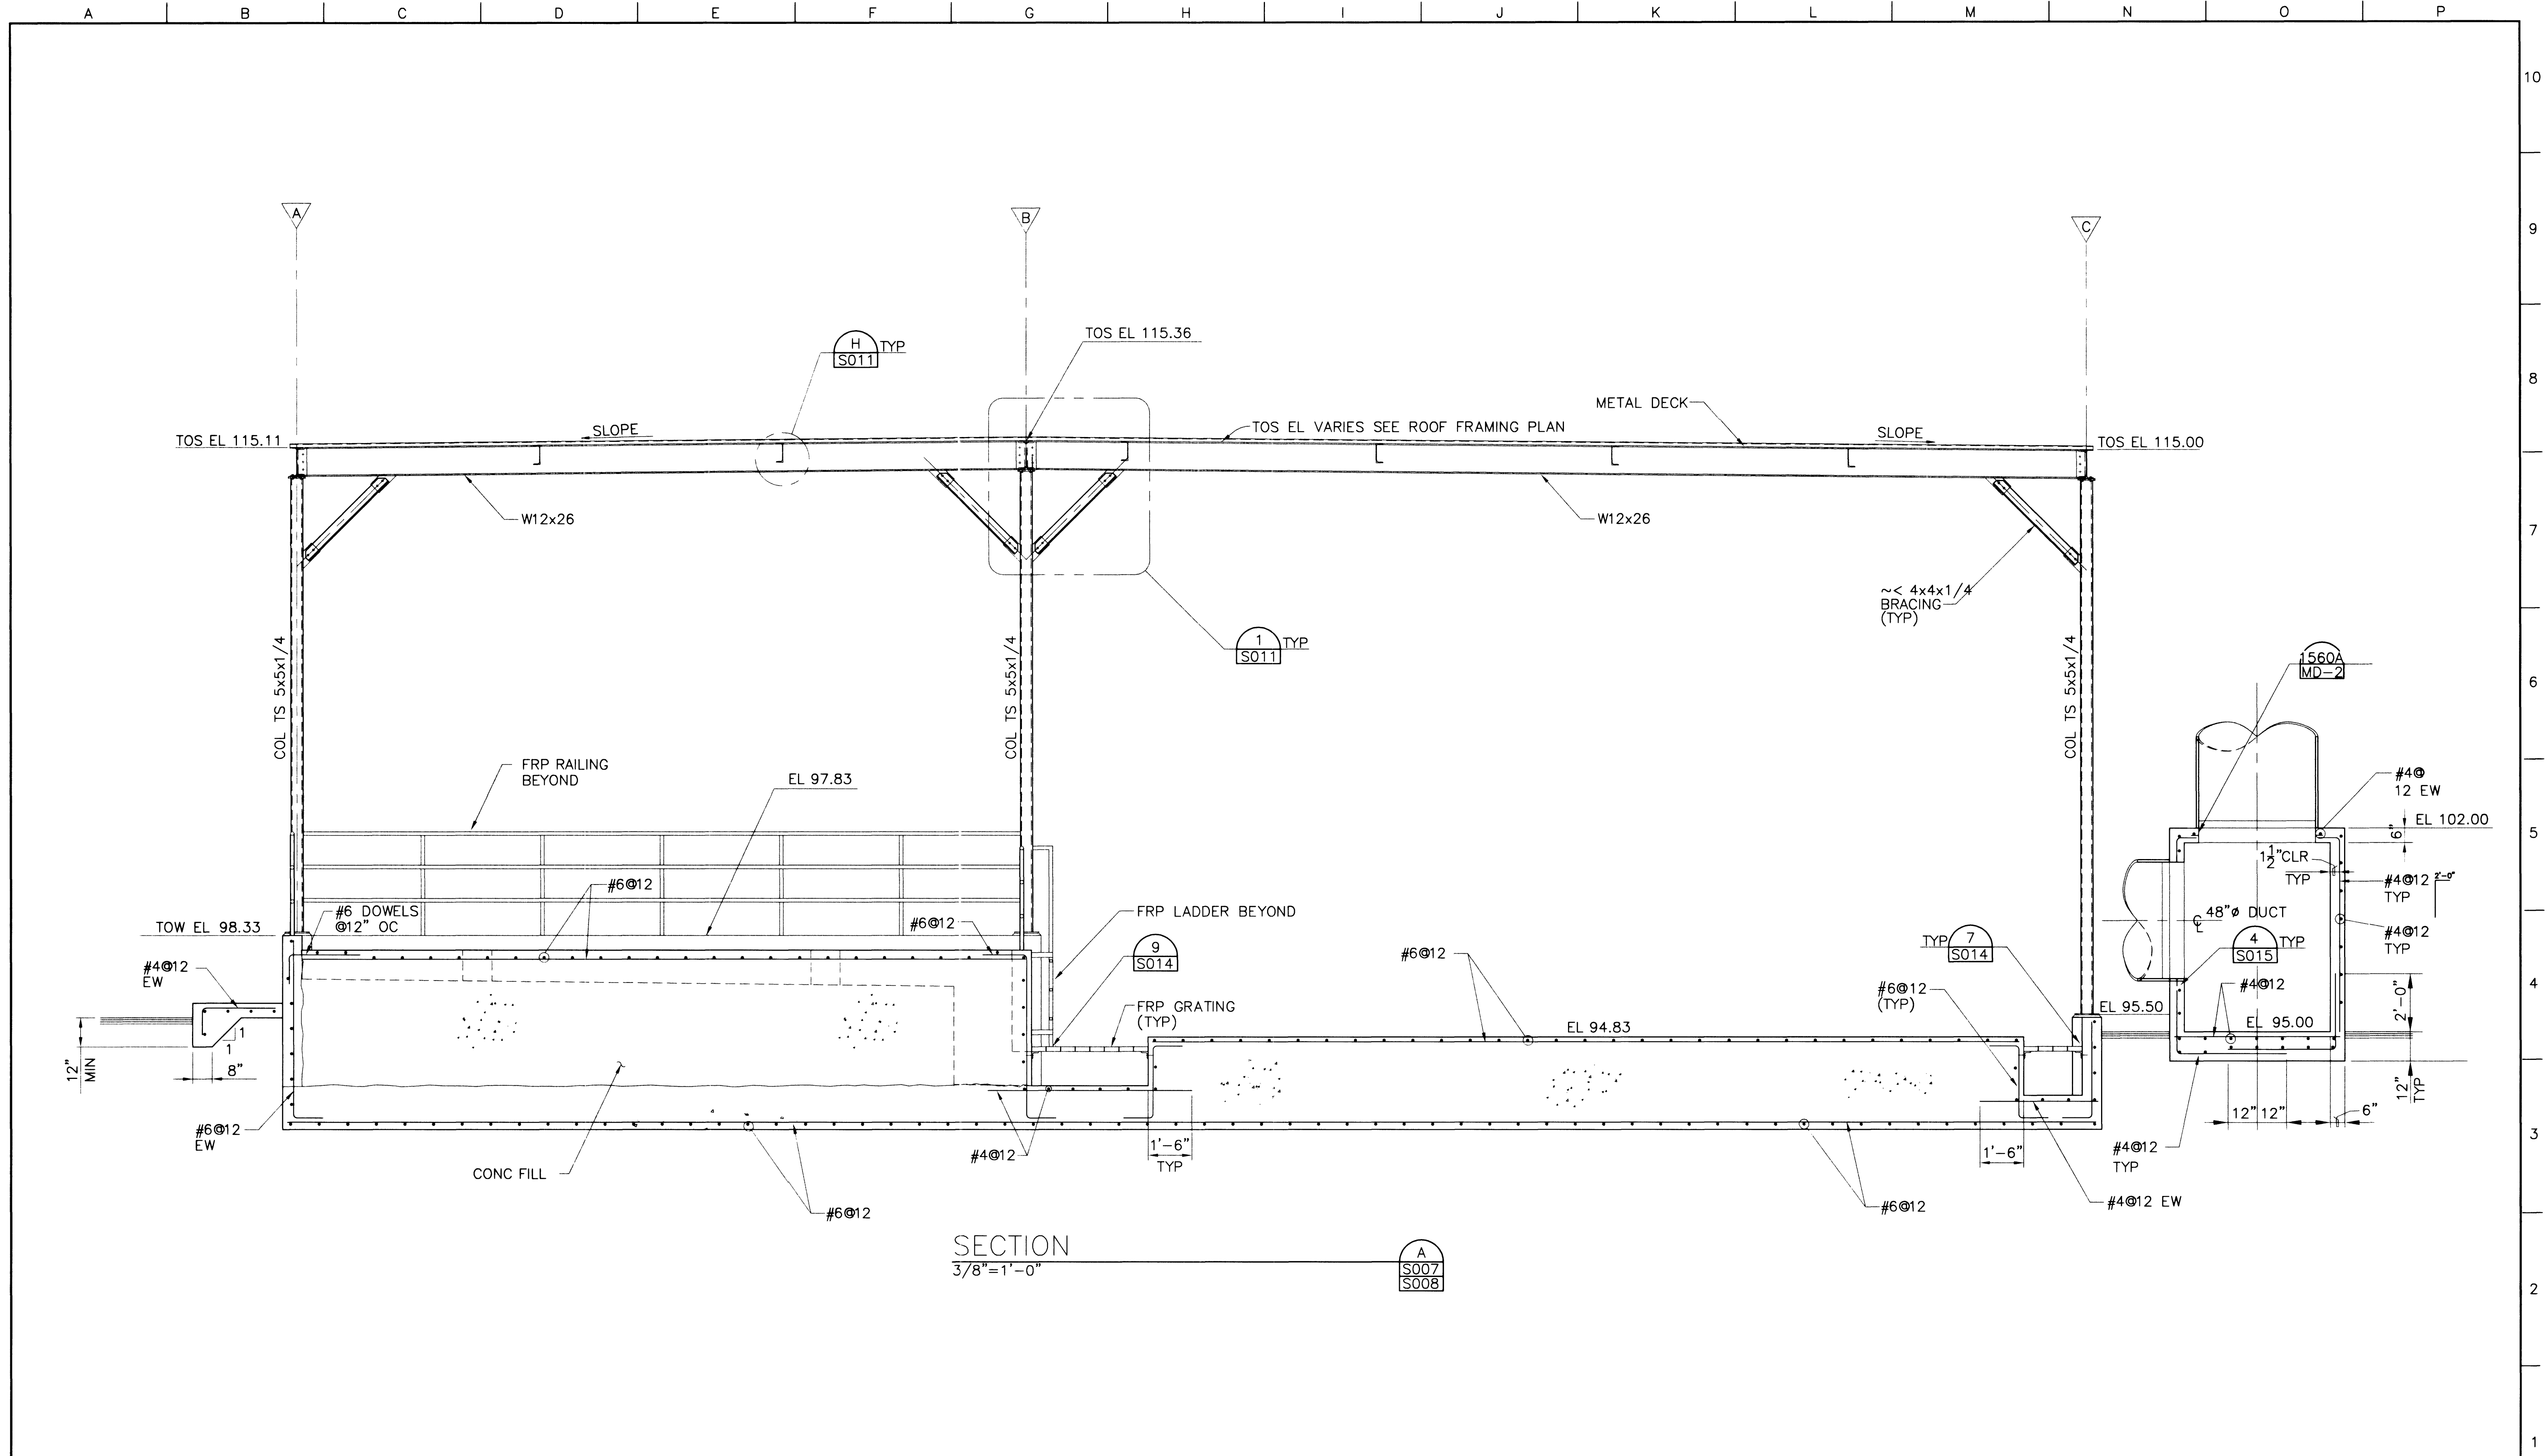

RECORD DRAWING		8/01/01	TUY	BJ		BJ
Description		Date	Drawn	Chkd.	Resp. Engr.	Proj. Mgr.
39133						

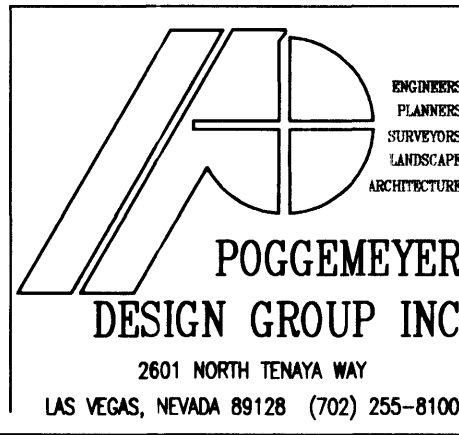

Project Manager	B. JOHNSON
Designed	M. SATTARZADEH
Designed	
Checked	M. STEELE
Drawn	S. GUERZON

City of Las Vegas
Water Pollution Control Facility
Plant Expansion
Contract 20 - Odor Control

STRUCTURAL		ODOR CONTROL FACILITY PLANT NOS. 3 AND 4		SECTION	
Date	SEPTEMBER 1998	Project No.	00120-154-141	Scale	3/8"=1'-0"
Drawing No.	S009	Sheet No.	28 of 76	3/1.48	