


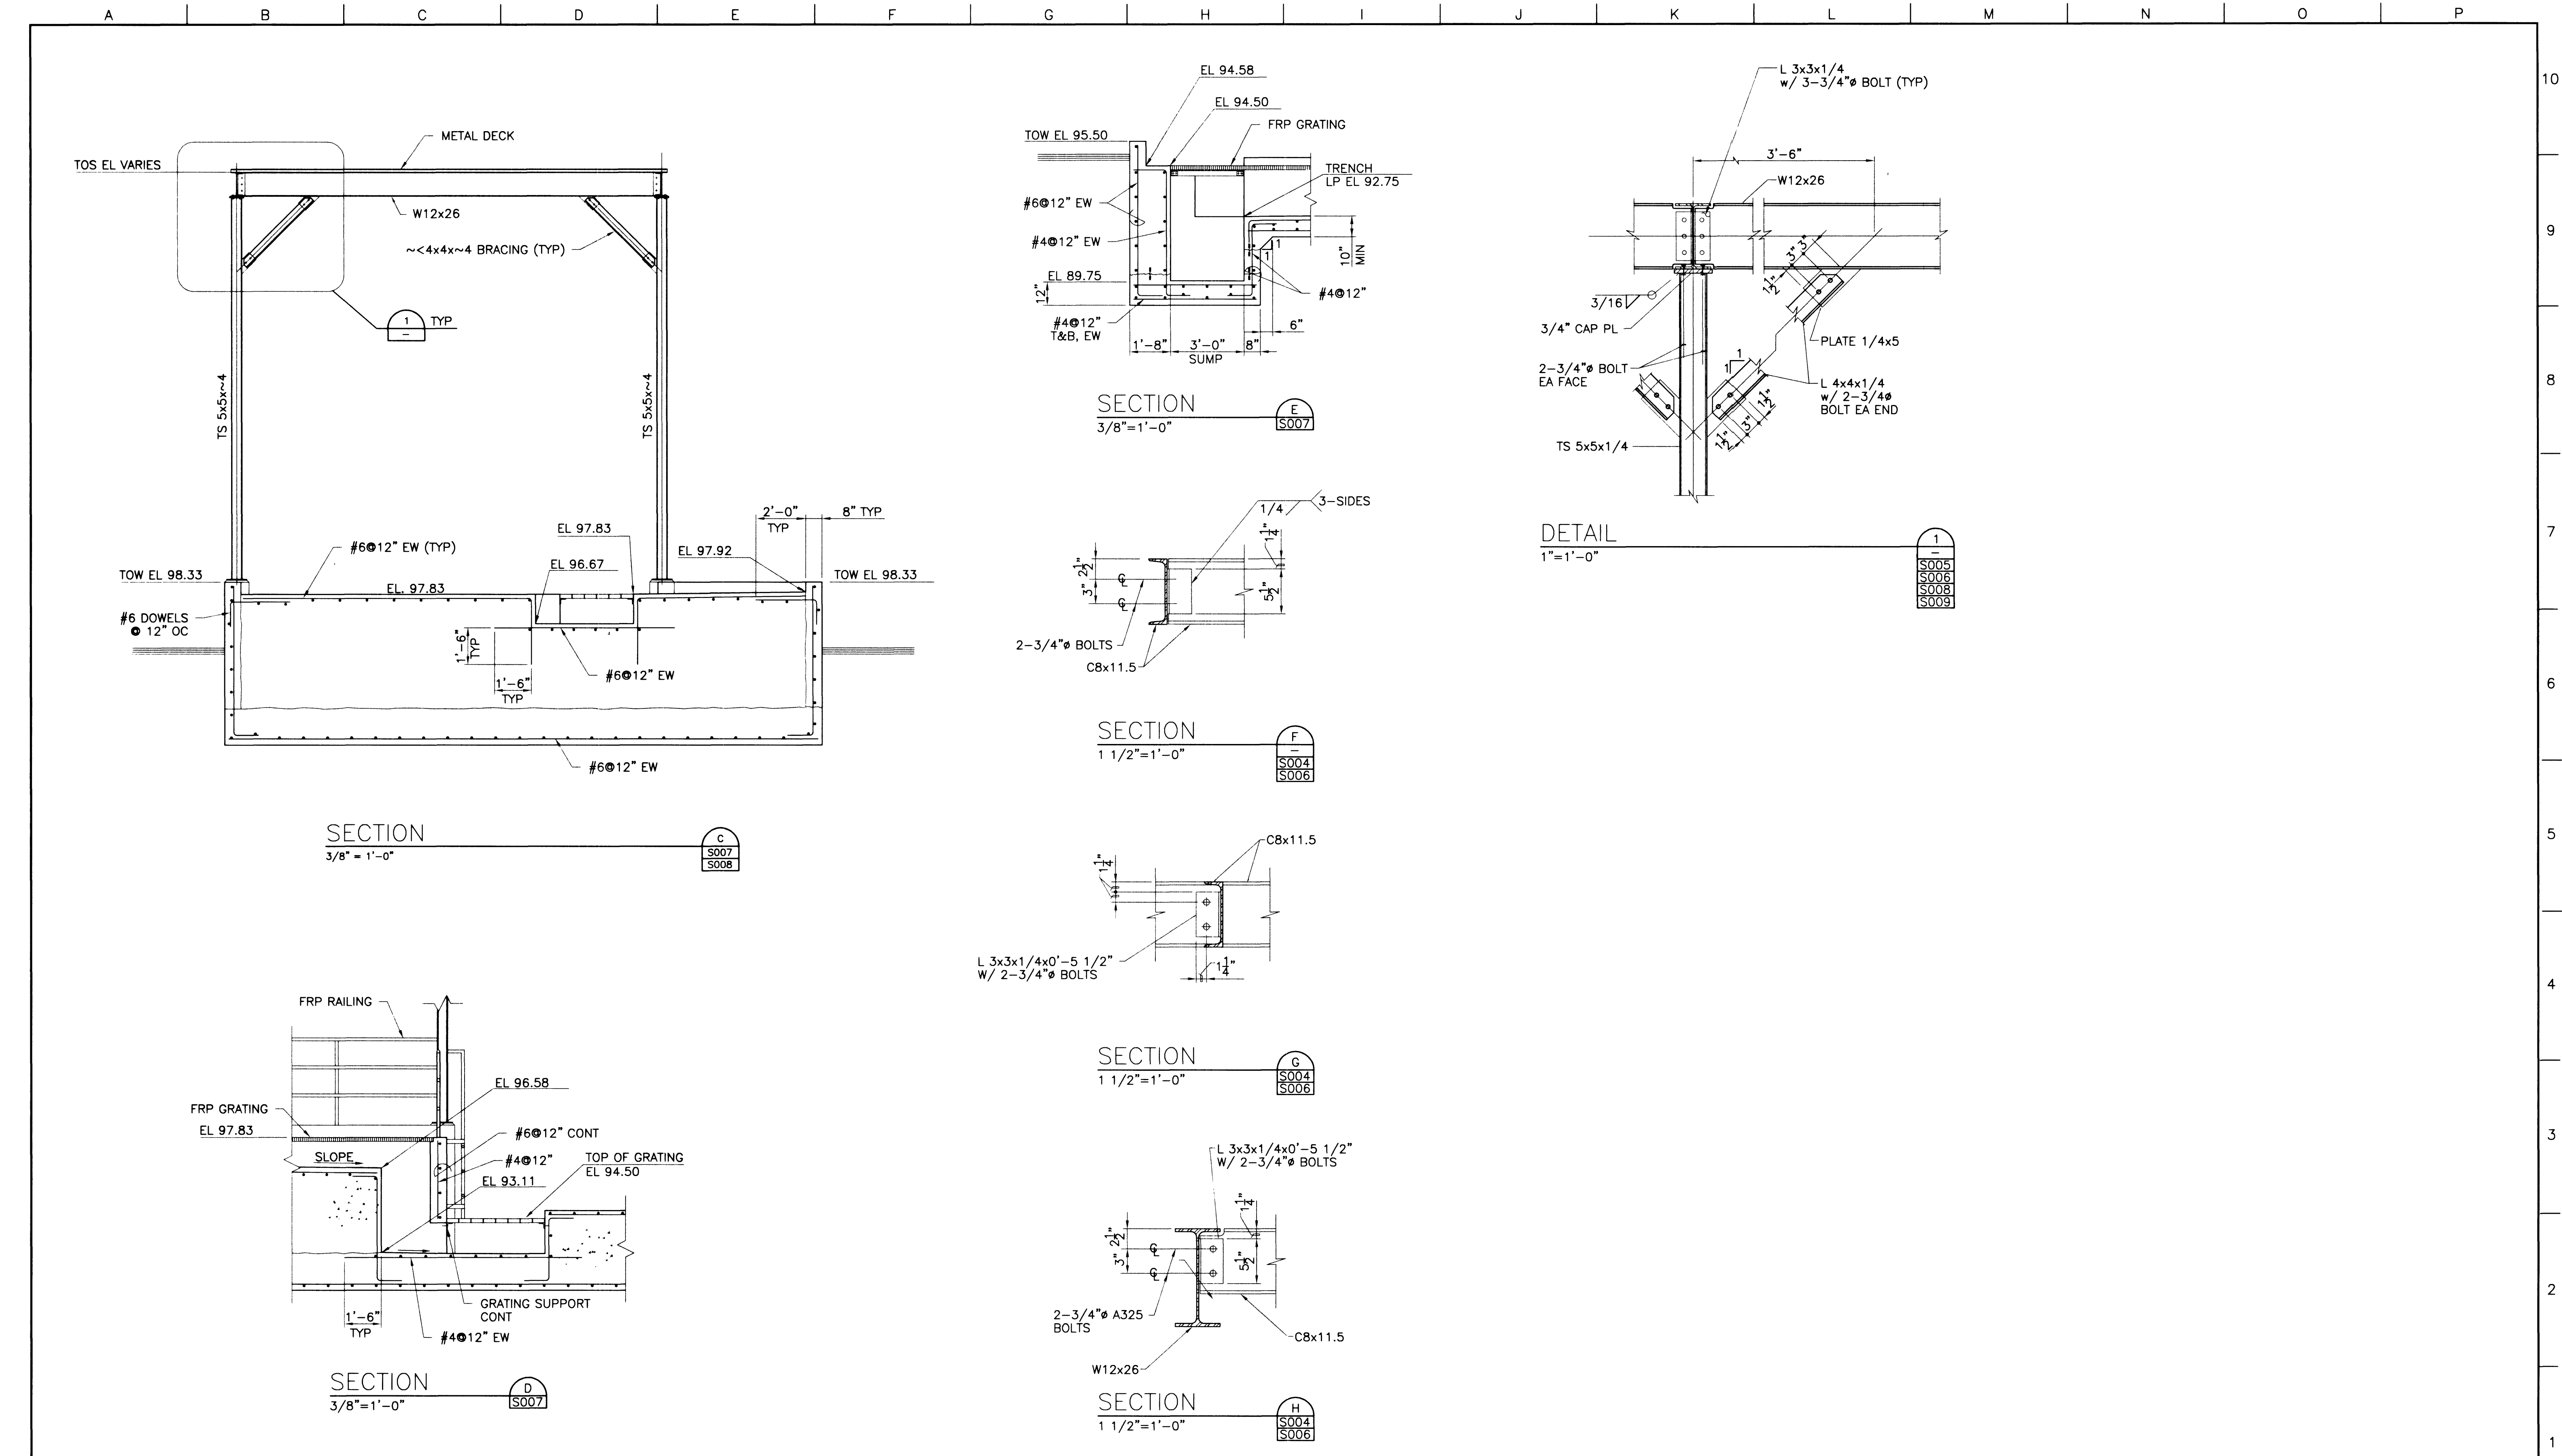

Issue No.	39/35
Description	RECORD DRAWING
Date	08-01-01
Drawn	TUY
Chkd.	BJ
Resp. Engr.	BJ
Proj. Mgr.	BJ

POGGEMEYER DESIGN GROUP INC.
2601 NORTH TENAYA WAY
LAS VEGAS, NEVADA 89128 (702) 255-8100

HDR
HDR Engineering, Inc.
5280 S. EASTERN AVE., D1
LAS VEGAS, NV 89119
702.256.4895

Project Manager	B. JOHNSON
Designed	M. SATTARZADEH
Designed	
Checked	M. STEELE
Drawn	M. SATTARZADEH

City of Las Vegas
**Water Pollution Control Facility
Plant Expansion
Contract 20 - Odor Control**

STRUCTURAL ODOR CONTROL FACILITY NOS. 1, 2, 3 AND 4 SECTIONS AND DETAIL		3//48	
Date	Project No.	Scale	Drawing No.
SEPTEMBER 1998	00120-154-141	AS SHOWN	S-11
Sheet No.		30 of 76	