


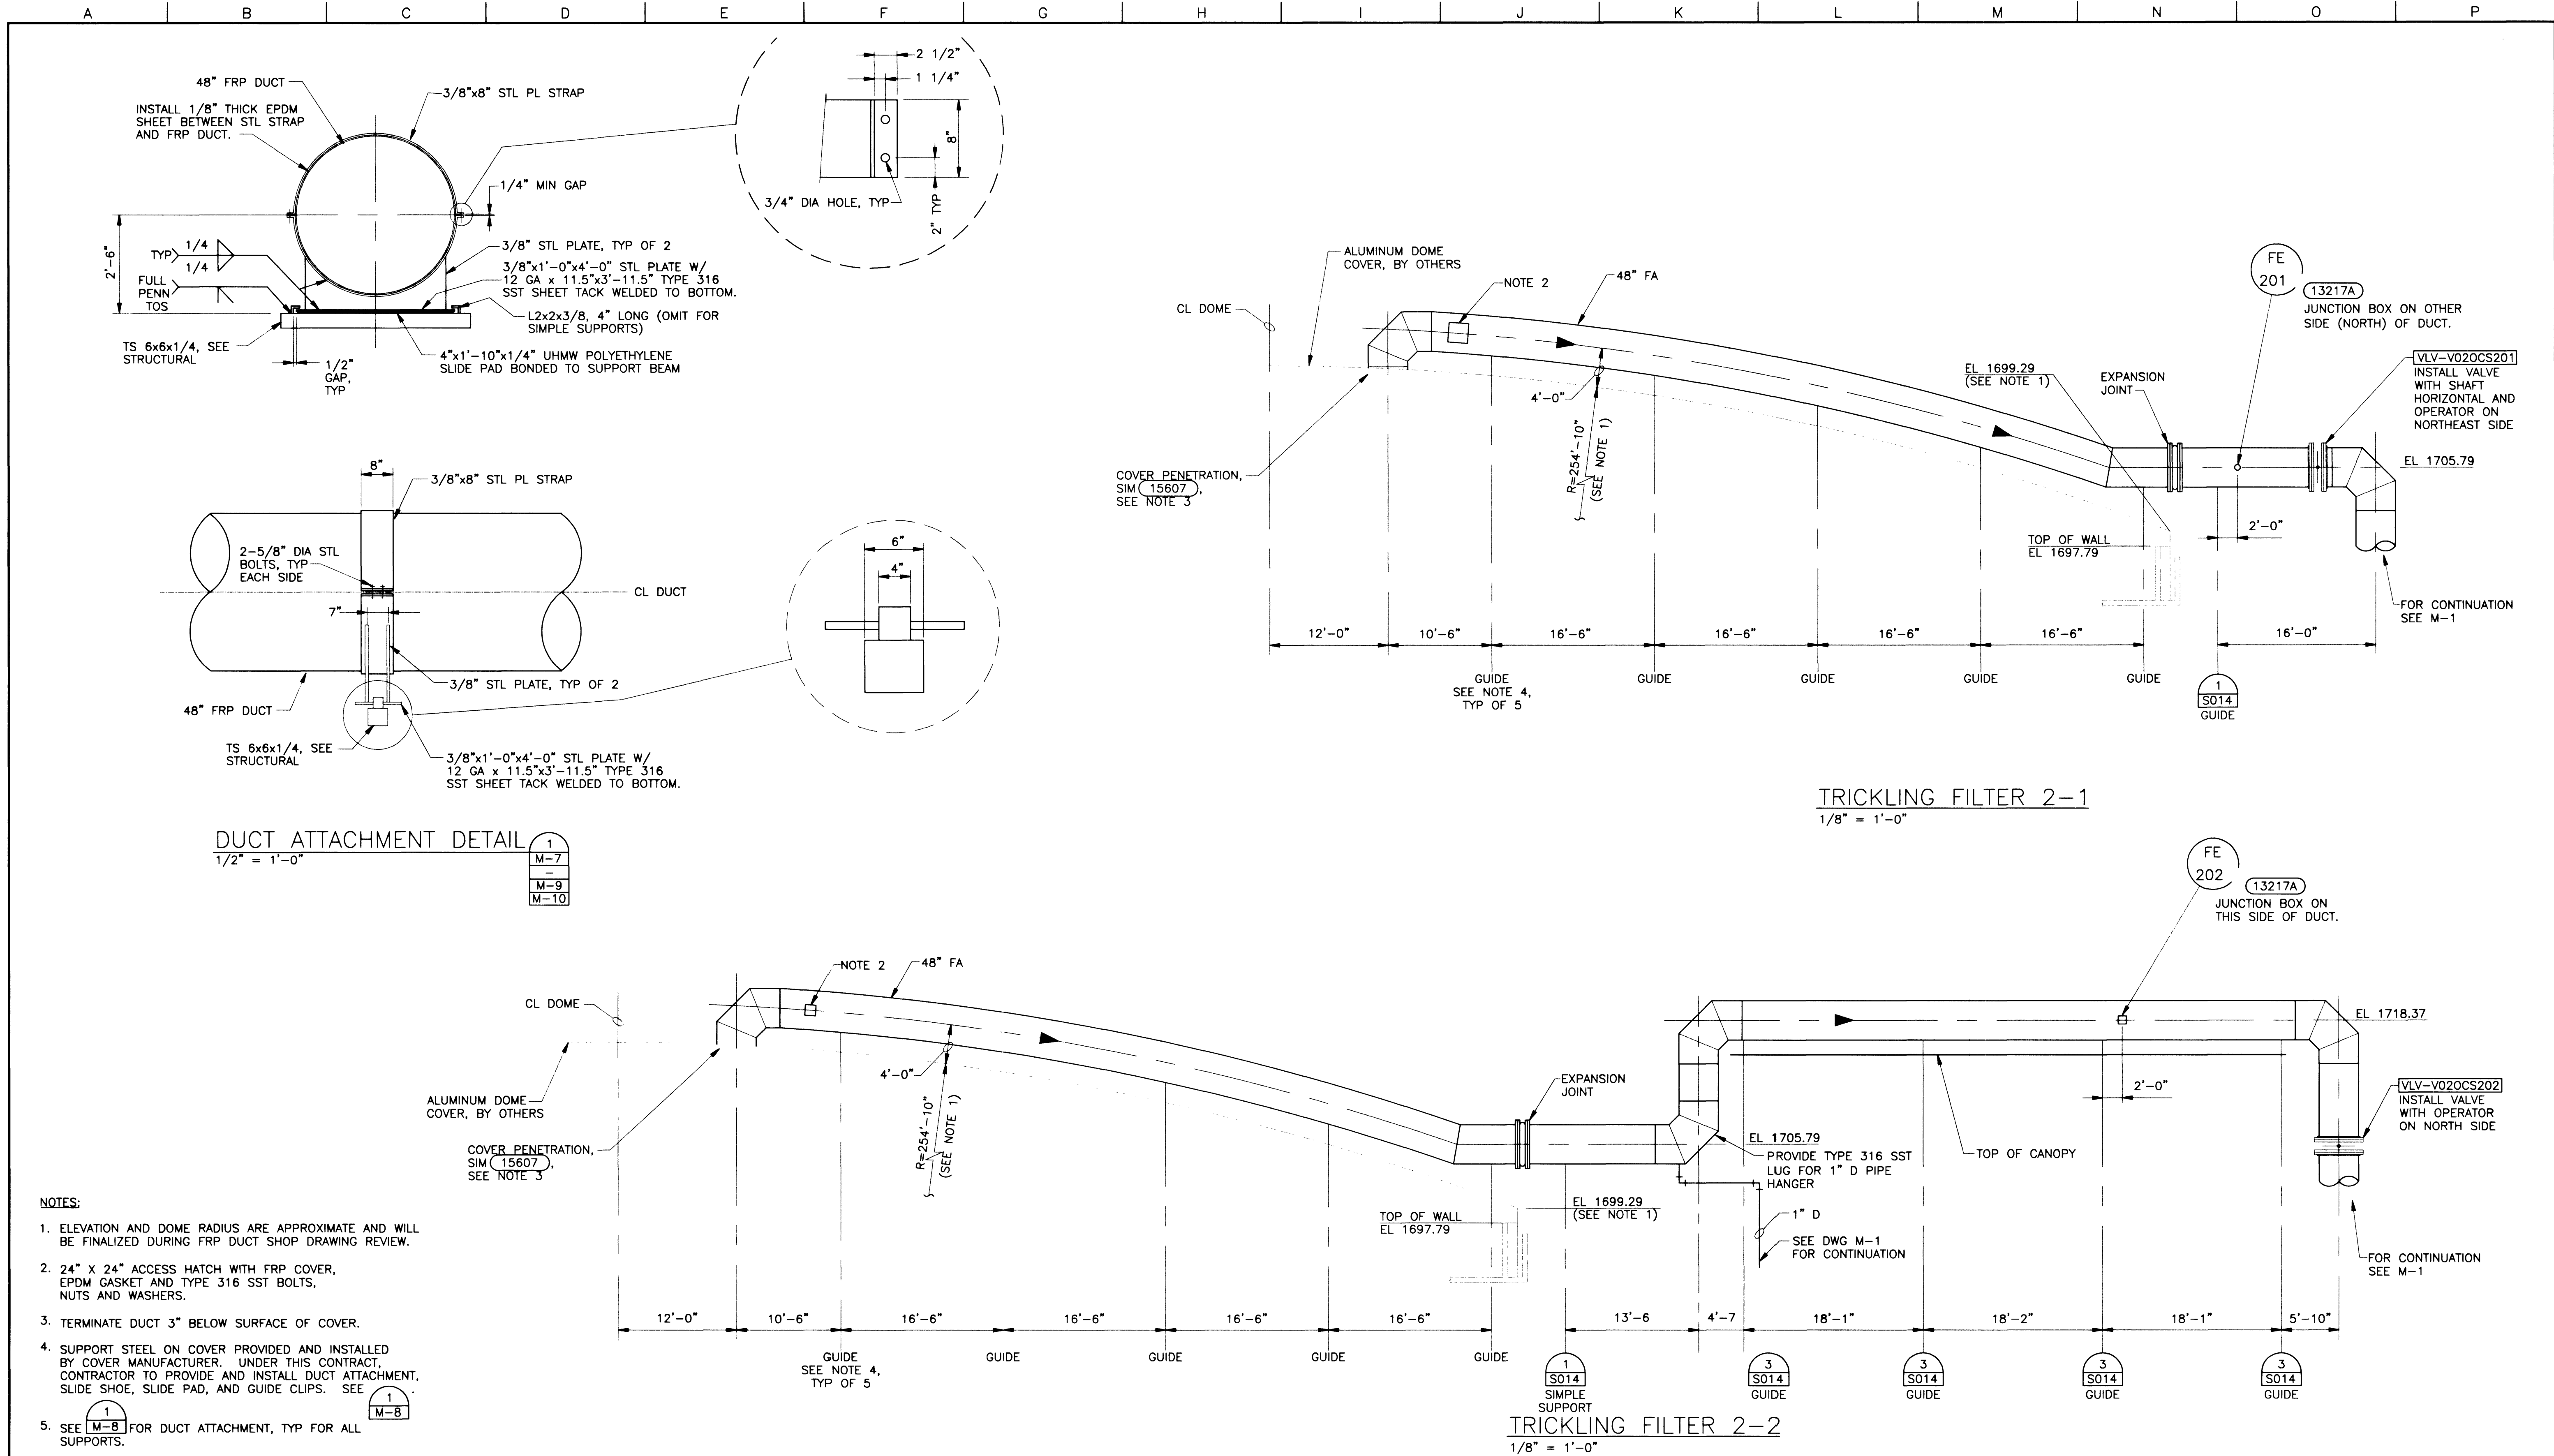

RECORD DRAWING Description 39/49		Date 7-31-01	Drawn TUY	Chkd. BJ	Resp. Eng.	Proj. Mgr. BJ
--	--	-----------------	--------------	-------------	---------------	---------------------

CH2MHILL
2000 E. FLAMINGO ROAD,
SUITE A
LAS VEGAS, NV 89119
702.369.6175

HDR
HDR Engineering, Inc.
5280 S. EASTERN AVE., D1
LAS VEGAS, NV 89119
702.256.4895

Project Manager
B. JOHNSON

Designed
R. LONG

Designed
BJ

Checked
J. McLUCAS

Drawn
C. MCCOY

City of Las Vegas

**Water Pollution Control Facility
Plant Expansion**

Contract 20 - Odor Control

MECHANICAL
PLANT NO. 2 - DUCTWORK SECTIONS

Date
SEPTEMBER 1998

Project No.
00120-154-141

Scale
AS SHOWN

Drawing No.
M-8

Sheet No.
44 of 76