
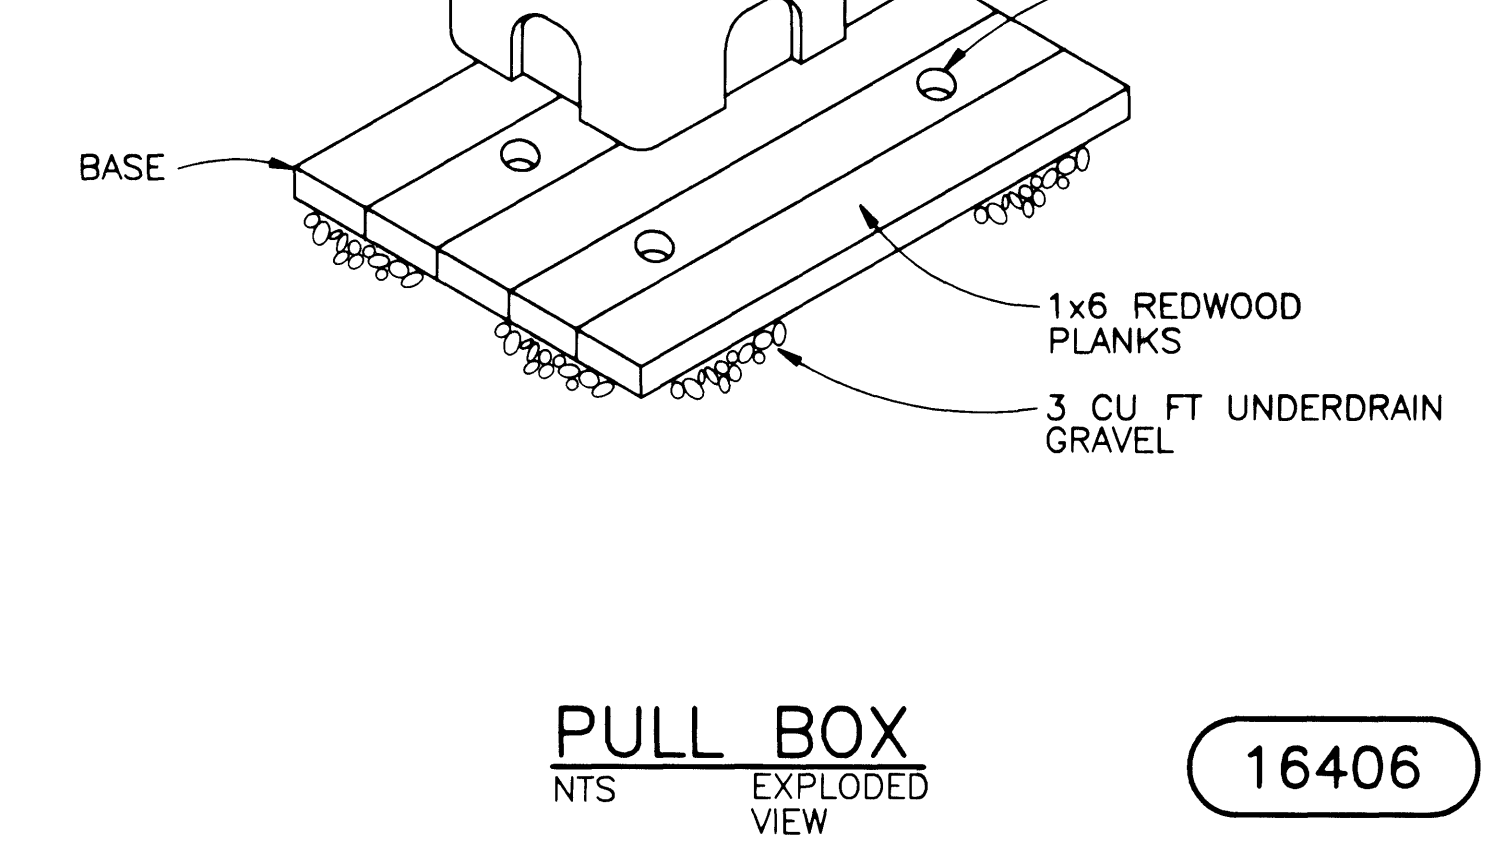
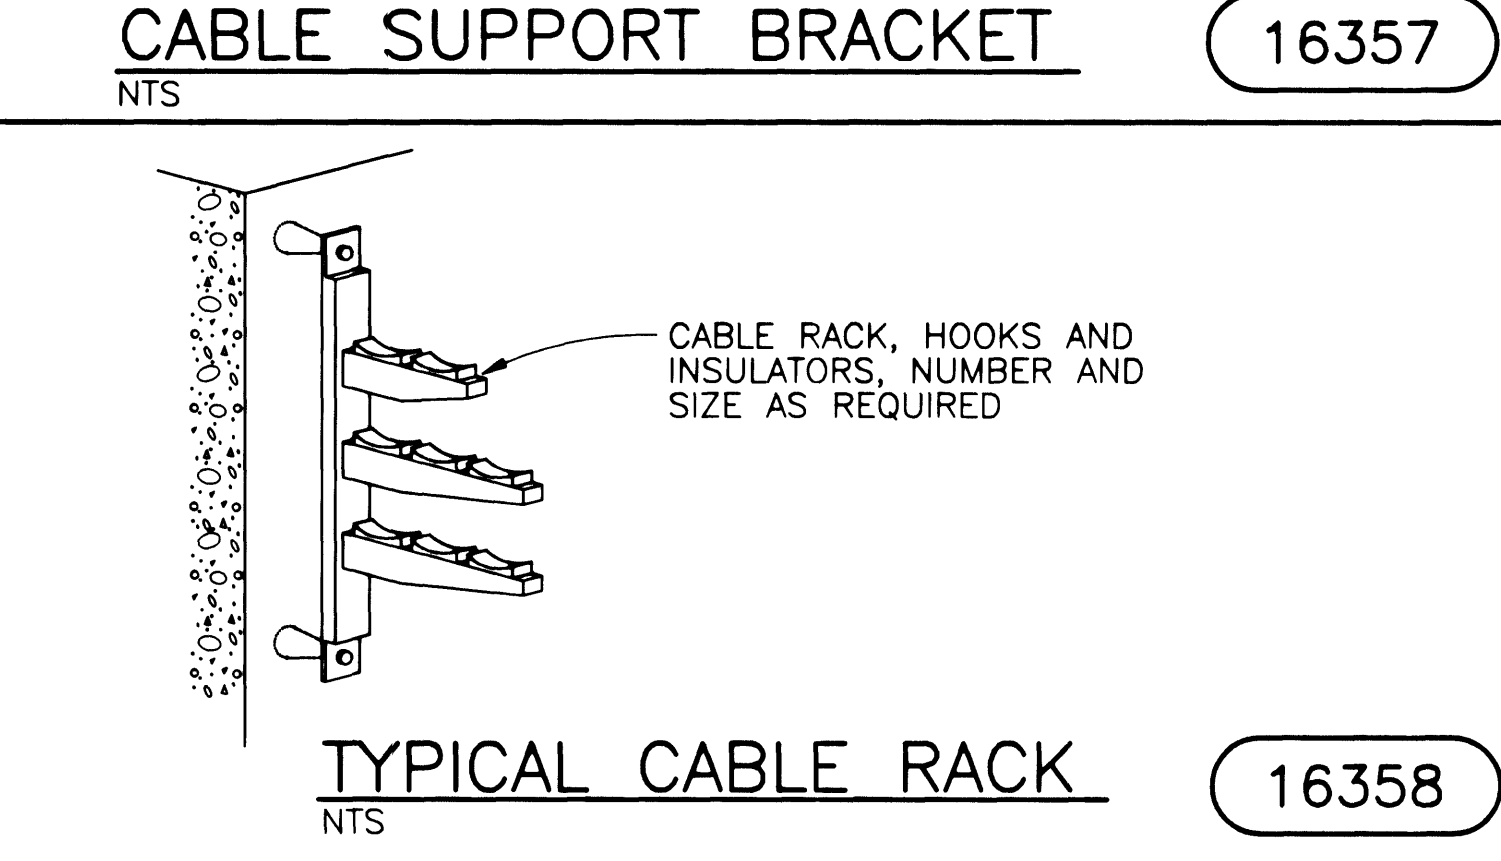
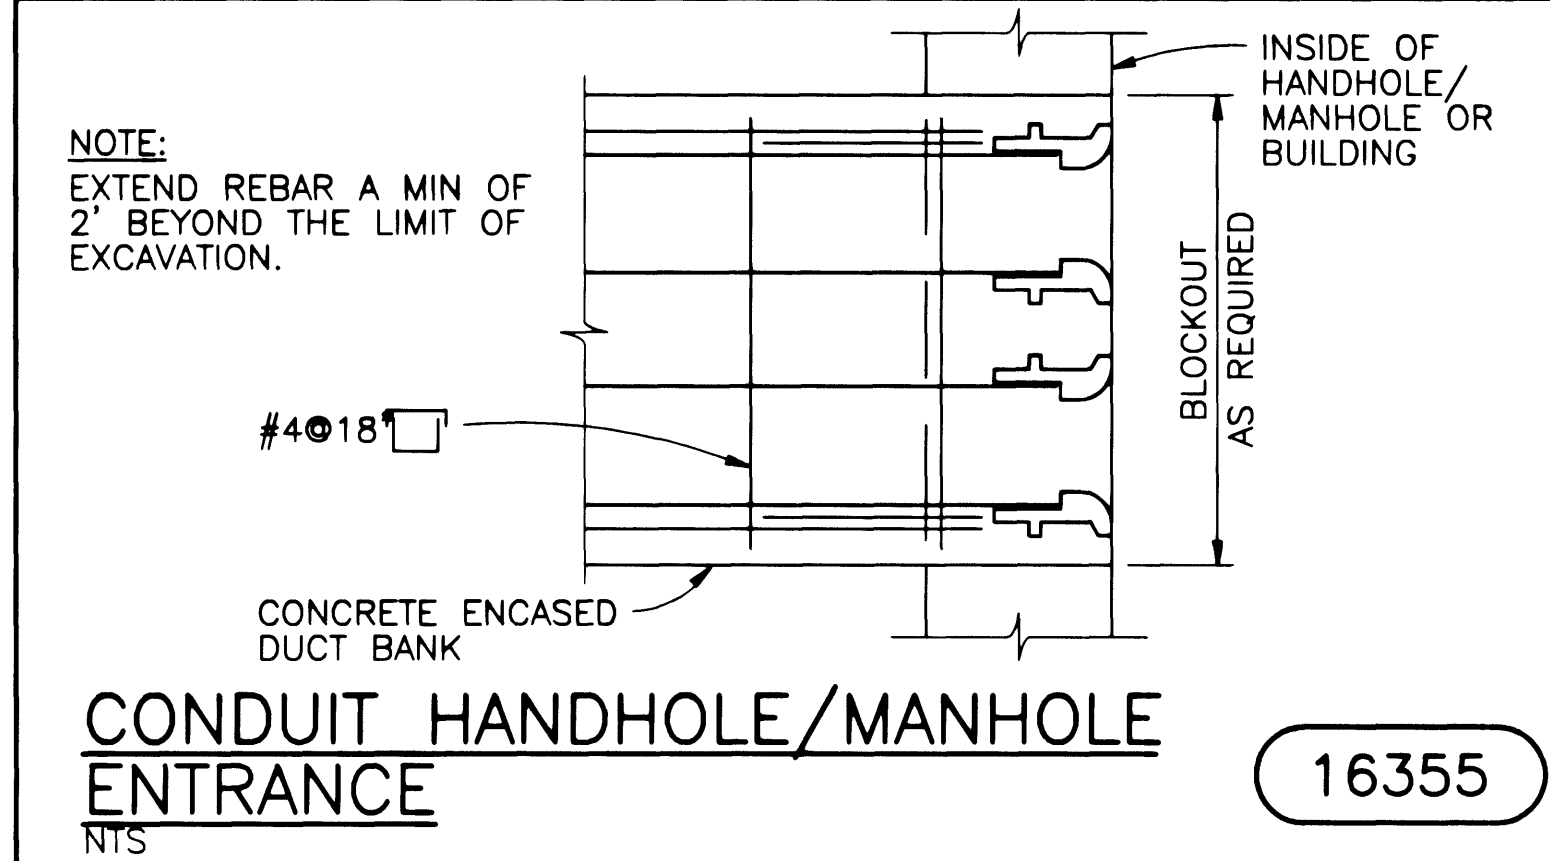
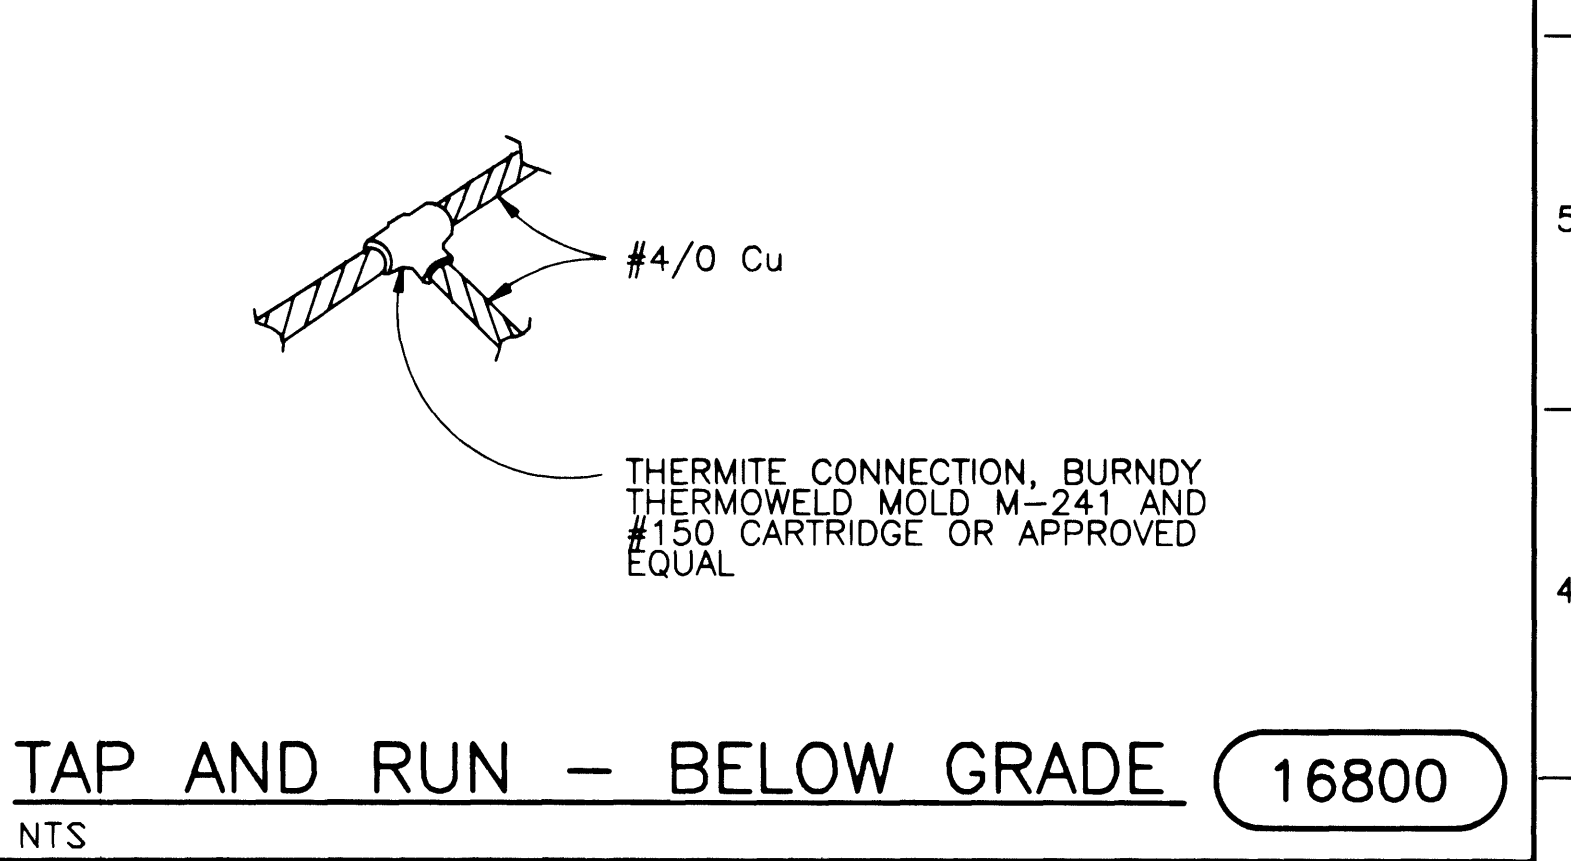
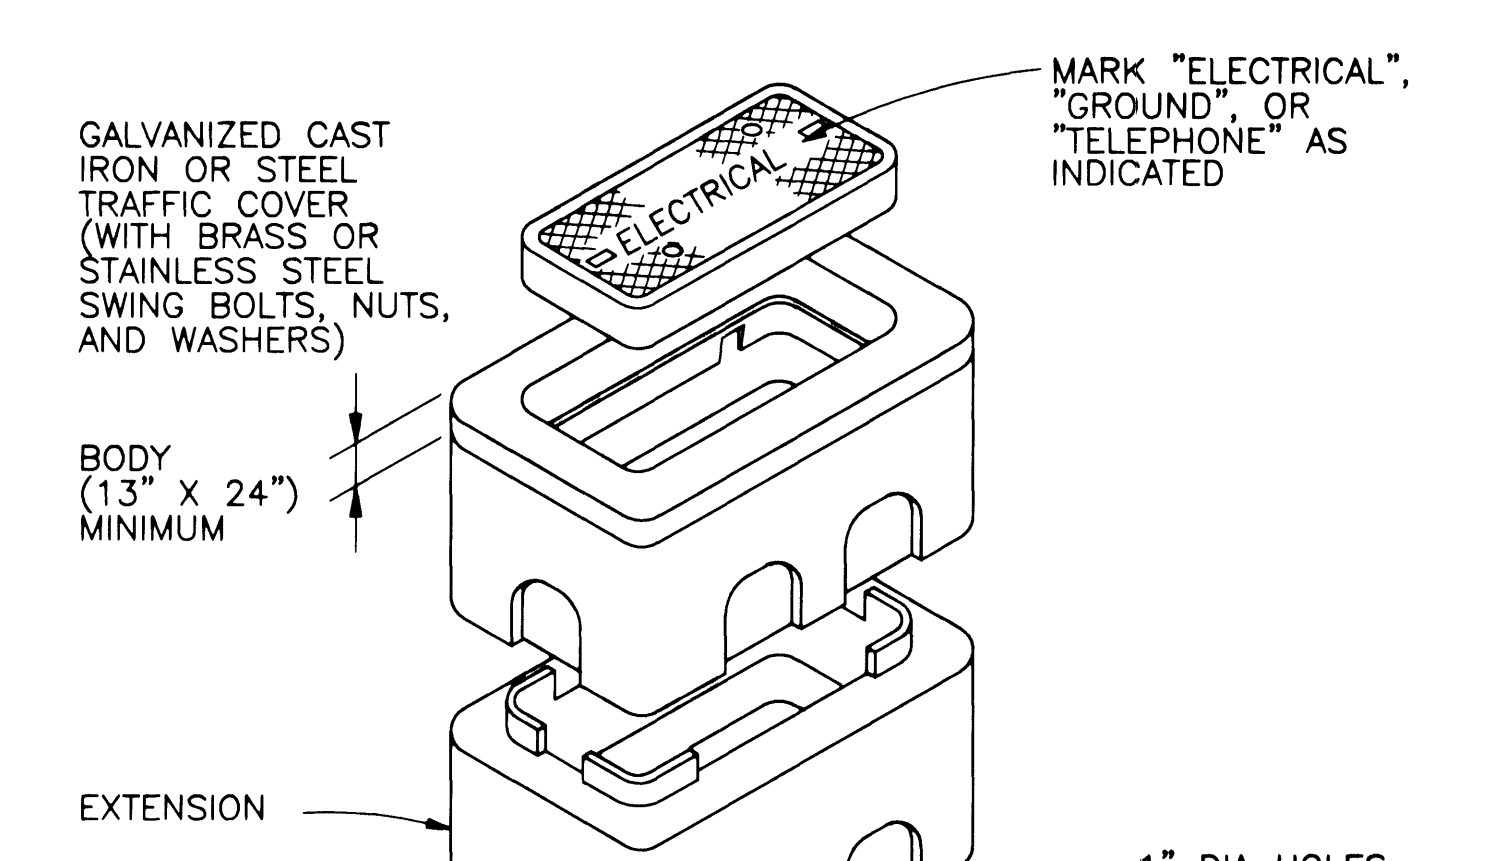
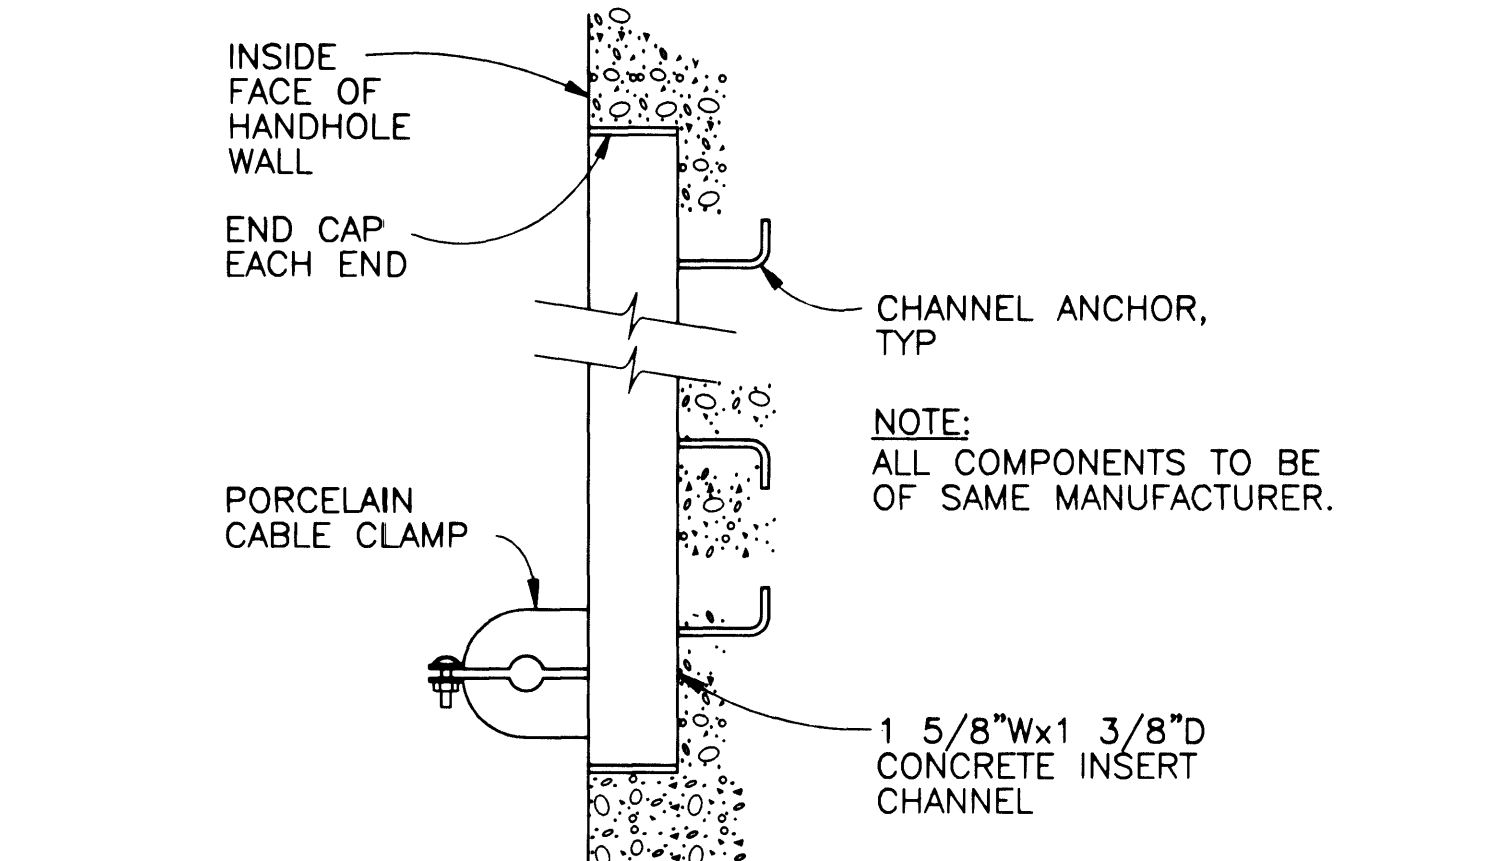
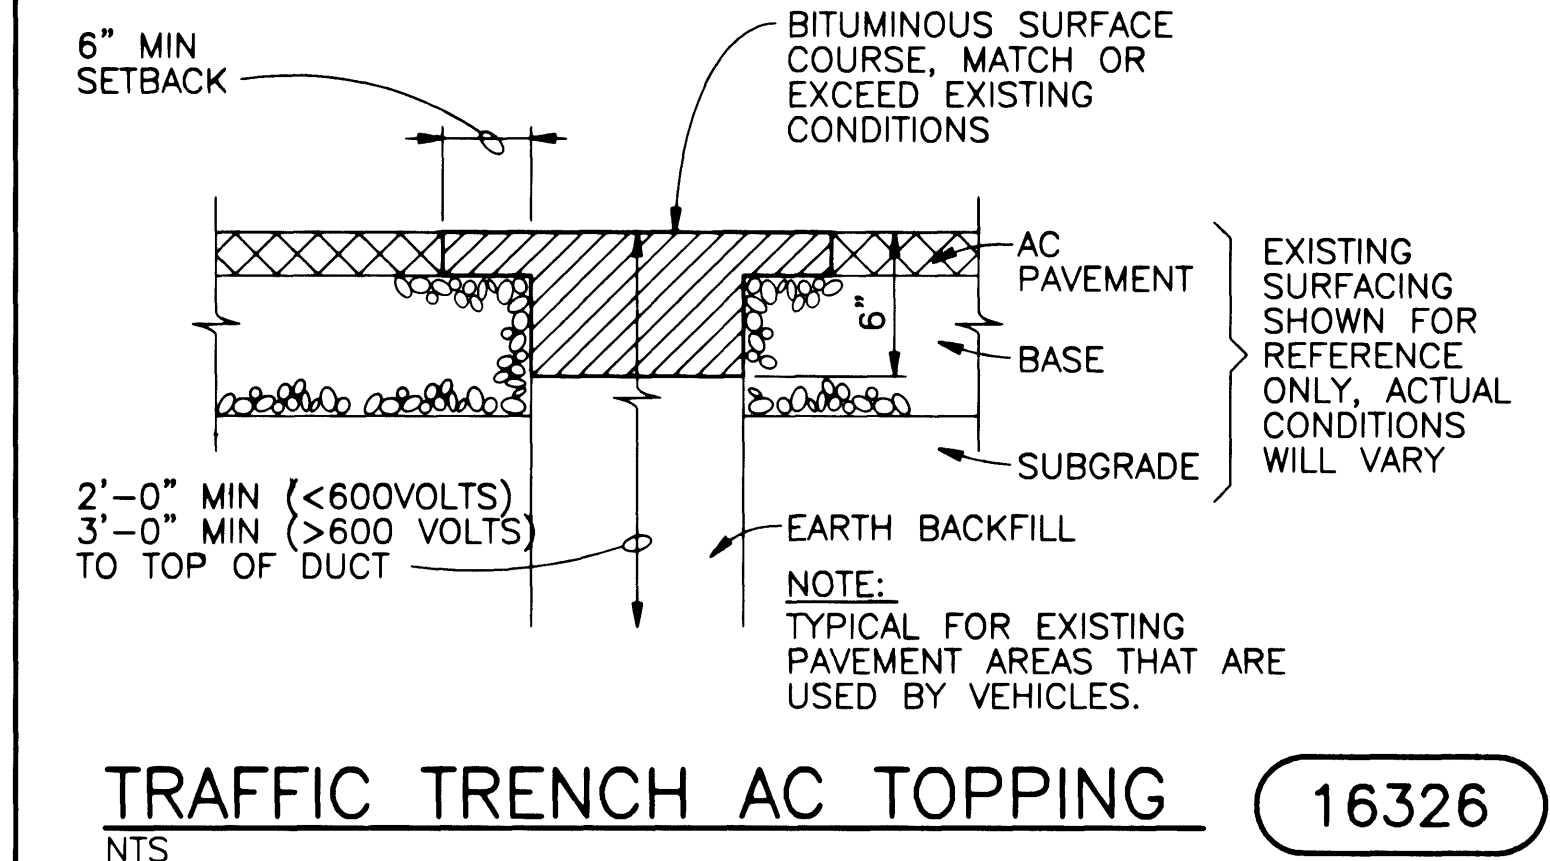
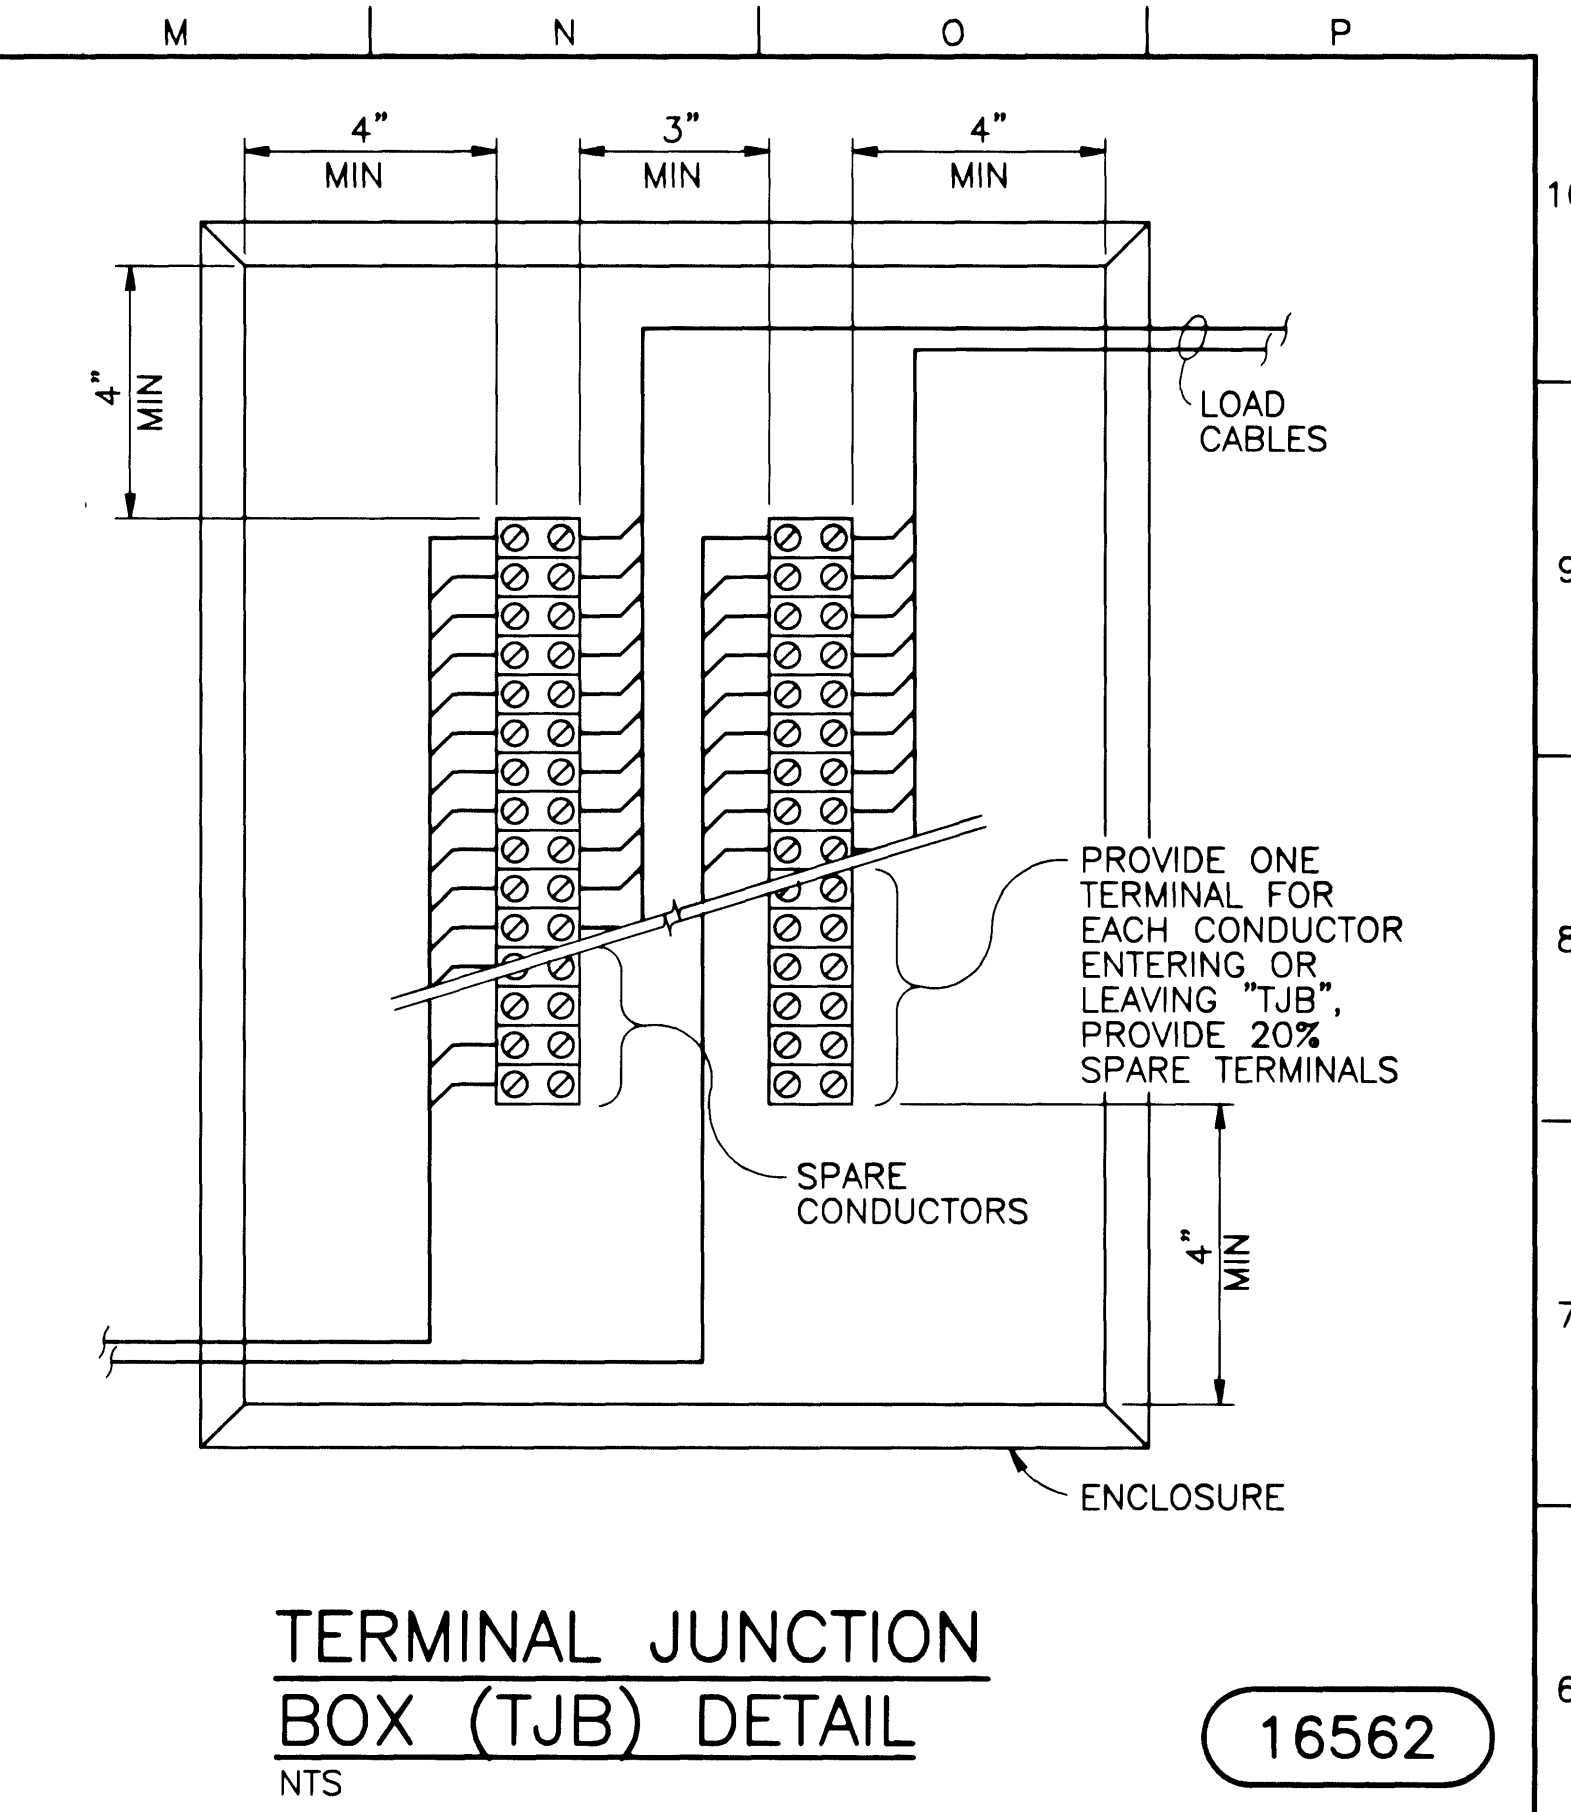
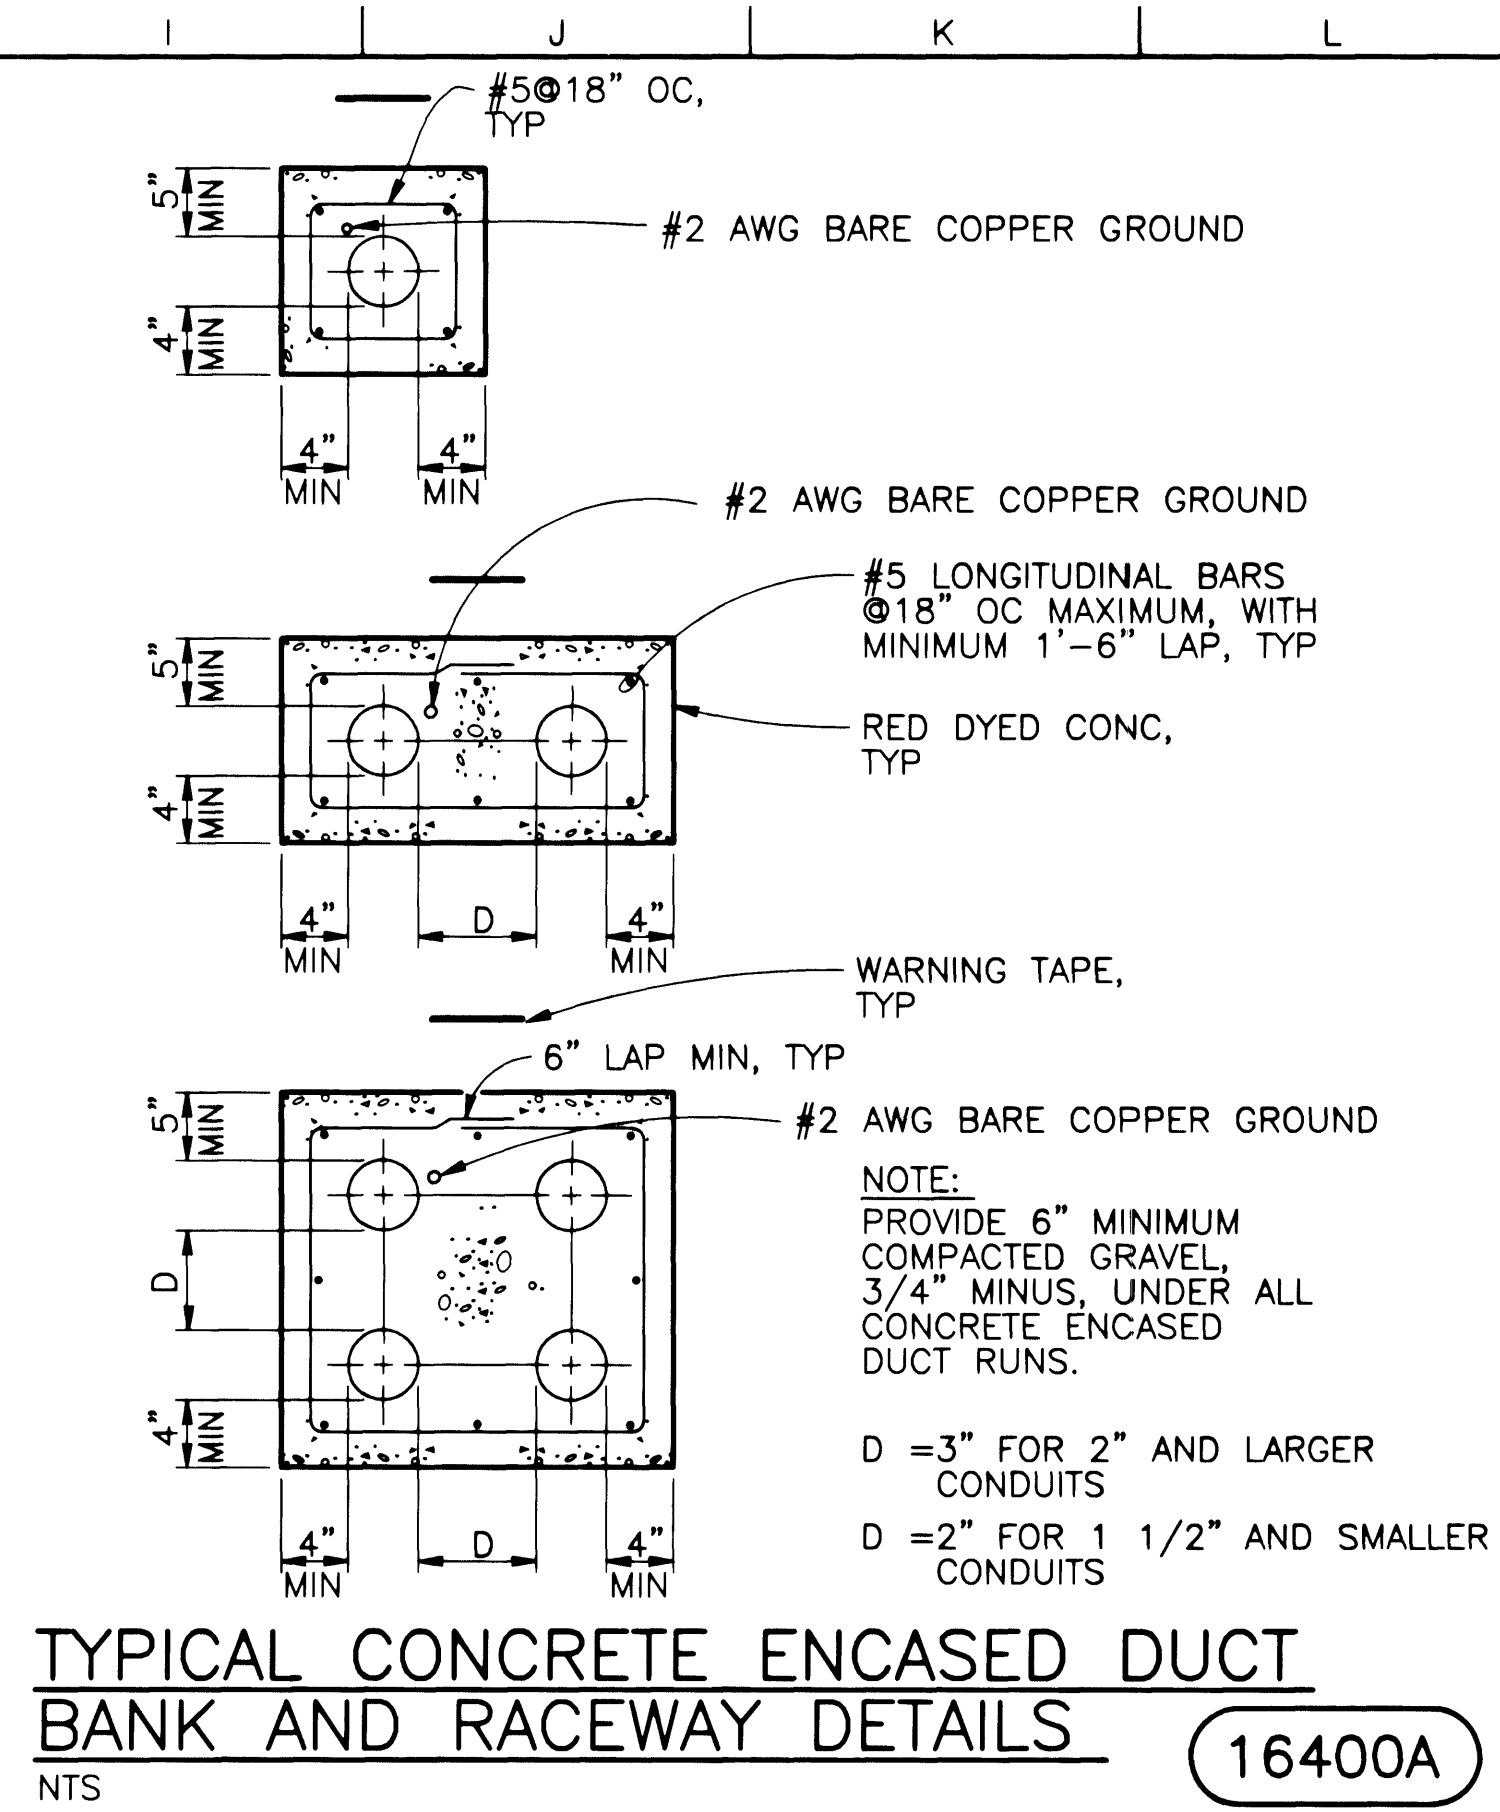
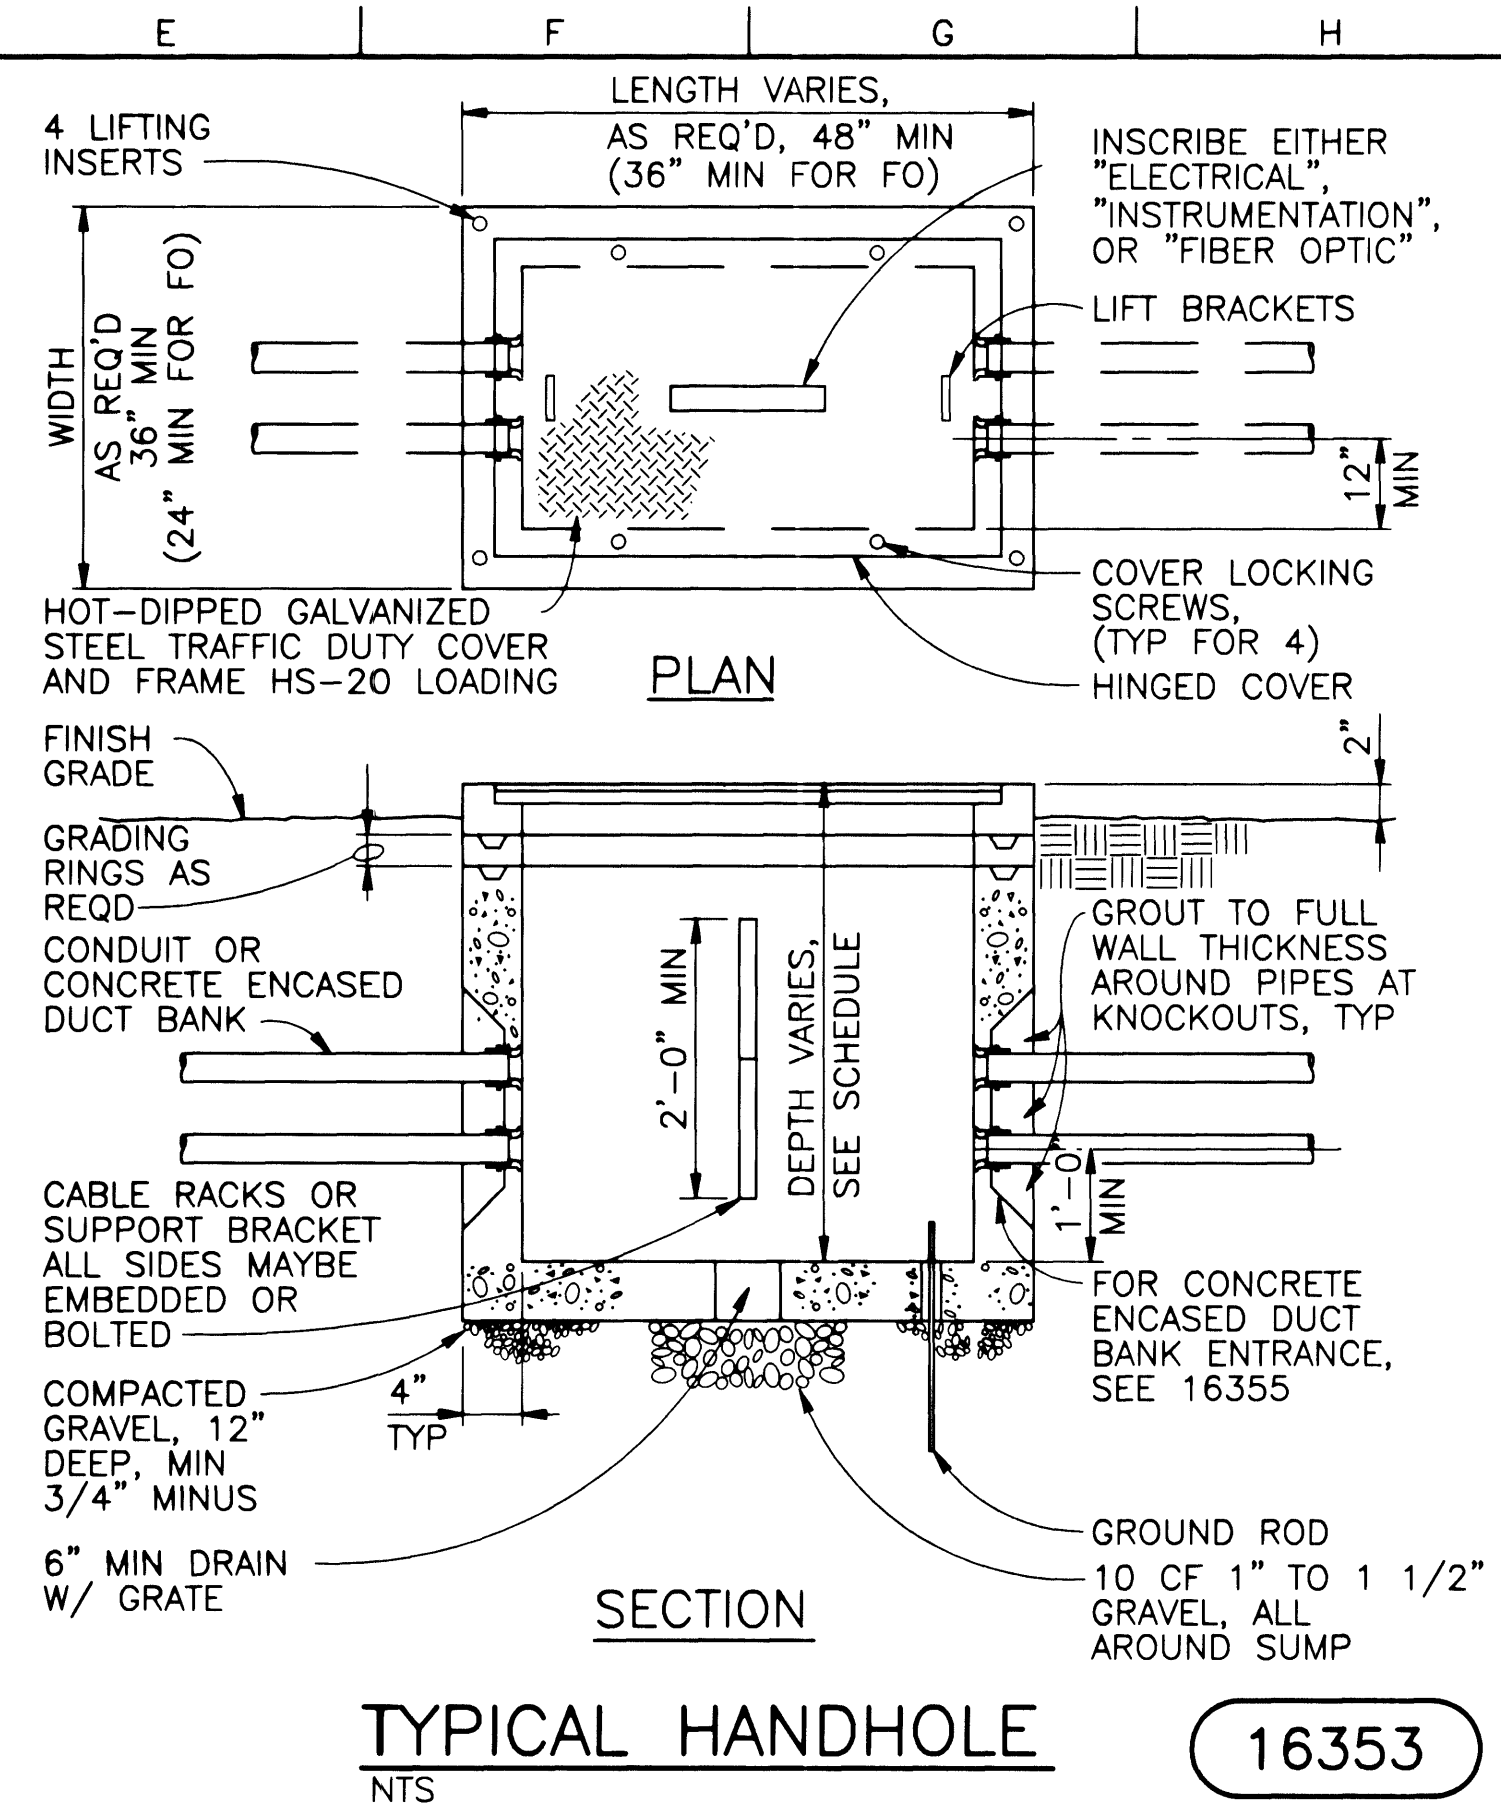


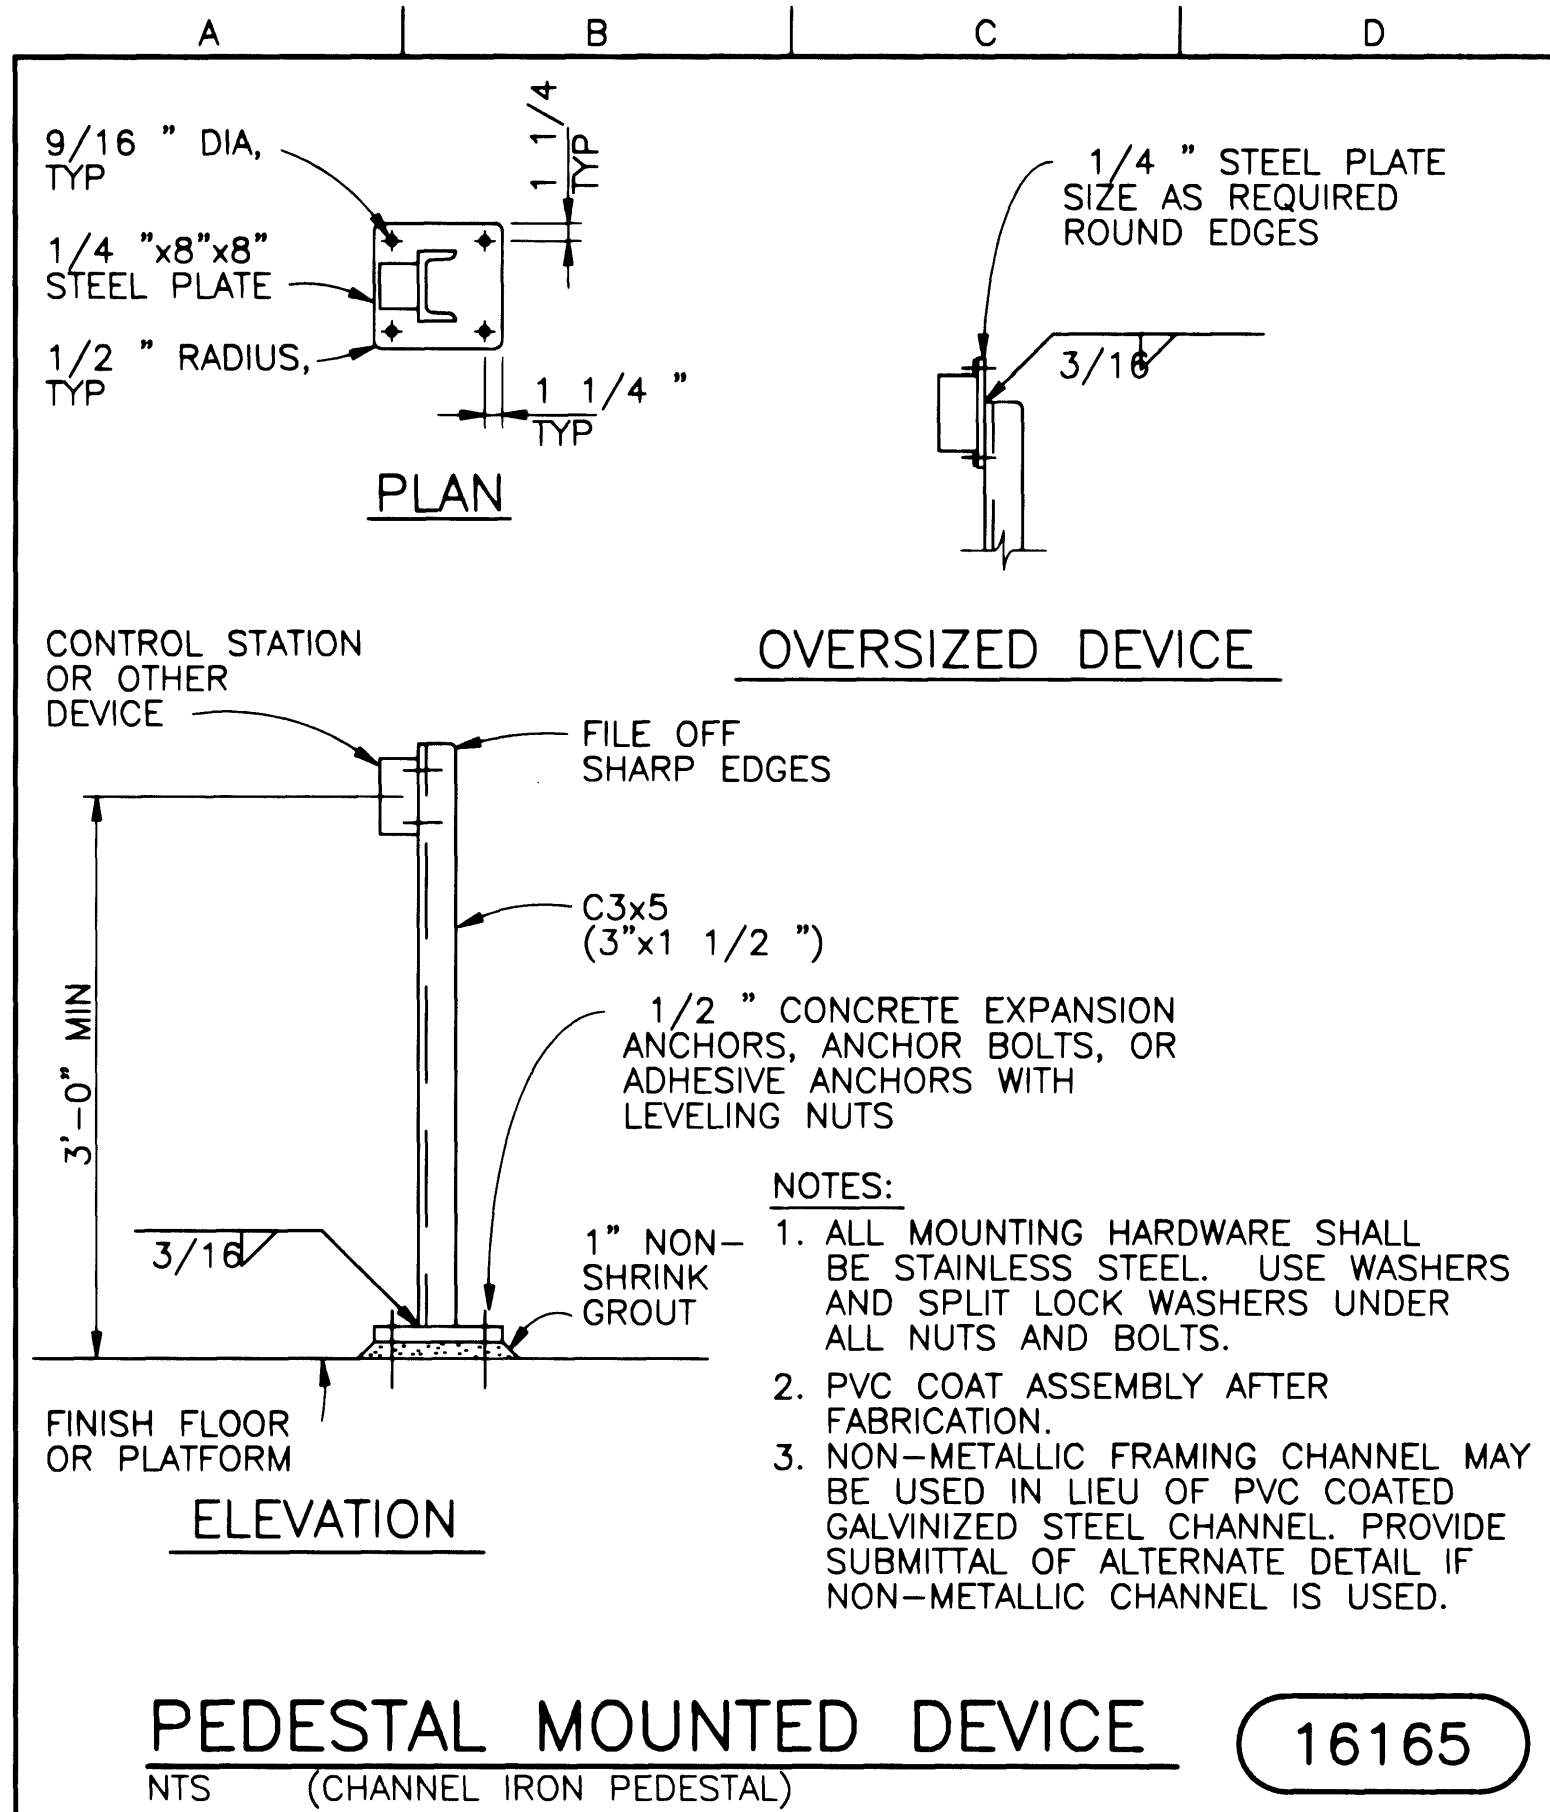

Issue No.	Description	Date	Drawn	Chkd.	Rev.	JH	BJ
39/81	RECORD DRAWING	7-31-01	BJ	BJ			

Professional Engineer - State of Nevada

JULIAN R. HOYLE

ELECTRICAL

REGISTERED PROFESSIONAL ENGINEER - STATE OF NEVADA

No. 12621

CH2M HILL

2000 E. FLAMINGO ROAD, SUITE A

LAS VEGAS, NV 89119

702.369.6175

HDR

HDR Engineering, Inc.

770 E. Warm Springs Road

Suite 360

Las Vegas, NV 89119

702-938-6000

Project Manager

B JOHNSON

Designed

J HOYLE

Checked

K VOLLMEYER

Drawn

B NORVILLE

City of Las Vegas

Water Pollution Control Facility

Plant Expansion

Contract 20 - Odor Control

STANDARD DETAILS

ELECTRICAL

Date

SEPTEMBER 1998

Project No.

00120-154-141

Scale

NTS

Drawing No.

ED-2

Sheet No.

76 of 76