


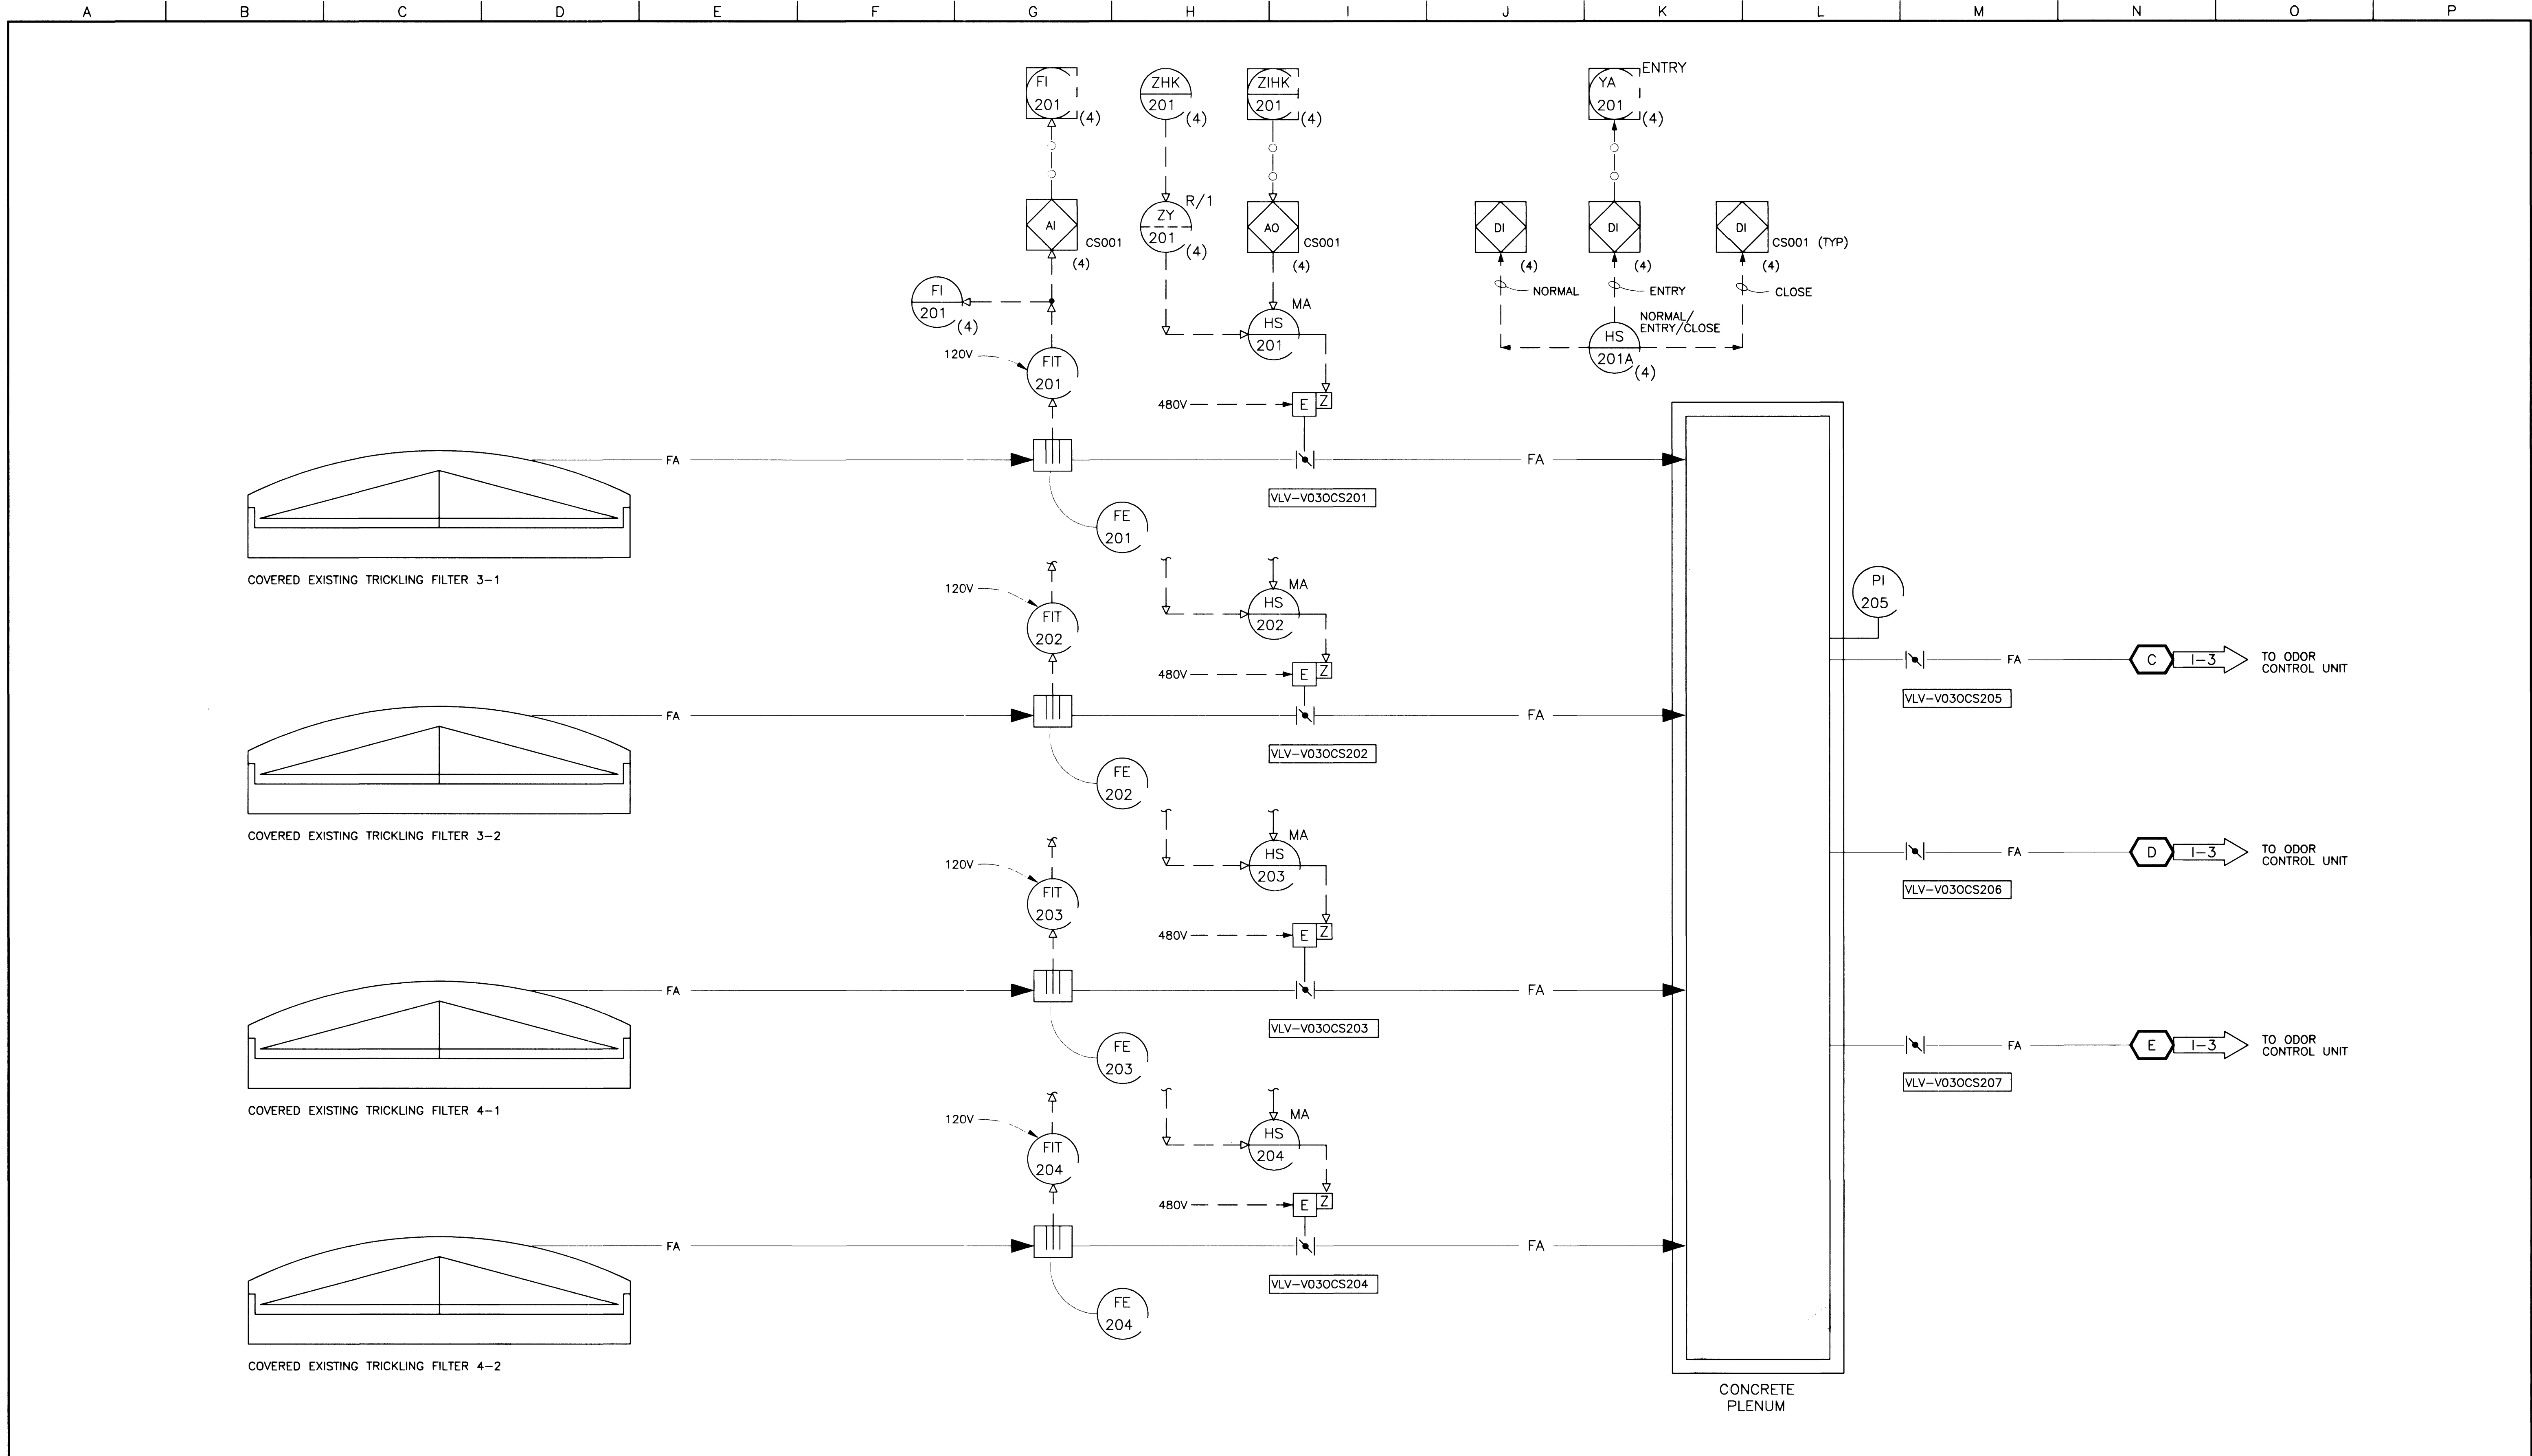

RECORD DRAWING		7-31-01	TUY	BJ		BJ
Issue No.	Description	Date	Drawn	Chkd.	Resp. Engr.	Proj. Mgr.
39/55						

CH2MHILL
2000 E. FLAMINGO ROAD,
SUITE A
LAS VEGAS, NV 89119
702.369.6175

HDR Engineering, Inc.
5280 S. EASTERN AVE., D1
LAS VEGAS, NV 89119
702.256.4895

Project Manager
B JOHNSON
Designed
W PEARSON
Designed
BJ
Checked
E VOLLRATH
Drawn
J PEPPEL

City of Las Vegas
Water Pollution Control Facility
Plant Expansion
Contract 20 - Odor Control

PROCESS INSTRUMENTATION AND CONTROLS
TRICKLING FILTER PLANTS 3 AND 4
FOUL AIR CONTROL

Date SEPTEMBER 1998	Project No. 00120-154-141	Scale NOT TO SCALE	Drawing No. 1-2	Sheet No. 50 of 76
------------------------	------------------------------	-----------------------	--------------------	-----------------------

C:\20-002\DWG
9-2-98