
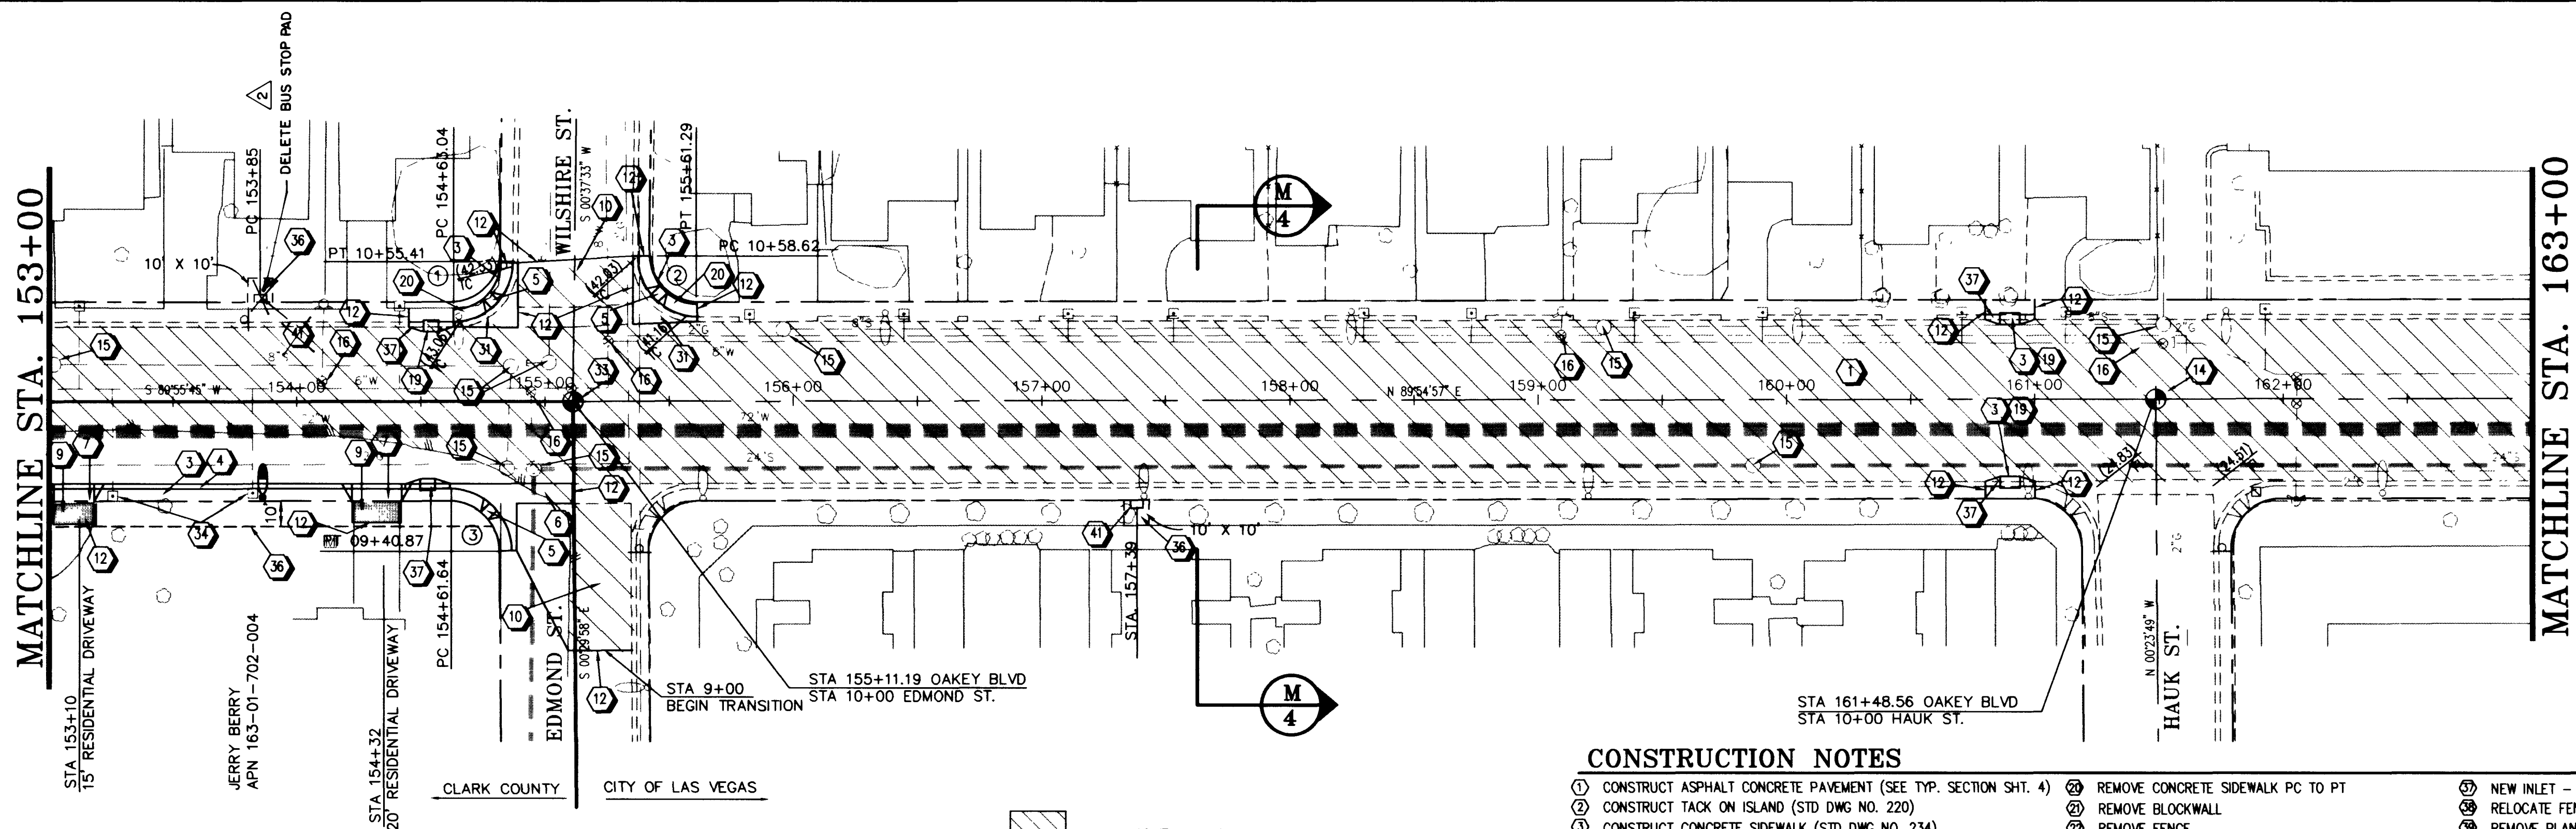


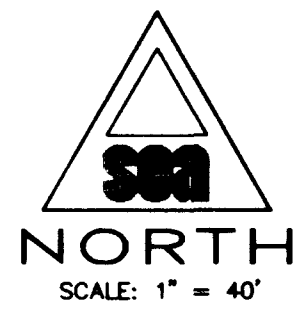


CURVE TABLE - BACK OF CURB					SIDEWALK RAMP DIMENSIONS	
NUMBER	RADIUS	DELTA	TANGENT	LENGTH	'A'	'B'
1	24'	89°18'12"	23.71'	37.40'	8.0'	8.0'
2	24'	90°42'36"	24.29'	37.99'	9.5'	4.5'
3	25'	89°34'17"	24.81'	39.08'	8.0'	8.0'

OAKEY BOULEVARD


HORIZONTAL SCALE 1"=40'
VERTICAL SCALE 1"=10'

CONSTRUCTION NOTES

1. CONSTRUCT ASPHALT CONCRETE PAVEMENT (SEE TYP. SECTION SHT. 4)
2. CONSTRUCT TACK ON ISLAND (STD DWG NO. 220)
3. CONSTRUCT CONCRETE SIDEWALK (STD DWG NO. 234)
4. CONSTRUCT L-TYPE CURB AND GUTTER (STD DWG NO. 216)
5. CONSTRUCT SIDEWALK RAMP (STD DWG NO. 235)
6. CONSTRUCT CROSS GUTTER (STD DWG NO. 228)
7. CONSTRUCT RESIDENTIAL DRIVEWAY (STD DWG NO. 223)
8. CONSTRUCT COMMERCIAL DRIVEWAY
9. CONSTRUCT 8' DRIVEWAY TRANSITION (MATCH EXISTING SURFACE)
10. CONSTRUCT TRANSITION PAVEMENT 2" AC OVER 6" TYPE II AGG. BASE
11. CONSTRUCT RETAINING WALL
12. SAWCUT AND MATCH EXISTING
13. SET NEW SURVEY MONUMENT, TYPE I (STD DWG NO. 239)
14. SET NEW SURVEY MONUMENT, TYPE III (STD DWG NO. 241)
15. ADJUST EXISTING MANHOLE (STD DWG NO. 403-408)
16. ADJUST EXISTING WATER VALVE (STD DWG NO. 517)
17. ADJUST UTILITY VAULT OR PULL BOX
18. REMOVE ASPHALT CONCRETE PAVEMENT
19. REMOVE L-TYPE CURB AND GUTTER
20. REMOVE CONCRETE SIDEWALK PC TO PT
21. REMOVE BLOCKWALL
22. REMOVE FENCE
23. REMOVE CROSS GUTTER
24. RELOCATE FIRE HYDRANT (MIN. 20' FROM CURB RETURN)
25. RELOCATE MAIL BOX
26. REMOVE TREE
27. NO CONSTRUCTION EASEMENT
28. RELOCATE WATER METER
29. RELOCATE STREET LIGHT (SEE TRAFFIC SHTS)
30. RELOCATE TRAFFIC SIGN (SEE TRAFFIC SHTS)
31. REMOVE & REPLACE CROSS GUTTER SPANDREL TO ACCOMMODATE NEW WHEELCHAIR RAMP
32. SAWCUT
33. SET NEW SURVEY MONUMENT TYPE IIB (STD DWG NO. 240)
34. ADJUST WATER METER
35. CONSTRUCT TRANSITION PAVEMENT 4" AC OVER 6" TYPE II AGG. BASE FROM END OF RETURN
36. TEMPORARY CONSTRUCTION EASEMENT
37. NEW INLET - SEE STORM DRAIN SHEET
38. RELOCATE FENCE TO NEW R/W
39. REMOVE PLANTER WALL
40. RECONSTRUCT BLOCK WALL
41. CONSTRUCT 3'X5' BUS STOP PAD (STD DWG #234)
42. EXIST POWER POLE TO BE RELOCATED BY NEVADA POWER
43. REMOVE/RECONSTRUCT BLOCK-WALL - W/ WROUGHT-IRON ORNAMENT
44. INSTALL 6" WATER LINE INCLUDING 8" X 6" TAPPING TEE AND 6" VALVE
45. INSTALL 4" SEWER SERVICE WITH INVERT AT 4' BELOW GRADE AT PROPERTY LINE.

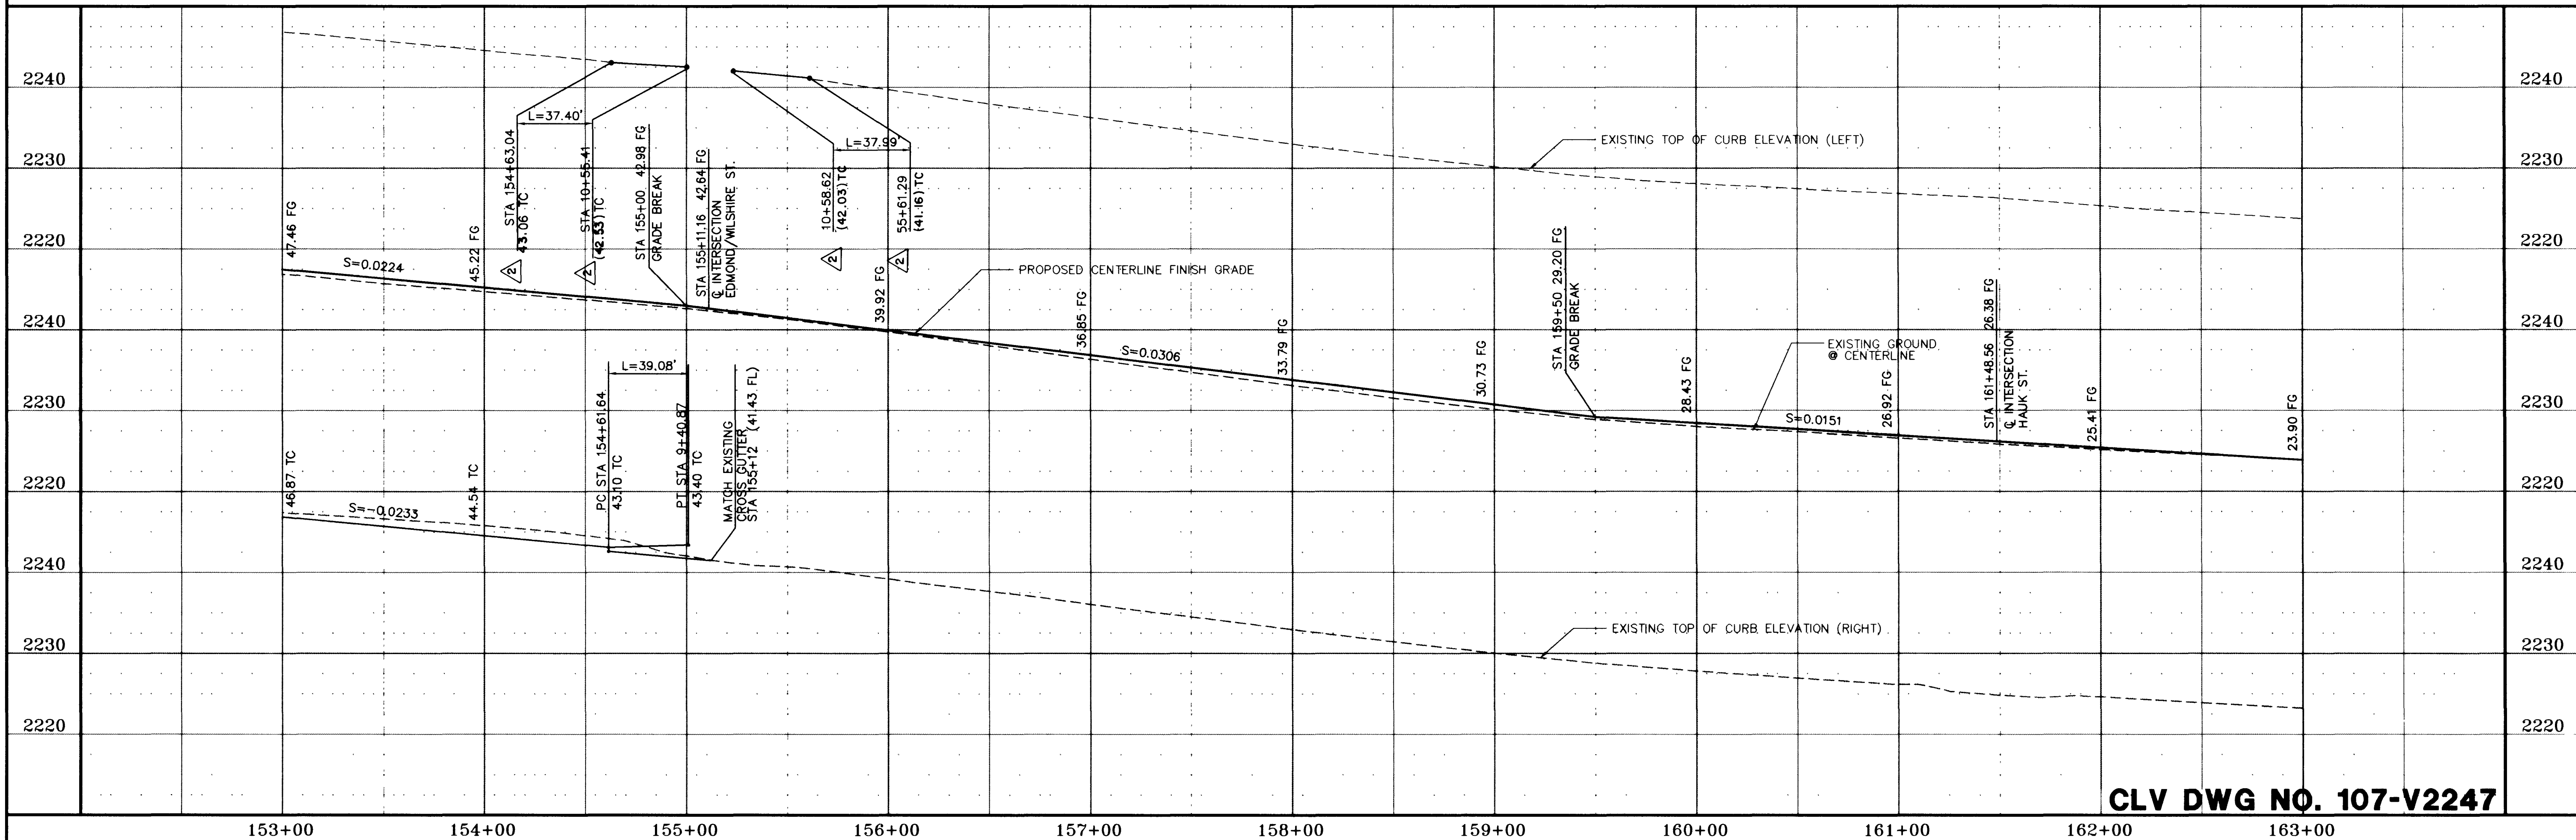

CLV DWG NO. 107-V2247

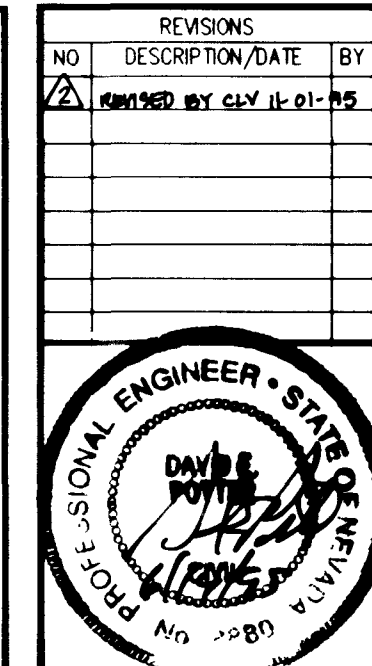

1100 GRIER DRIVE
LAS VEGAS, NEVADA 89119
PHONE (702) 361-9050
FAX (702) 361-0659
CONSULTING ENGINEERS

NEVADA

ROADWAY PLAN AND PROFILE
FROM STA. 153+00 TO STA. 163+00
OAKEY BOULEVARD
RAINBOW BLVD. TO DECATUR BLVD.

CITY OF LAS VEGAS
CLARK COUNTY

JOB NO. 2-241-073
ACAD FILE OAKEPP10
DESIGNED: DP
DRAWN: TL
CHECKED: DP
DATE: JUNE 1995

C10

18 OF 62 SHEETS

