


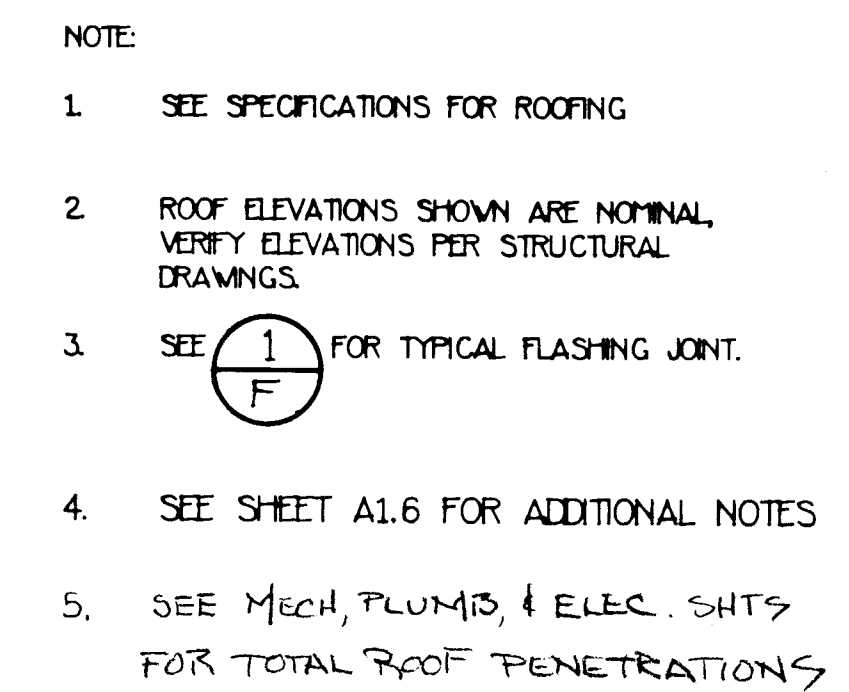

AS-BUILT 12-15-89  
Richardson Const. Inc.