


RECORD OF SURVEY MONUMENT TIE MAP

MONUMENT REPLACEMENT IN THE NORTHWEST QUARTER OF SECTION 34,
TOWNSHIP 20 SOUTH, RANGE 61 EAST, M.D.M.
IN THE LEWIS AVENUE CORRIDOR IMPROVEMENTS
FEDERAL PROJECT NUMBER STP-0170(075)

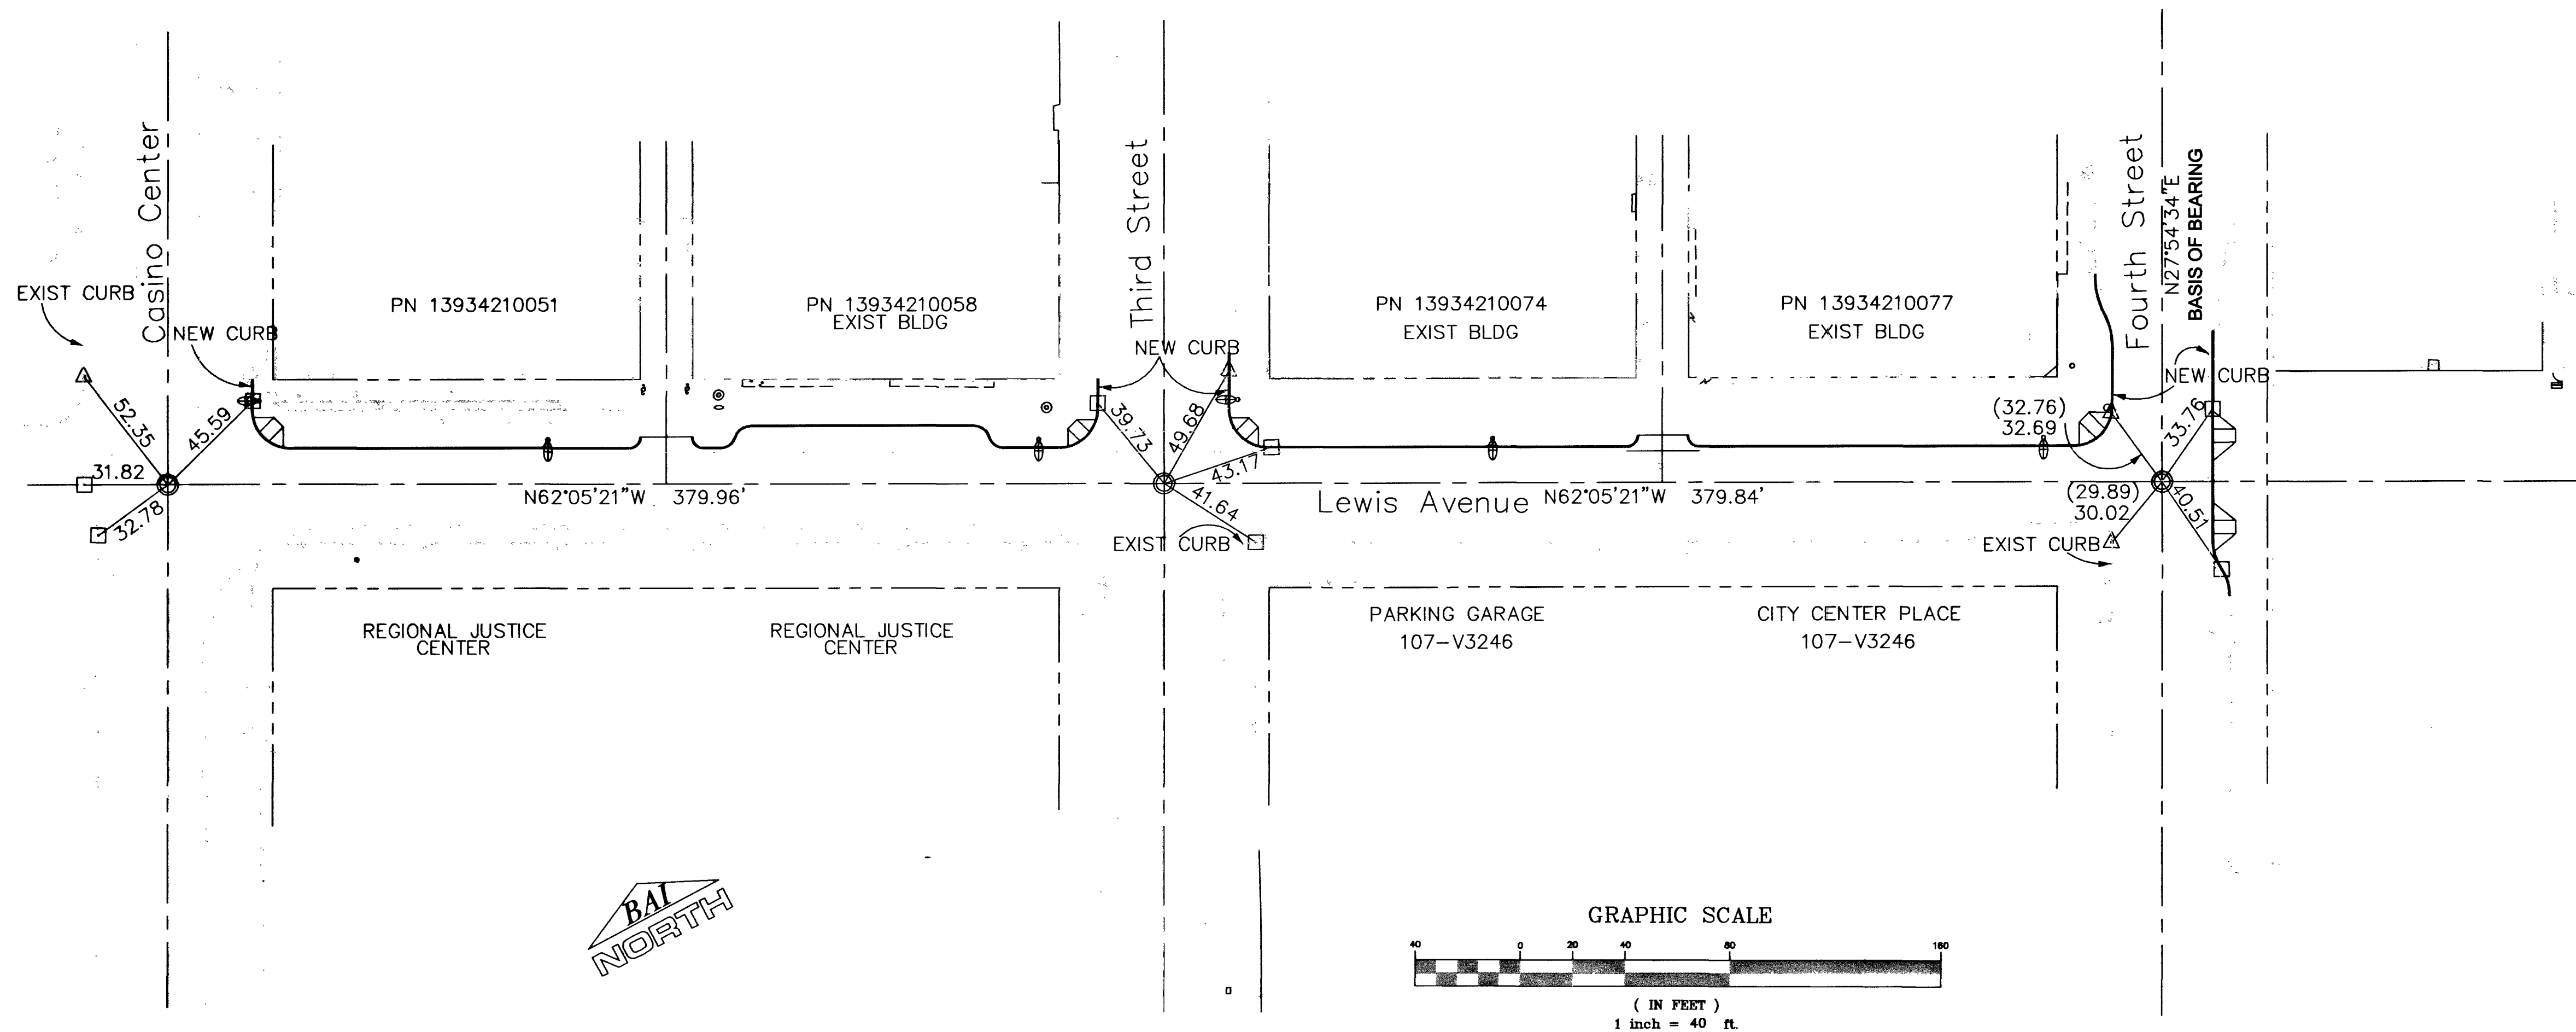

SURVEYOR'S CERTIFICATE

I, ANTONIO BARAJAS, A PROFESSIONAL LAND SURVEYOR REGISTERED IN THE STATE OF NEVADA, CERTIFY THAT:

1. THIS MAP REPRESENTS THE RESULT OF A FIELD SURVEY TO REPLACE CENTERLINE MONUMENTS LOST DUE TO CONSTRUCTION HEREON, CONDUCTED UNDER MY DIRECT SUPERVISION AT THE INSTANCE OF THE CITY OF LAS VEGAS.
2. THE LANDS SURVEYED LIE WITHIN SECTION 34, TOWNSHIP 20 SOUTH, RANGE 61 EAST, M.D.M., AND THE SURVEY WAS COMPLETED ON NOV 15, 2002.
3. THIS MAP COMPLIES WITH THE APPLICABLE STATE STATUTES AND ANY LOCAL ORDINANCES IN EFFECT ON THE DATE THAT THE SURVEY WAS COMPLETED AND WAS PERFORMED IN ACCORDANCE WITH THE NEVADA ADMINISTRATIVE CODE STANDARDS OF PRACTICE FOR PROFESSIONAL LAND SURVEYORS.
4. THE MONUMENTS DEPICTED ON THIS MAP ARE OF THE CHARACTER SHOWN, OCCUPY THE POSITIONS INDICATED, AND ARE OF SUFFICIENT NUMBER AND DURABILITY.
5. THIS MAP SHOWS ONLY TIES TO MONUMENTS THAT HAVE BEEN REPLACED TO THEIR ORIGINAL POSITION.

LEGEND

- SET TYPE II MONUMENT, RLS 11585.
- SET TYPE IV TIE MONUMENT, RLS 11585.
- △ FOUND TYPE IV TIE MONUMENT.
- — — — — CENTERLINE.
- - - - - RIGHT OF WAY

RECORDER'S NOTE

ANY SUBSEQUENT CHANGES TO THIS MAP SHOULD BE EXAMINED AND MAY BE DETERMINED BY REFERENCE TO THE COUNTY RECORDER'S CUMULATIVE MAP INDEX, NRS 278.6695

BASIS OF BEARINGS

CENTERLINE OF FOURTH STREET, BEARS N27°54'34\"/>

SURVEYORS NOTE:
NO ATTEMPT WAS MADE TO CORRECT POSITION OF MONUMENTS SET, ONLY TO RESET MONUMENTS LOST DUE TO CONSTRUCTION IN THEIR ORIGINAL POSITIONS.

FPN STP-0170(075)

RECORD OF SURVEY MONUMENT TIE MAP

MONUMENT REPLACEMENT IN THE NORTHWEST QUARTER OF SECTION 34,
TOWNSHIP 20 SOUTH, RANGE 61 EAST, M.D.M.
IN THE LEWIS AVENUE CORRIDOR IMPROVEMENTS
FEDERAL PROJECT NUMBER STP-0170(075)

BARAJAS AND ASSOCIATES INC.

8260 W. CHARLESTON BLVD.
LAS VEGAS, NV 89117
702-360-4477

INST. _____
FILED AT THE REQUEST OF:
BARAJAS AND ASSOC. INC.
DATE _____ AT _____
FILE _____ PAGE _____
SURVEYS
OFFICIAL RECORDS
BOOK _____
CLARK COUNTY NEVADA RECORDS
FRANCES DEANE — RECORDER
FEE _____ DEPUTY _____

ANTONIO BARAJAS, PLS
NEVADA CERTIFICATE NO. 11585

