

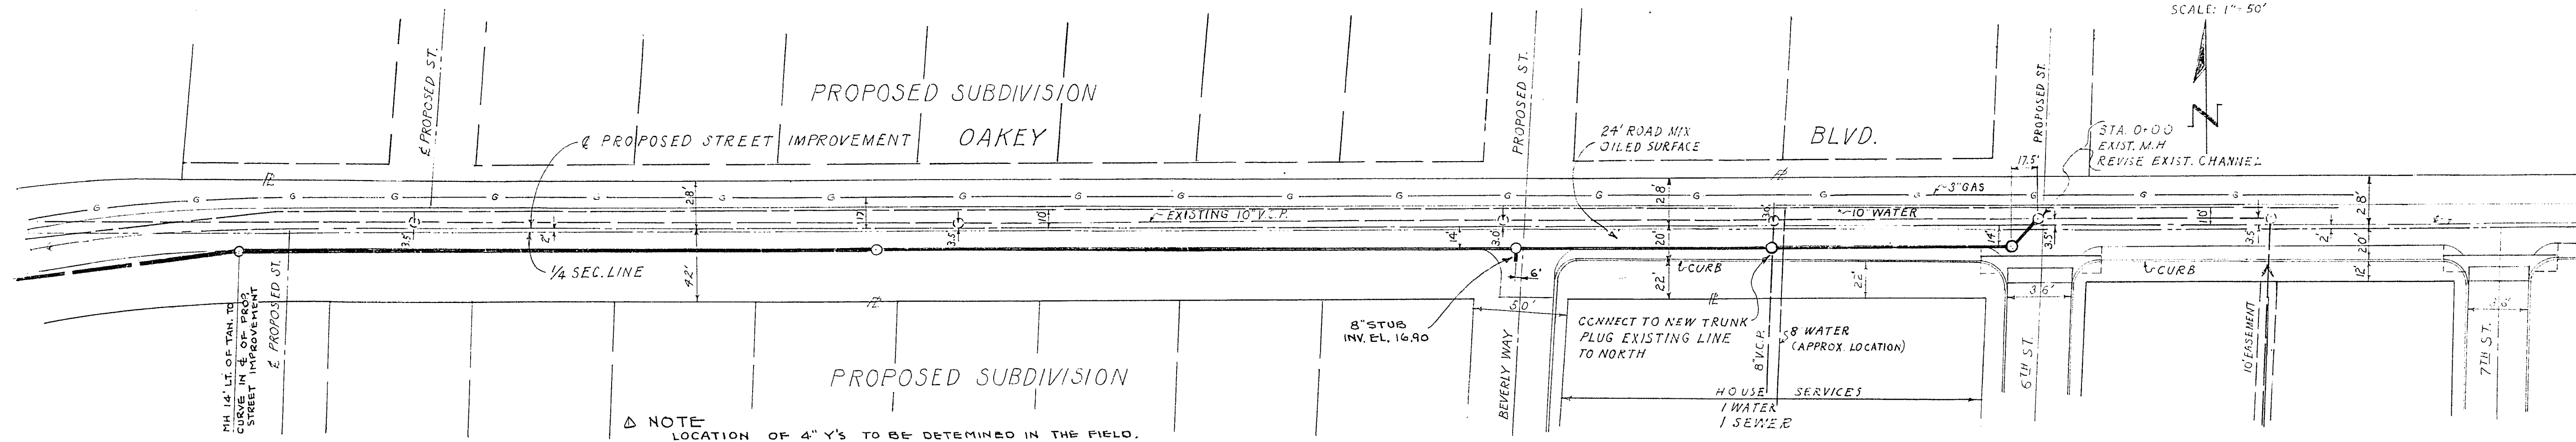


B.M. ELEV. 3033.00
TOP JONES F.H. @ 4TH ST.

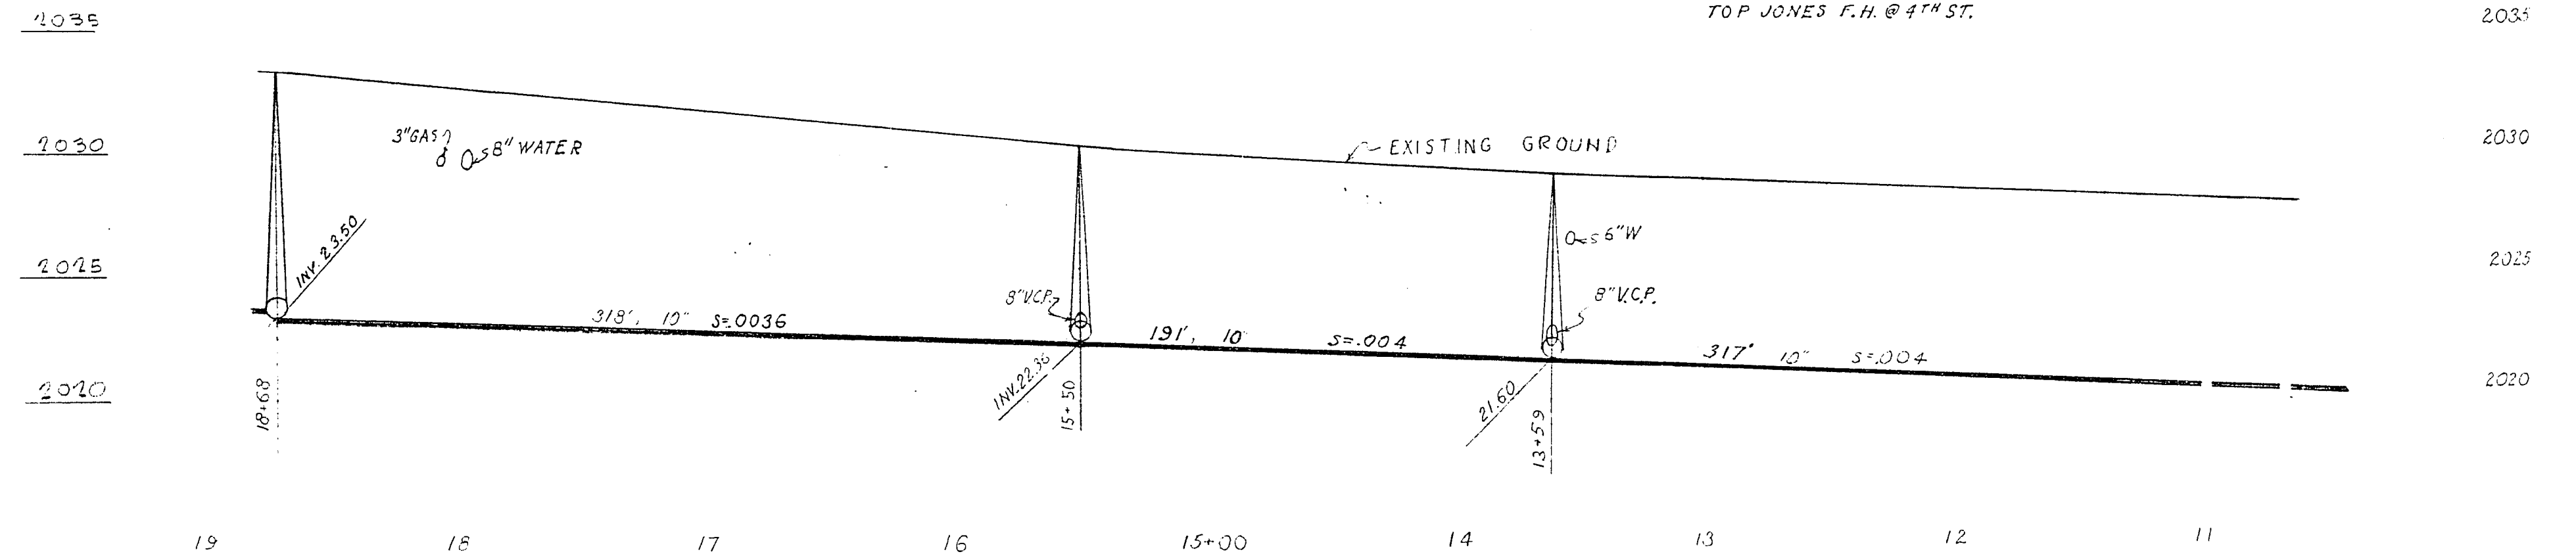

NOTE
LOCATION OF 4\"/>

Δ AUG. 1953 - RELOCATED
M.H.'S. BTWN STA 11+59 &
STA. 13+59

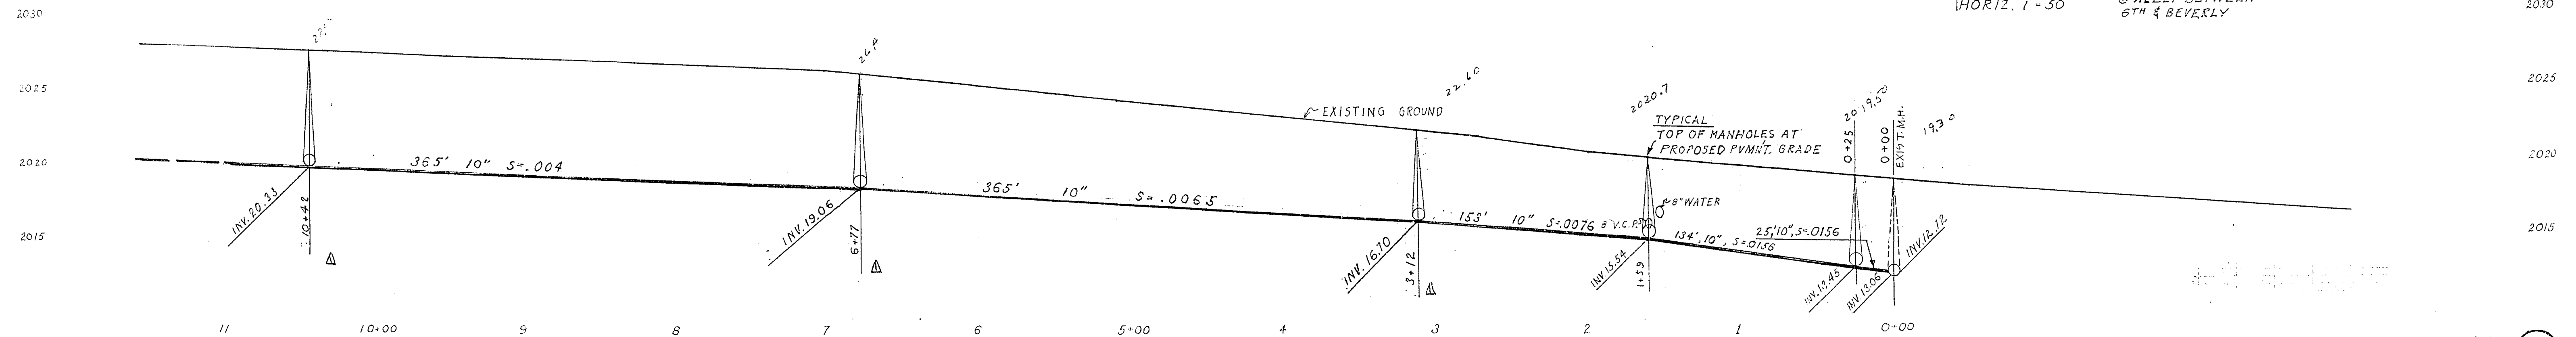

SCALE: VERT. 1\"/>

B.M. ELEV. 2023.34
TOP MUELLER F.H.
ALLEY BETWEEN
6TH & BEVERLY

OAKLEY BLVD. TRUNK

307.W148