
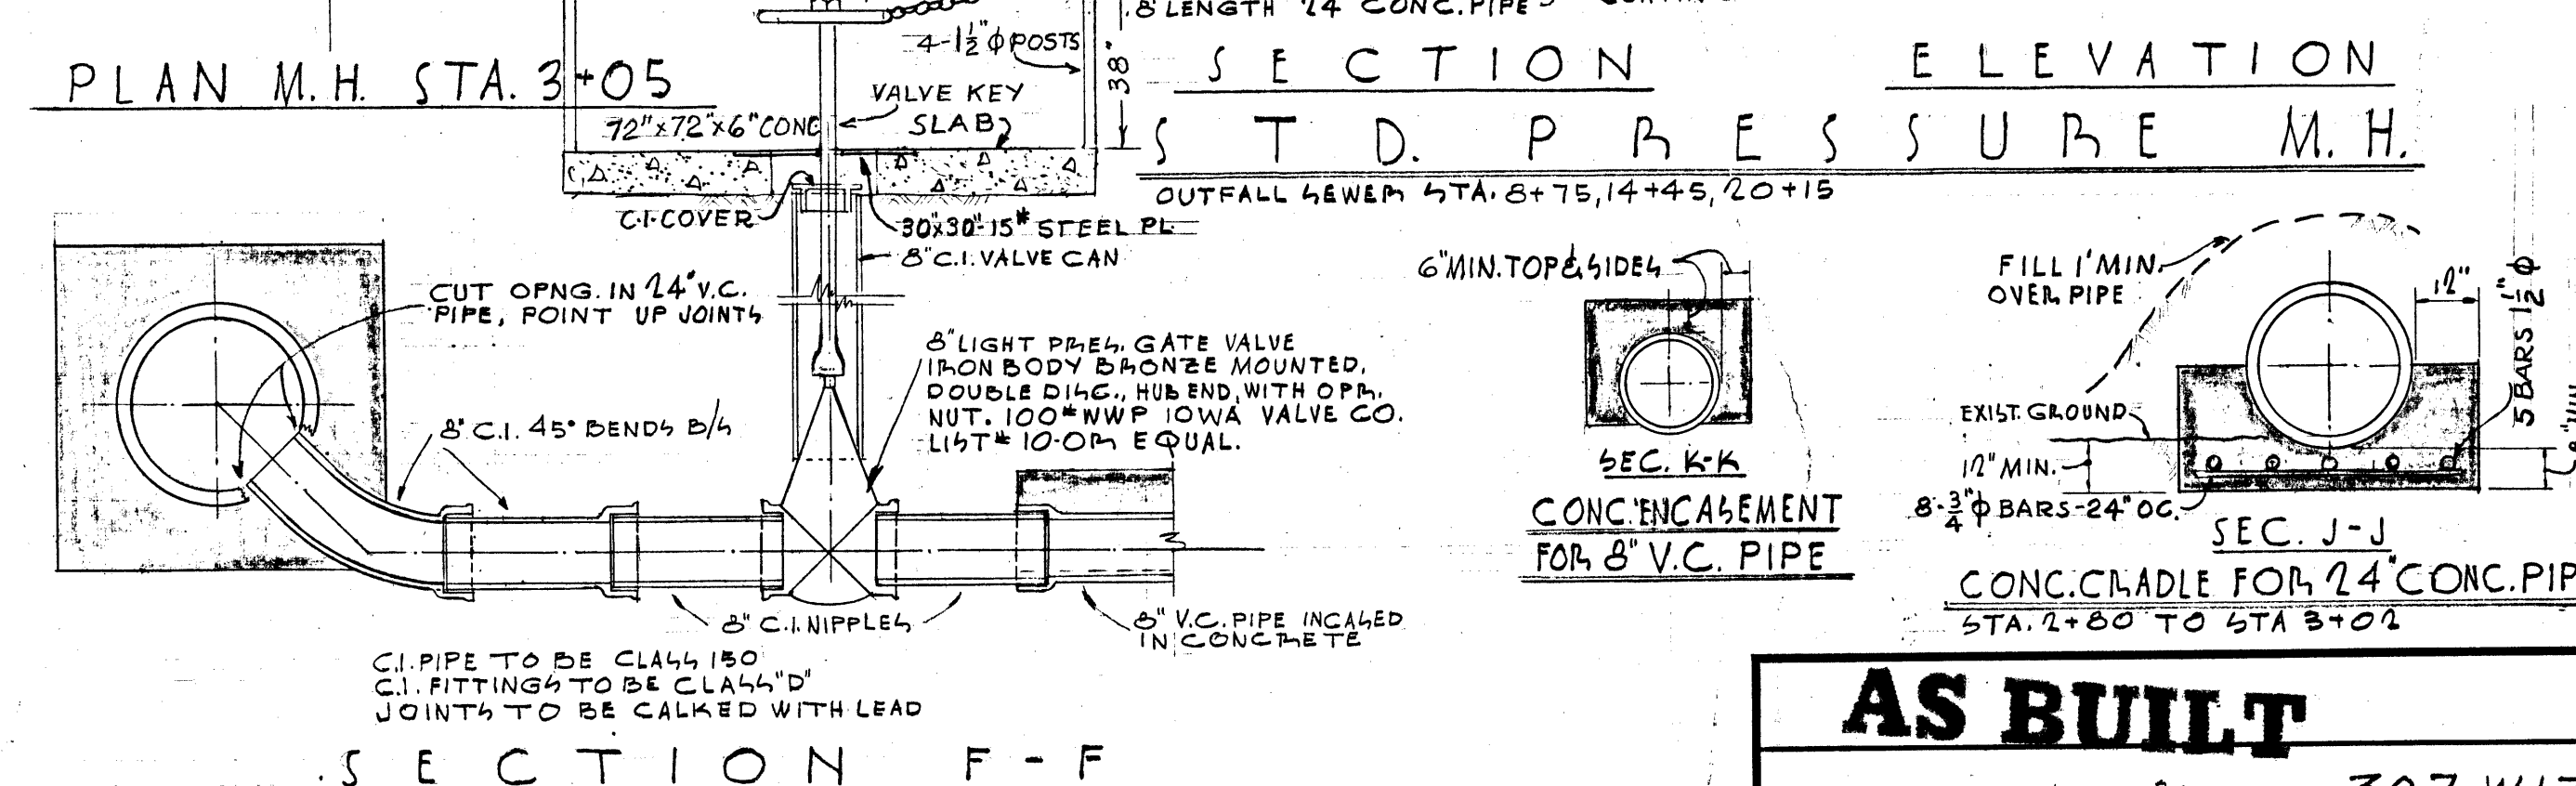
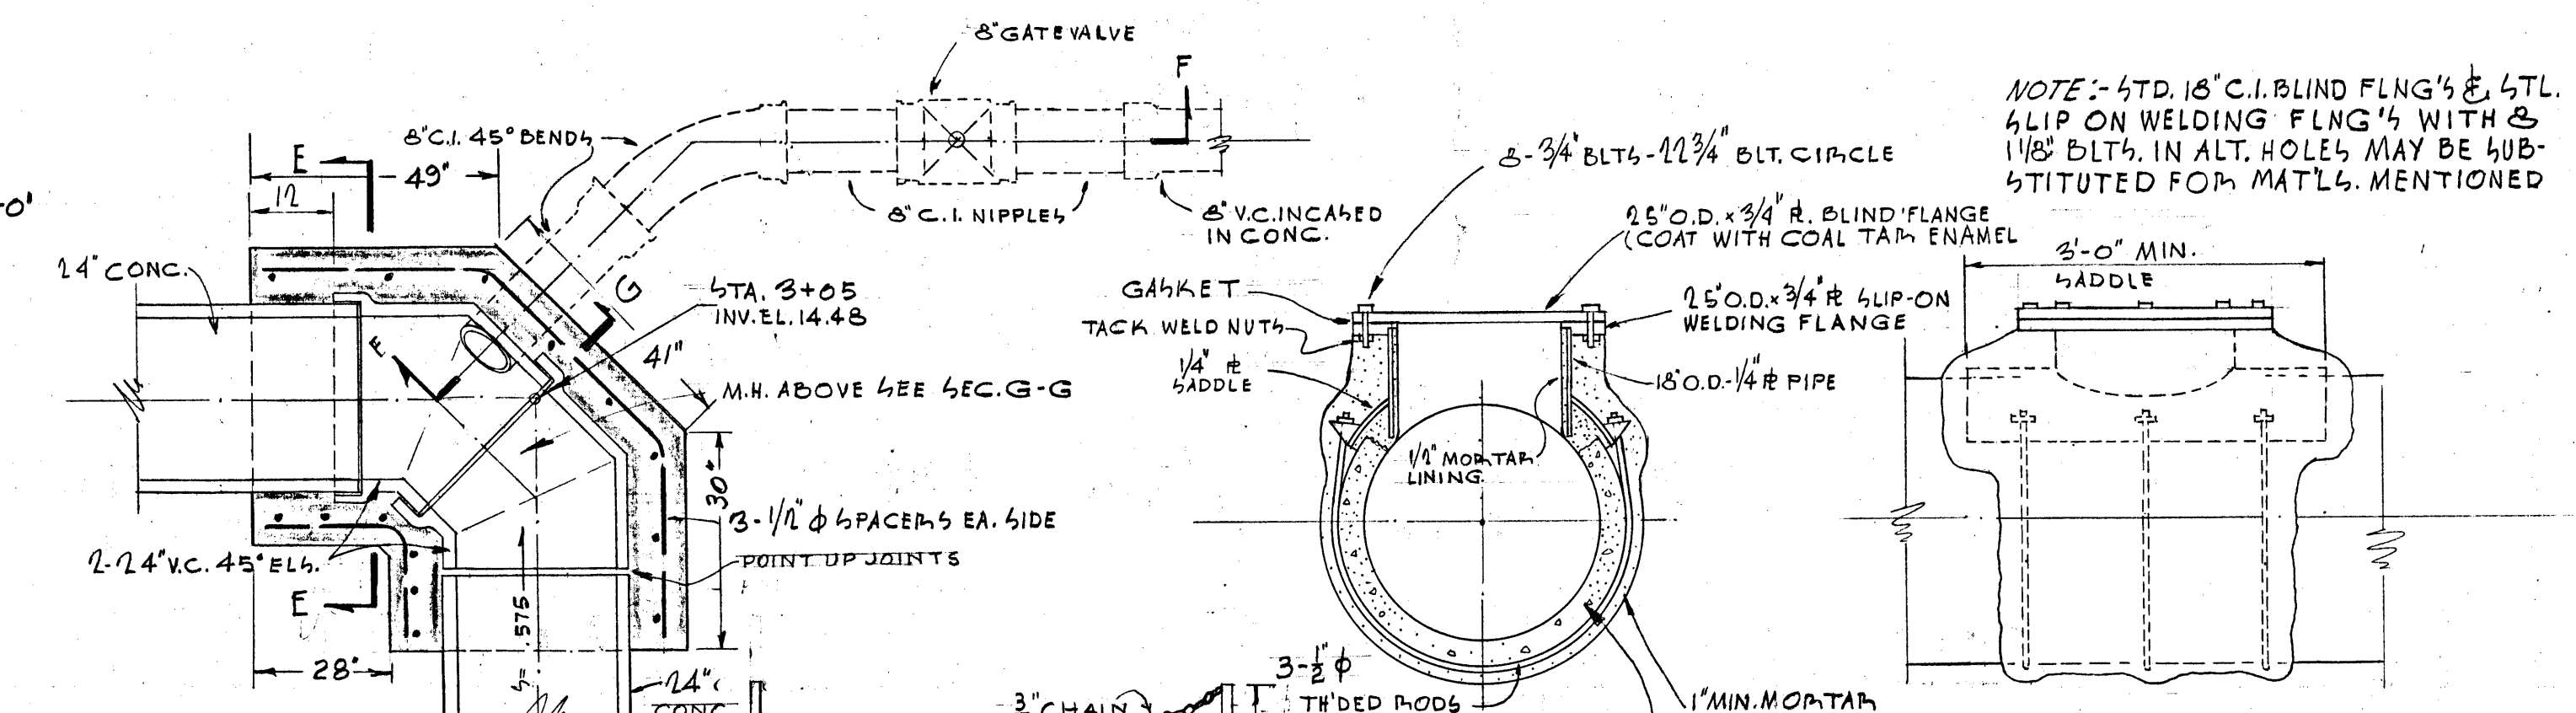
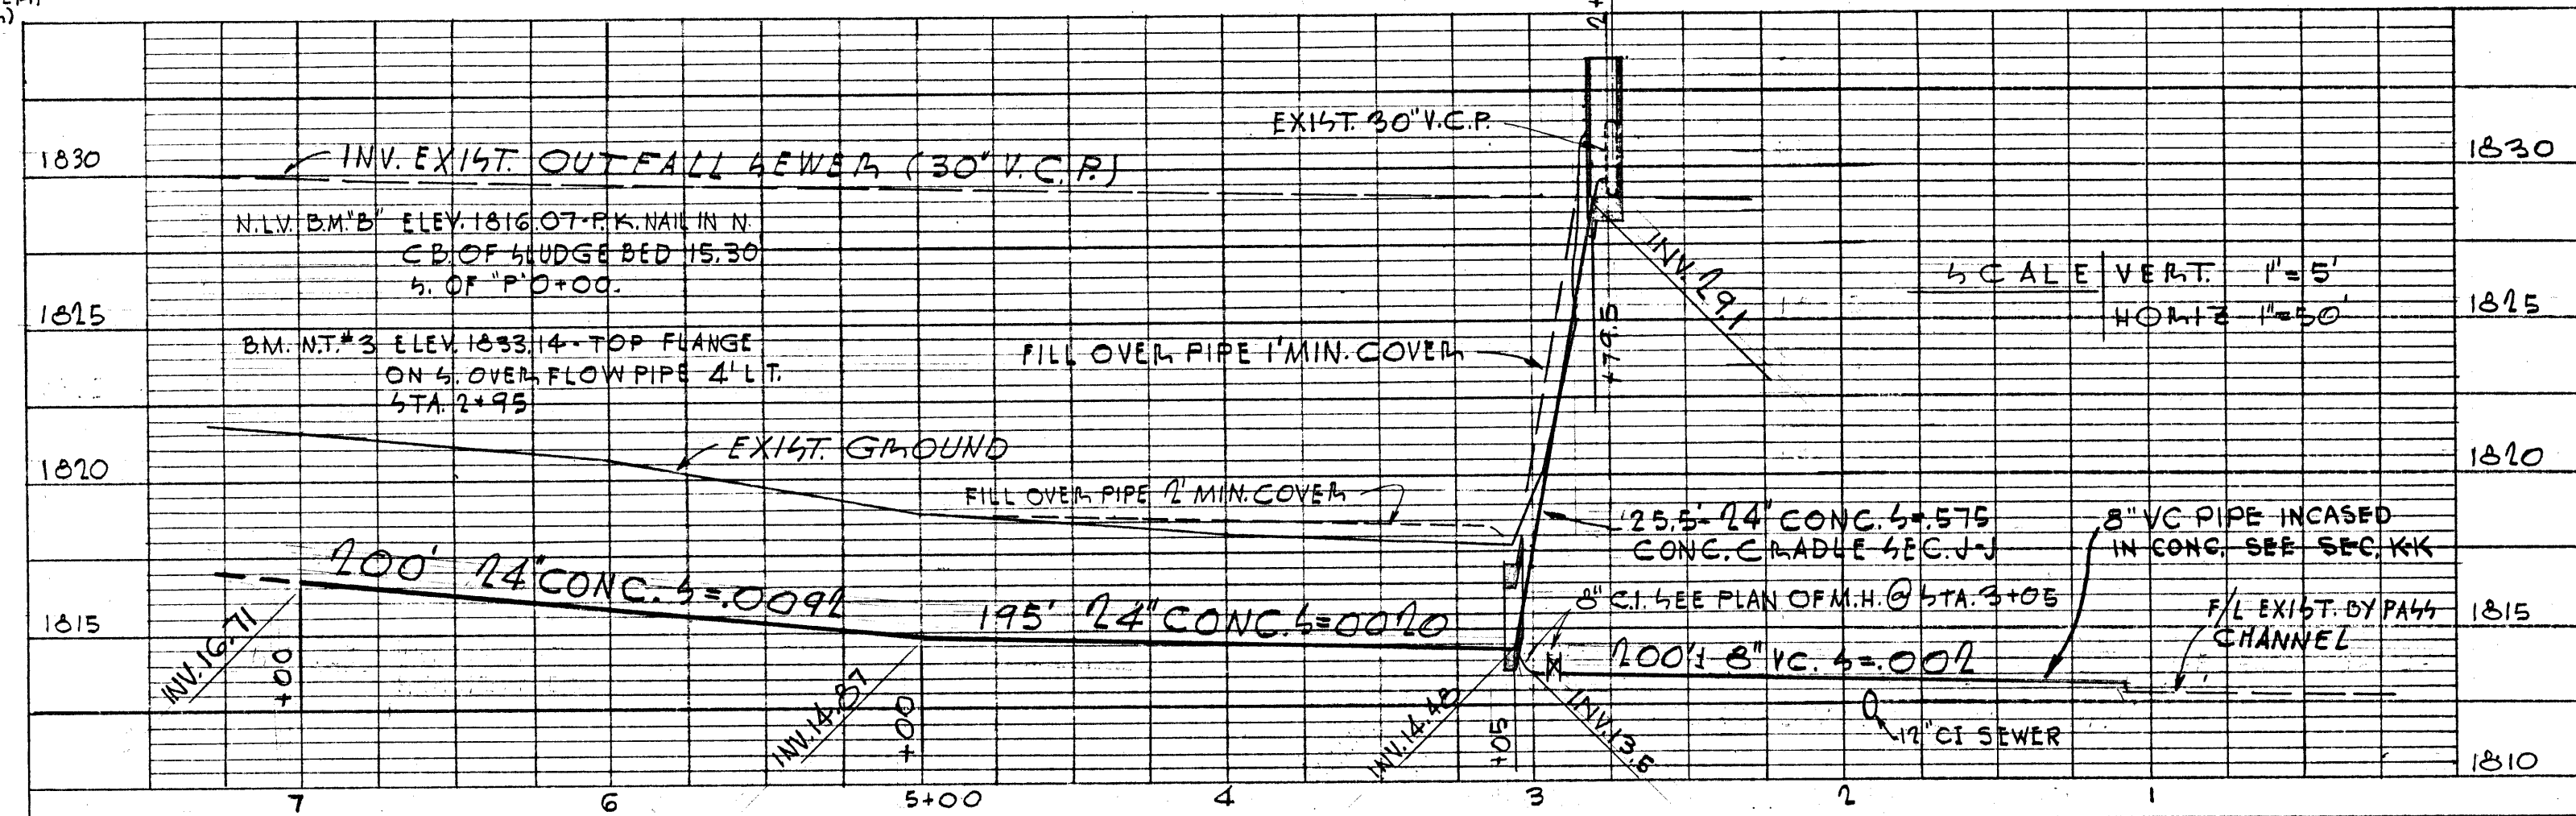
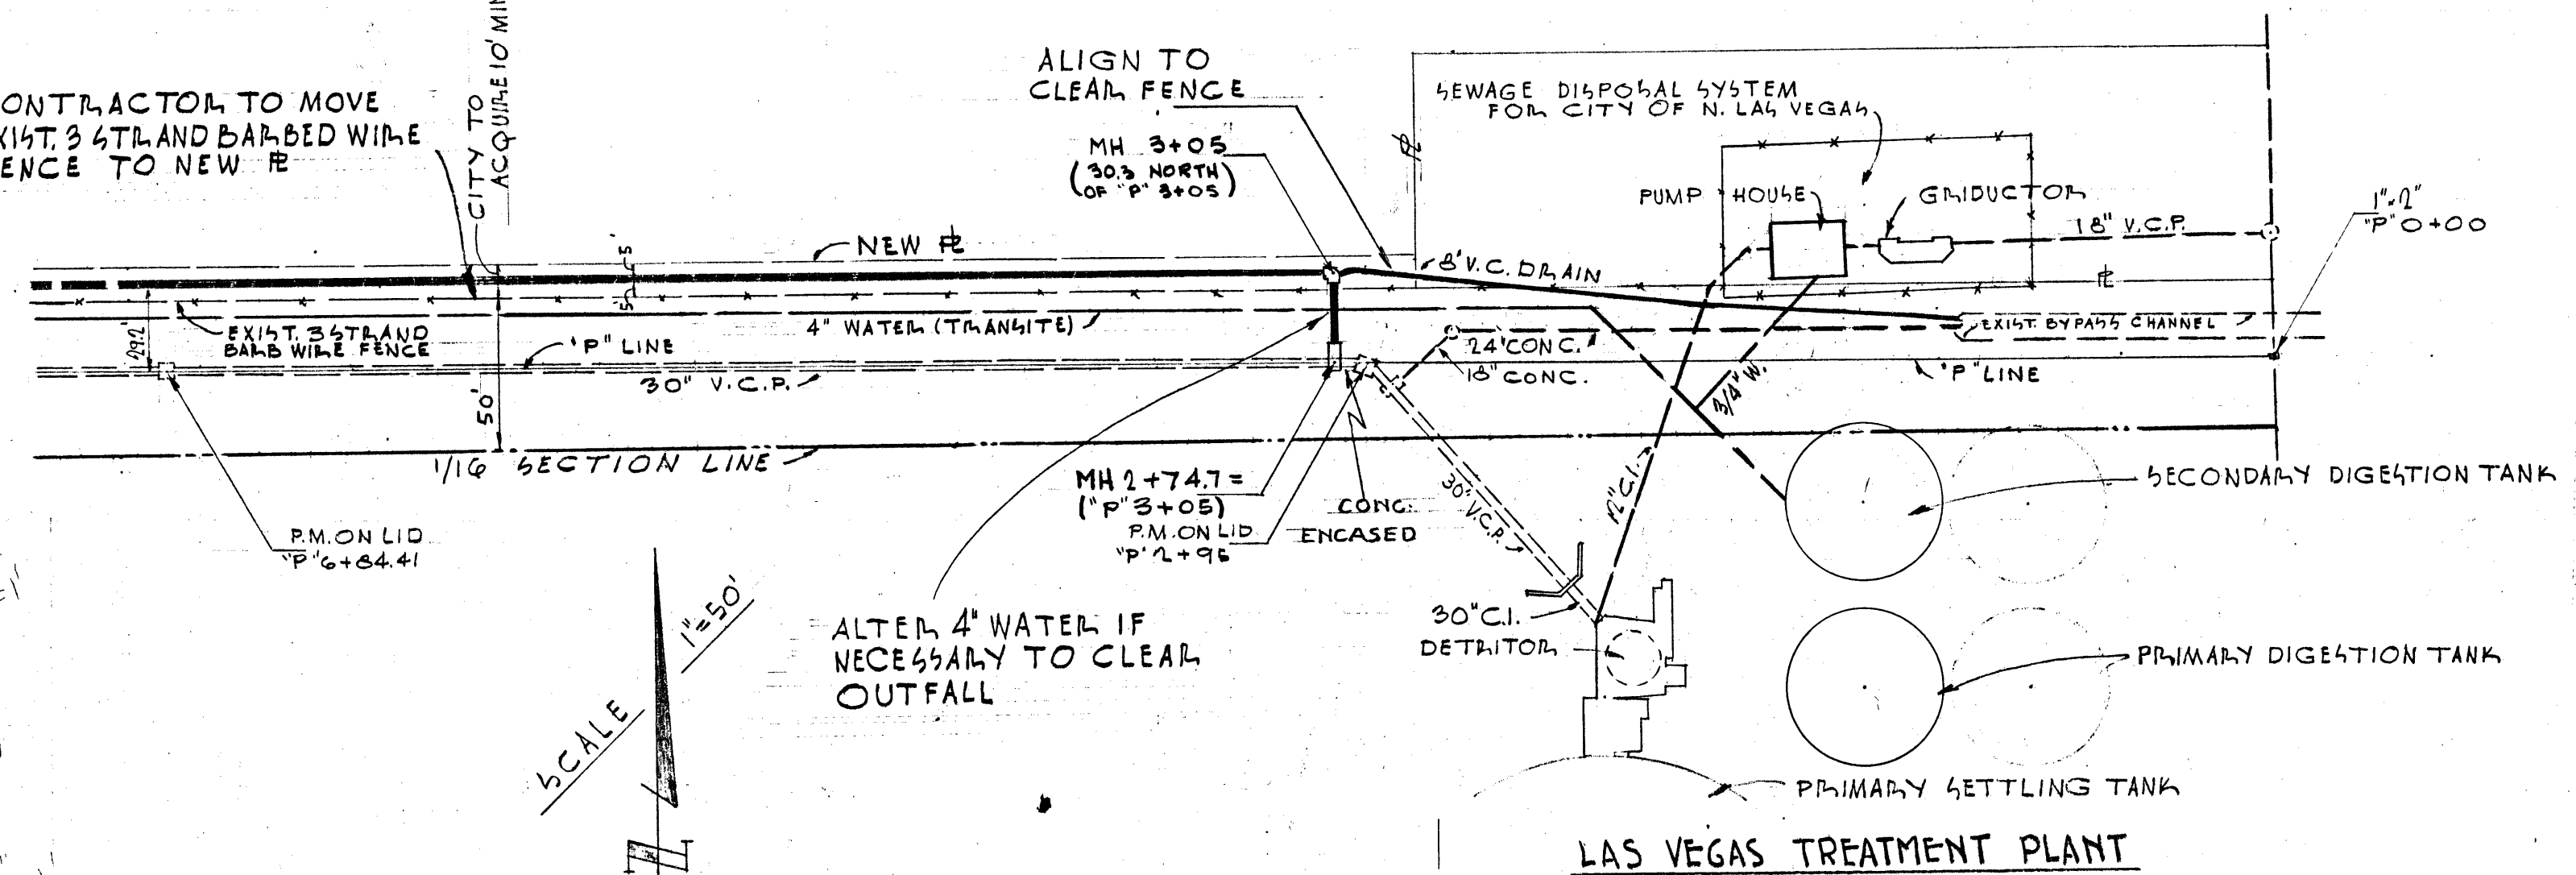
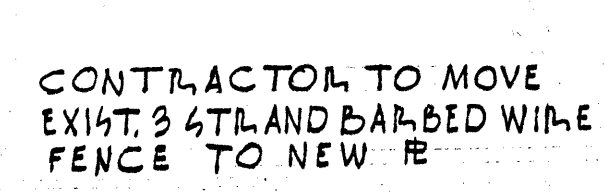
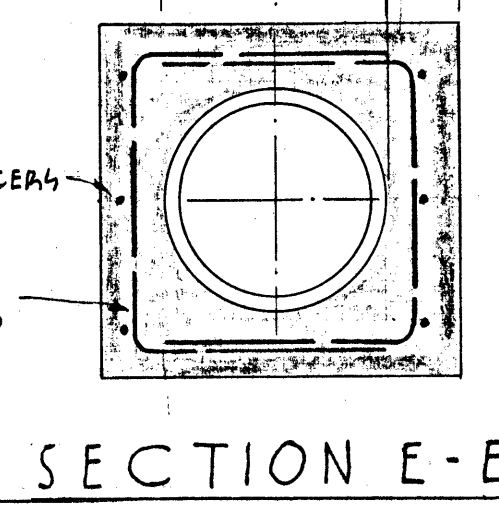
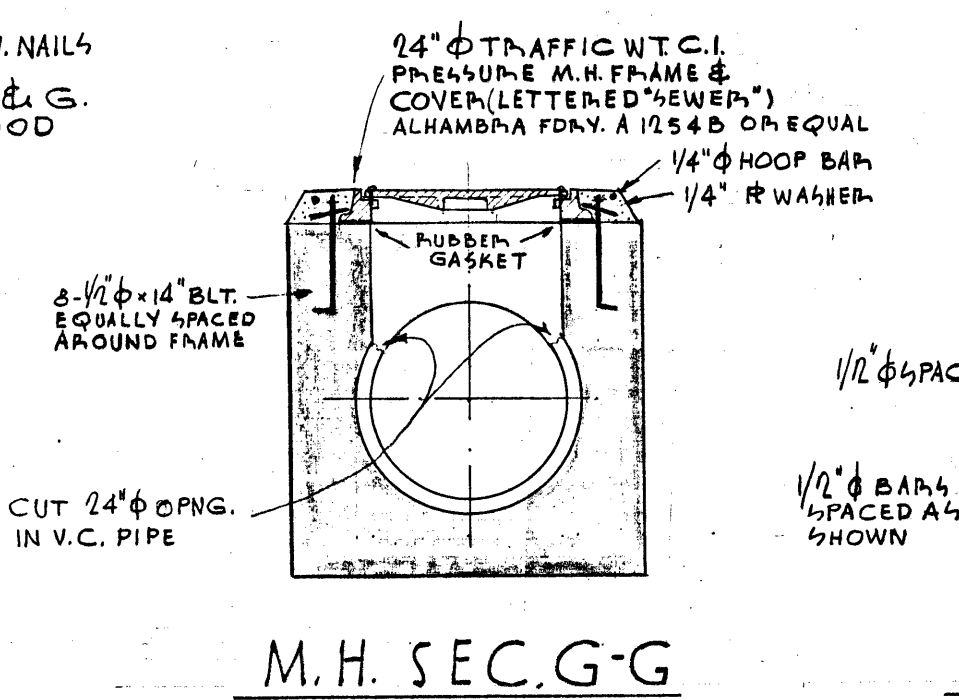
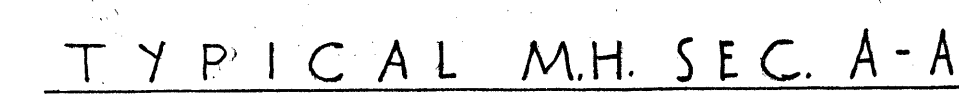
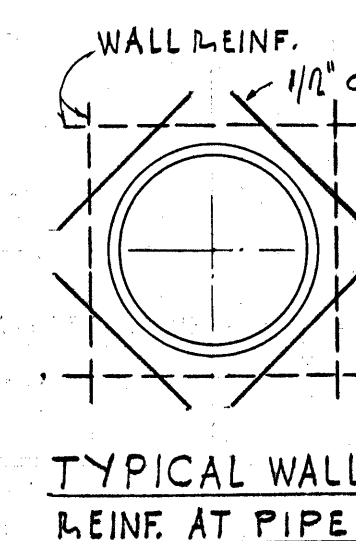
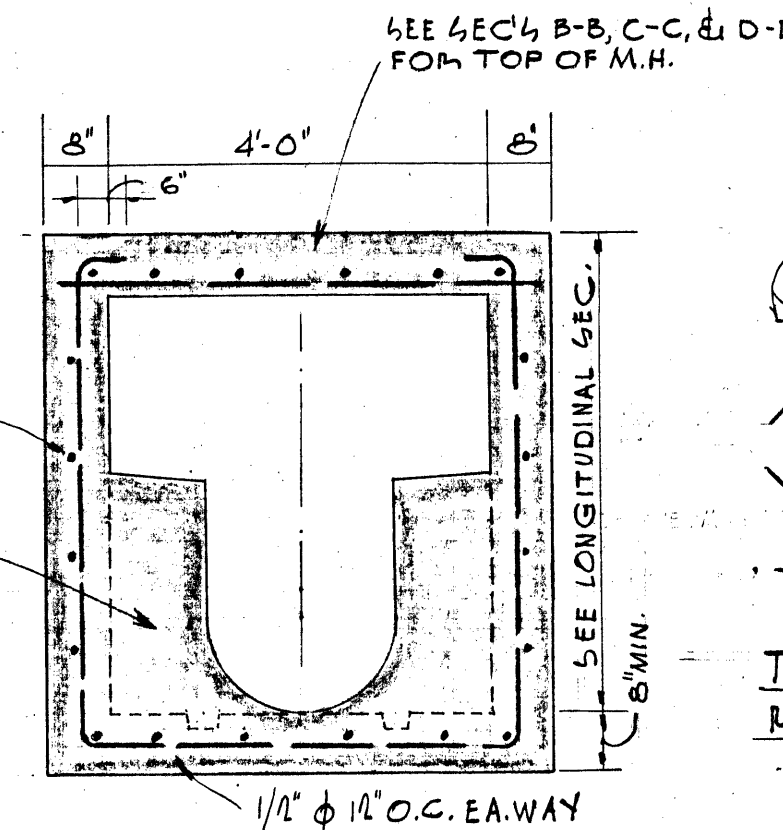
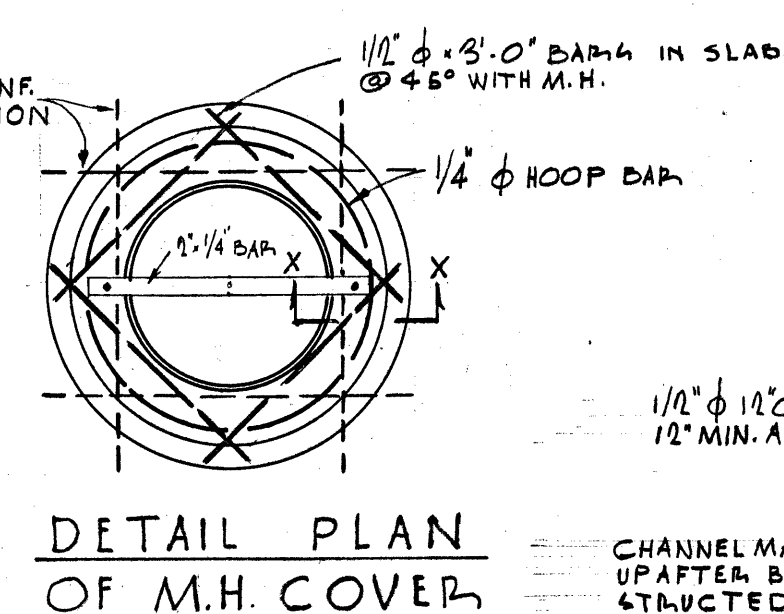
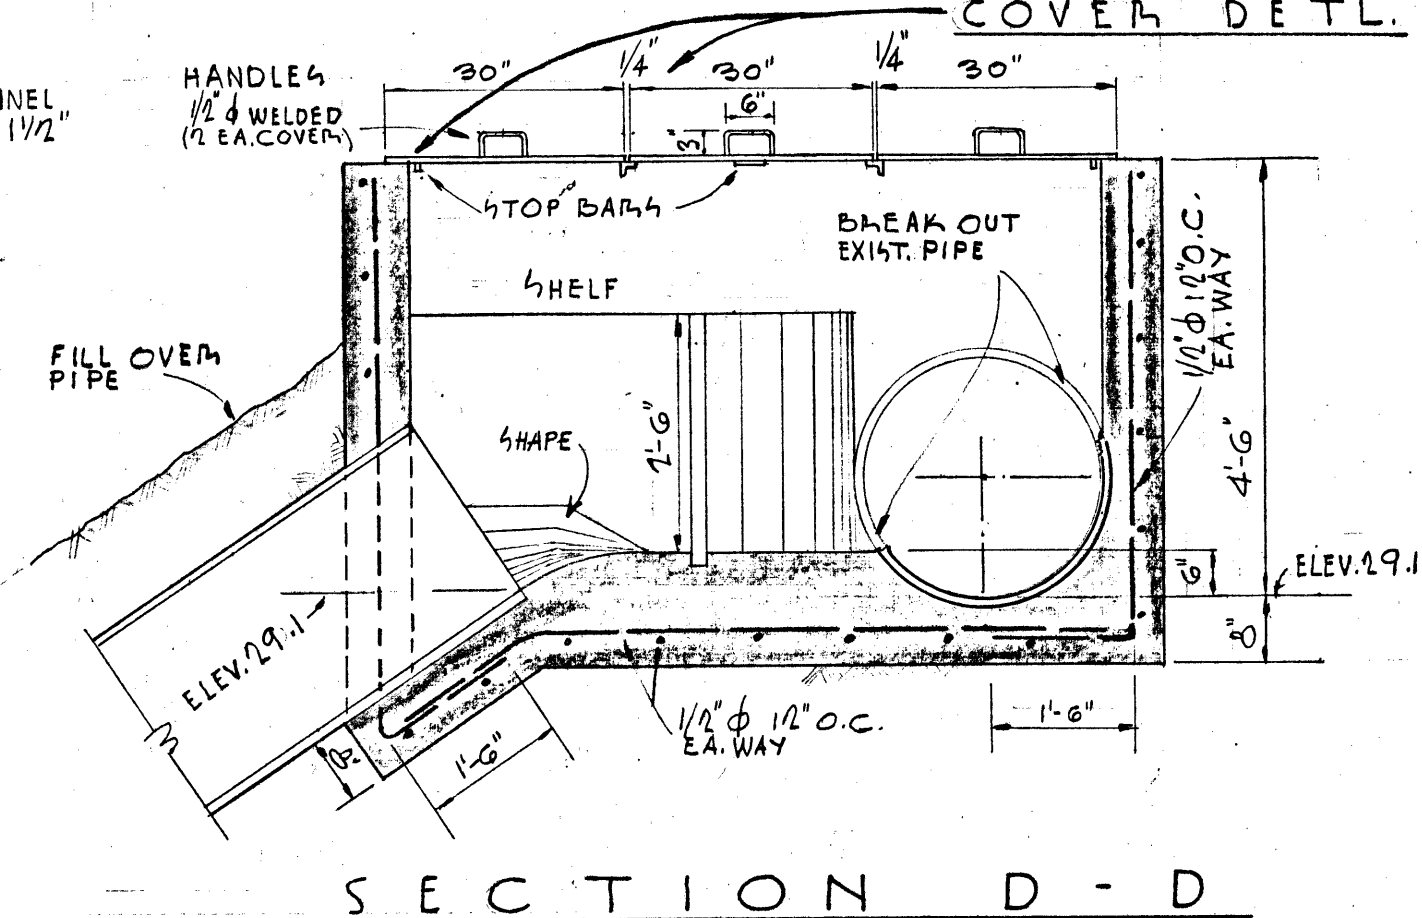
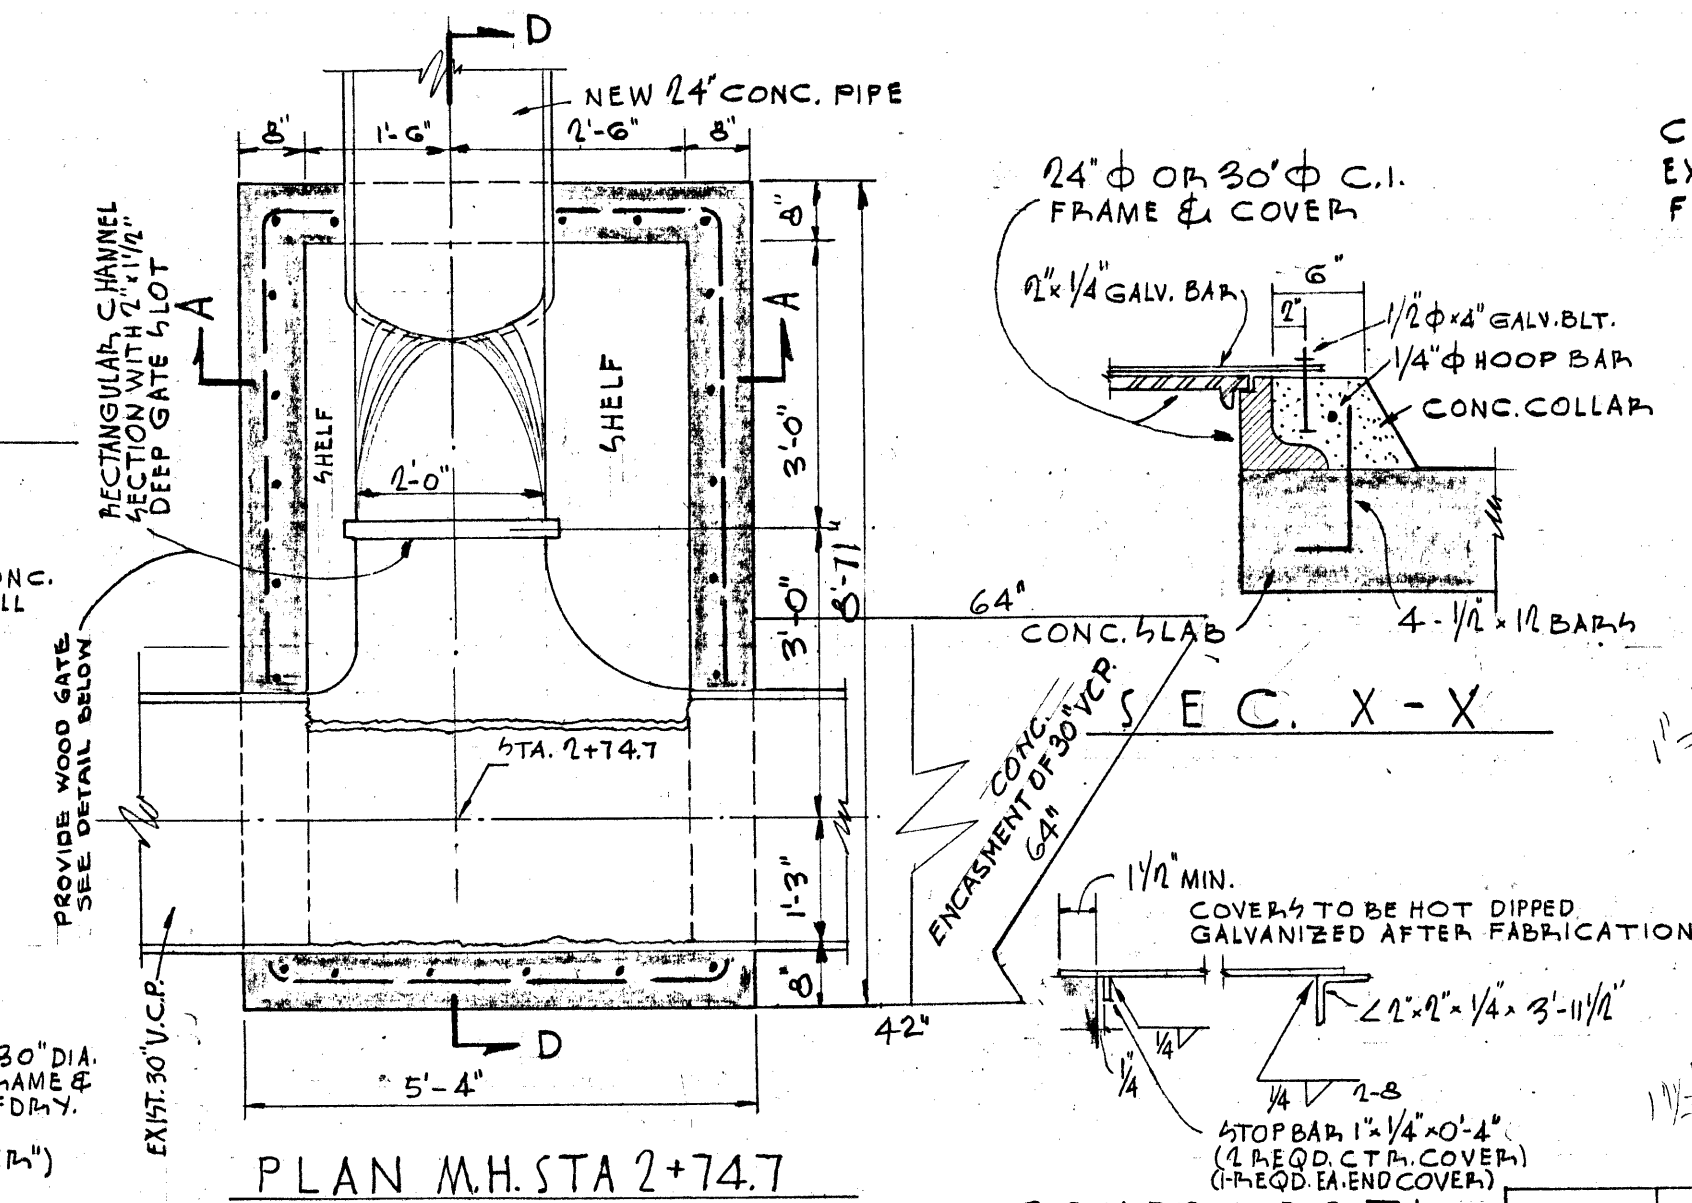
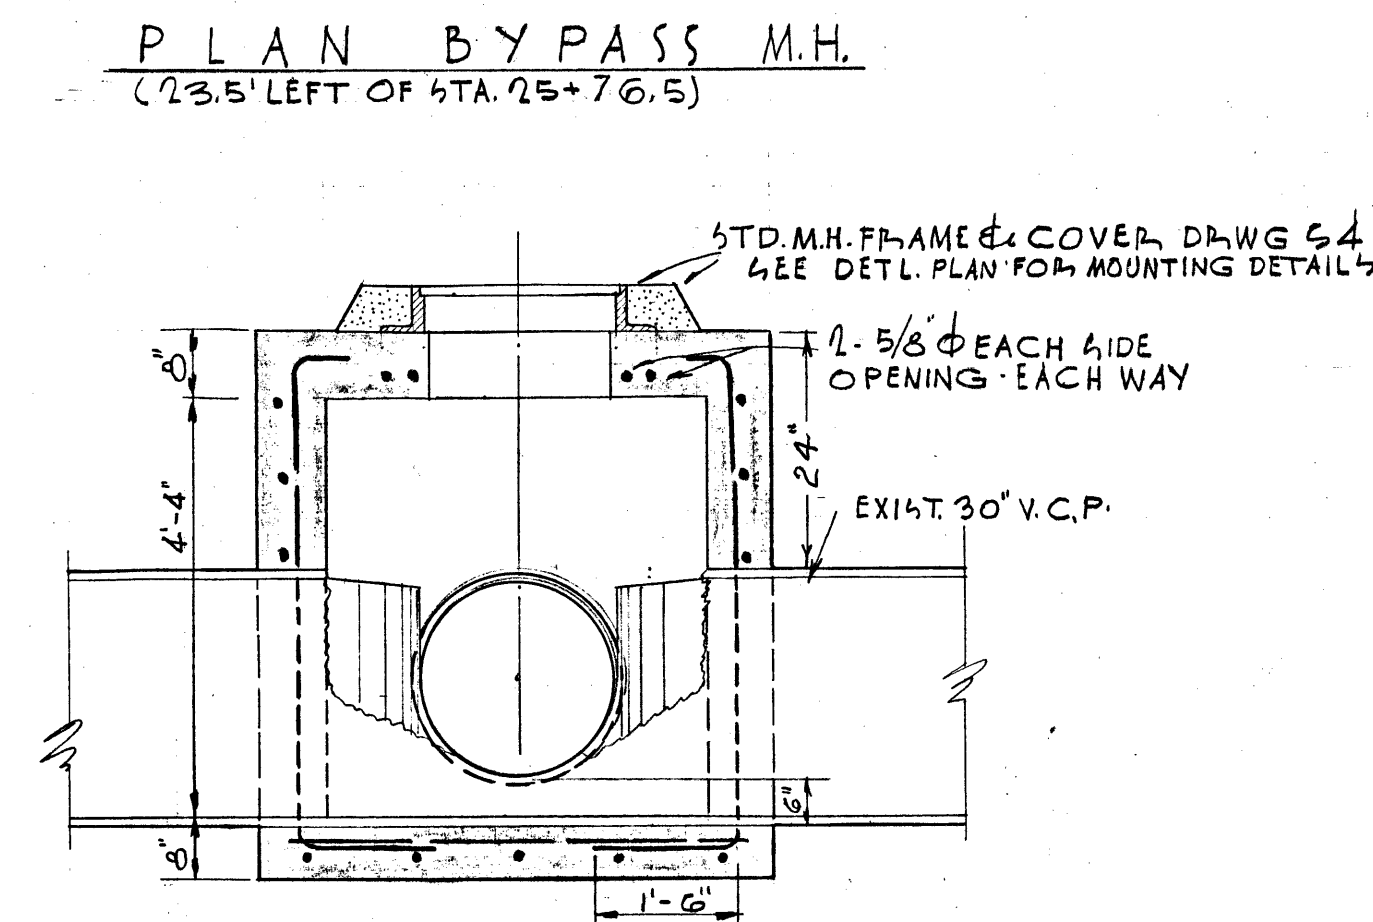
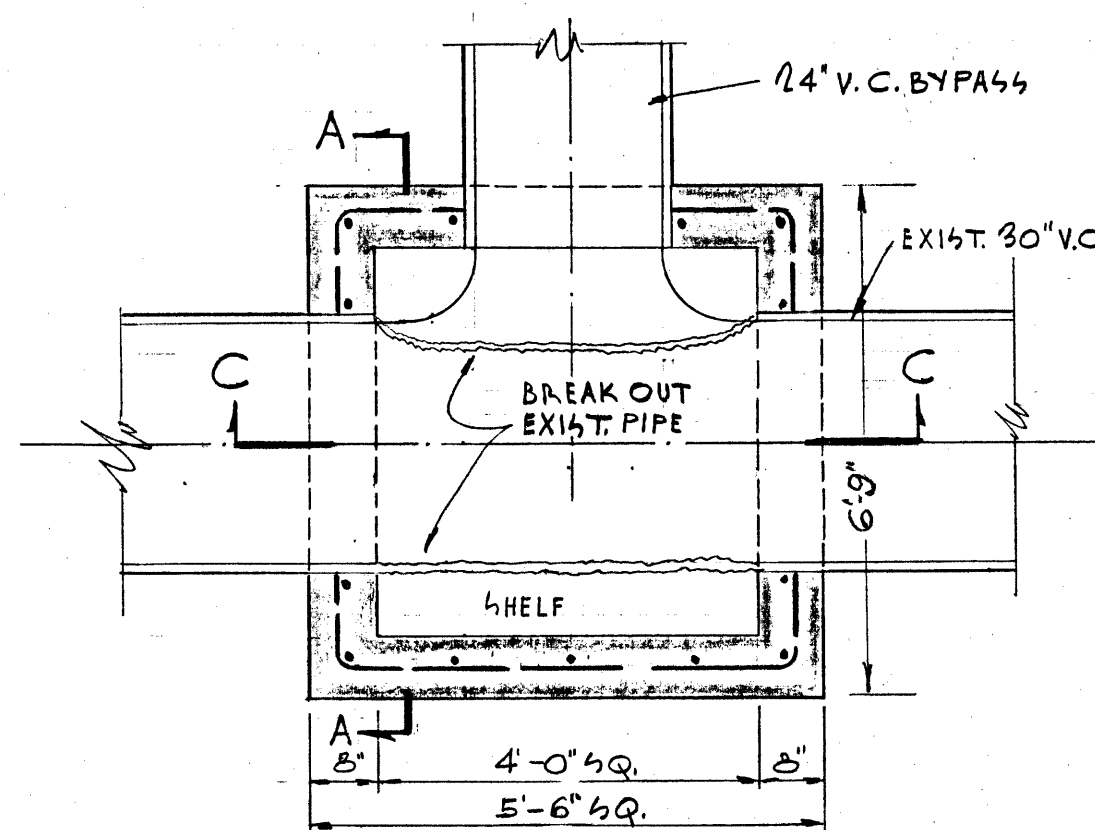
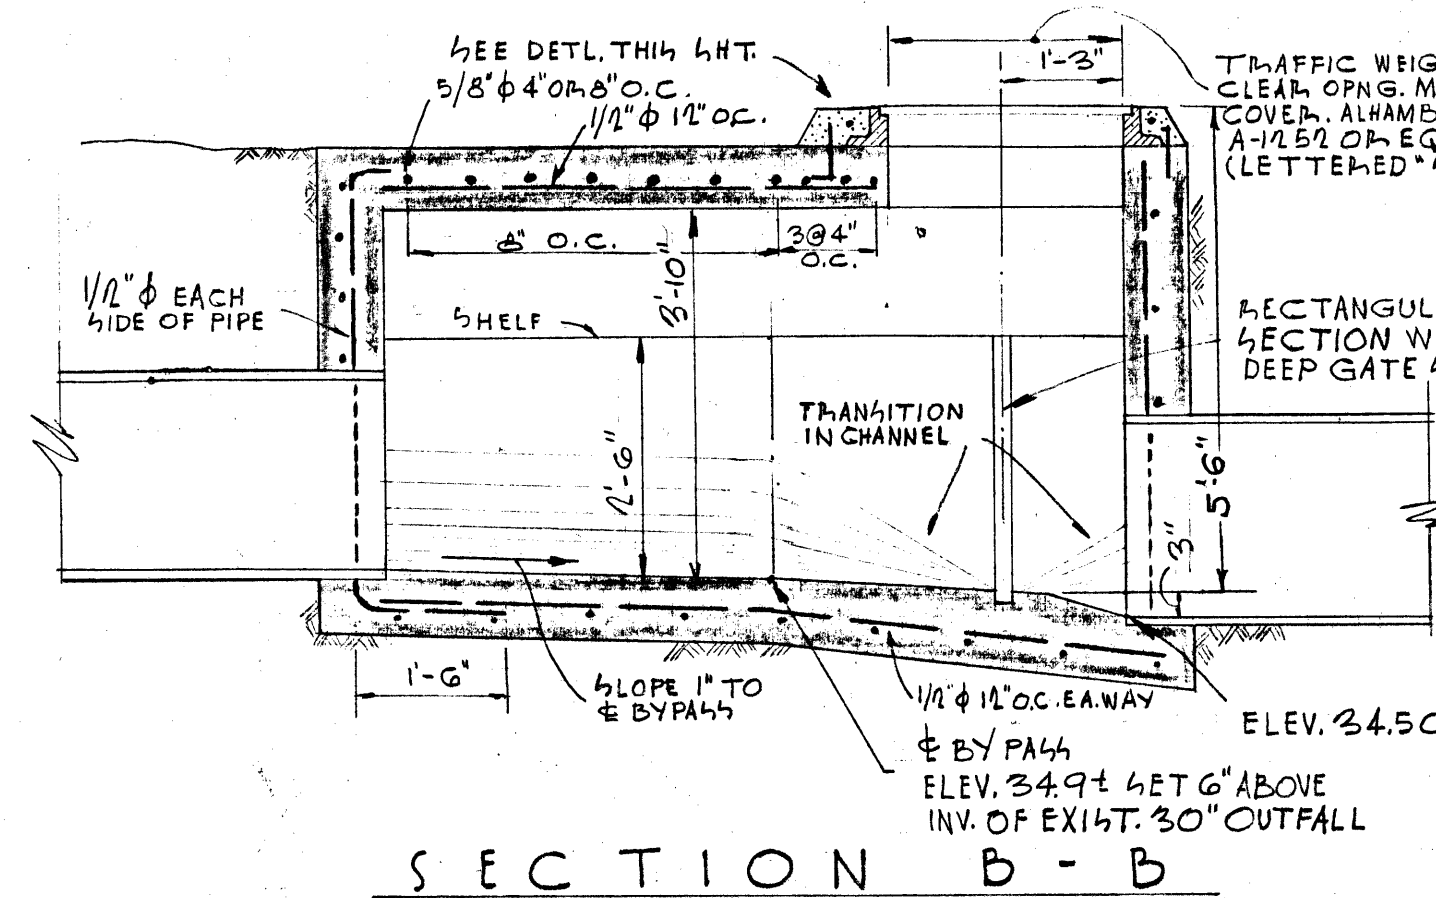


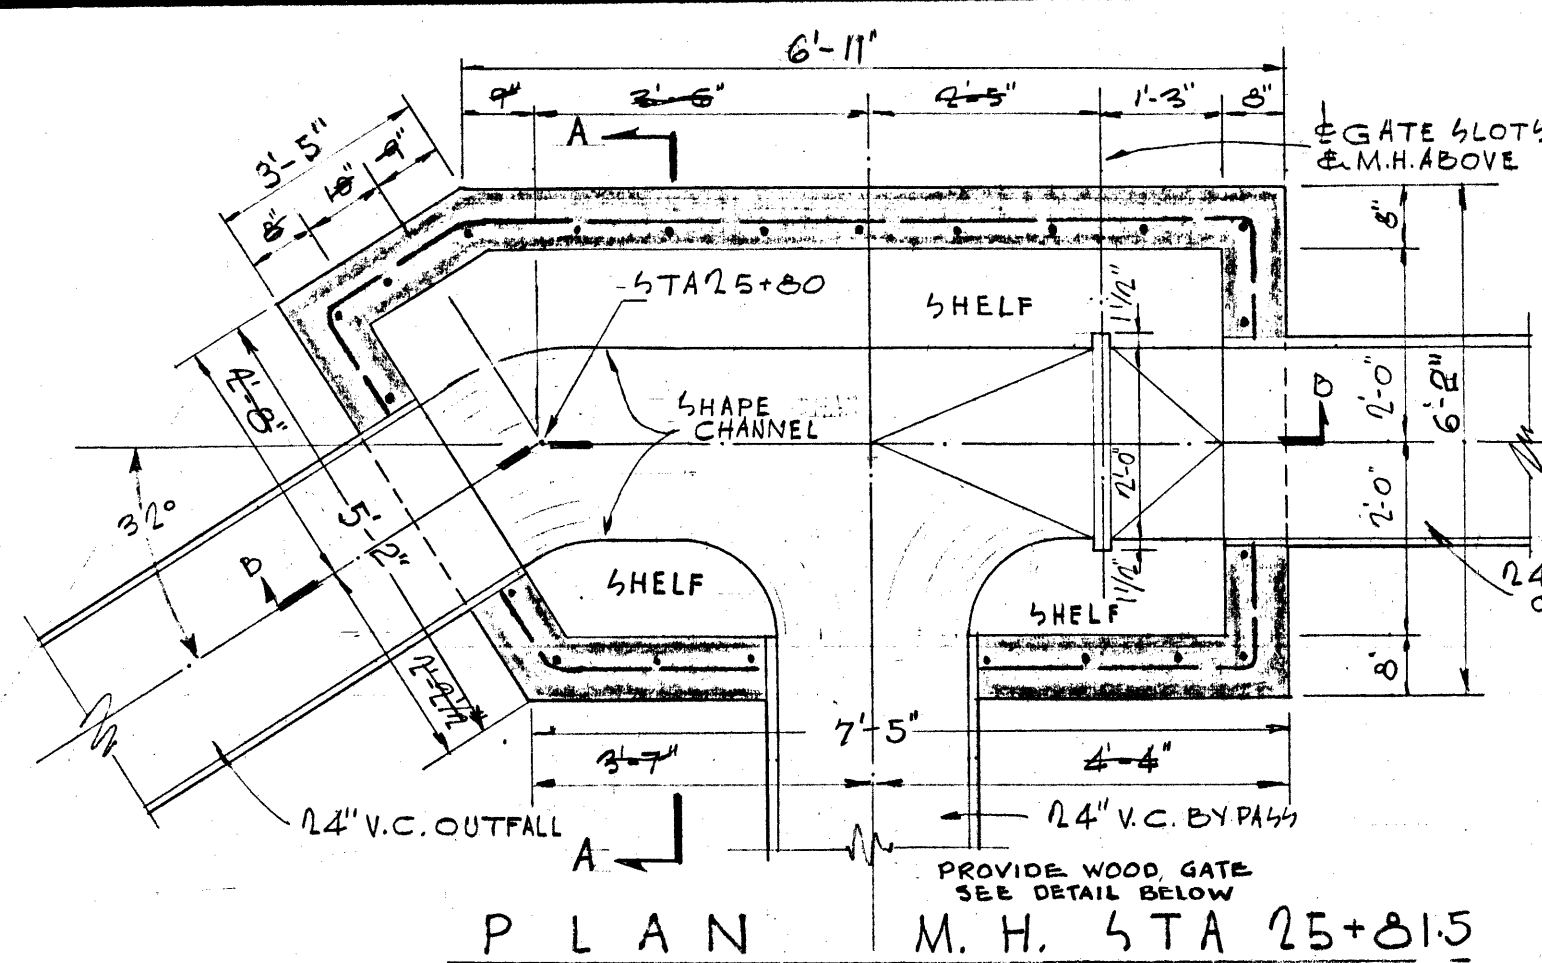

AS BUILT

OUTFALL SEWER

307-W172

SCH. B & C. (26)