

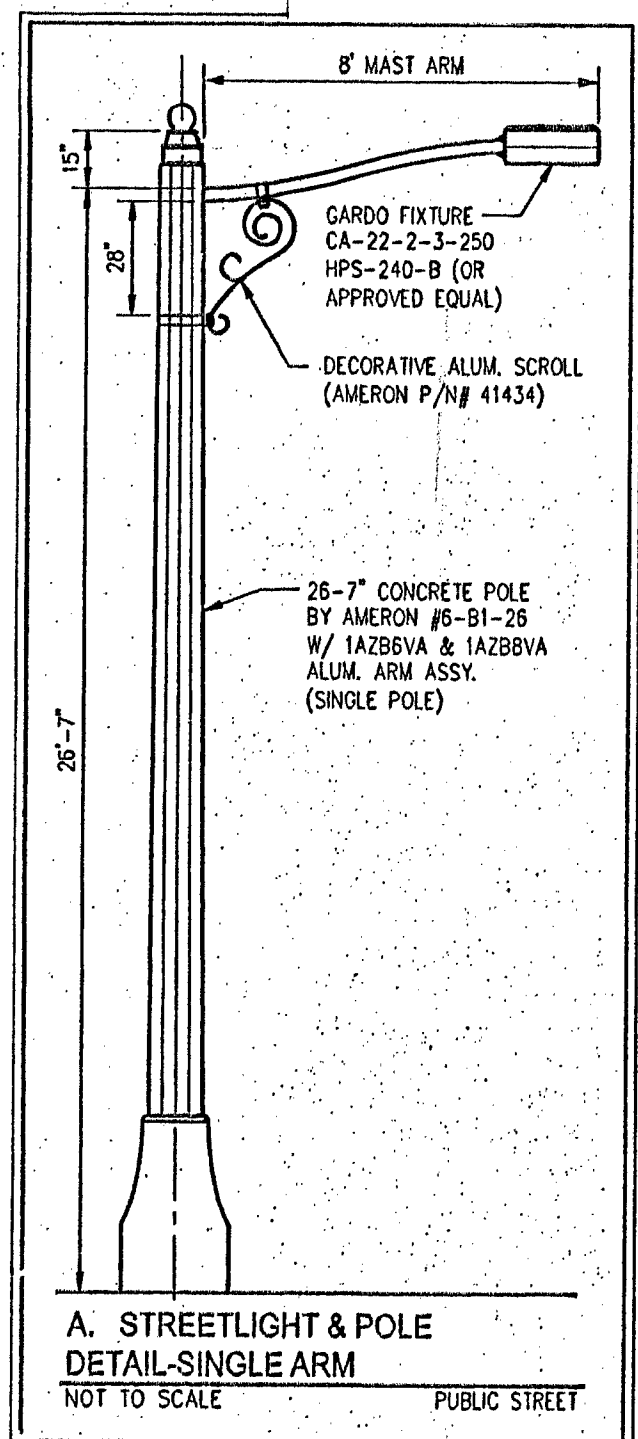
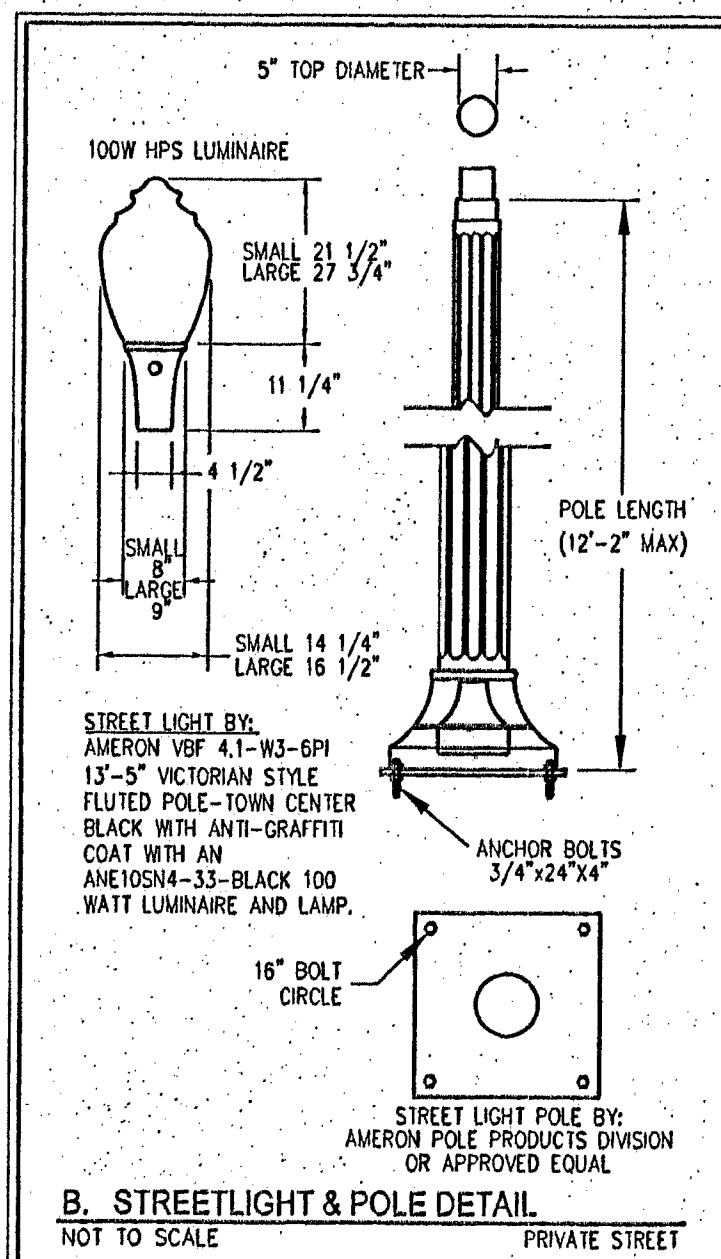
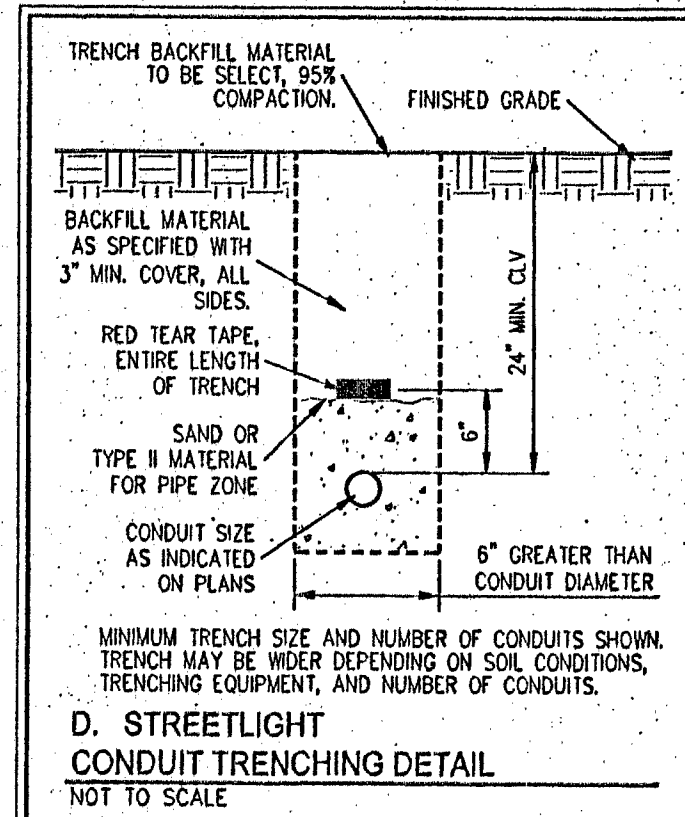
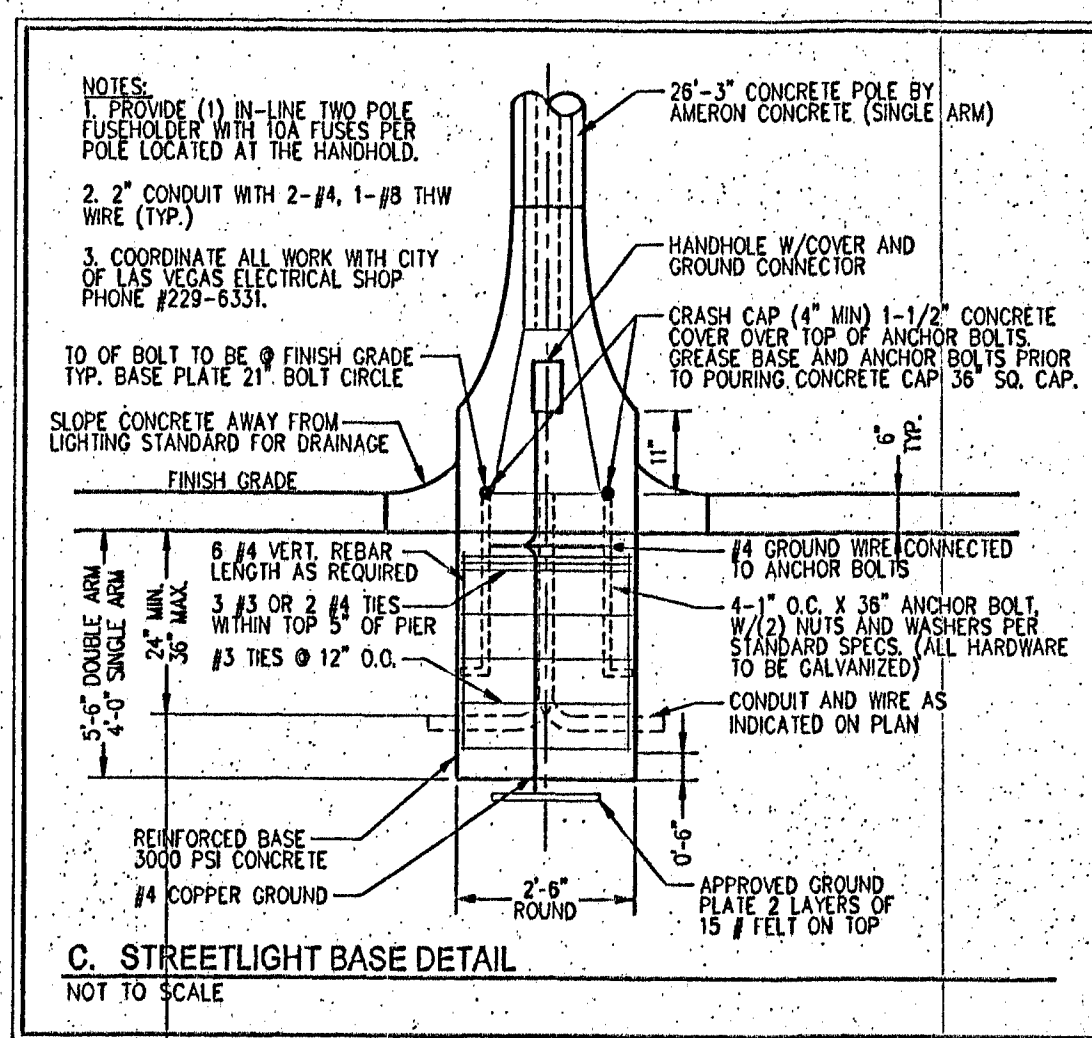
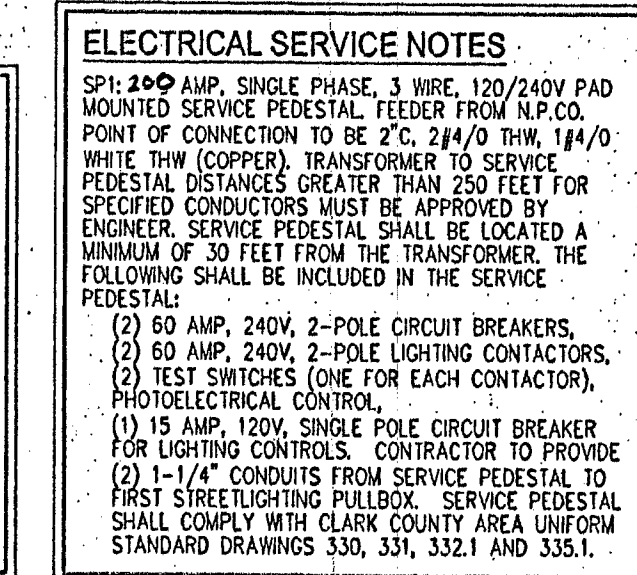
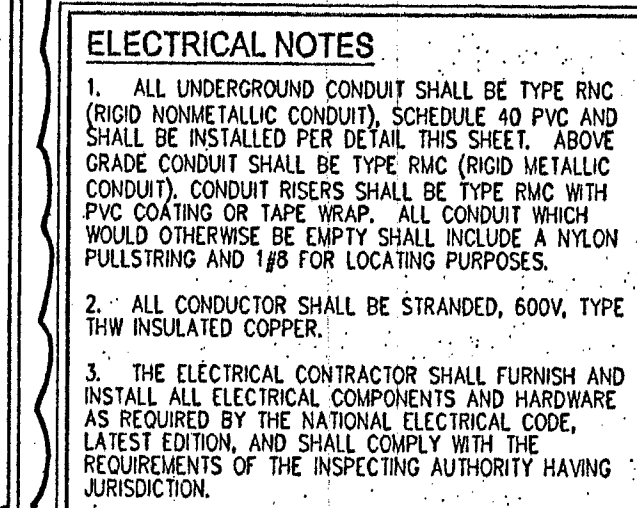
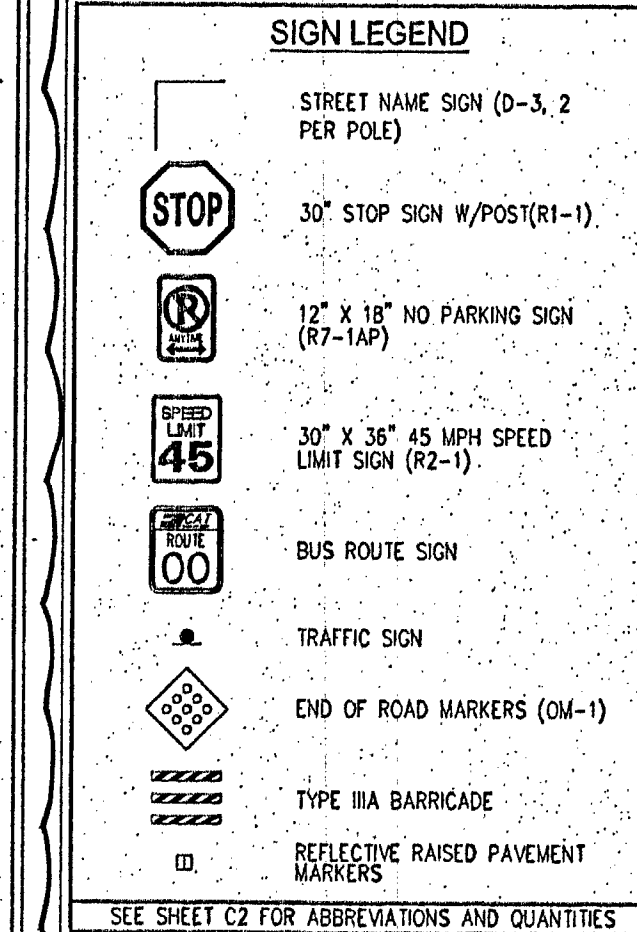


TRAFFIC SIGNAL As-Built





COMPLETED BY
KNL CONSTRUCTION, LLC
11-14-13
Robert M Walker

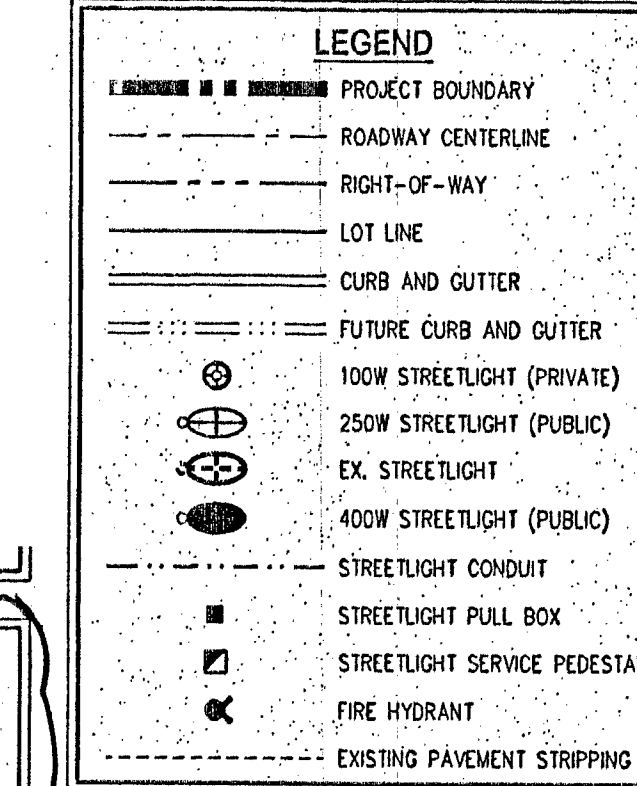

UNDERGROUND LAYOUT

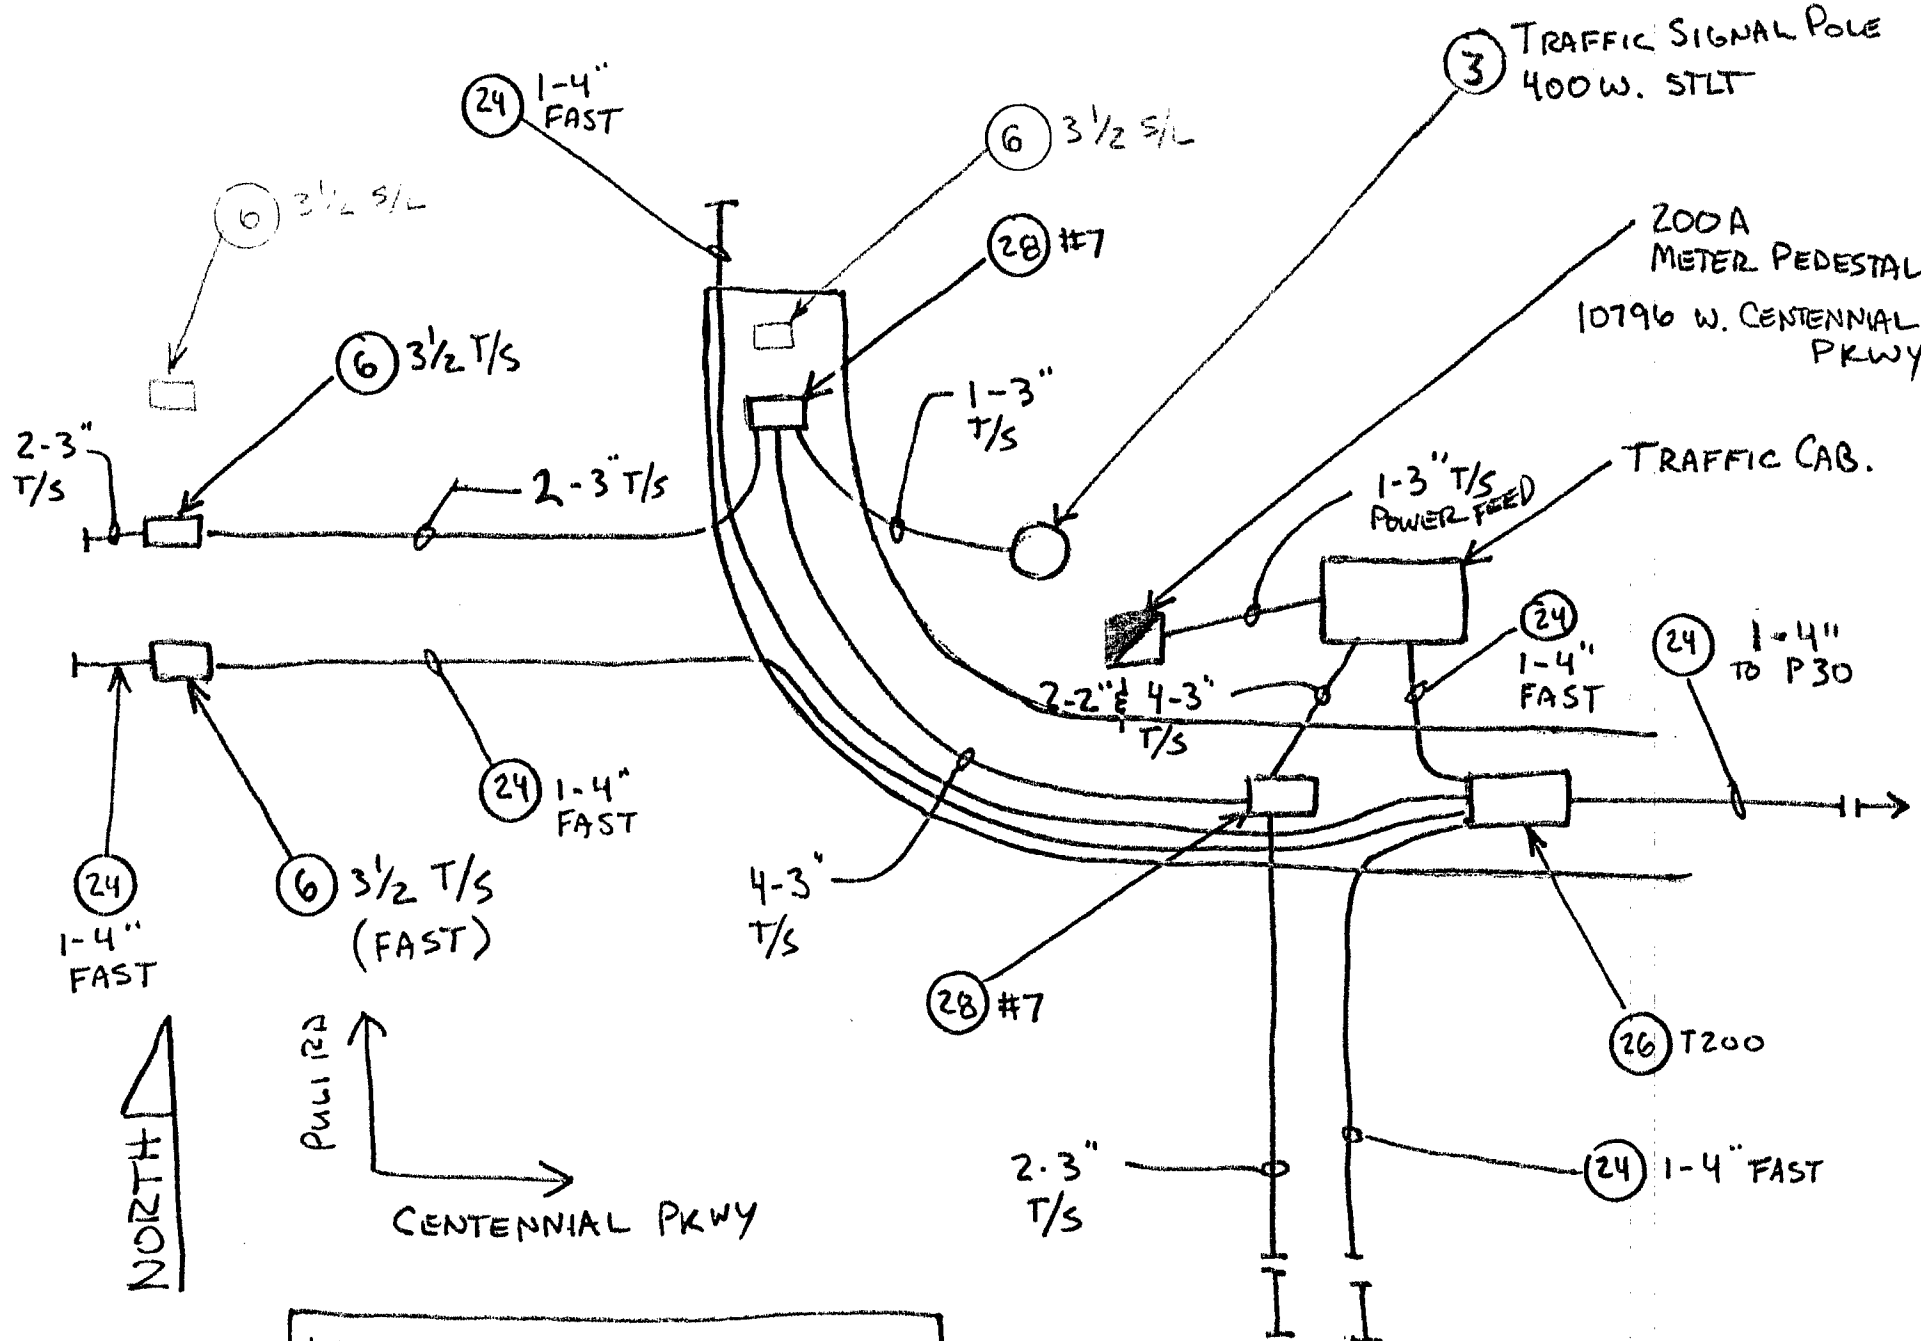

- TRAFFIC NOTES**
- 100W HPS DECORATIVE LIGHTING ASSEMBLY PER DETAIL B/(T-1) (PRIVATE CIRCUIT SP(A))
 - 250W HPS DECORATIVE LIGHTING ASSEMBLY PER DETAIL A/(T-1) (EXISTING CIRCUIT)
 - 400W HPS STREET LIGHT
 - 1-1/4\"/>

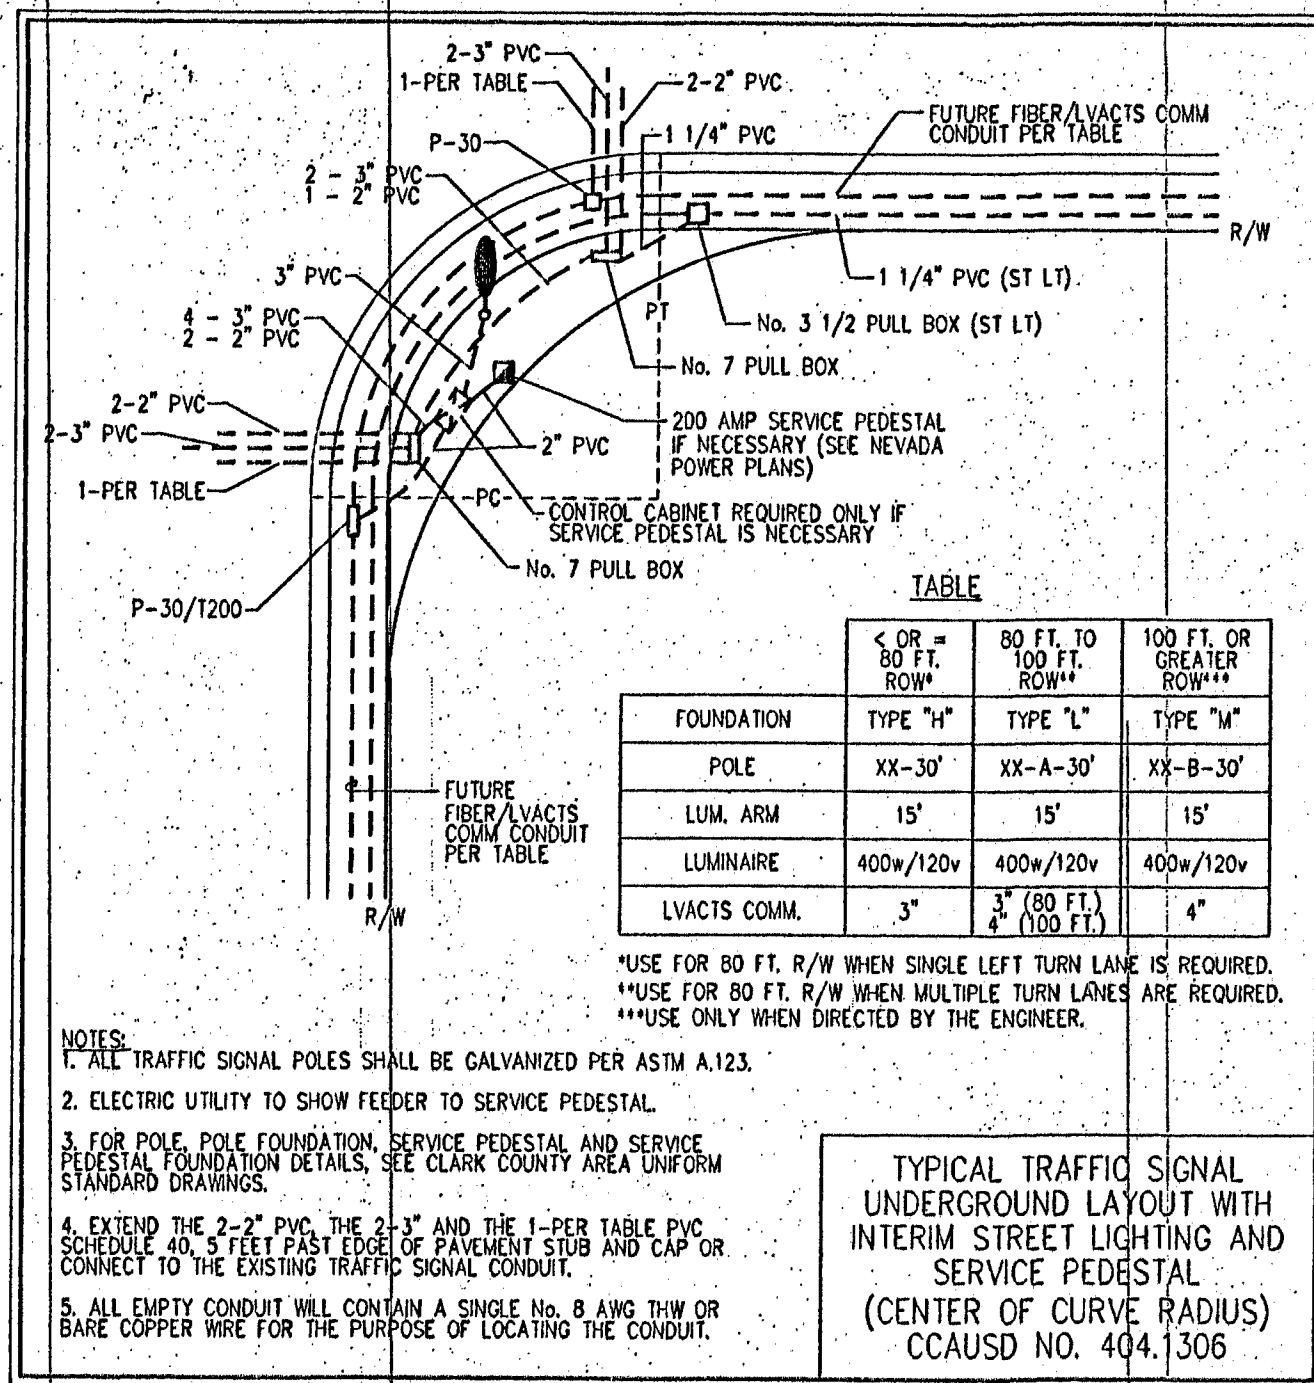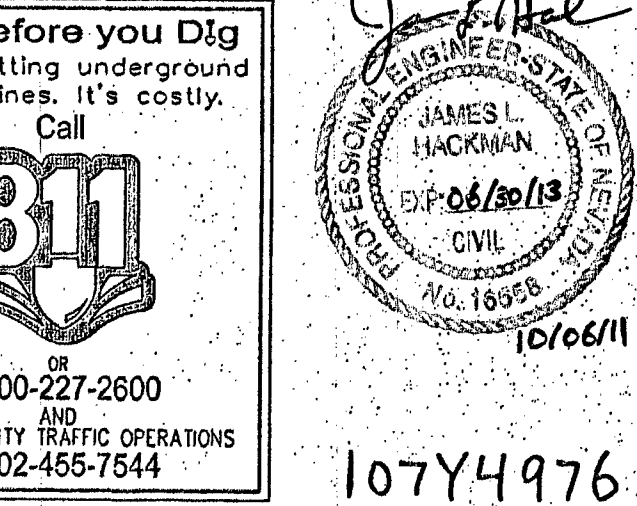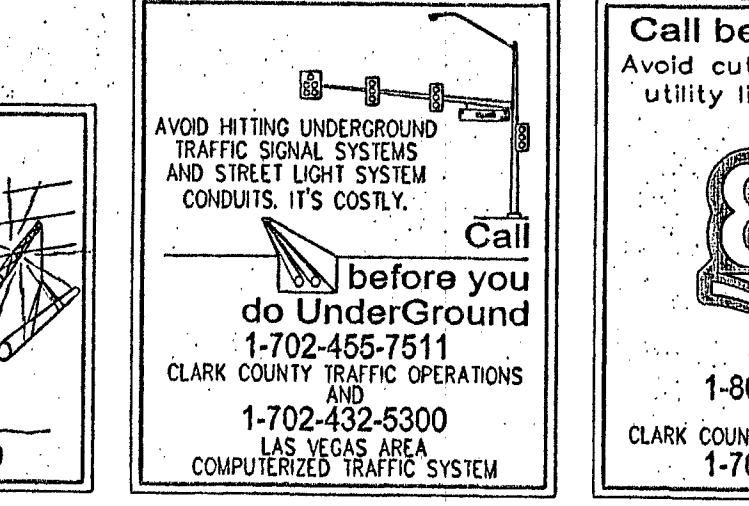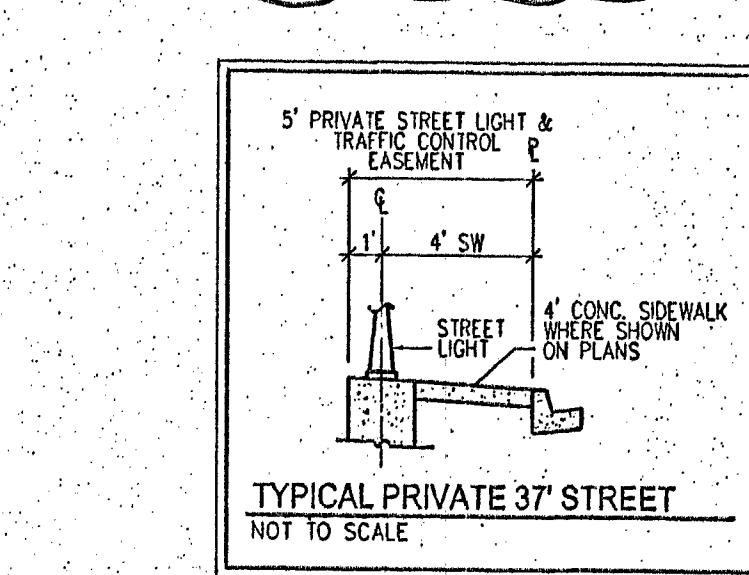

SEE UNDERGROUND LAYOUT - THIS SHEET

