


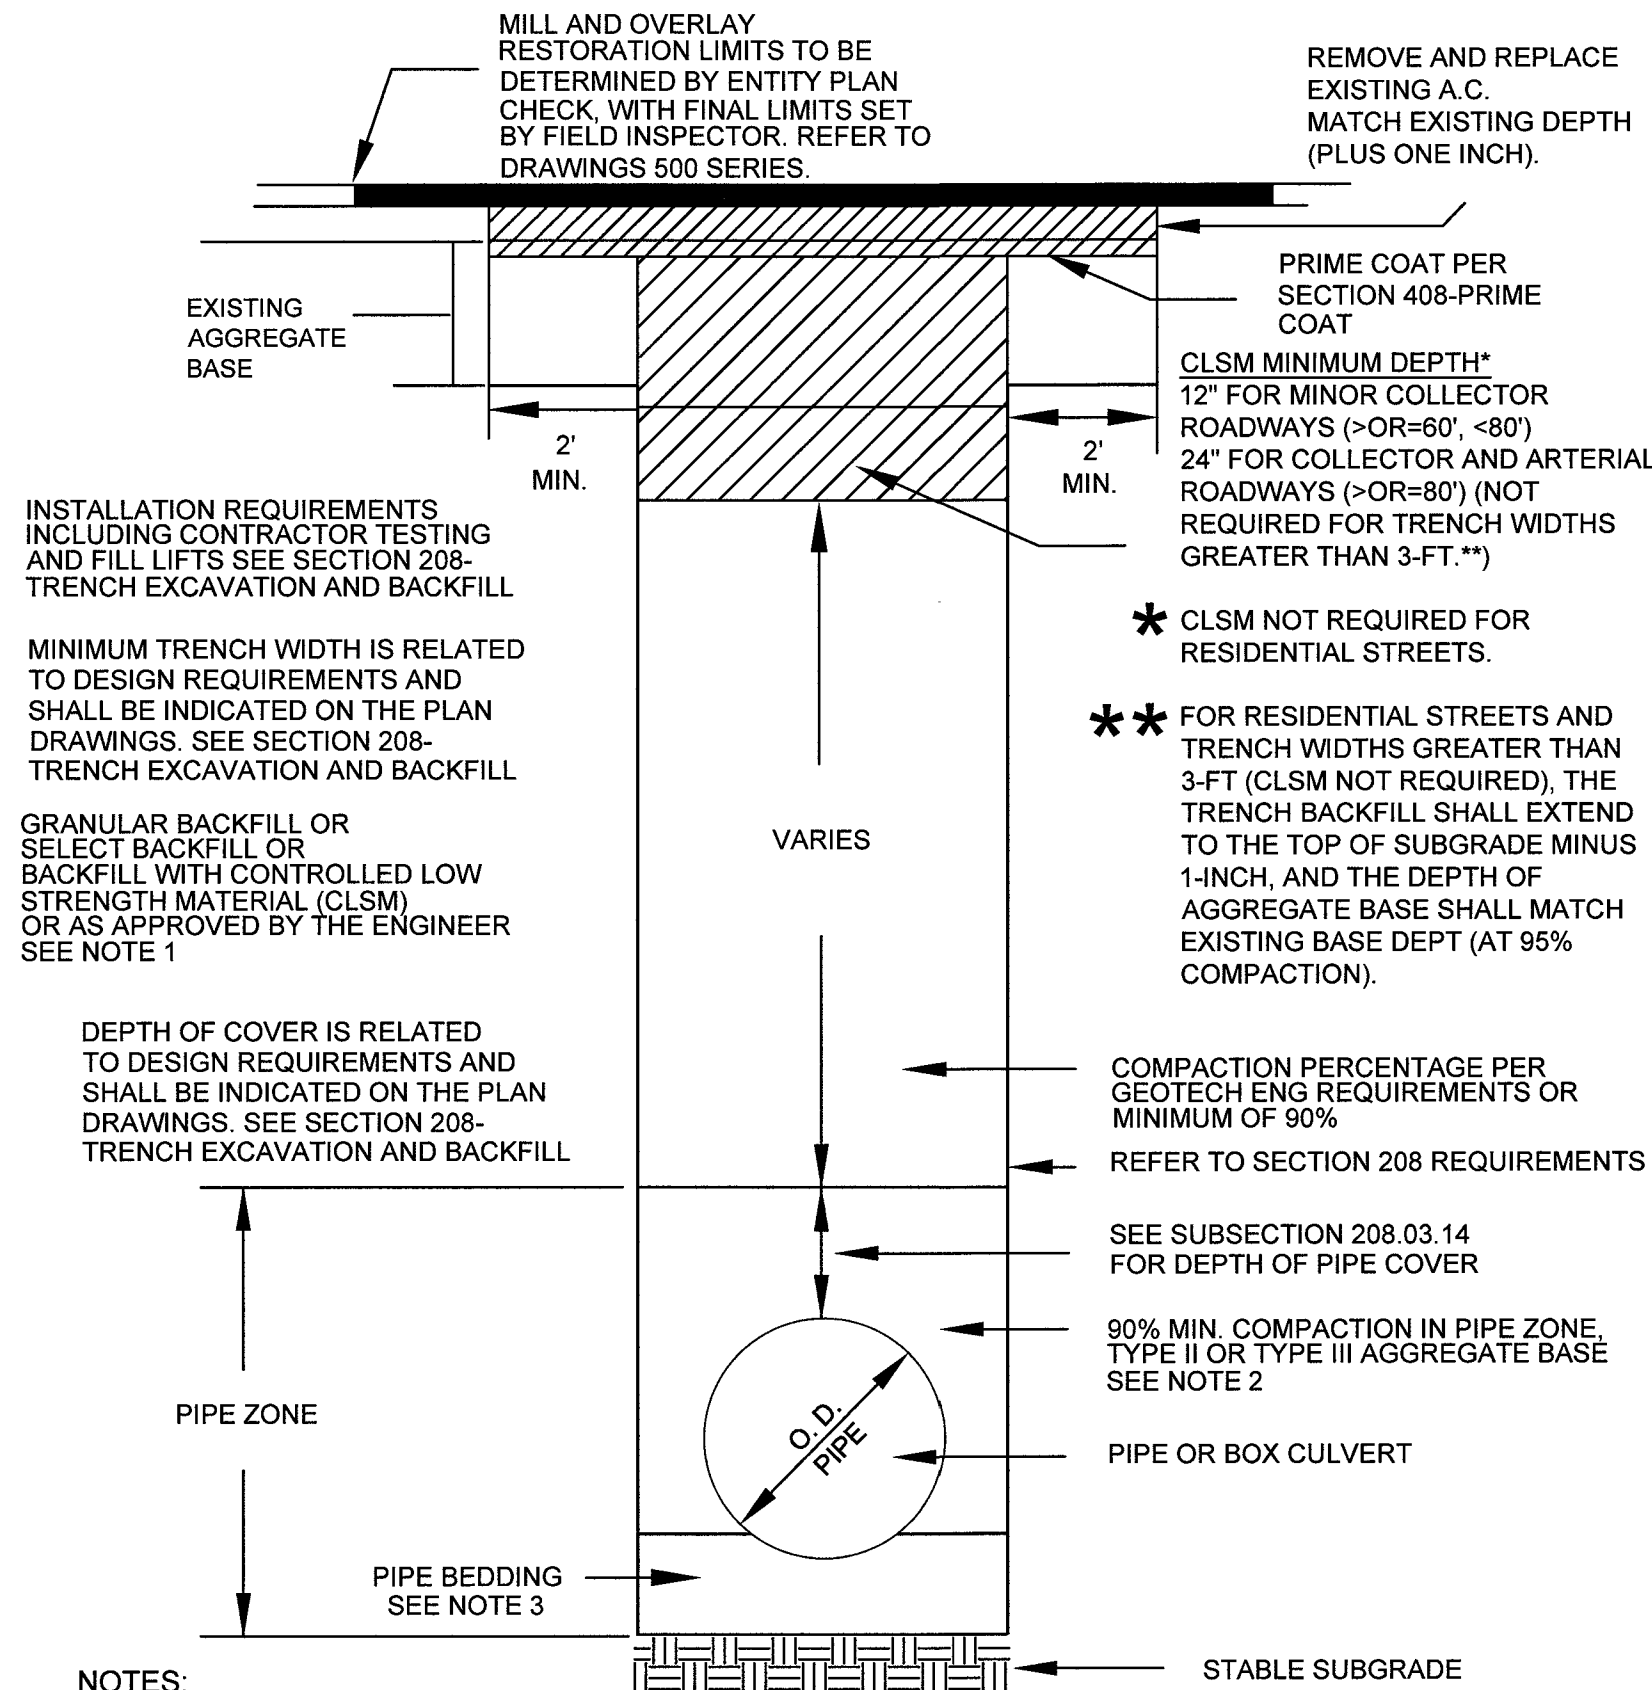

NOTES:

1. NO STONES OR LUMPS GREATER THAN 3" PERMITTED IN TRENCH 2' OR LESS IN WIDTH.
2. TRENCH WIDTH, BEDDING, SUBGRADE AND PIPE ZONE REQUIREMENTS FOR UTILITY INSTALLATIONS SHALL CONFORM TO THE RESPECTIVE ENTITY REQUIREMENTS.
3. CRUSHED ROCK MAY BE USED FOR PIPE BEDDING ONLY IF MATERIAL USE HAS BEEN SPECIFICALLY APPROVED BY THE GOVERNING AGENCY. SEE STANDARD DRAWING NO. 505 FOR PIPE BEDDING METHODS.
4. LAS VEGAS VALLEY WATER DISTRICT REQUIRES PIPE BEDDING AND BACKFILL WITHIN THE PIPE ZONE TO BE OF THE SAME MATERIAL.

RTC STD DWG 503

NEW FACILITIES:

- 1 NEW 2" PE MAIN
- 2 NEW 2" PE FULL FLOW TEE (140-3074)
- 3 NEW 2" PE CAP (140-3060)
- 4 NEW 2" PE COUPLING (140-3442)
- 5 NEW 4" PE MAIN
- 6 NEW 4" PE FULL FLOW TEE (140-3076)
- 8 NEW 4" PERFECTION COUPLING (140-3530)
- 9 NEW 2" PE 90° ELBOW (140-3067)
- 10 NEW 4" PE 90° ELBOW (140-3069)
- 11 NEW 4" X 2" PE REDUCER (140-5118)
- 15 NEW 3" PE SLEEVING (100-8075)
- 16 NEW 6" PE SLEEVING (100-8066)
- 17 NEW 2" PE STRAIGHT STICK (100-5133)
- 18 NEW 3" SLEEVING PVC STICK 20' JOINTS (100-8997)
- 19 NEW 4" PE COUPLING (140-3530)
- 20 NEW 2" METFIT COUPLING (140-3504)
- 21 NEW 2" HVTT TAP TEE (160-8171)
- 22 NEW 6" SLEEVING PVC STICK 20' JOINTS (100-9000)
- 23 NEW 2" METFIT CAP (140-2882)
- 24 NEW 4" PE CAP (140-3062)

EOM END OF MAIN

B BORE

B-F BUTT FUSION

T-S TEST STATION - (251-2406)

ABANDONED FACILITIES:

- | | QTY. |
|----------------------------------|--------|
| 1 ABANDON EX. 1" PE '08 SVC | 3' |
| 2 ABANDON EX. 2" PE '80 MOP 43# | 233' |
| 3 ABANDON EX. 2" PVC '58 MOP 43# | 192' |
| 4 ABANDON EX. 2" STL '55 MOP 43# | 1,982' |
| 5 ABANDON EX. 2" STL '57 MOP 43# | 924' |
| 6 ABANDON EX. 4" STL '55 MOP 43# | 1,638' |
| 7 ABANDON EX. 1/2" PE '02 SVC | 47' |
| 8 ABANDON EX. 1/2" PVC '55 SVC | 48' |
| 9 ABANDON EX. 1/2" PVC '62 SVC | 50' |
| 10 ABANDON EX. 1/2" PVC '64 SVC | 3' |
| 11 ABANDON EX. 1/2" PVC '66 SVC | 22' |
| 12 ABANDON EX. 1/2" PVC '68 SVC | 6' |
| 13 ABANDON EX. 3/4" PVC '55 SVC | 40' |
| 14 ABANDON EX. 3/4" STL '74 SVC | 9' |
| 15 ABANDON EX. 1" STL '66 SVC | 1' |
| 16 ABANDON 2" PE TO BE INSTALLED | 1' |
| 17 ABANDON EX. 1/2" PE '77 SVC | 107' |
| 18 ABANDON EX. 1/2" PE '81 SVC | 59' |
| 19 ABANDON EX. 1/2" PE '89 SVC | 11' |
| 20 ABANDON EX. 1/2" PE '99 SVC | 86' |
| 21 ABANDON EX. 1/2" PE '08 SVC | 5' |
| 22 ABANDON EX. 1/2" PVC '60 SVC | 112' |
| 23 ABANDON EX. 1/2" PVC '61 SVC | 50' |
| 24 ABANDON EX. 1/2" PVC '67 SVC | 4' |
| 25 ABANDON EX. 1/2" PVC '69 SVC | 482' |
| 26 ABANDON EX. 1/2" PVC '71 SVC | 124' |
| 27 ABANDON EX. 1/2" PVC '74 SVC | 101' |
| 28 ABANDON EX. 1/2" PVC '75 SVC | 85' |
| 29 ABANDON EX. 3/4" STL '60 SVC | 113' |
| 30 ABANDON EX. 1" STL '59 SVC | 115' |
| 31 ABANDON EX. 1" PE '79 SVC | 239' |

NOTE: ABANDON MAIN IN PLACE

CONSTRUCTION NOTES:

1. SUGGESTED GAS LOCATIONS ARE TO CLEAR SUBSTRUCTURES LOCATE IN FIELD.
2. ALL PIPELINE CONSTRUCTION SHALL CONFORM TO APPLICABLE JURISDICTIONAL SPECIFICATIONS.
3. DO NOT SCALE THIS DRAWING.
4. SEE AC'S FOR SERVICE REPLACEMENT.
5. CHANGE IN PROPOSED MAIN LOCATION MUST BE AUTHORIZED BY SWG ENGINEER PRIOR TO INSTALLATION.
6. GAS MAINS SHALL BE PURGED PER OPERATIONS MANUAL.
7. ABANDONED SERVICE NO ACTION REQUIRED.
8. REPLACE ALL ACTIVE SERVICES EXCEPT WHERE EXISTING PE SERVICES ARE VERIFIED, INSPECTED, AND APPROVED FOR TIE-OVER BY SWG INSPECTOR.
9. EXISTING PE SERVICE, PE VERIFICATION, AND INSPECTION REQUIRED FROM MAIN TO RISER. TIE INTO NEW MAIN IF APPROVED BY SWG INSPECTOR, OTHERWISE REPLACE SERVICE.
10. EXISTING SERVICE, UNKNOWN TYPE, SIZE, AND LOCATION TO BE VERIFIED.
11. EXISTING ANODE RISER.
12. EXISTING ANODELESS RISER.
13. REPLACEMENT SVCS TO BE SINGLE OR BRANCHED. NO CROSS-LOT REPLACEMENT SVCS PERMITTED.
14. REPLACE ALL ANODE RISERS WITH ANODELESS RISERS.
15. CITY OF LAS VEGAS PERMIT REQUIRED.
16. ALL EXISTING UTILITY LOCATION TO BE VERIFIED PRIOR TO START OF CONSTRUCTION.
17. CONTACT ENGINEERING FOR BYPASS INFORMATION.
18. ALL MAIN TIE-INS REQUIRING TEES ARE TO BE FULL-FLOW TEES UNLESS OTHERWISE STATED.
19. ALL WELDS SHALL BE X-RAYED AND DOCUMENTED, INCLUDING GPS COORDINATES, ON AS-BUILT DRAWINGS.
20. ALL SHORING REQUIREMENTS SHALL CONFORM TO APPLICABLE PORTIONS OF THE OPERATIONS MANUAL.
21. REQUEST FOR SURVEYING AND/OR STAKING WILL BE SUBMITTED TO ENGINEERING 72 HOURS IN ADVANCE, MINIMUM.
22. TRENCHING AND BACKFILL TO CONFORM WITH UNIFORM STANDARD SPECS. SECTION 208 AND RTC STANDARD 503.
23. PROTECT ALL EXISTING VALLEY GUTTERS IN PLACE BORE, DO NOT CUT.
24. TRENCHING AND BACKFILL TO CONFORM WITH RTC STANDARDS 500.5 & 503 FOR ALL SERVICE REPLACEMENTS.
25. REPLACE EXISTING SERVICE WITH SIMILAR SIZE UNLESS OTHERWISE NOTED.

NOTE:

EMS BALLS ON ALL TEE'S, 90'S, SERVICE IN FRONT OF CURB AND EVERY 50' ALONG MAIN

EXISTING RISERS

QTY.

# OF ANODELESS RISERS	27
# OF ANODE RISERS	9

LINE LOCATE PERFORMED BY:

NAME: KENNETH BINGHAM DATE: 03/16/2017

NAME: DATE:

PURGE PLAN WAS COMPLETED IN ACCORDANCE WITH THE OPERATIONS MANUAL GUIDELINES BY:

PRINT: DATE:

SIGNATURE:



SYSTEM D VALLEY WIDE
DR. NO. 21DR10008938
SEGMENT M.A.O.P. N/A
SYSTEM M.A.O.P. 43 psig
SYSTEM M.O.P. 43 psig

NO.	DESCRIPTION	BY	DATE	APPVD.
4.	AS-BUILT SUBMITTAL FOR FINAL CLOSE	SWG	8/9/17	
REVISIONS				
PROPERTY UNITS				
TAX CODES	UNIT NO.	UNIT TYPE	INSTL. PROPOSED	RETIRED COMPLETED
	3780102	2" PE	3,325'	234'
	3780602	2" PVC		192'
	3780202	2" STL		2,908'
	3780104	4" PE	1,641'	1,638'
	3780204	4" STL		1,638'
	3800101	1/2" PE		315'
	3800601	1/2" PVC		1,039'
	3800801	3/4" PVC		40'
	3800201	1" STL		122'
	3800101	1" PE	1,678'	242'
	3800201	1" STL		116'

TEST BLOCK 2	TEST MEDIUM	TEST METHOD
PIPE DIA. (2")	☒ AIR	☒ GAUGE
PIPE LENGTH (450')	☐ NITROGEN	☐ CHART
PIPE TYPE PE	☐ WATER	☐ GAUGE/ PRESS REC SN#
MIN. DURATION 2 HOURS	☒ SOAP	☒ PRESS REC SN# 209393 CALIB. 05-11-15
TEST PRES. (PSIG)	102 PSI	102 PSI
TIME	7:00	9:00
DATE	3-26-16	3-26-16
PERFORMED BY	MANUEL ACOSTA APL	

TEST BLOCK 1	TEST MEDIUM	TEST METHOD
PIPE DIA. (2") (4")	☒ AIR	☒ GAUGE
PIPE LENGTH (1,709') (1,272')	☐ NITROGEN	☐ CHART
PIPE TYPE PE	☐ WATER	☐ GAUGE/ PRESS REC SN#
MIN. DURATION 2 HOURS	☒ SOAP	☒ PRESS REC SN# 209393 CALIB. 05-11-15
TEST PRES. (PSIG)	104 PSI	104 PSI
TIME	7:00 AM	9:00 AM
DATE	3-23-16	3-23-16
PERFORMED BY	MANUEL ACOSTA APL	

TEST BLOCK 3	TEST MEDIUM	TEST METHOD
PIPE DIA. (4")	☒ AIR	☒ GAUGE
PIPE LENGTH (29')	☐ NITROGEN	☐ CHART
PIPE TYPE PE	☐ WATER	☐ GAUGE/ PRESS REC SN#
MIN. DURATION 2 HOURS	☒ SOAP	☒ PRESS REC SN# 209393 CALIB. 05-11-15
TEST PRES. (PSIG)	100 PSI	100 PSI
TIME	7:00	9:00
DATE	4-7-16	4-7-16
PERFORMED BY	MANUEL ACOSTA APL	

TEST BLOCK 4	TEST MEDIUM	TEST METHOD
PIPE DIA. (2") (4")	☒ AIR	☒ GAUGE
PIPE LENGTH (1,236') (362')	☐ NITROGEN	☐ CHART
PIPE TYPE PE	☐ WATER	☐ GAUGE/ PRESS REC SN#
MIN. DURATION 2 HOURS	☒ SOAP	☒ PRESS REC SN# 382280 CALIB. 03-25-16 02-09-17
TEST PRES. (PSIG)	104	104
TIME	12:00PM	2:00PM
DATE	03/01/2017	03/01/2017
PERFORMED BY	ALDO ROJAS APL	

VISUAL INSPECTION CERTIFICATION
I HAVE VISUALLY INSPECTED ALL HEATED FUSIONS, SOLVENT CEMENT, MECHANICAL JOINTS, AND WELDS THAT I HAVE PERFORMED
NAME: MANUEL ACOSTA APL DATE: 04/26/2016
ALDO ROJAS APL DATE: 04/26/2016
ALDO ROJAS APL DATE: 03/16/2017

AS-BUILTS ACCEPTED BY: DATE: POSTED BY: DATE: POSTING QC'D BY: DATE:

TEST BLOCK 4	TEST MEDIUM	TEST METHOD
PIPE DIA. (2") (4")	☒ AIR	☒ GAUGE
PIPE LENGTH (1,236') (362')	☐ NITROGEN	☐ CHART
PIPE TYPE PE	☐ WATER	☐ GAUGE/ PRESS REC SN#
MIN. DURATION 2 HOURS	☒ SOAP	☒ PRESS REC SN# 382280 CALIB. 03-25-16 02-09-17
TEST PRES. (PSIG)	104	104
TIME	12:00PM	2:00PM
DATE	03/01/2017	03/01/2017
PERFORMED BY	ALDO ROJAS APL	

CONSTRUCTION
INSPECTOR: FOREMAN: MANUEL ACOSTA APL
REVIEWED BY:

PERMIT INFORMATION
CITY OF LAS VEGAS, NV
TAX CODE 02-0200

ISOLATION AREA
095

LOCATION
T20S R61E SEC 32 M.D.M.


W.R. NO.
3021514

ATLAS #/TILE #
x618y514

ENGINEER/TECH: ARIANA ALANIZ
ACCOUNT REP: PHONE: 702-365-2027
PROJECT CONTACT: ARIANA ALANIZ
SHEET NO: 2 OF 15 SCALE: N.T.S. DATE: 01/07/16
DWN. BY: ZONE ENG. CHKD. BY: APPVD. BY:

TITLE
GIR-CLV-PINTO & SHETLAND - STEEL REPLACEMENT

1

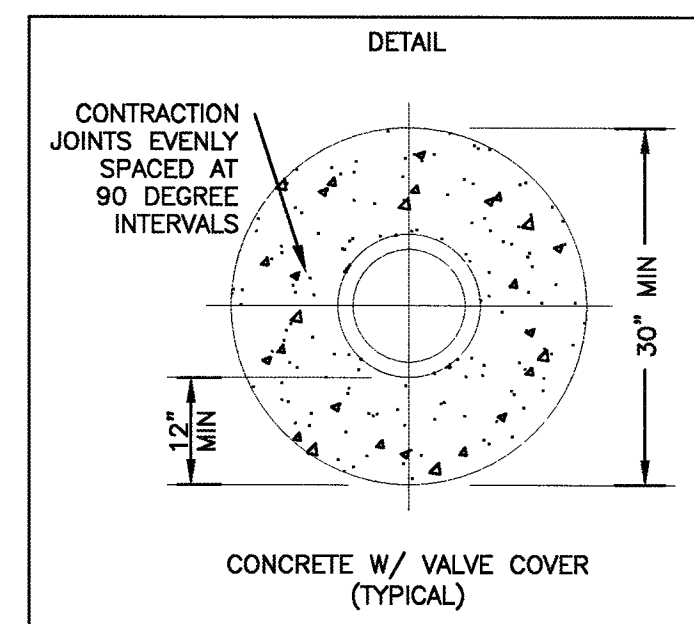

* WIRES SHOULD BE LONG
ENOUGH TO EXTEND AT
LEAST 2 FEET ABOVE GRADE


3. INSTALL CP TEST STATION. SEE DETAIL "B" ON SHEET 13 AND DETAIL "254" ON THIS SHEET.


WELDS CUT OUT:


WELD PROCEDURES USED:	
SIGNATURE _____	
DATE _____	

DETAIL "245"


PLASTIC TO STEEL TEST STATION

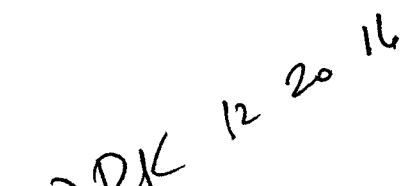

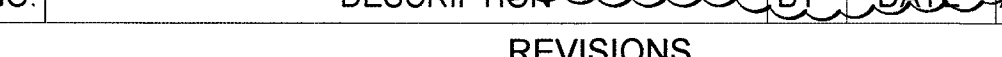 REVISED PROP ALIGNMENT & UPDATE QTY'S REV. 1 DECLINED BY THE CITY NEW 2" PE 16 WILL BE ABANDONED IN PLACE REVISED LOCATION BASED ON REV. 1 COMMENTS NO. _____ DESCRIPTION _____ BY _____ DATE _____ APPVD. _____	AA	5/4/16	 SOUTHWEST GAS CORPORATION														
	AA	12/12/2016															
REVISIONS		PROPERTY UNITS		AS-BUILT DRAWING-PRESSURE TEST DATA		VISUAL INSPECTION CERTIFICATION		CONSTRUCTION		ISOLATION AREA		W.R. NO.		ENGINEER/TECH: ARIANA ALANIZ		PHONE: 702-365-2027	
								I HAVE VISUALLY INSPECTED ALL HEATED FUSIONS, SOLVENT CEMENT, MECHANICAL JOINTS, AND WELDS THAT I HAVE PERFORMED		INSPECTOR _____ FOREMAN _____ REVIEWED BY SEE SHEET 2		095		3021514		ACCOUNT REP: _____ PROJECT CONTACT: ARIANA ALANIZ PHONE: 702-365-2027	
								NAME _____ DATE _____		PERMIT INFORMATION CITY OF LAS VEGAS, NV		LOCATION T20S R61E SEC 32 M.D.M.		ATLAS #/TILE # x618y514		SHEET NO: 3 OF 15 DWN. BY: ZONE ENG. CHKD. BY: _____ DATE: 01/07/16 APPVD. BY: _____	
								TEST MEDIUM TEST METHOD PIPE DIA. _____ ☐ AIR ☐ GAUGE PIPE LENGTH _____ ☐ NITROGEN ☐ CHART PIPE TYPE _____ ☐ WATER ☐ GAUGE/ MIN. DURATION _____ SOAP PRESS REC SN# _____		AS-BUILT'S ACCEPTED BY _____ DATE _____ POSTED BY _____ DATE _____ POSTING QC'D BY _____ DATE _____						TITLE GIR-CLV-PINTO & SHETLAND - STEEL REPLACEMENT	
								TEST PRES. (PSIG) _____ START _____ END _____ TIME _____ DATE _____ PERFORMED BY _____									

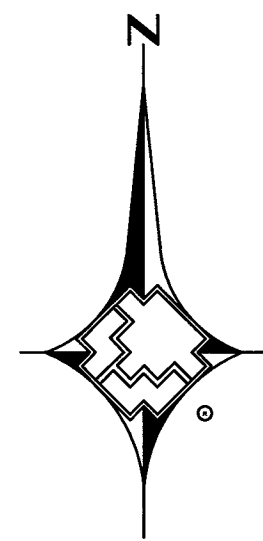


0 1" = 40' 40

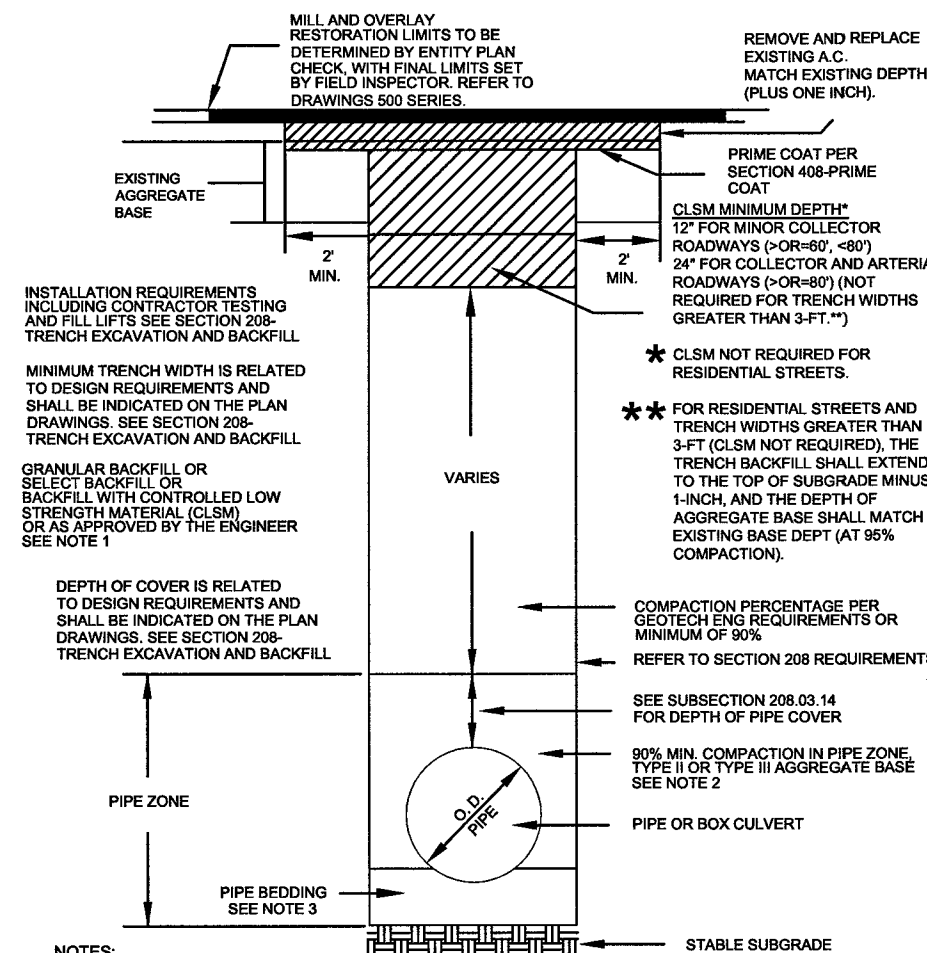

- NOTES:
1. NO STONES OR LUMPS GREATER THAN 3" PERMITTED IN TRENCH 2' OR LESS IN WIDTH.
 2. TRENCH WIDTH, BEDDING, SUBGRADE AND PIPE ZONE REQUIREMENTS FOR UTILITY INSTALLATIONS SHALL CONFORM TO THE RESPECTIVE ENTITY REQUIREMENTS.
 3. CRUSHED ROCK MAY BE USED FOR PIPE BEDDING ONLY IF MATERIAL USE HAS BEEN SPECIFICALLY APPROVED BY THE GOVERNING AGENCY. SEE STANDARD DRAWING NO. 505 FOR PIPE BEDDING METHODS.
 4. LAS VEGAS VALLEY WATER DISTRICT REQUIRES PIPE BEDDING AND BACKFILL WITHIN THE PIPE ZONE TO BE OF THE SAME MATERIAL.

RTC STD DWG 503

MATCHLINE - SEE SHEET 12 FOR CONTINUATION

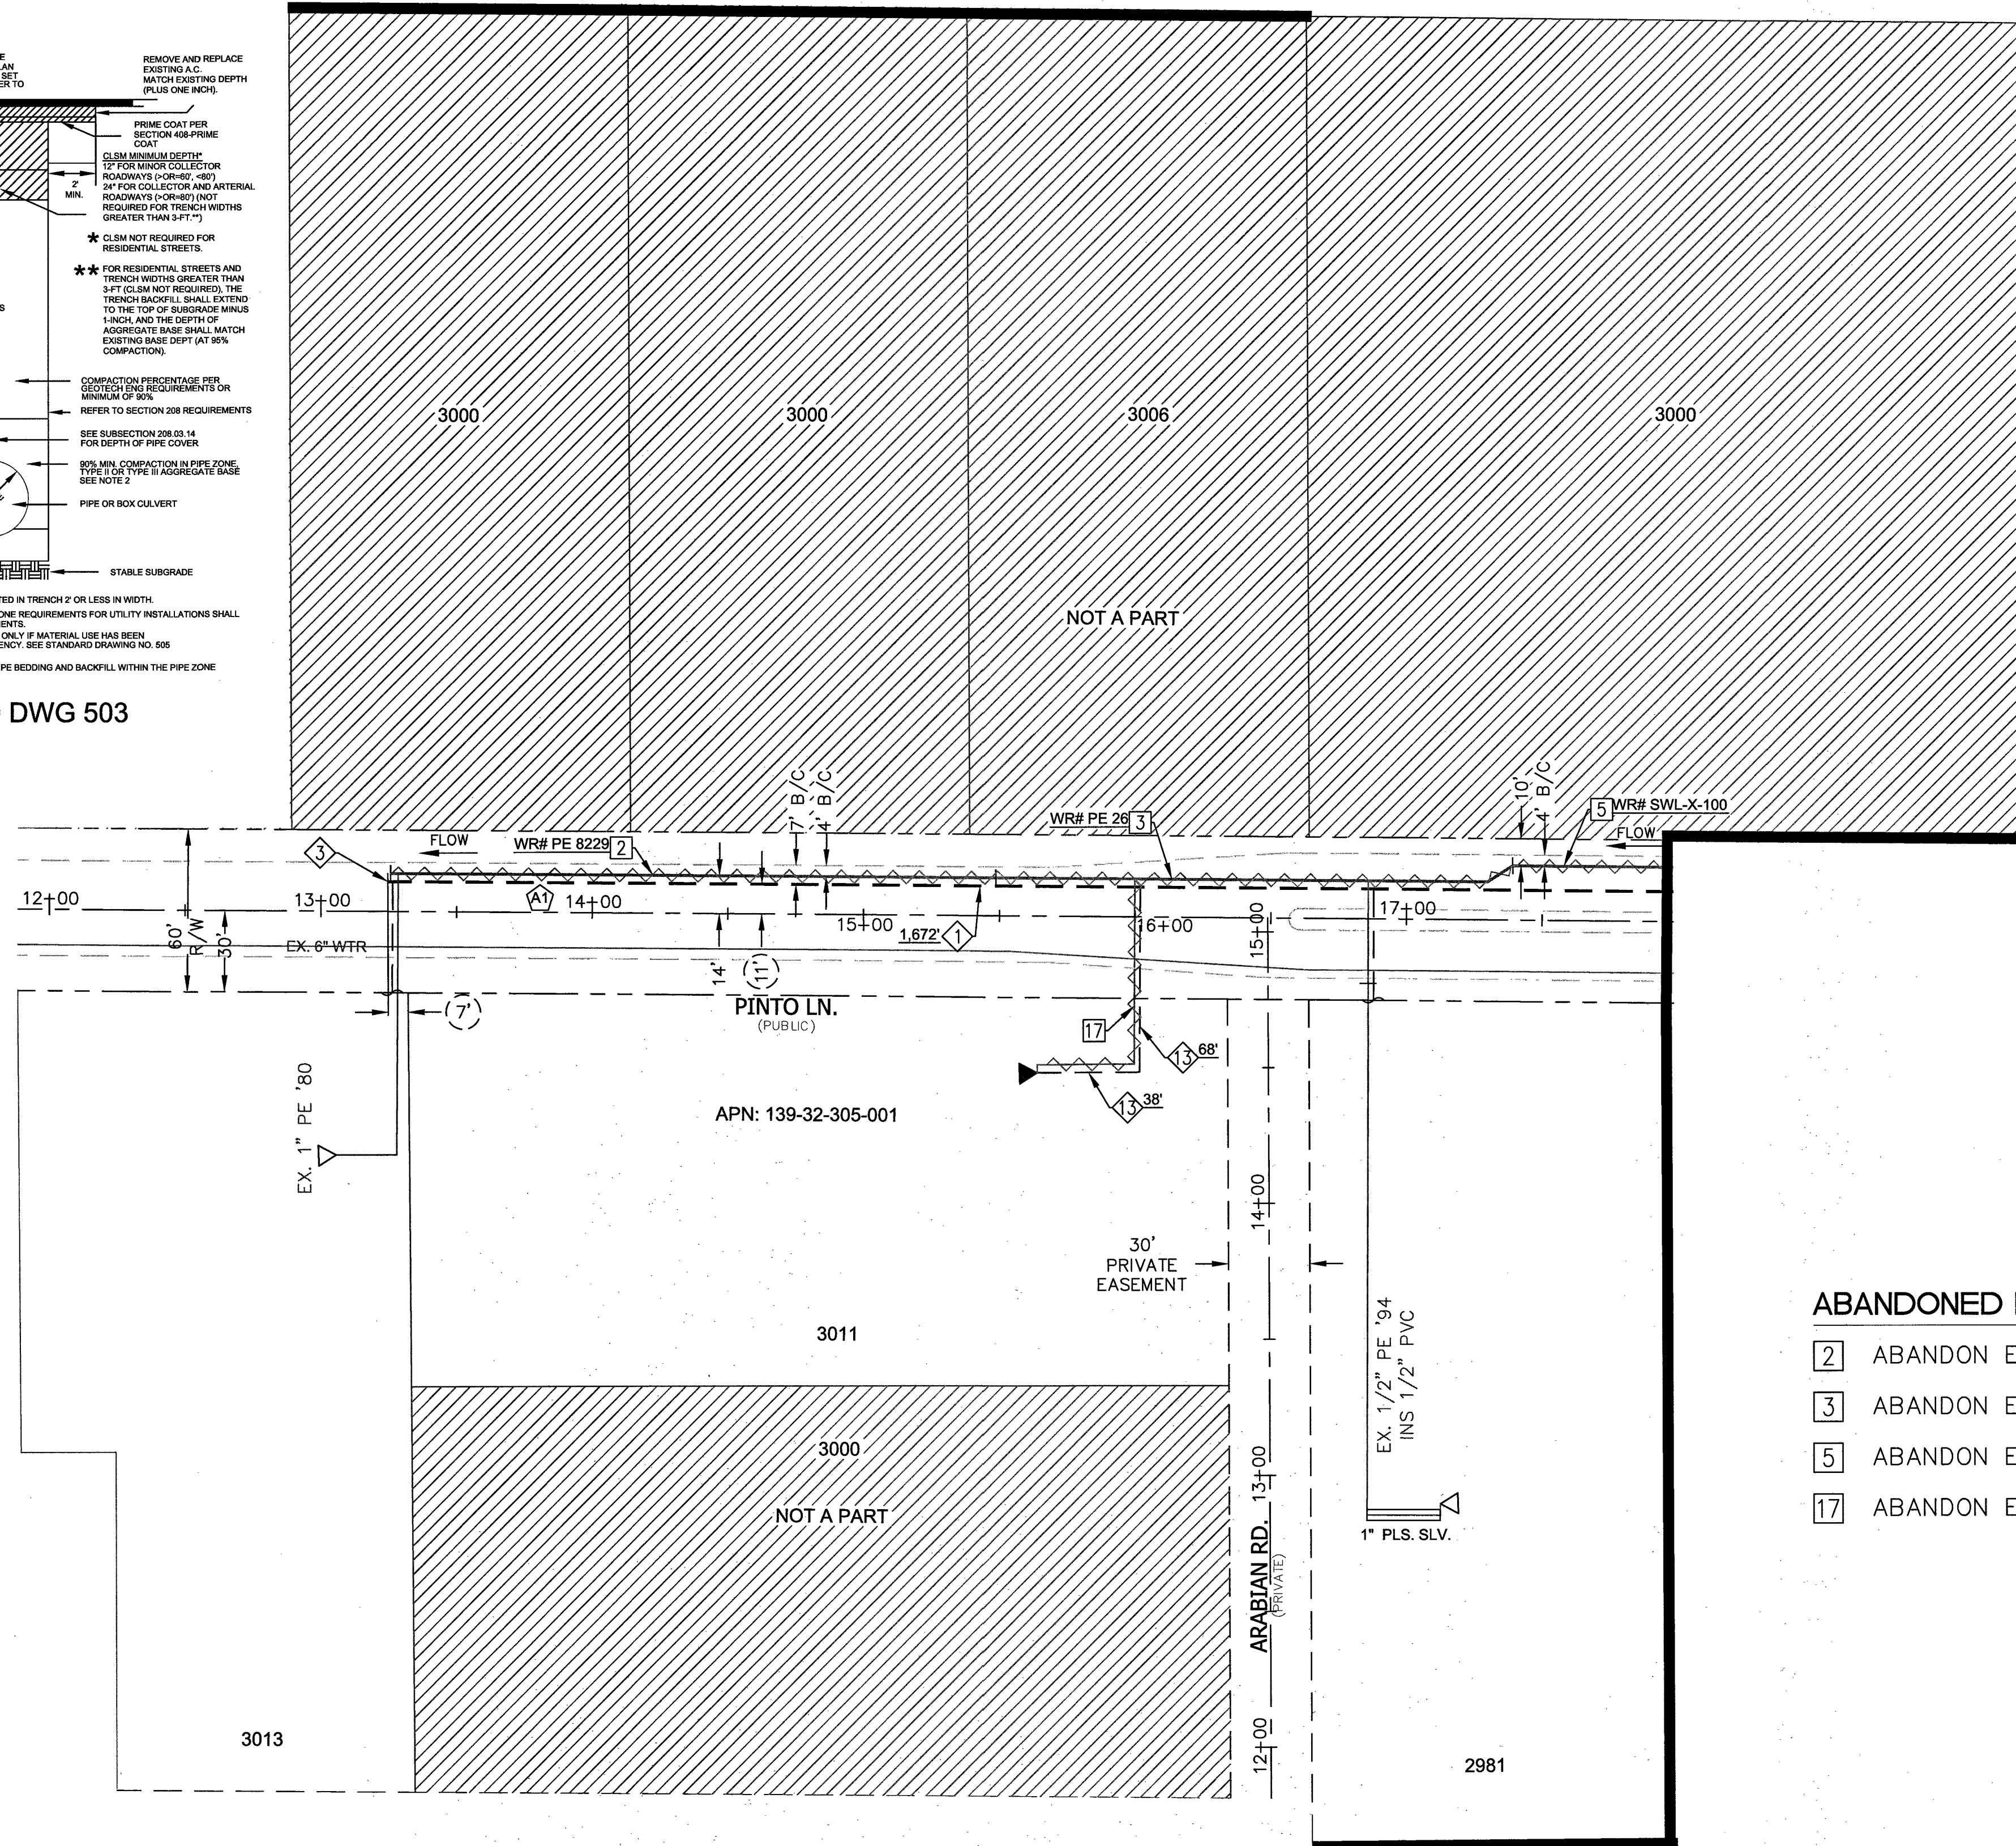

MATCHLINE - SEE SHEET 5 FOR CONTINUATION

ABANDONED FACILITIES:

- 2 ABANDON EX. 2" PE '80 MOP 43#
- 3 ABANDON EX. 2" PVC '58 MOP 43#
- 5 ABANDON EX. 2" STL '57 MOP 43#
- 17 ABANDON EX. 1/2" PE '77 SVC


PROPOSED FACILITIES:

- 1 PROP. 2" PE MAIN
- 3 PROP. 2" PE CAP (140-3060)
- 13 PROP. 1" PE SVC

RTC NOTES:

PAVEMENT REPAIR SHALL CONFORM TO RTC STANDARD(S):

- A1 500.4
- A3 503

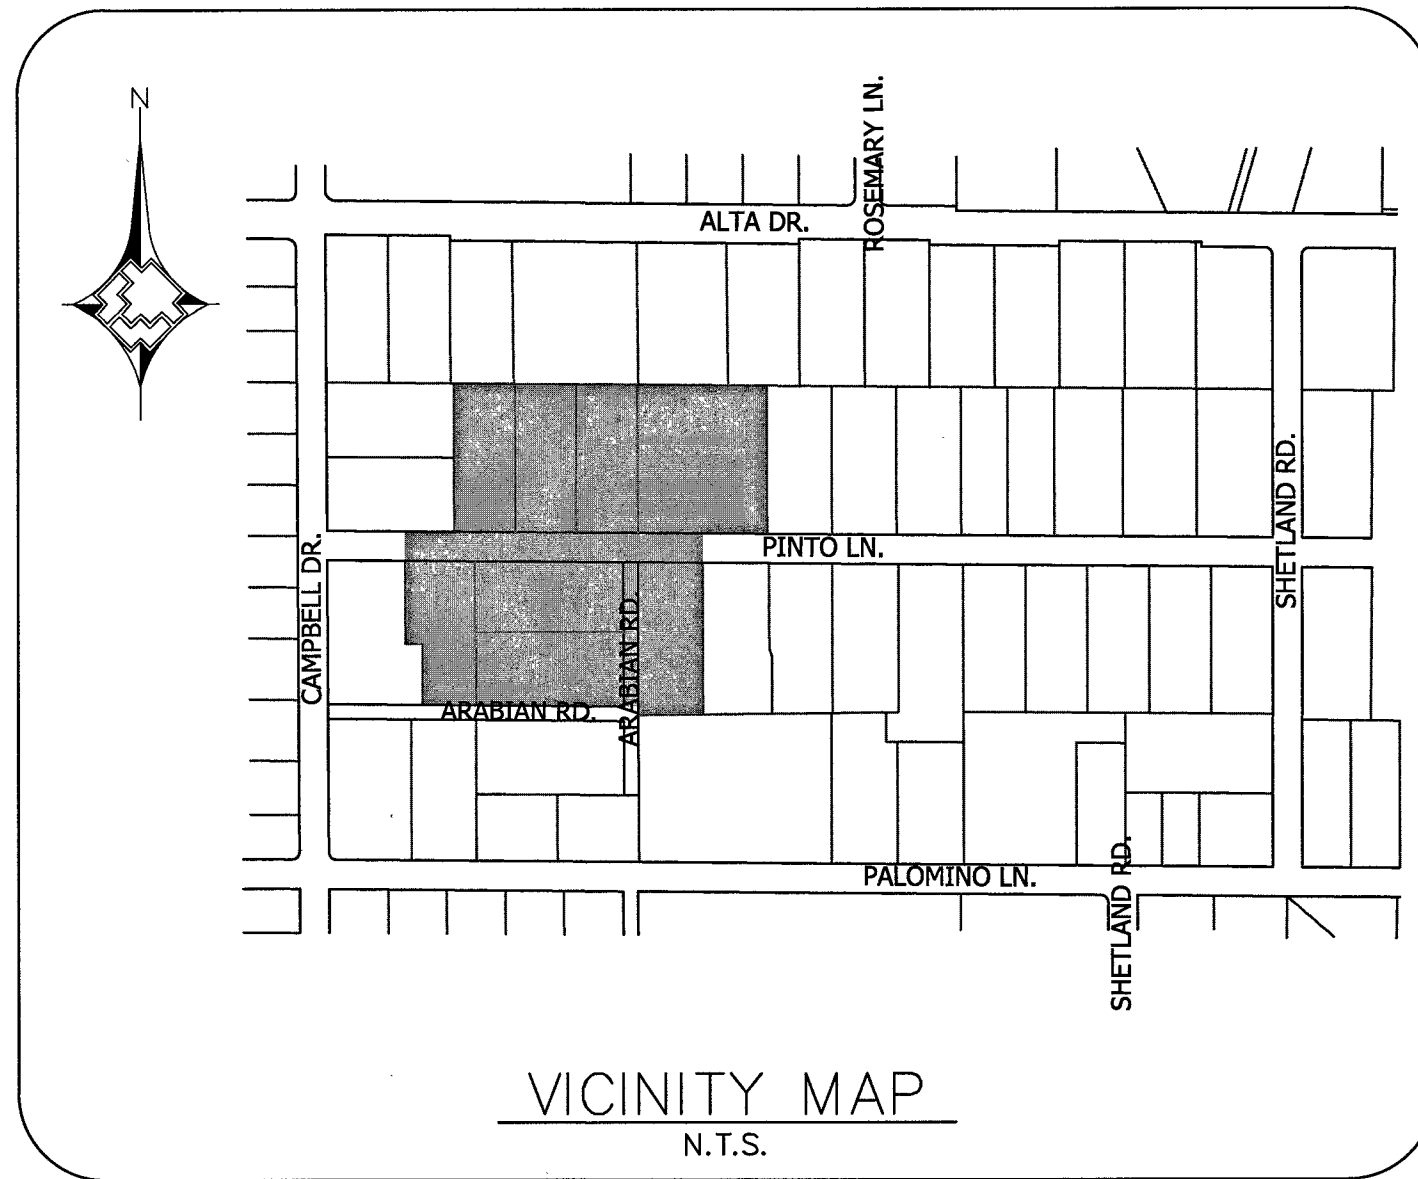


VICINITY MAP
N.T.S.


LEGEND:

- EXISTING GAS LINE
- GAS LINE TO BE ABANDONED
- EXISTING GAS SERVICE
- PROPOSED MAIN GAS LINE (NEW)
- PROPOSED SERVICE LATERAL (NEW)
- PROPOSED SERVICE LINE (NEW)
- RIGHT OF WAY LINE
- STREET CENTERLINE
- PROPERTY LINE
- BACK OF CURB
- MATCHLINE
- EASEMENT
- EXISTING ANODELESS RISER
- EXISTING ANODE RISER
- EXISTING GAS LIGHT
- EXISTING GAS VALVE


MATCHLINE - SEE SHEET 9 FOR CONTINUATION

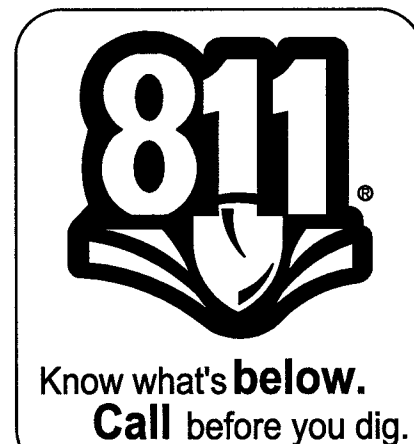

1. 2. 3. 4. NO. DESCRIPTION BY DATE APPVD.				AS-BUILT DRAWING-PRESSURE TEST DATA				VISUAL INSPECTION CERTIFICATION				CONSTRUCTION				ISOLATION AREA		W.R. NO.		ENGINEER/TECH: ARIANA ALANIZ ACCOUNT REP: PROJECT CONTACT: ARIANA ALANIZ SHEET NO: 4 OF 15 DWN. BY: ZONE ENG.				PHONE: 702-365-2027 PHONE: PHONE: 702-365-2027 DATE: 01/07/16 APPVD. BY:			
REVISIONS				PIPE DIA. PIPE LENGTH PIPE TYPE MIN. DURATION				TEST MEDIUM TEST METHOD GAUGE/ PRESS REC SN#				NAME DATE				INSPECTOR FOREMAN REVIEWED BY				095		3021514		TITLE			
				TEST PRES. (PSIG) TIME DATE PERFORMED BY				START END				SEE SHEET 2				PERMIT INFORMATION CITY OF LAS VEGAS, NV TAX CODE 02-0200				LOCATION T20S R61E SEC 32 M.D.M.		ATLAS #/TILE # x618y514		GIR-CLV-PINTO & SHETLAND - STEEL REPLACEMENT			
SOUTHWEST GAS CORPORATION				TAX CODES UNIT NO. UNIT TYPE				INSTL. RETIRED PROPOSED COMPLETED																			

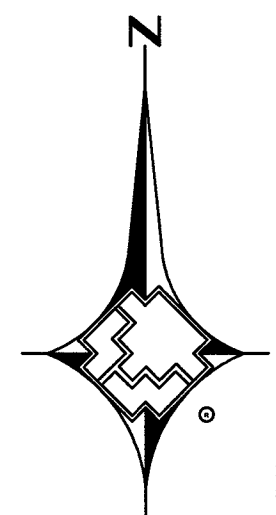


1" = 40'

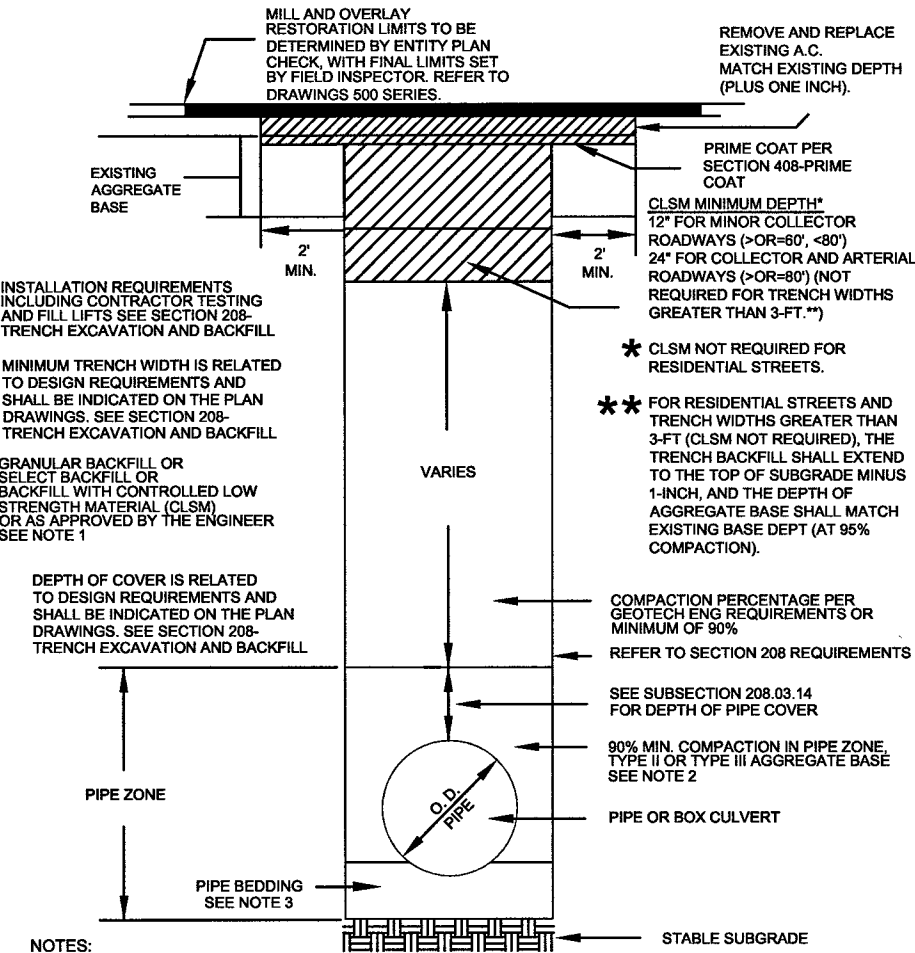

- NOTES:
1. NO STONES OR LUMPS GREATER THAN 3" PERMITTED IN TRENCH 2' OR LESS IN WIDTH.
 2. TRENCH WIDTH, BEDDING, SUBGRADE AND PIPE ZONE REQUIREMENTS FOR UTILITY INSTALLATIONS SHALL CONFORM TO THE RESPECTIVE ENTITY REQUIREMENTS.
 3. CRUSHED ROCK MAY BE USED FOR PIPE BEDDING ONLY IF MATERIAL USE HAS BEEN SPECIFICALLY APPROVED BY THE GOVERNING AGENCY. (SEE STANDARD DRAWING NO. 505 FOR PIPE BEDDING METHODS).
 4. LAS VEGAS VALLEY WATER DISTRICT REQUIRES PIPE BEDDING AND BACKFILL WITHIN THE PIPE ZONE TO BE OF THE SAME MATERIAL.

RTC STD DWG 503


MATCHLINE - SEE SHEET 4
FOR CONTINUATION

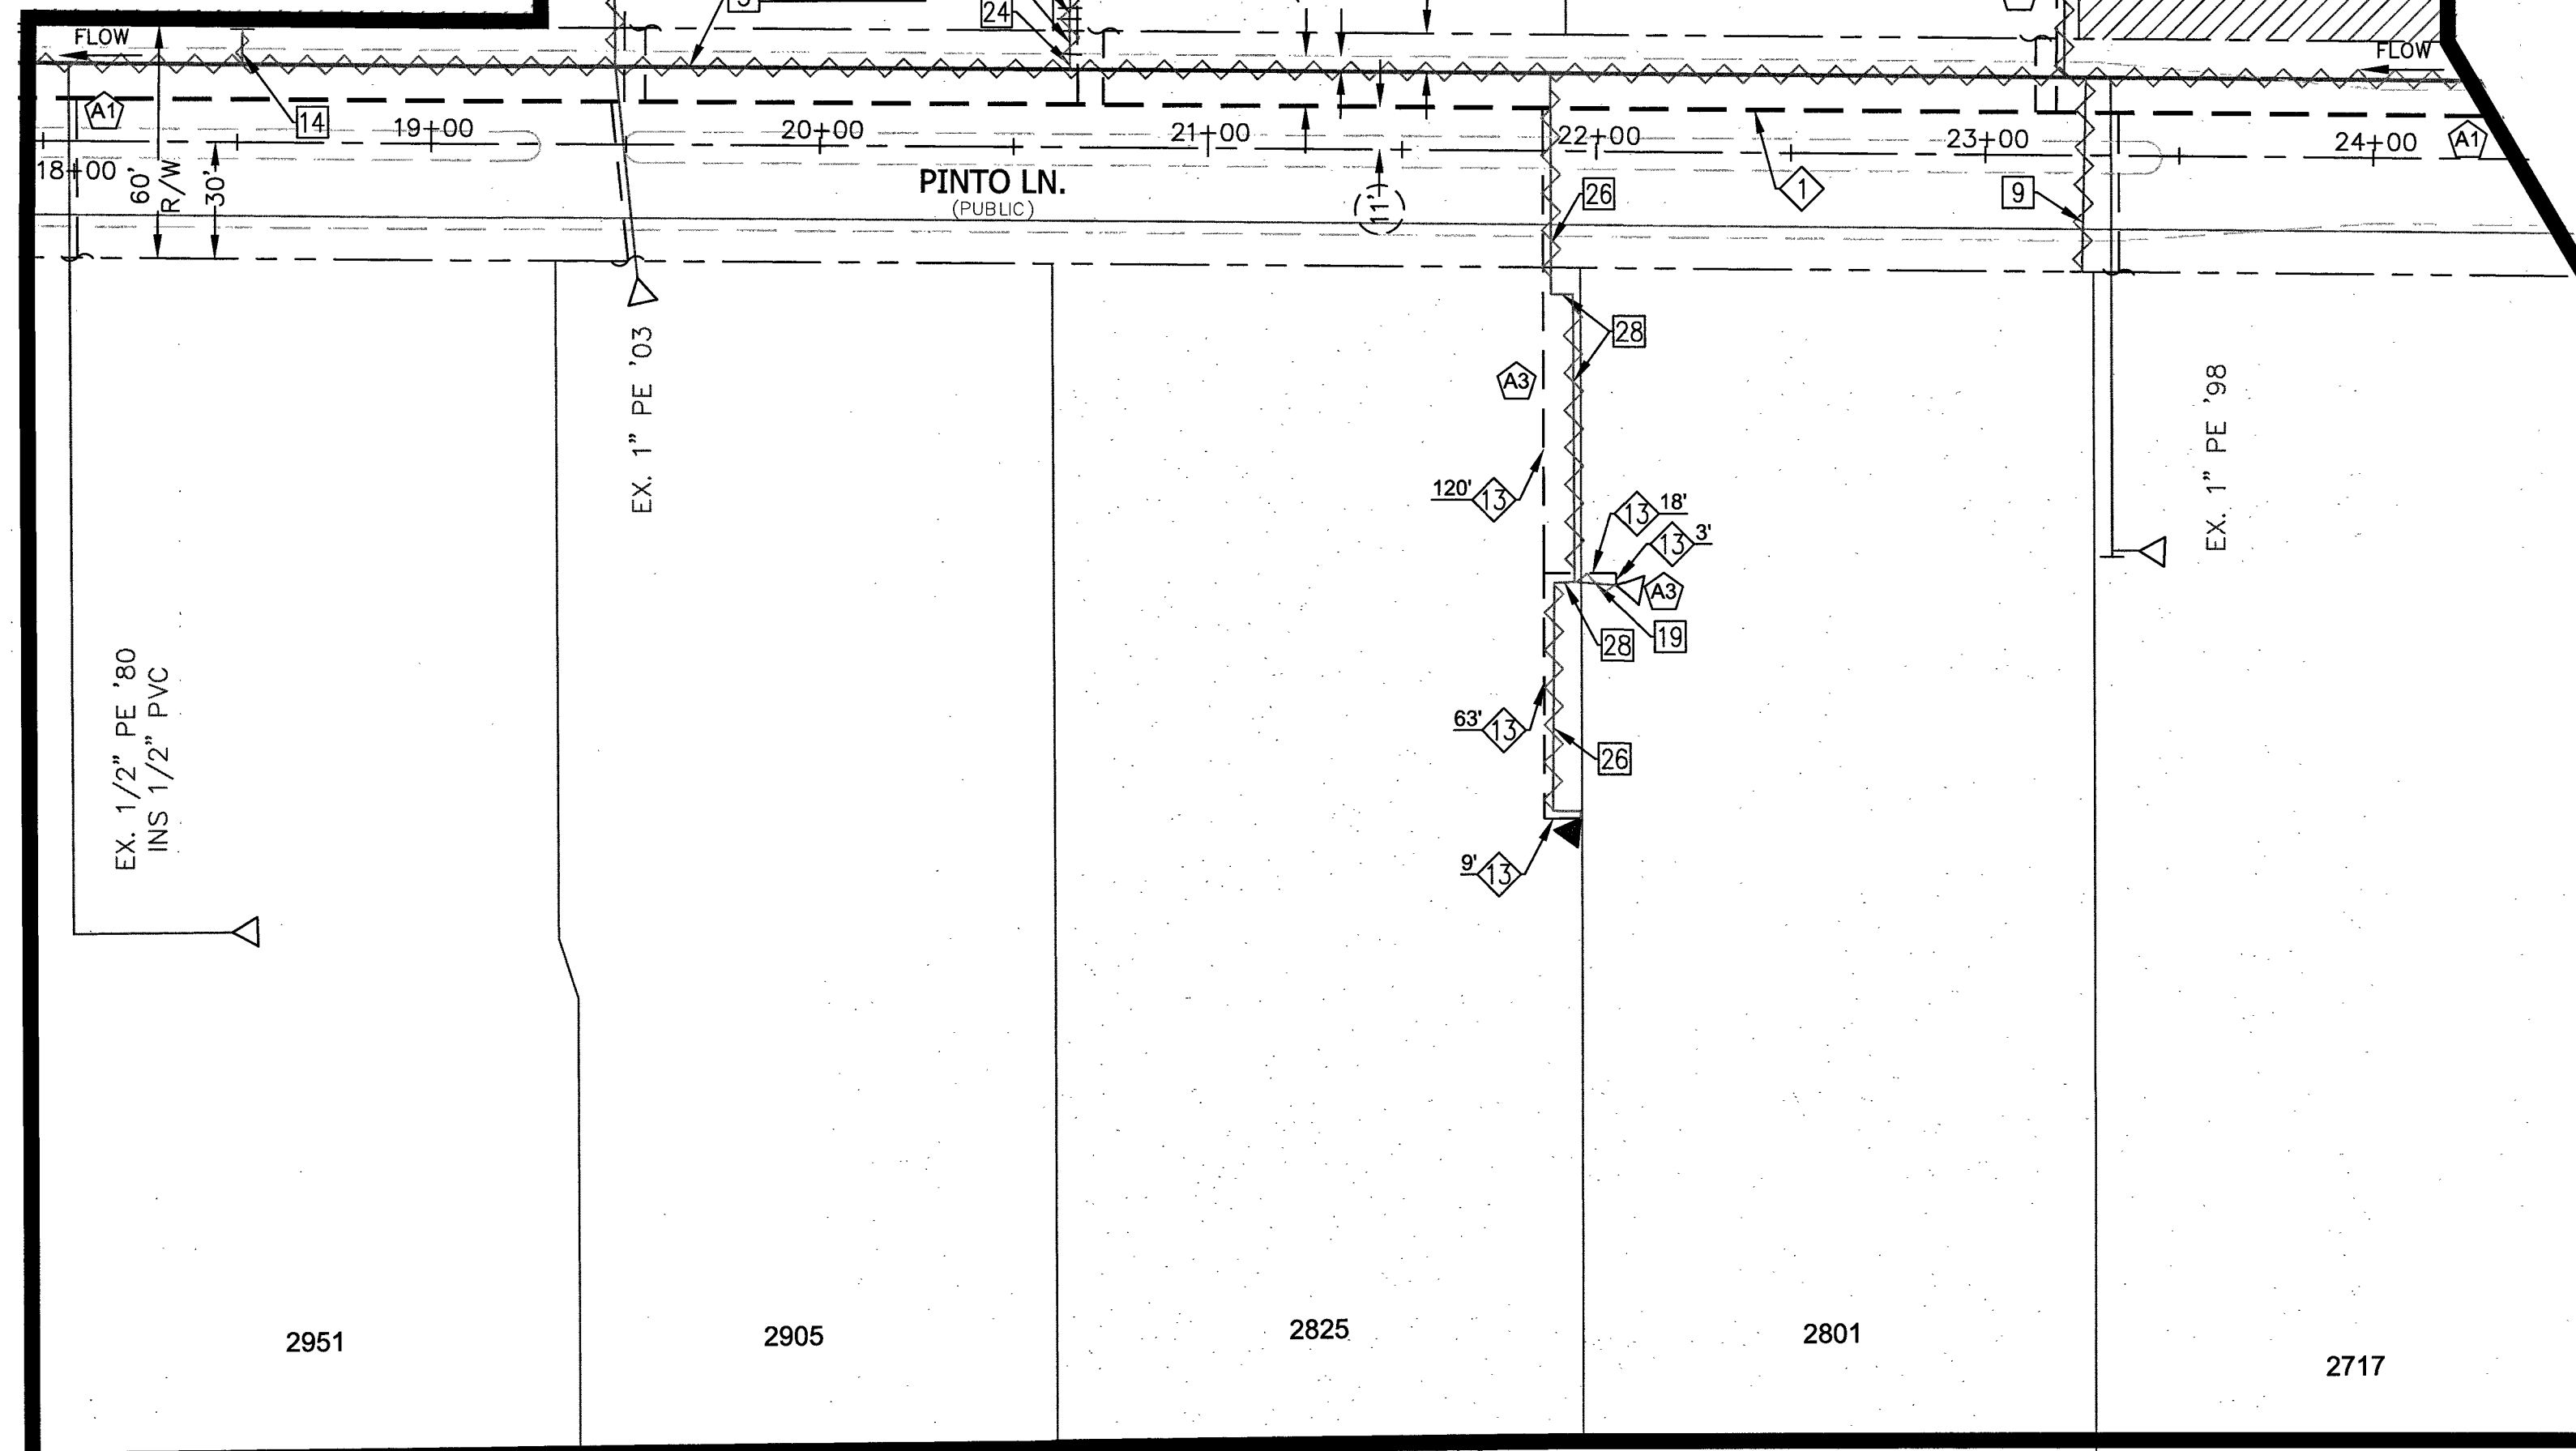

MATCHLINE - SEE SHEET 9
FOR CONTINUATION


MATCHLINE - SEE SHEET 8
FOR CONTINUATION

MATCHLINE - SEE SHEET 6 FOR CONTINUATION

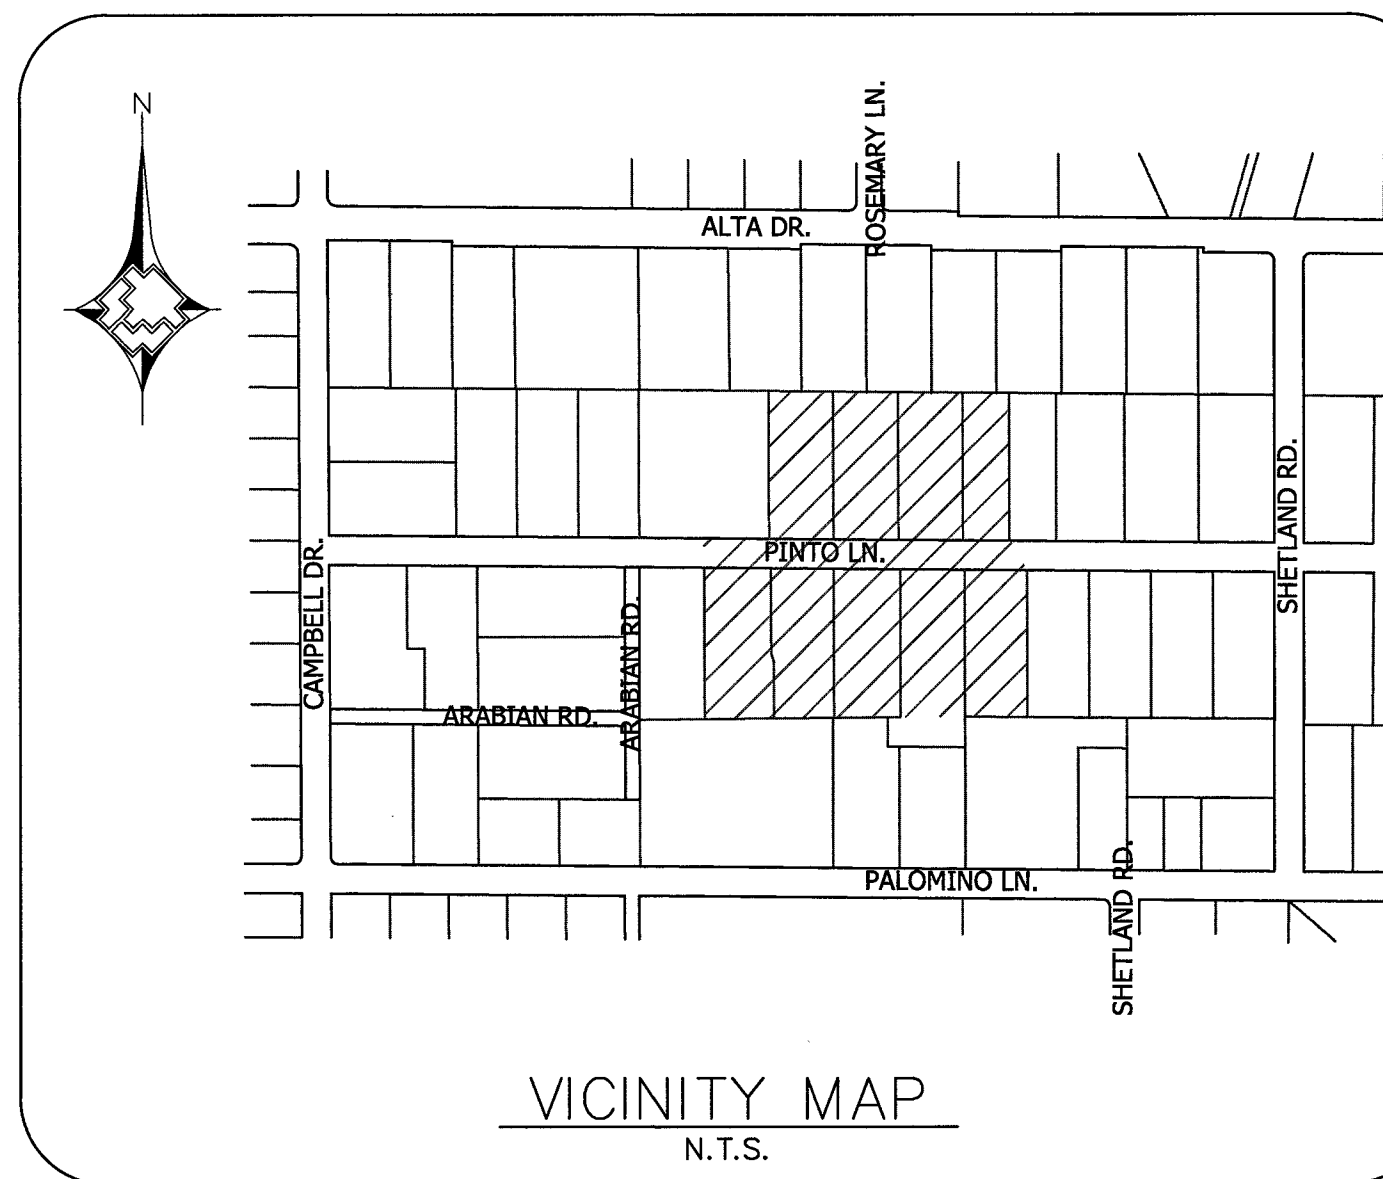

VICINITY MAP
N.T.S.

LEGEND:

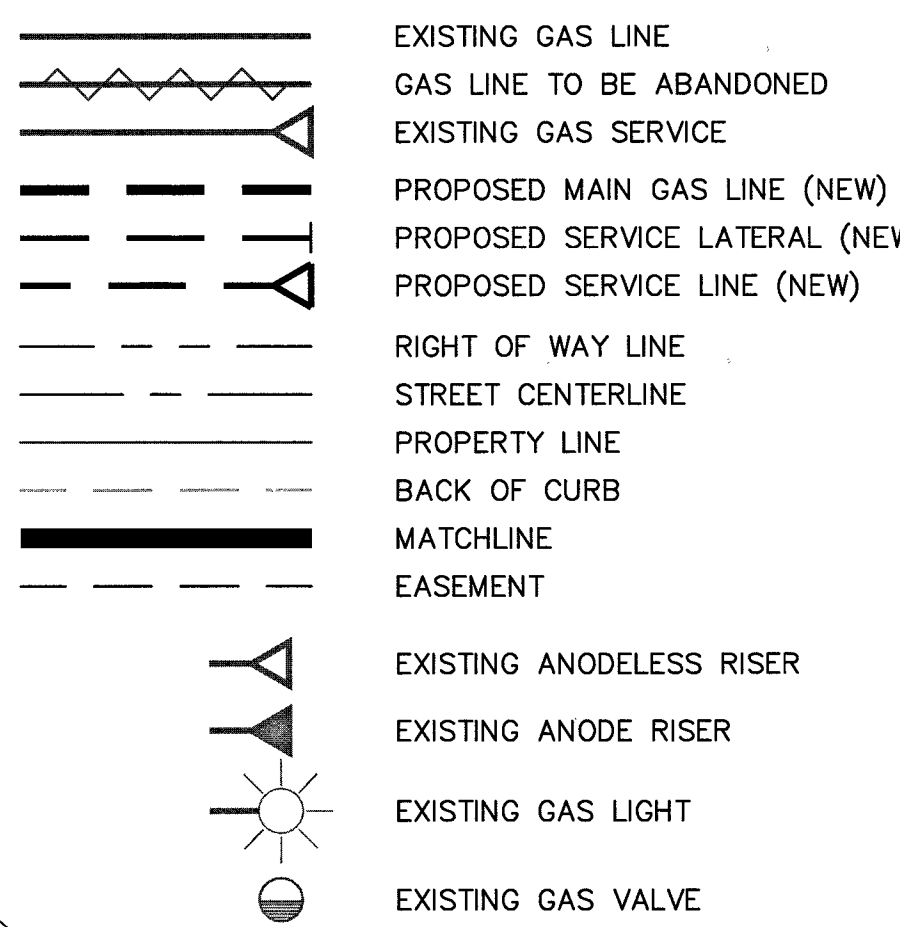

ABANDONED FACILITIES:

- 5 ABANDON EX. 2" STL '57 MOP 43#
- 9 ABANDON EX. 1/2" PVC '62 SVC
- 14 ABANDON EX. 3/4" STL '74 SVC
- 19 ABANDON EX. 1/2" PE '89 SVC
- 20 ABANDON EX. 1/2" PE '99 SVC
- 22 ABANDON EX. 1/2" PVC '60 SVC
- 24 ABANDON EX. 1/2" PVC '67 SVC
- 25 ABANDON EX. 1/2" PVC '69 SVC
- 26 ABANDON EX. 1/2" PVC '71 SVC
- 28 ABANDON EX. 1/2" PVC '75 SVC

PROPOSED FACILITIES:

- 14 PROP. 2" PE MAIN
- 13 PROP. 1" PE SVC

RTC NOTES:

- PAVEMENT REPAIR SHALL CONFORM TO RTC STANDARD(S):
- A1 500.4
 - A3 503





1. 2. 3. 4. NO. DESCRIPTION BY DATE APPVD.				AS-BUILT DRAWING-PRESSURE TEST DATA				VISUAL INSPECTION CERTIFICATION				CONSTRUCTION				ISOLATION AREA		W.R. NO.		ENGINEER/TECH: ARIANA ALANIZ				PHONE: 702-365-2027			
				PIPE DIA. PIPE LENGTH PIPE TYPE MIN. DURATION				TEST MEDIUM TEST METHOD Gauge/Chart PRESS REC SN#				NAME DATE				INSPECTOR FOREMAN REVIEWED BY		095		3021514		ACCOUNT REP: PROJECT CONTACT: ARIANA ALANIZ				PHONE: 702-365-2027	
				TEST PRES. (PSIG) TIME DATE PERFORMED BY				START END				SEE SHEET 2				SEE SHEET 2						SHEET NO: 5 OF 15				DATE: 01/07/16	
				PROPERTY UNITS												PERMIT INFORMATION		LOCATION		ATLAS #/TITLE #		TITLE					
																CITY OF LAS VEGAS, NV		T20S R61E SEC 32 M.D.M.		x618y514		GIR-CLV-PINTO & SHETLAND - STEEL REPLACEMENT					
																TAX CODE											
																02-0200											




MATCHLINE - SEE SHEET 5 FOR CONTINUATION

MATCHLINE - SEE SHEET 11 FOR CONTINUATION

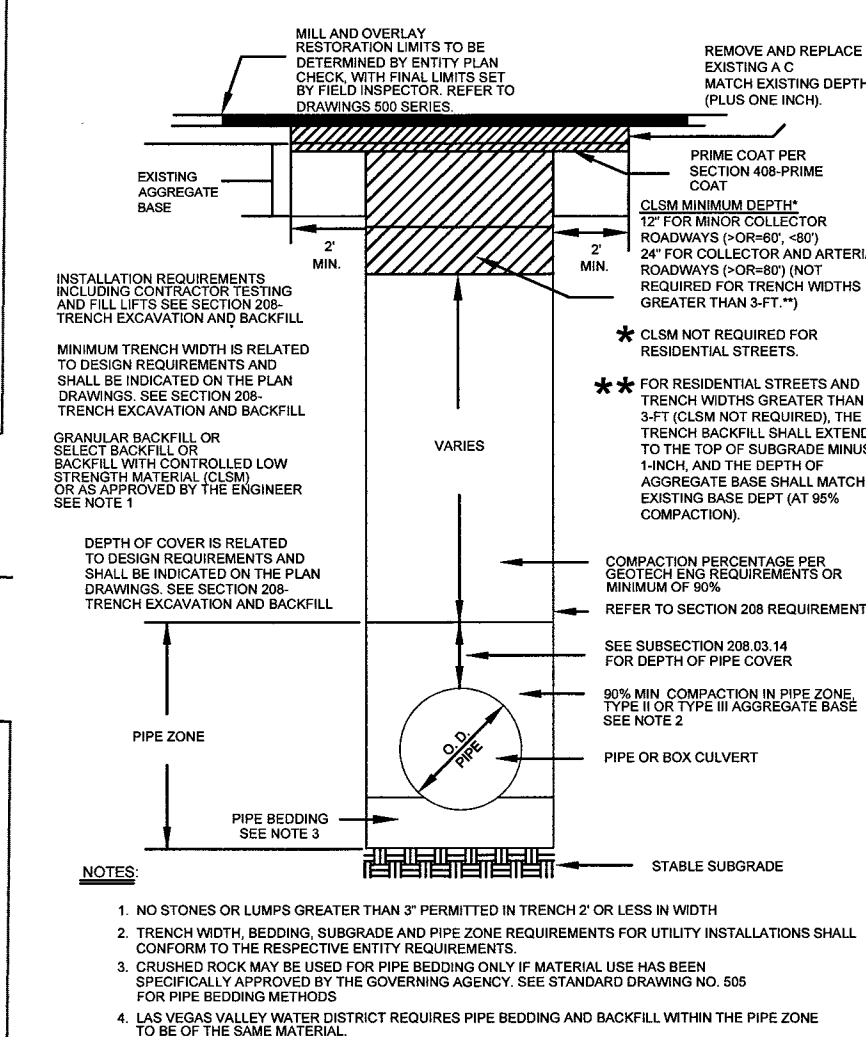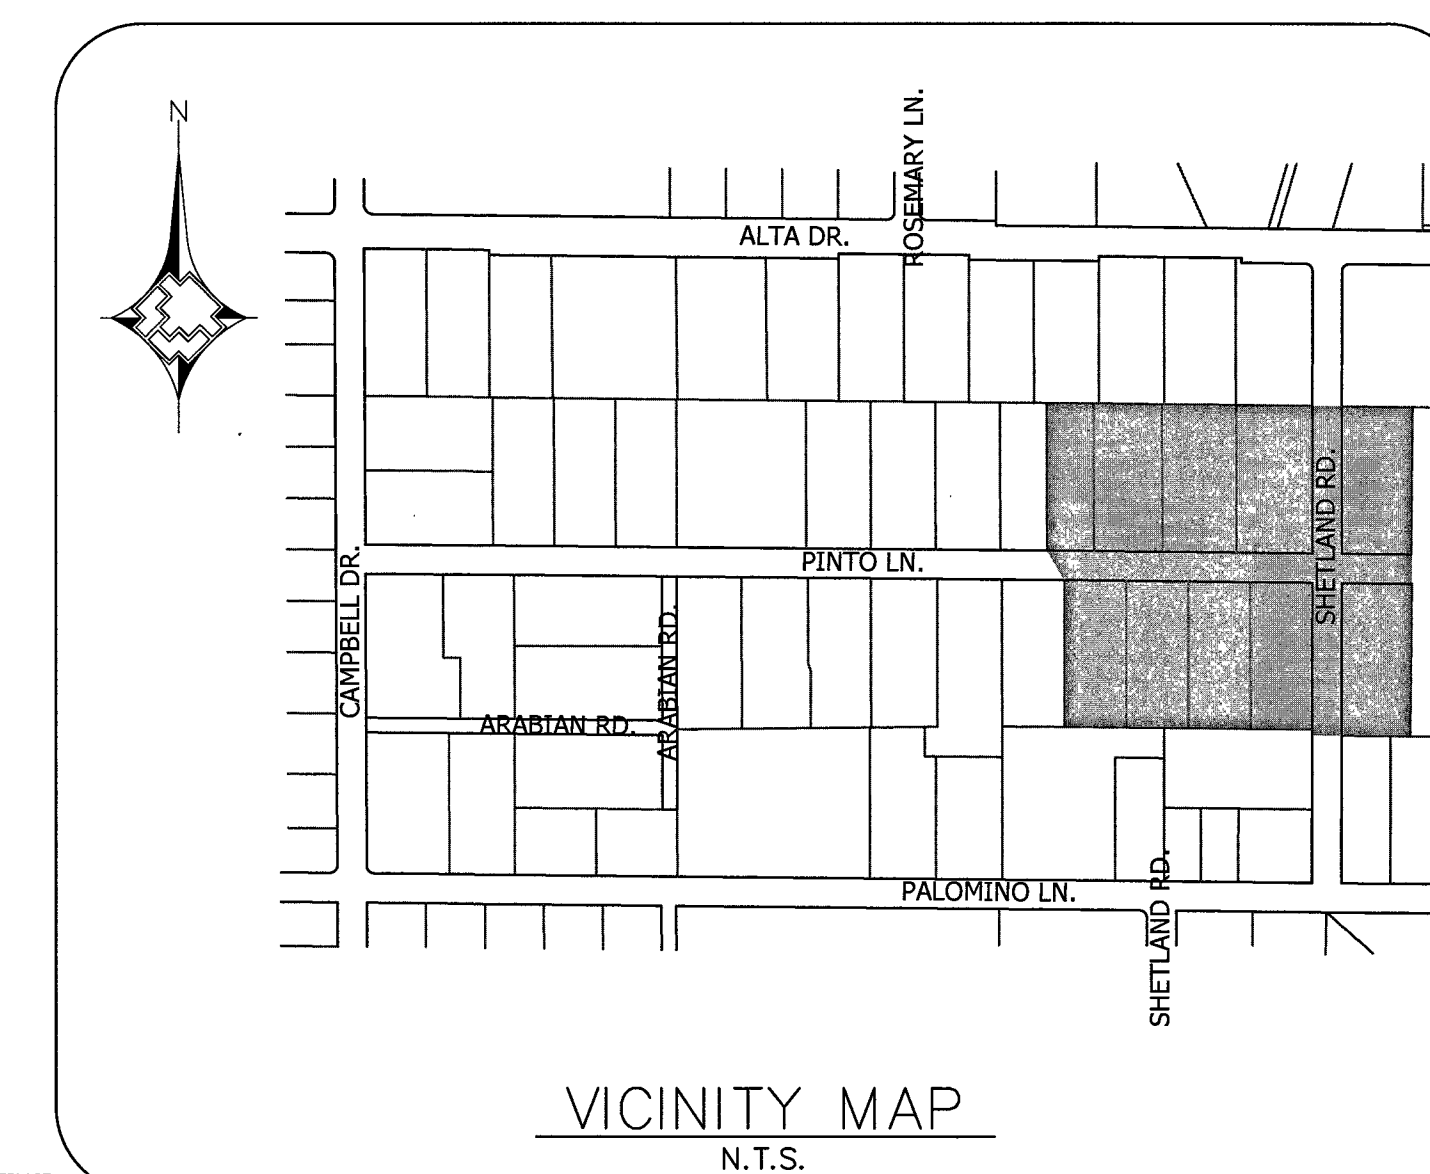

RTC STD DWG 503

LEGEND:

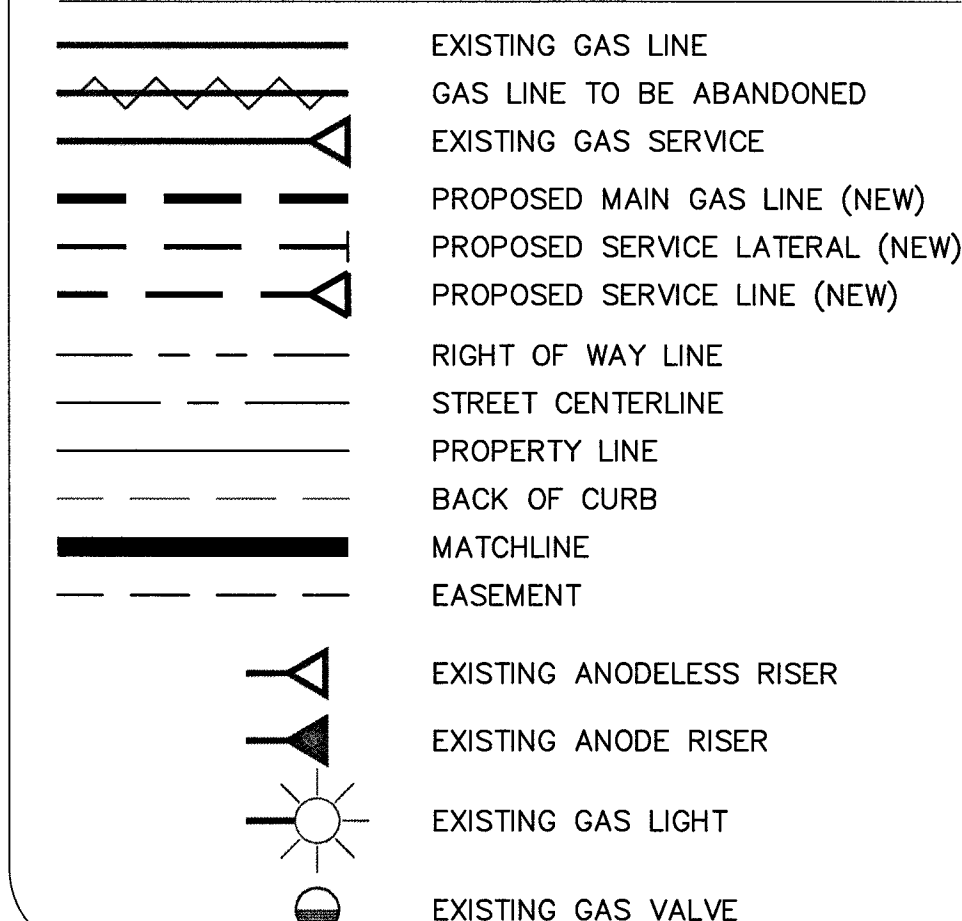

NEW FACILITIES:

- | | |
|----|--------------------------------------|
| 1 | NEW 2" PE MAIN - 479' |
| 5 | NEW 4" PE MAIN - 658" |
| 15 | NEW 3" PE SLEEVING (100-8075) - 475' |
| 16 | NEW 6" PE SLEEVING (100-8066) - 4' |
| B | BORE |


B-F BUTT FUSION


RTC NOTES:

PAVEMENT REPAIR SHALL CONFORM TO RTC
STANDARD(S):

- | | |
|----|-------|
| A1 | 500.4 |
| A2 | 500.5 |
| A3 | 503 |

REPL

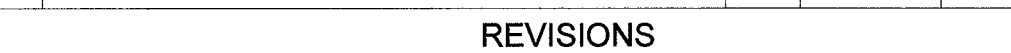
4.	AS-BUILT SUBMITTAL FOR FINAL CLOSE		SWG	8/9/17		
NO.	DESCRIPTION		BY	DATE	APPVD.	
REVISIONS						
						
TAX CODES	UNIT NO.	UNIT TYPE	INSTL. PROPOSED	RETIRED PROPOSED	INSTL. COMPLETED	RETIRED COMPLETED
PROPERTY UNITS						
AS-BUILT DRAWING-PRESSURE TEST DATA TEST MEDIUM TEST METHOD PIPE DIA. ☐ AIR ☐ GAUGE PIPE LENGTH ☐ NITROGEN ☐ CHART PIPE TYPE ☐ WATER ☐ GAUGE/ MIN. DURATION ☐ SOAP PRESS REC SN# TEST PRES. (PSIG) START END DATE PERFORMED BY						
VISUAL INSPECTION CERTIFICATION I HAVE VISUALLY INSPECTED ALL HEATED FUSIONS, SOLVENT CEMENT, MECHANICAL JOINTS, AND WELDS THAT I HAVE PERFORMED NAME DATE REVIEWED BY						
CONSTRUCTION INSPECTOR FOREMAN REVIEWED BY PERMIT INFORMATION CITY OF LAS VEGAS, NV TAX CODE 02-0200						
ISOLATION AREA			W.R. NO.		TITLE	
095			3021514		ENGINEER/TECH: ARIANA ALANIZ PHONE: 702-365-2027 ACCOUNT REP: PHONE: PROJECT CONTACT: ARIANA ALANIZ PHONE: 702-365-2027 SHEET NO: 6 OF 15 SCALE: 1" = 40' DATE: 01/07/16 DWN. BY: ZONE ENG. CHKD. BY: APPVD. BY:	
LOCATION			ATLAS #/TITLE #		GIR-CLV-PINTO & SHETLAND - STEEL REPLACEMENT	
T20S R61E SEC 32 M.D.M.			x618y514			

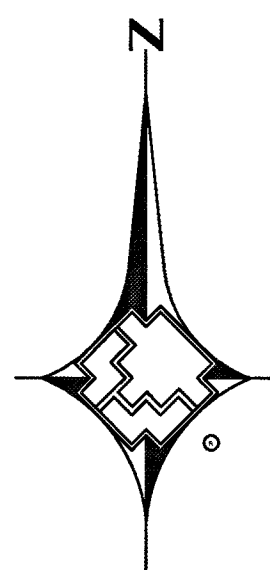

0 1" = 40' 40

MATCHLINE - SEE SHEET 5
FOR CONTINUATION


MATCHLINE - SEE SHEET 6
FOR CONTINUATION

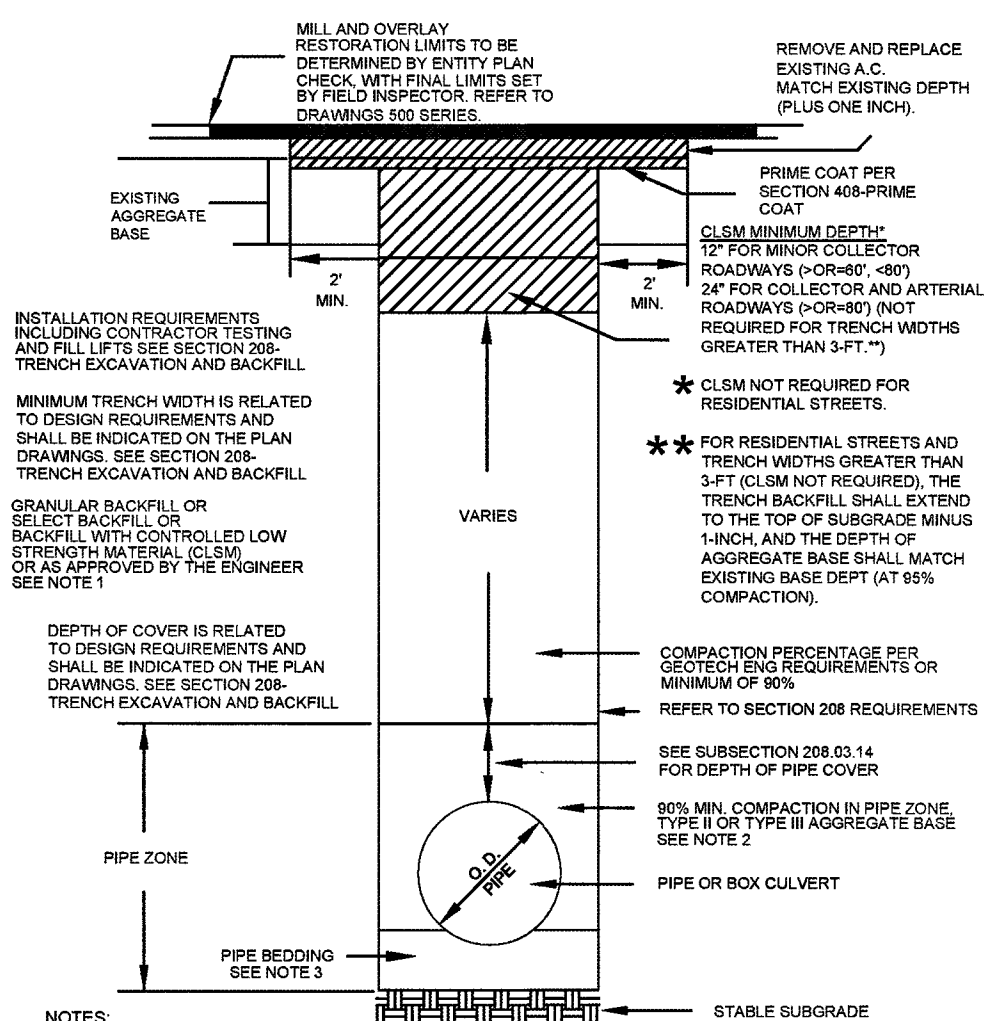


- NOTES
1. NO STONES OR LUMPS GREATER THAN 3" PERMITTED IN TRENCH 2' OR LESS IN WIDTH.
 2. TRENCH WIDTH, BEDDING, SUBGRADE AND PIPE ZONE REQUIREMENTS FOR UTILITY INSTALLATIONS SHALL CONFORM TO THE RESPECTIVE ENTITY REQUIREMENTS.
 3. CRUSHED ROCK MAY BE USED FOR PIPE BEDDING ONLY IF MATERIAL USE HAS BEEN SPECIFICALLY APPROVED BY THE GOVERNING AGENCY. SEE STANDARD DRAWING NO. 505 FOR PIPE BEDDING METHODS.
 4. LAS VEGAS VALLEY WATER DISTRICT REQUIRES PIPE BEDDING AND BACKFILL WITHIN THE PIPE ZONE TO BE OF THE SAME MATERIAL.

RTC STD DWG 503

MATCHLINE - SEE SHEET 9
FOR CONTINUATION

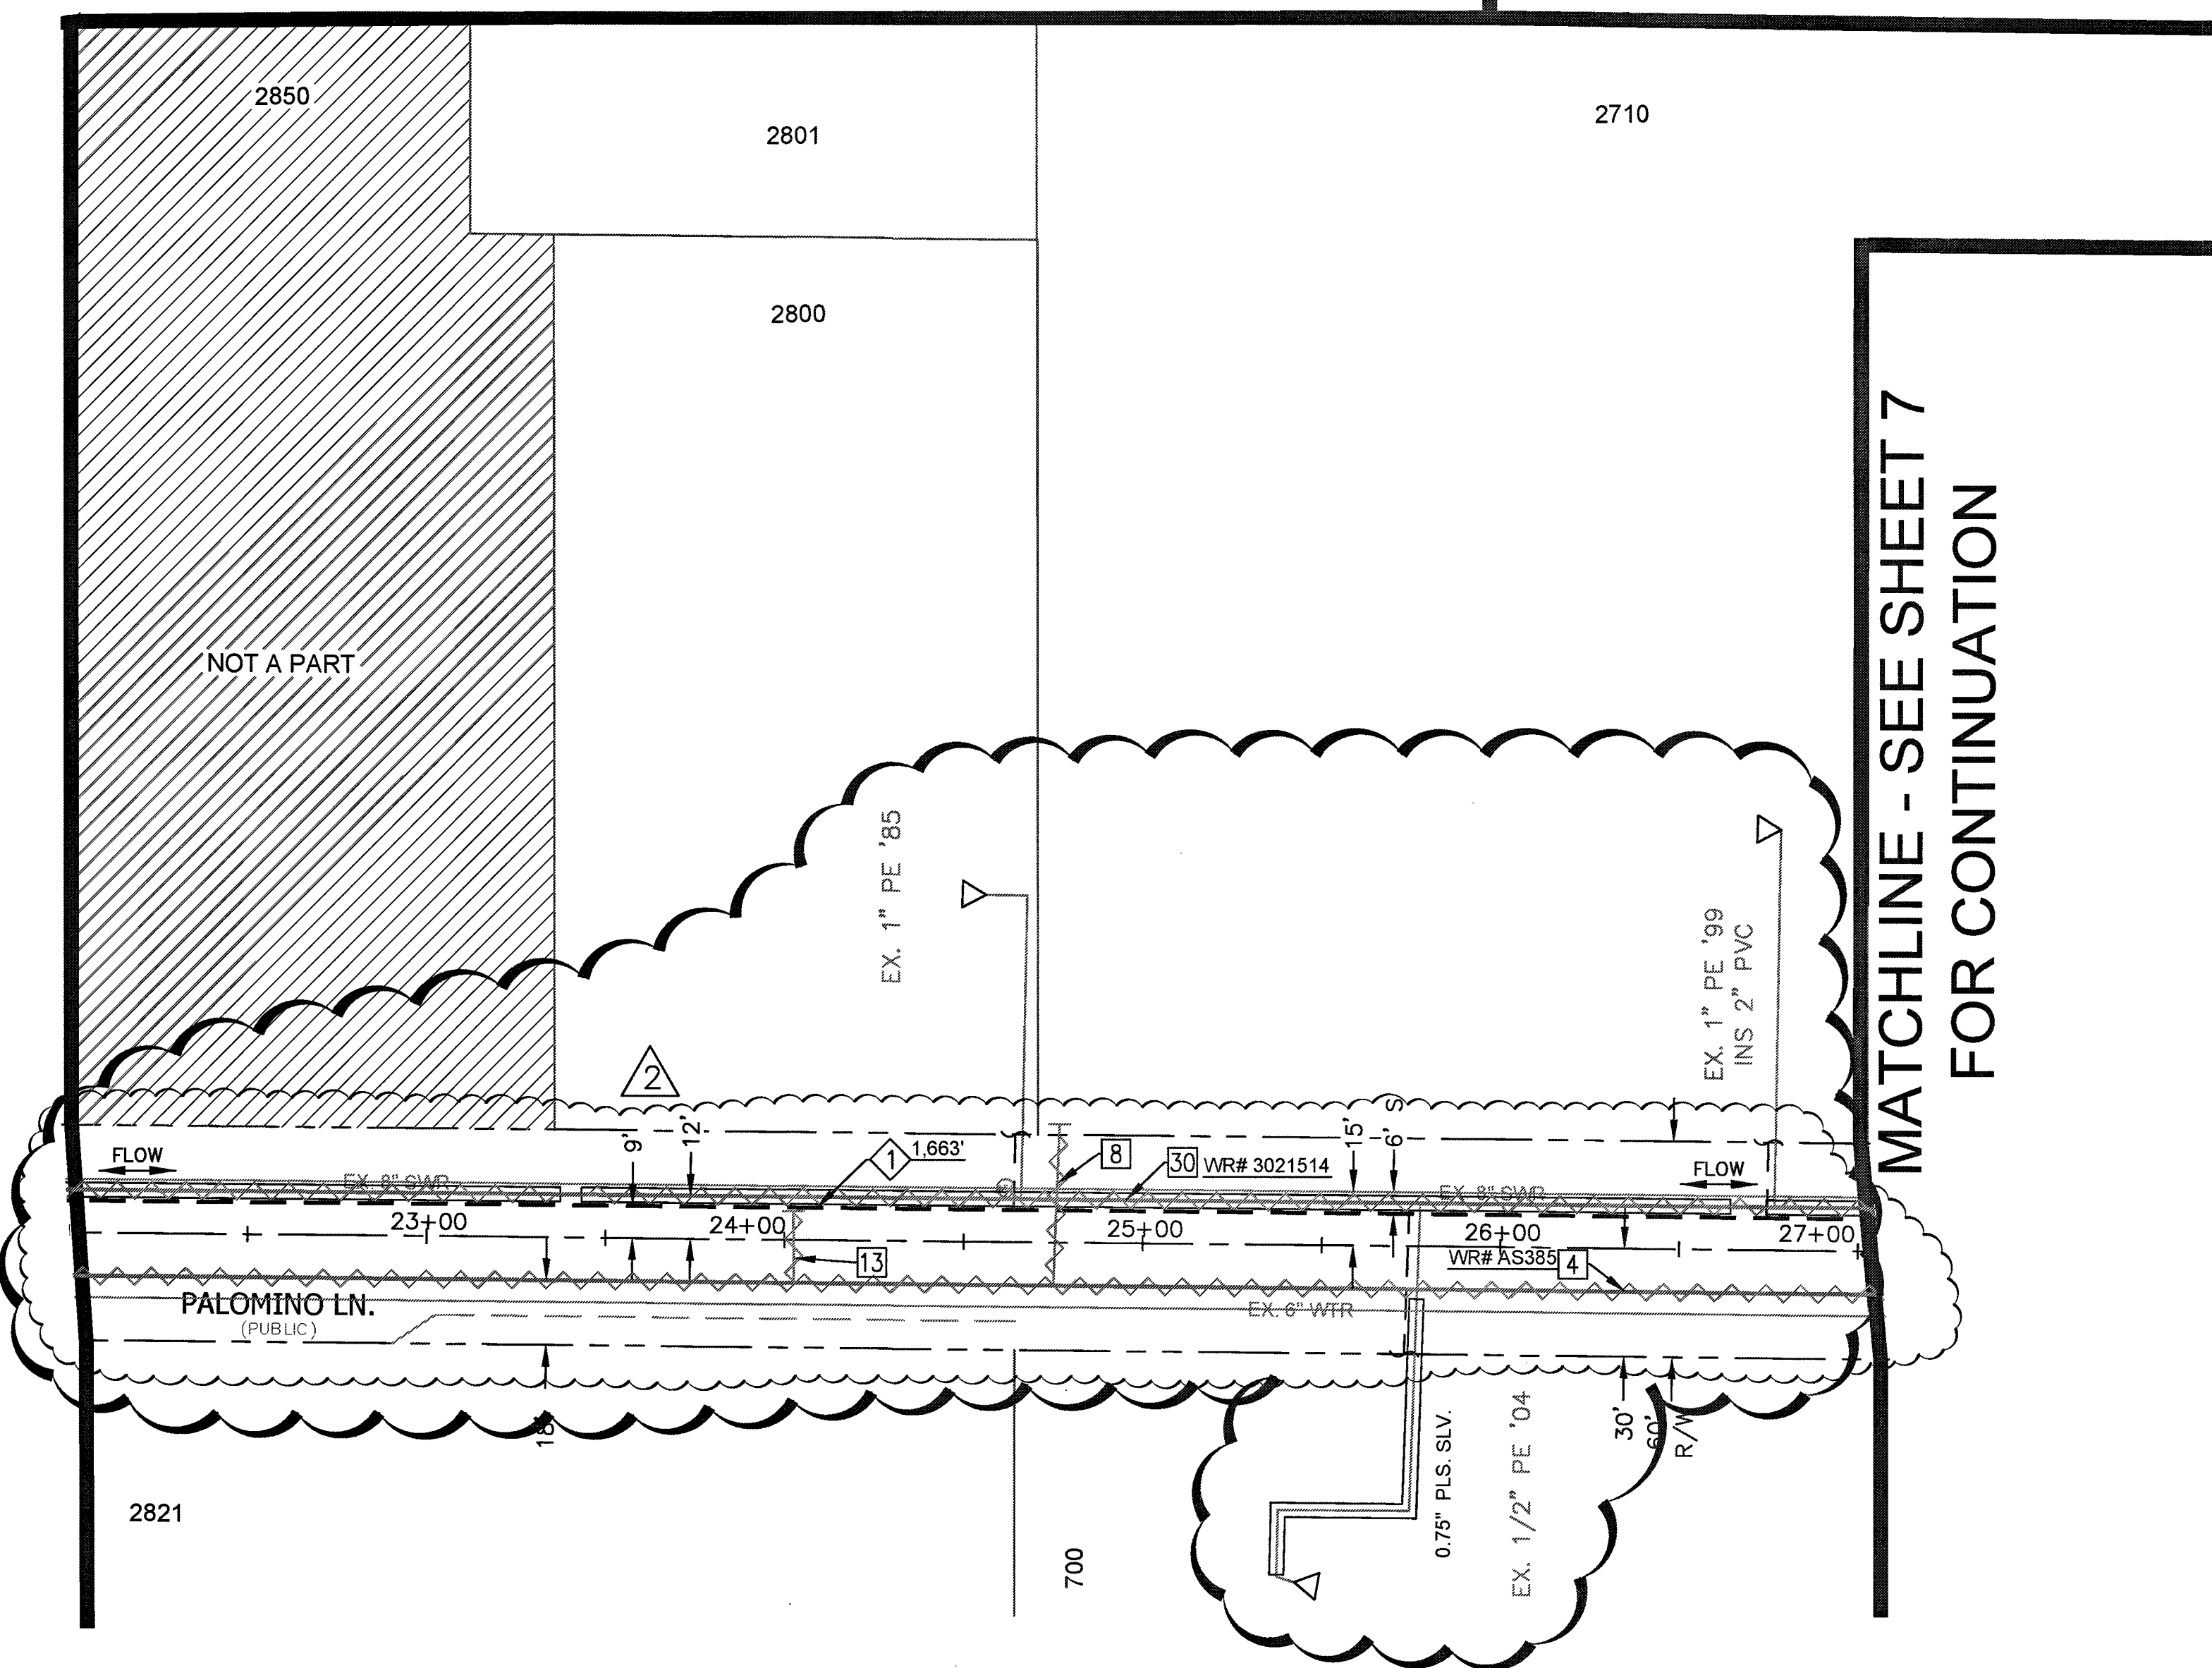

MATCHLINE - SEE SHEET 7
FOR CONTINUATION

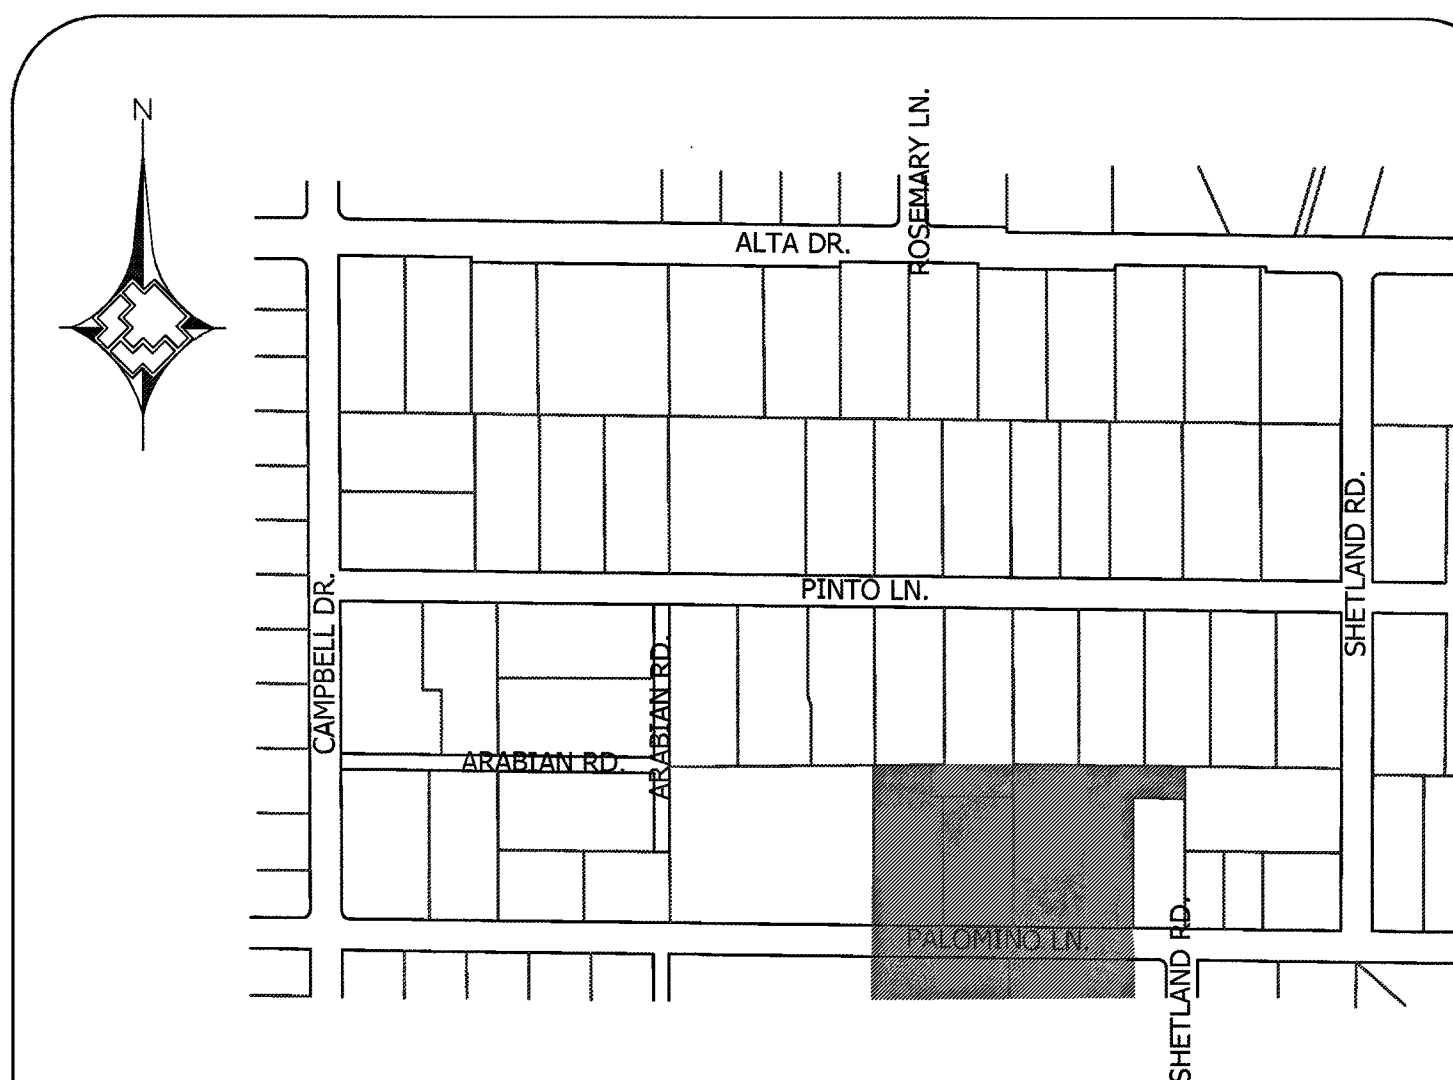

VICINITY MAP
N.T.S.

LEGEND:

- EXISTING GAS LINE
- GAS LINE TO BE ABANDONED
- EXISTING GAS SERVICE
- PROPOSED MAIN GAS LINE (NEW)
- PROPOSED SERVICE LATERAL (NEW)
- PROPOSED SERVICE LINE (NEW)
- RIGHT OF WAY LINE
- STREET CENTERLINE
- PROPERTY LINE
- BACK OF CURB
- MATCHLINE
- EASEMENT
- EXISTING ANODELESS RISER
- EXISTING ANODE RISER
- EXISTING GAS LIGHT
- EXISTING GAS VALVE

PROPOSED FACILITIES:

- 1 PROP. 2" PE MAIN

ABANDONED FACILITIES:

- 4 ABANDON EX. 2" STL '55 MOP 43#
- 13 ABANDON EX. 3/4" PVC '55 SVC
- 30 ABANDON EX. 2" PE '16 MOP 43#

RTC NOTES:

PAVEMENT REPAIR SHALL CONFORM TO RTC STANDARD(S):

- A1 500.4
- A3 503



NO.	DESCRIPTION	BY	DATE	APPVD
1	REVISED PROP ALIGNMENT & UPDATE QTY'S	AA	5/4/16	
2	REV. 1 DECLINED BY THE CITY			
3	NEW 2" PE '16 WILL BE ABANDONED IN PLACE			
4	REVISED LOCATION BASED ON REV. 1 COMMENTS	AA	12/12/2016	



TAX CODES	UNIT NO.	UNIT TYPE	INSTL. PROPOSED	RETIRED PROPOSED	INSTL. COMPLETED	RETIRED COMPLETED



PIPE DIA.	PIPE LENGTH	PIPE TYPE	MIN. DURATION	TEST PRES. (PSIG)	TIME	DATE	PERFORMED BY

NAME	DATE	AS-BUILTS ACCEPTED BY	DATE	POSTED BY	DATE	POSTING QC'D BY	DATE

INSPECTOR	FOREMAN	REVIEWED BY	PERMIT INFORMATION	TAX CODE
			CITY OF LAS VEGAS, NV	02-0200

ISOLATION AREA	W.R. NO.	LOCATION	ATLAS #/TILE #
095	3021514	T20S R61E SEC 32 M.D.M.	x618y514

ENGINEER/TECH: ARIANA ALANIZ			PHONE: 702-365-2027
ACCOUNT REP:			PHONE:
PROJECT CONTACT: ARIANA ALANIZ			PHONE: 702-365-2027
SHEET NO: 8 OF 15		SCALE: 1"=40'	DATE: 01/07/16
DWN. BY: ZONE ENG.		CHKD. BY:	APPVD. BY:
TITLE			
GIR-CLV-PINTO & SHETLAND - STEEL REPLACEMENT			

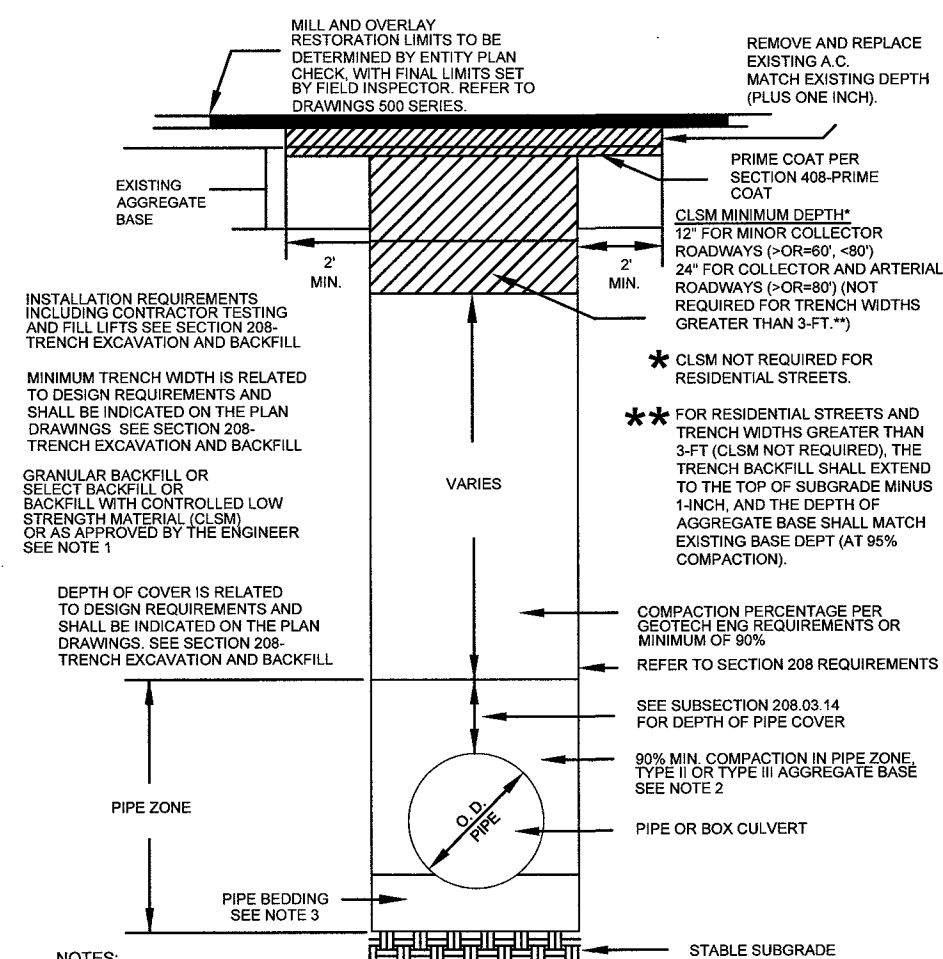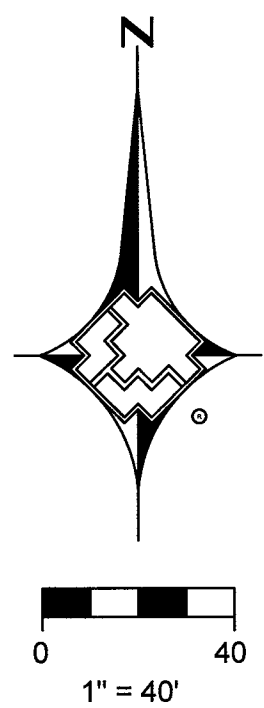


RTC STD DWG 503


MATCHLINE - SEE SHEET 10
FOR CONTINUATION

MATCHLINE - SEE SHEET 4
FOR CONTINUATION

MATCHLINE - SEE SHEET 5
FOR CONTINUATION

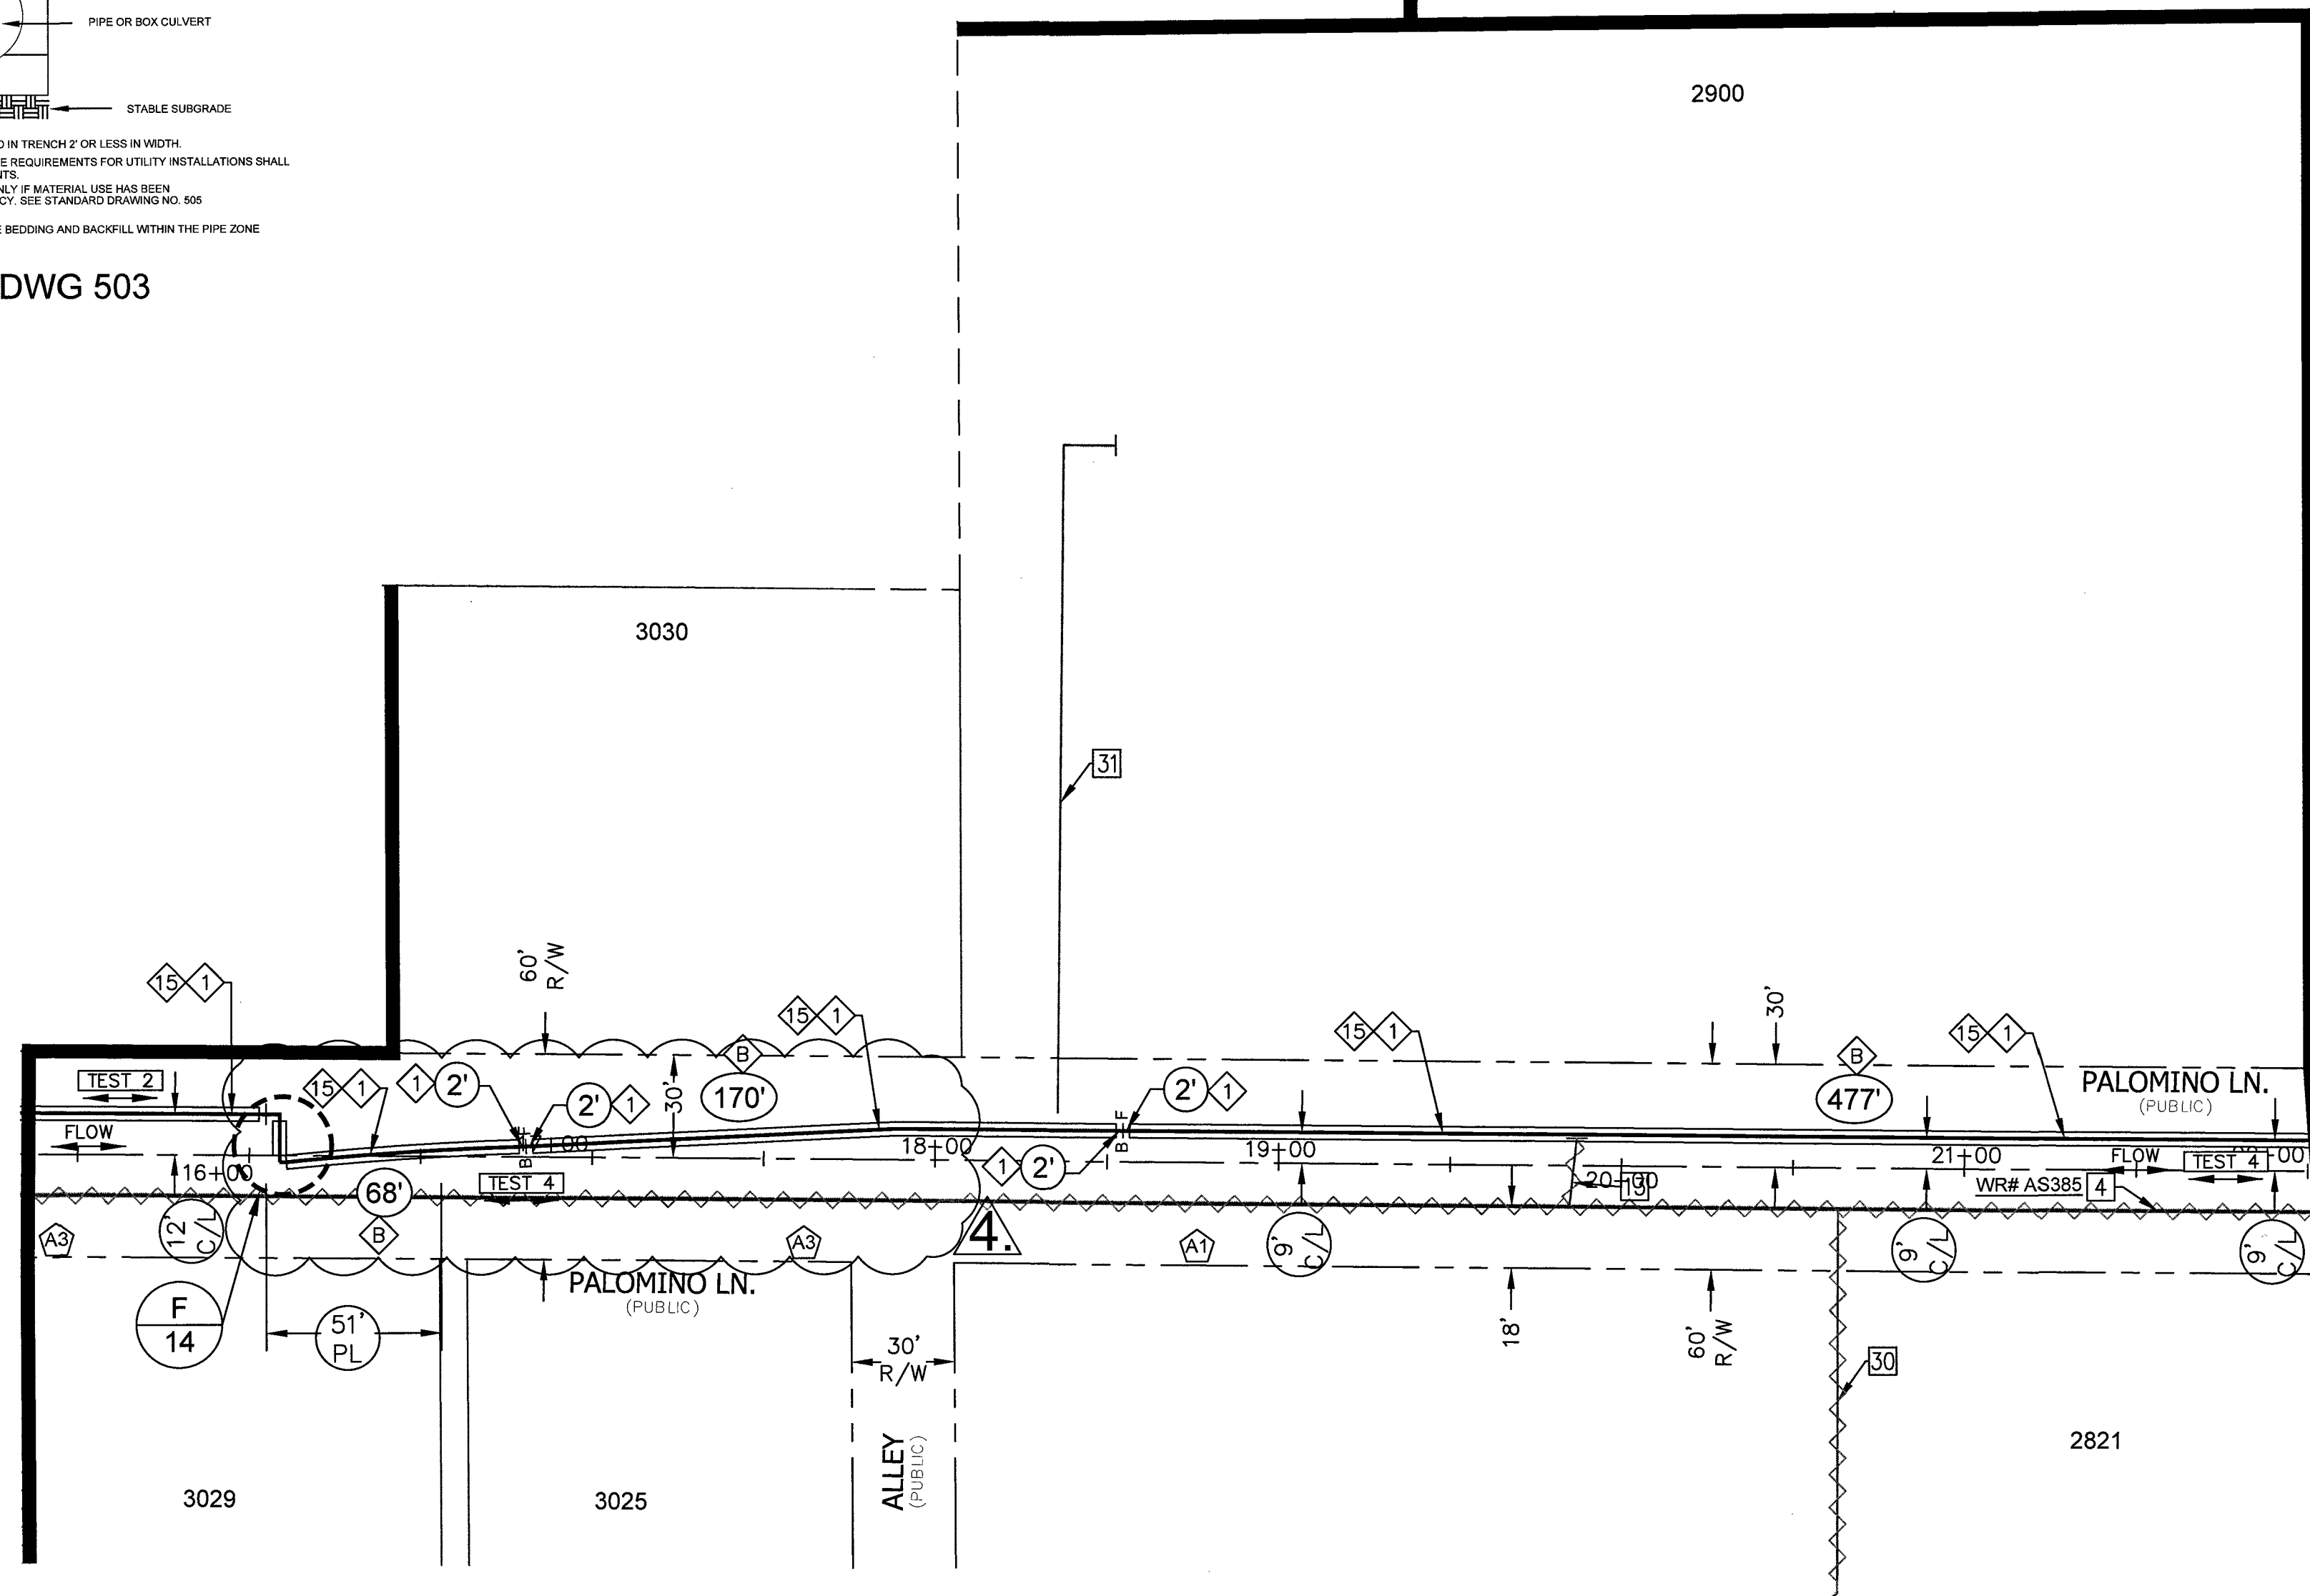


MATCHLINE - SEE SHEET 8
FOR CONTINUATION

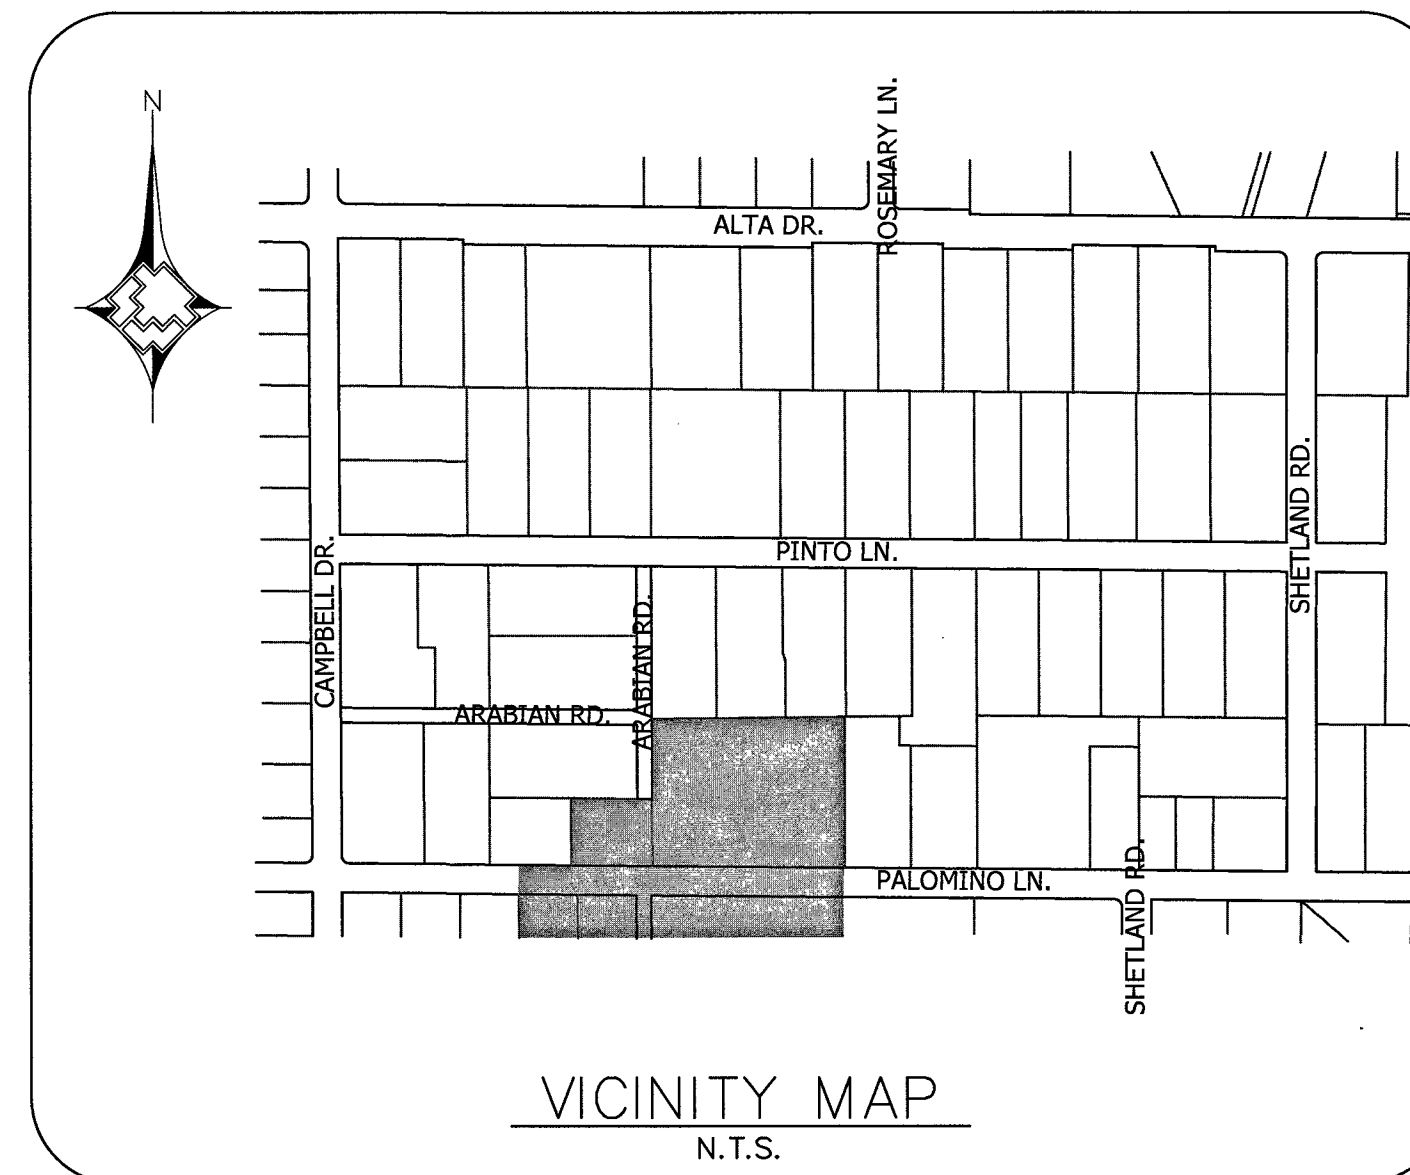

VICINITY MAP
N.T.S.

LEGEND:

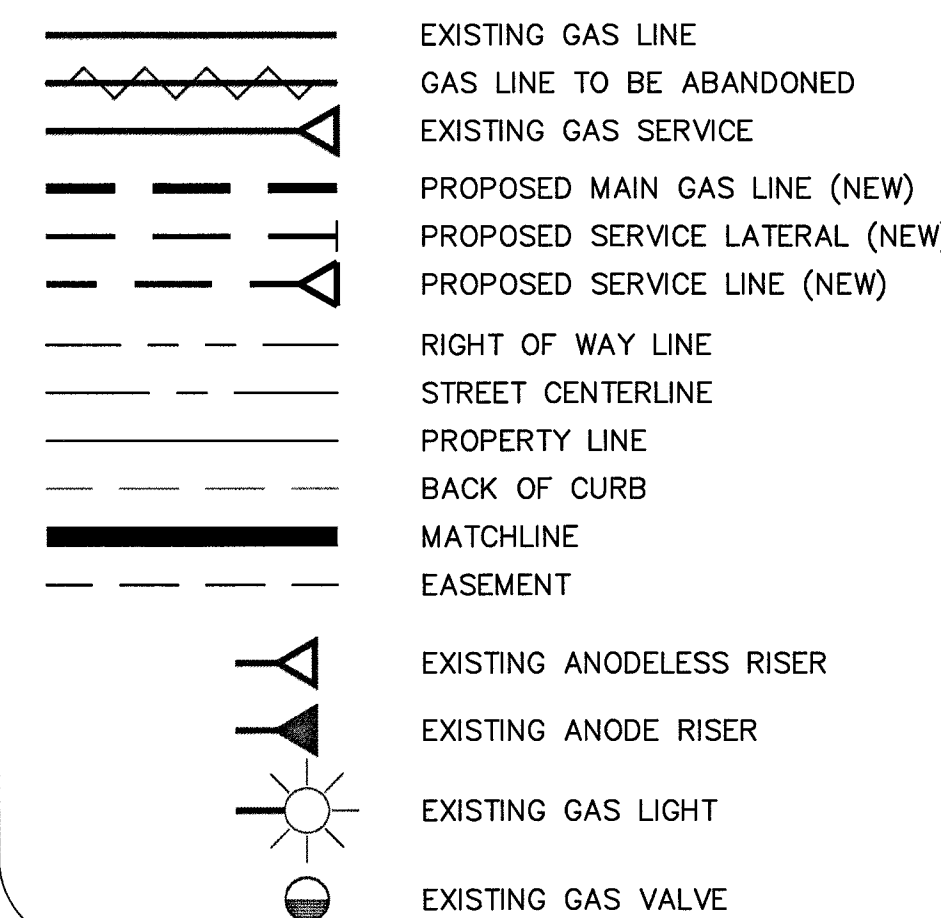

NEW FACILITIES:

- 1 NEW 2" PE MAIN - 723'
- 15 NEW 3" PE SLEEVING (100-8075) - 715'
- B BORE
- B-F BUTT FUSION

RTC NOTES:

- STANDARD(S):
- PAVEMENT REPAIR SHALL CONFORM TO RTC
- A1 500.4
- A3 503



4. AS-BUILT SUBMITTAL FOR FINAL CLOSE	SWG 8/9/17	PK 15 M					AS-BUILT DRAWING-PRESSURE TEST DATA				VISUAL INSPECTION CERTIFICATION				CONSTRUCTION				ISOLATION AREA		W.R. NO.		ENGINEER/TECH: ARIANA ALANIZ				PHONE: 702-365-2027			
											I HAVE VISUALLY INSPECTED ALL HEATED FUSIONS, SOLVENT CEMENT, MECHANICAL JOINTS, AND WELDS THAT I HAVE PERFORMED				INSPECTOR				095		3021514		ACCOUNT REP:				PHONE:			
															FOREMAN								PROJECT CONTACT: ARIANA ALANIZ				PHONE: 702-365-2027			
															REVIEWED BY				SEE SHEET 2				SHEET NO: 9 OF 15				SCALE: 1" = 40'		DATE: 01/07/16	
																							DWN. BY: ZONE ENG.				CHKD. BY:		APPVD. BY:	
																							TITLE							
																							GIR-CLV-PINTO & SHETLAND -							
																							STEEL REPLACEMENT							



NO.		DESCRIPTION		BY	DATE	APPVD
REVISIONS						
SOUTHWEST GAS CORPORATION						
TAX CODES	UNIT NO.	UNIT TYPE	INSTL. PROPOSED	RETIRED	INSTL. COMPLETED	RETIRED
PROPERTY UNITS						

TEST MEDIUM	TEST METHOD	
PIPE DIA.	AIR	GAUGE
PIPE LENGTH	NITROGEN	CHART
PIPE TYPE	WATER	GAUGE/ PRESS REC SNR
MIN. DURATION	SOAP	
TEST PRES. (PSIG)	START	END
TIME		
DATE		
PERFORMED BY		

AS-BUILTS ACCEPTED BY	DATE
POSTED BY	DATE
POSTING QC'D BY	DATE


PERMIT INFORMATION	
CITY OF LAS VEGAS, NV	
TAX CODE 02-0200	

LOCATION	ATLAS #/TITLE #
T20S R61E SEC 32 M.D.M.	x618y514

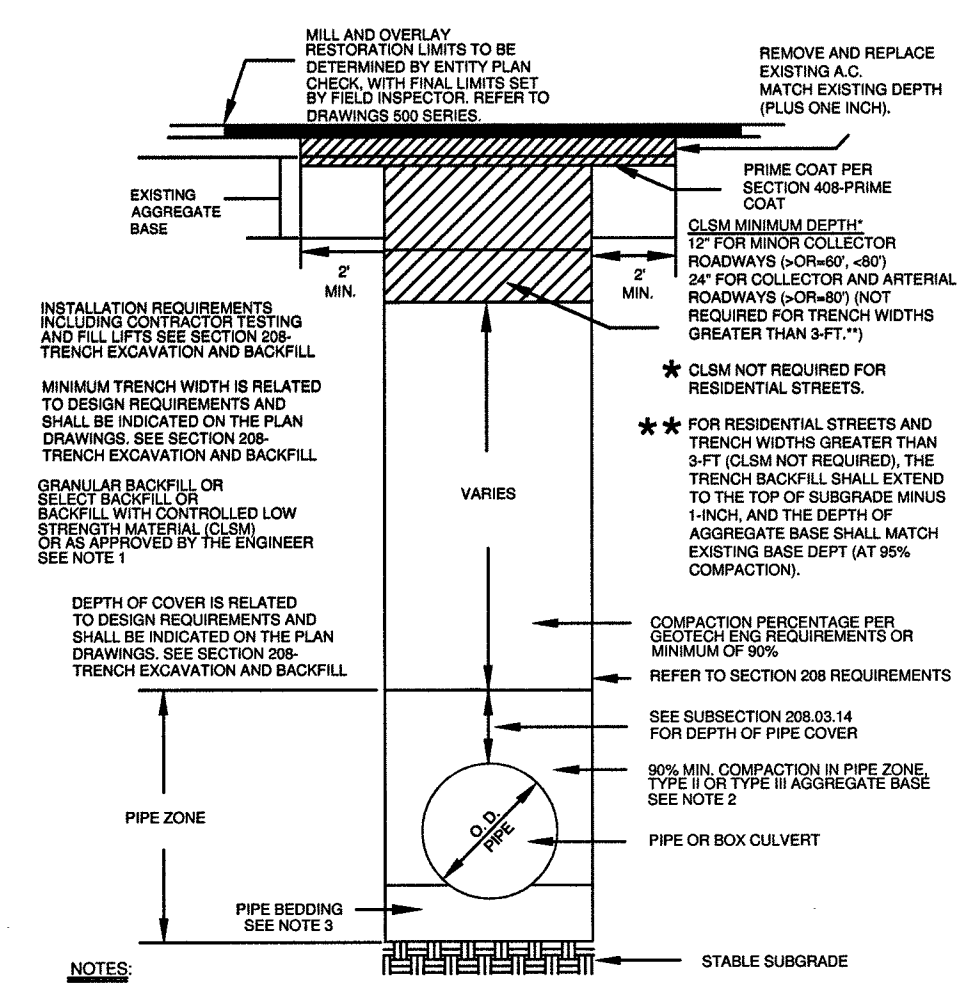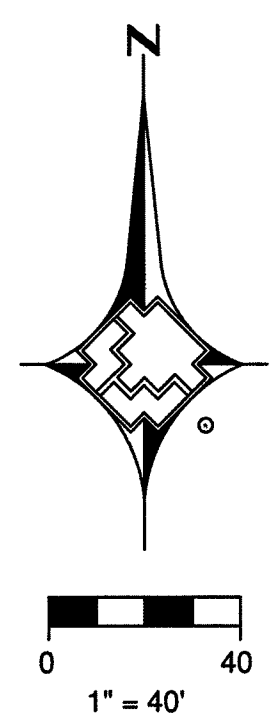


- NOTES:
- NO STONES OR LUMPS GREATER THAN 3" PERMITTED IN TRENCH 2" OR LESS IN WIDTH.
 - TRENCH WIDTH, BROW, SURROUND AND PIPE ZONE REQUIREMENTS FOR UTILITY INSTALLATIONS SHALL CONFORM TO THE RESPECTIVE CITY REQUIREMENTS.
 - GRAVELLY ROCK MAY BE USED FOR PIPE BEDDING ONLY IF MATERIAL USE HAS BEEN SPECIFICALLY APPROVED BY THE GOVERNING AGENCY. SEE STANDARD DRAWING NO. 505 FOR PIPE BEDDING METHODS.
 - LAS VEGAS VALLEY WATER DISTRICT REQUIRES PIPE BEDDING AND BACKFILL WITHIN THE PIPE ZONE TO BE OF THE SAME MATERIAL.

RTC STD DWG 503

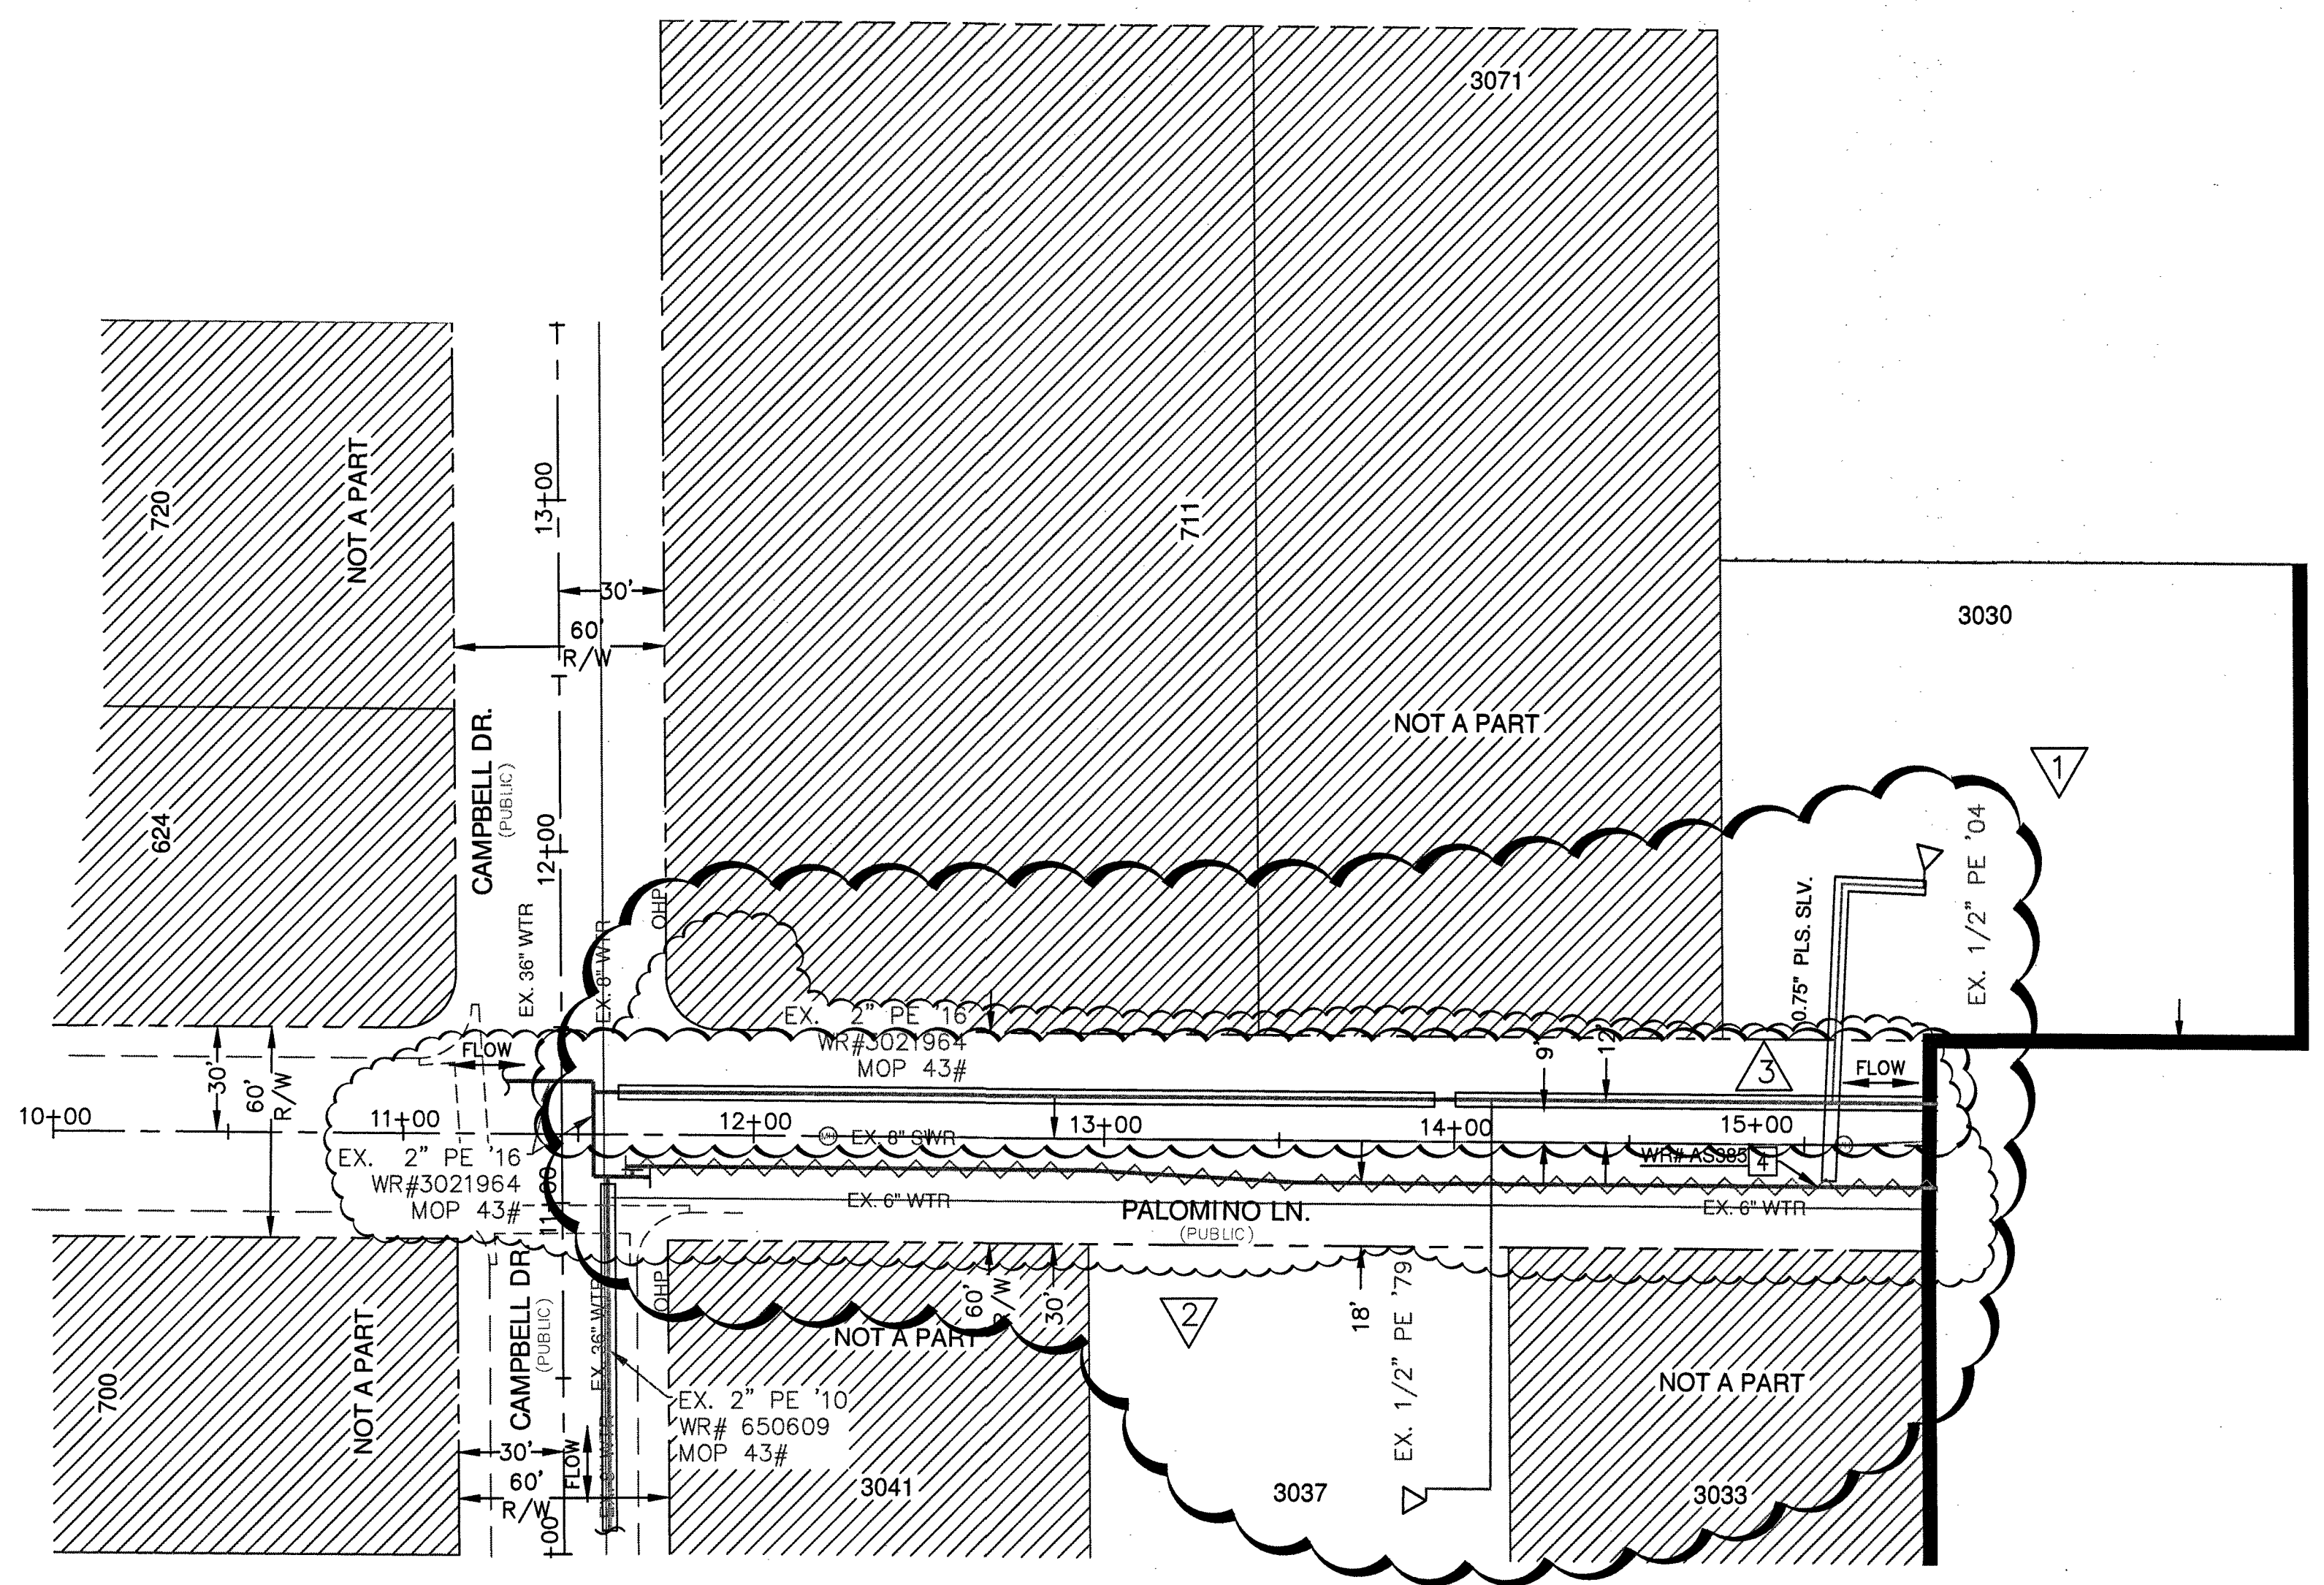

MATCHLINE - SEE SHEET 9
FOR CONTINUATION

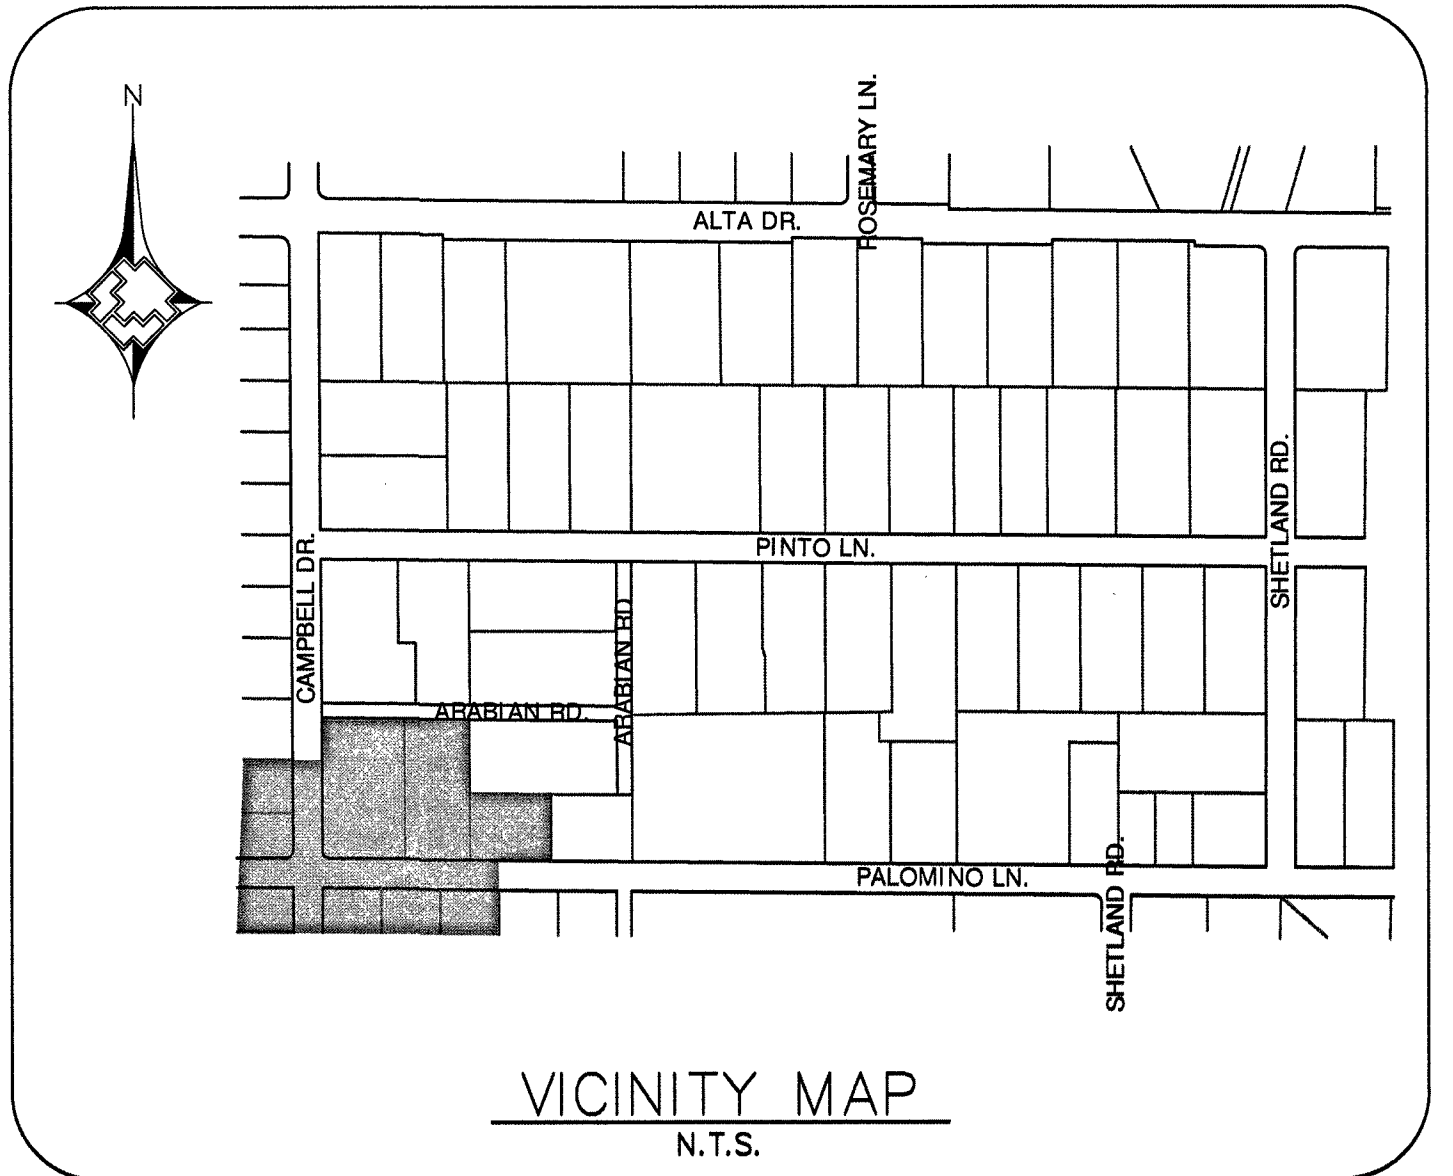

VICINITY MAP
N.T.S.

- LEGEND:
- EXISTING GAS LINE
 - GAS LINE TO BE ABANDONED
 - EXISTING GAS SERVICE
 - PROPOSED MAIN GAS LINE (NEW)
 - PROPOSED SERVICE LATERAL (NEW)
 - PROPOSED SERVICE LINE (NEW)
 - RIGHT OF WAY LINE
 - STREET CENTERLINE
 - PROPERTY LINE
 - BACK OF CURB
 - MATCHLINE
 - EASEMENT
 - EXISTING ANODELESS RISER
 - EXISTING ANODE RISER
 - EXISTING GAS LIGHT
 - EXISTING GAS VALVE

PROPOSED FACILITIES:

- 1 PROP. 2" PE MAIN

ABANDONED FACILITIES:

- 4 ABANDON EX. 2" STL '55 MOP 43#
30 ABANDON EX. 2" PE '16 MOP 43#

RTC NOTES:

PAVEMENT REPAIR SHALL CONFORM TO RTC STANDARD(S):

- A1 500.4
A2 500.5
A3 503



✓	REVISED PROP ALIGNMENT & UPDATE QTYS	AA	5/4/16	
	REV. 1 DECLINED BY THE CITY			
	NEW 2" PE '16 WILL BE ABANDONED IN PLACE			
✓	REVISED LOCATION BASED ON REV. DOCUMENTS	AA	12/18/2016	
✓	REVISED TIE-IN SHEET 9	DF	02/28/2016	
NO.	DESCRIPTION	BY	DATE	APPVD.
REVISIONS				

**SOUTHWEST GAS CORPORATION**
®



TAX CODES	UNIT NO.	UNIT TYPE	INSTL. PROPOSED	RETIRED	INSTL. COMPLETED	RETIRED
PROPERTY UNITS						



AS-BUILT DRAWING-PRESSURE TEST DATA	
PIPE DIA.	TEST MEDIUM
PIPE LENGTH	TEST METHOD
PIPE TYPE	GAUGE
MIN. DURATION	CHART
TEST PRES. (PSIG)	WATER
TIME	GAUGE/ PRESS REC SW
DATE	
PERFORMED BY	

VISUAL INSPECTION CERTIFICATION	
I HAVE VISUALLY INSPECTED ALL HEATED FUSIONS, SOLVENT CEMENT, MECHANICAL JOINTS, AND WELDS THAT I HAVE PERFORMED	
NAME	DATE
INSPECTOR	
FOREMAN	
REVIEWED BY	
PERMIT INFORMATION	
CITY OF LAS VEGAS, NV	
TAX CODE 02-0200	



CONSTRUCTION	
ISOLATION AREA 095	
W.R. NO. 3021514	
LOCATION T20S R61E SEC 32 M.D.M.	
ATLAS #/TITLE # x618y514	

ENGINEER/TECH: ARIANA ALANIZ		PHONE: 702-365-2027
ACCOUNT REP:		PHONE:
PROJECT CONTACT: ARIANA ALANIZ		PHONE: 702-365-2027
SHEET NO: 10 OF 15	SCALE: 1"=40'	DATE: 01/07/16
DWN. BY: ZONE ENG.	CHKD. BY:	APPVD. BY:

GIR-CLV-PINTO & SHETLAND - STEEL REPLACEMENT	
--	--

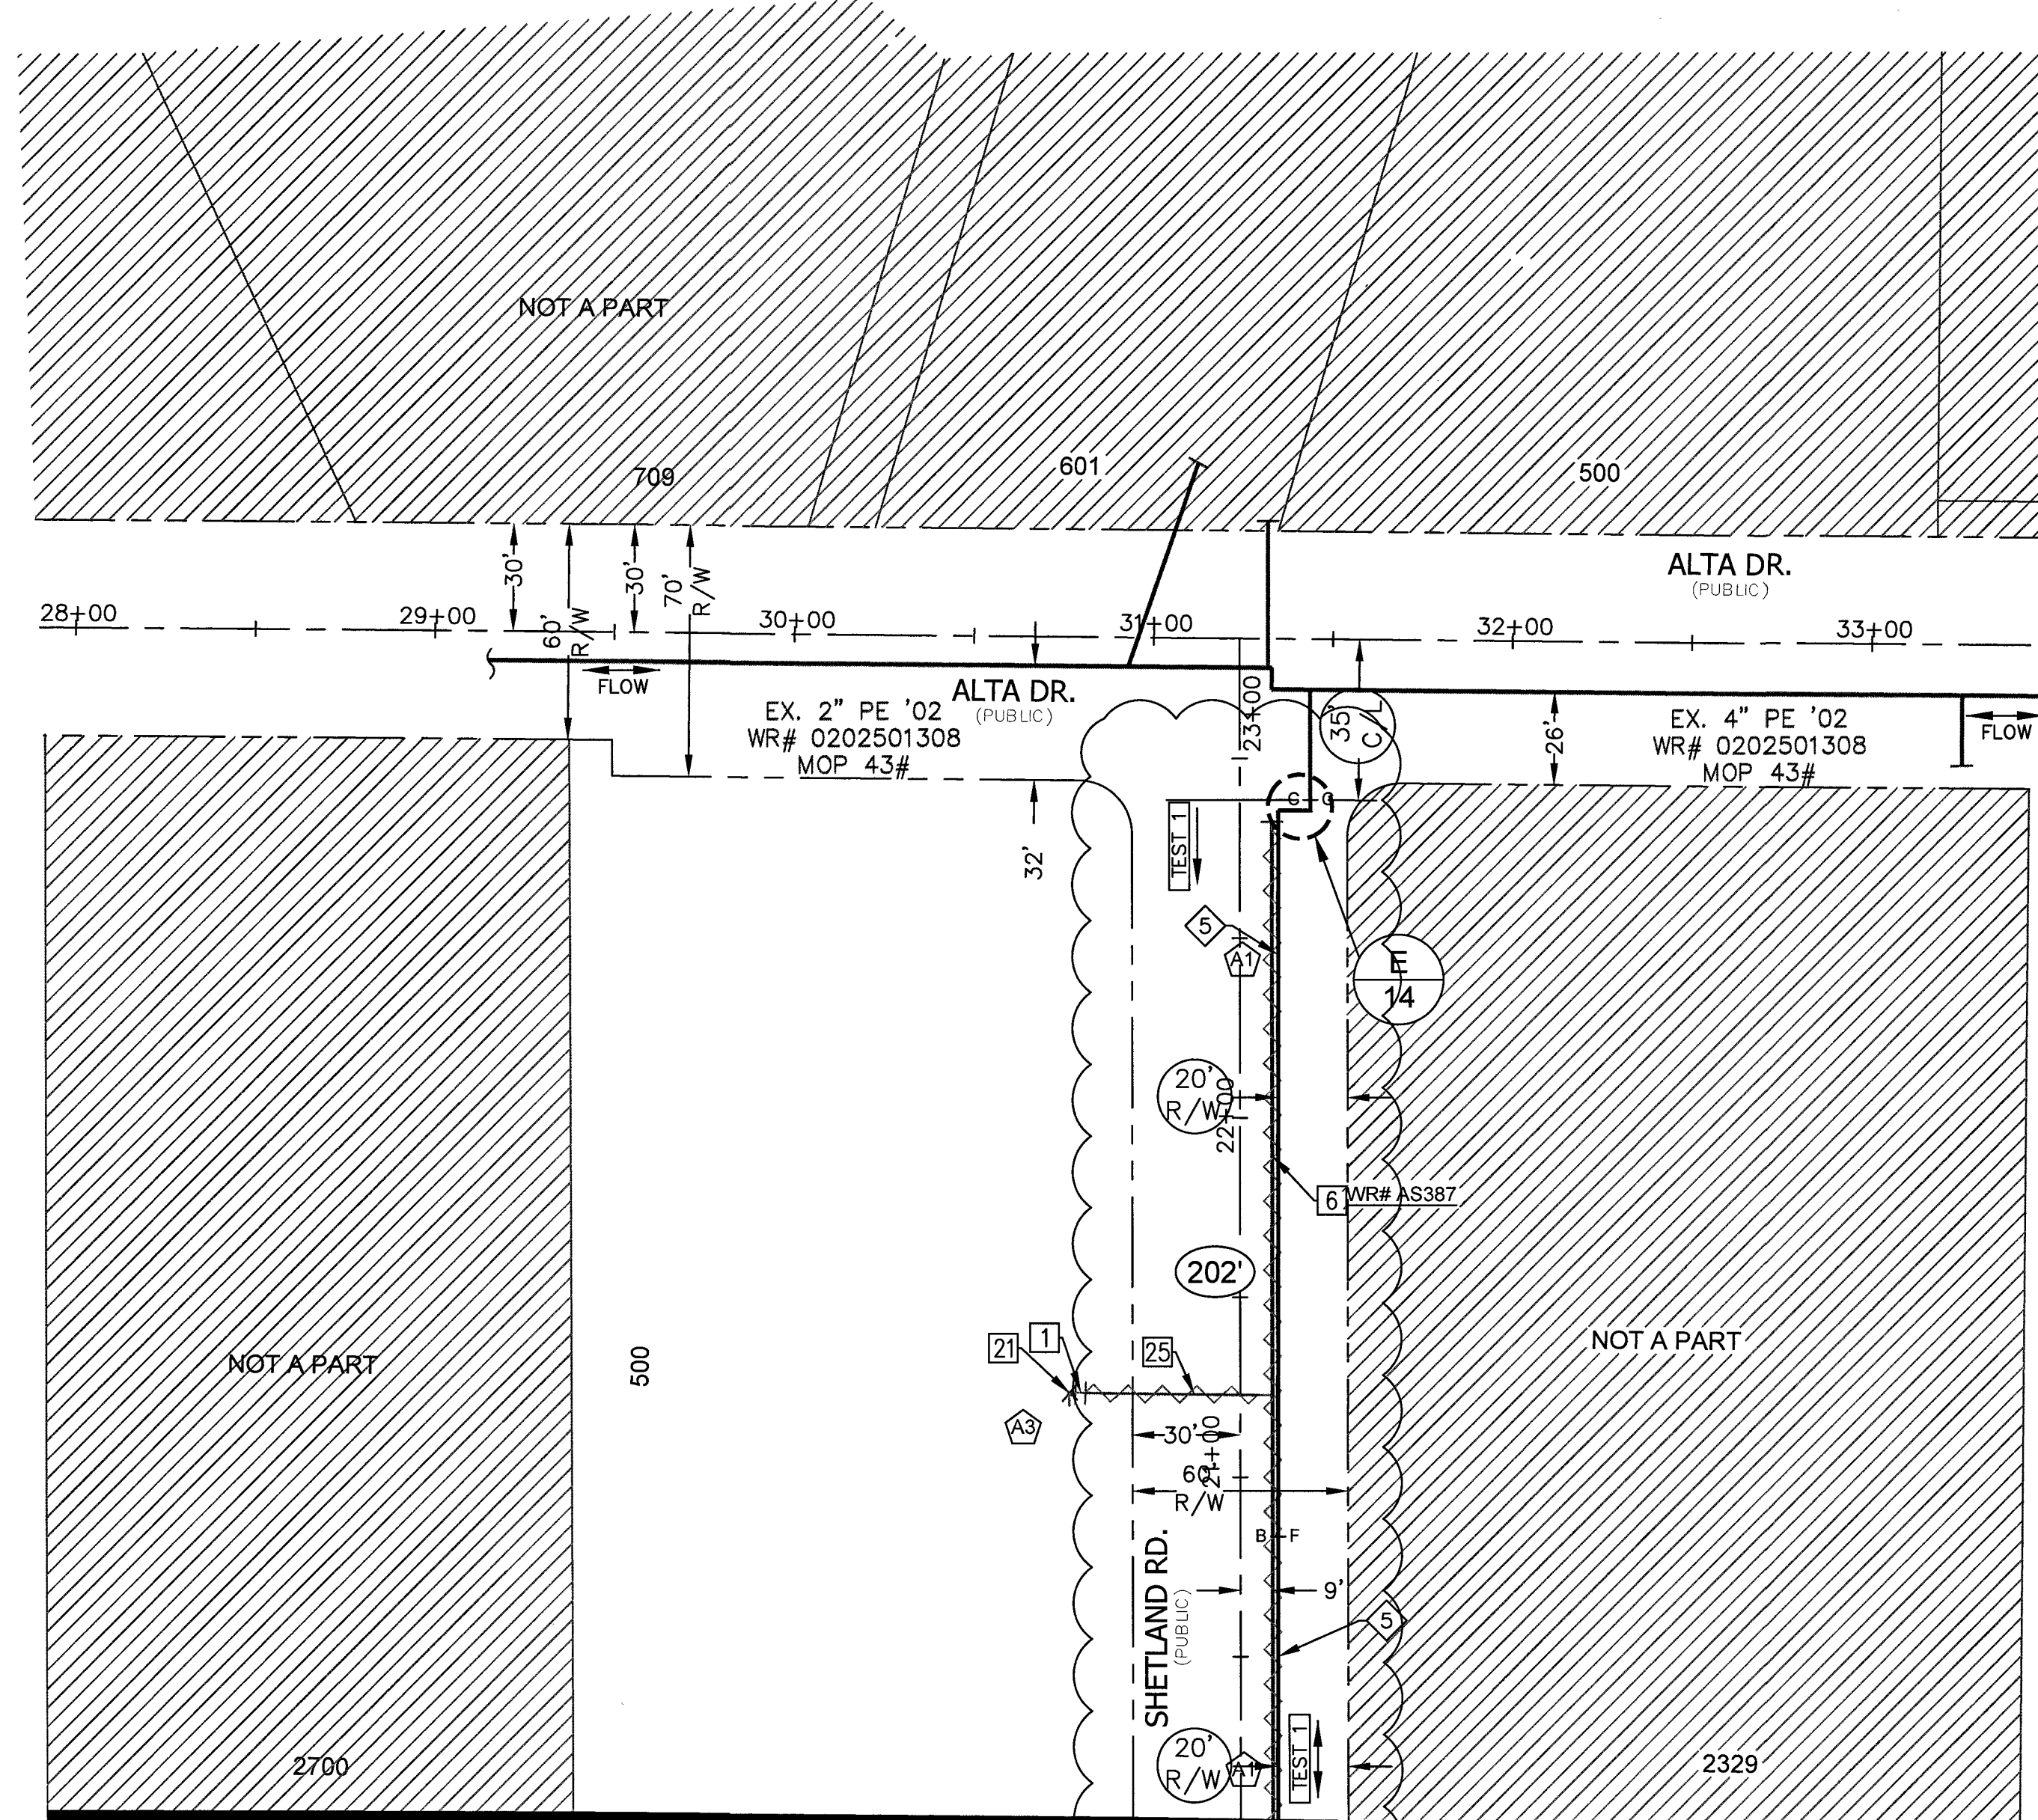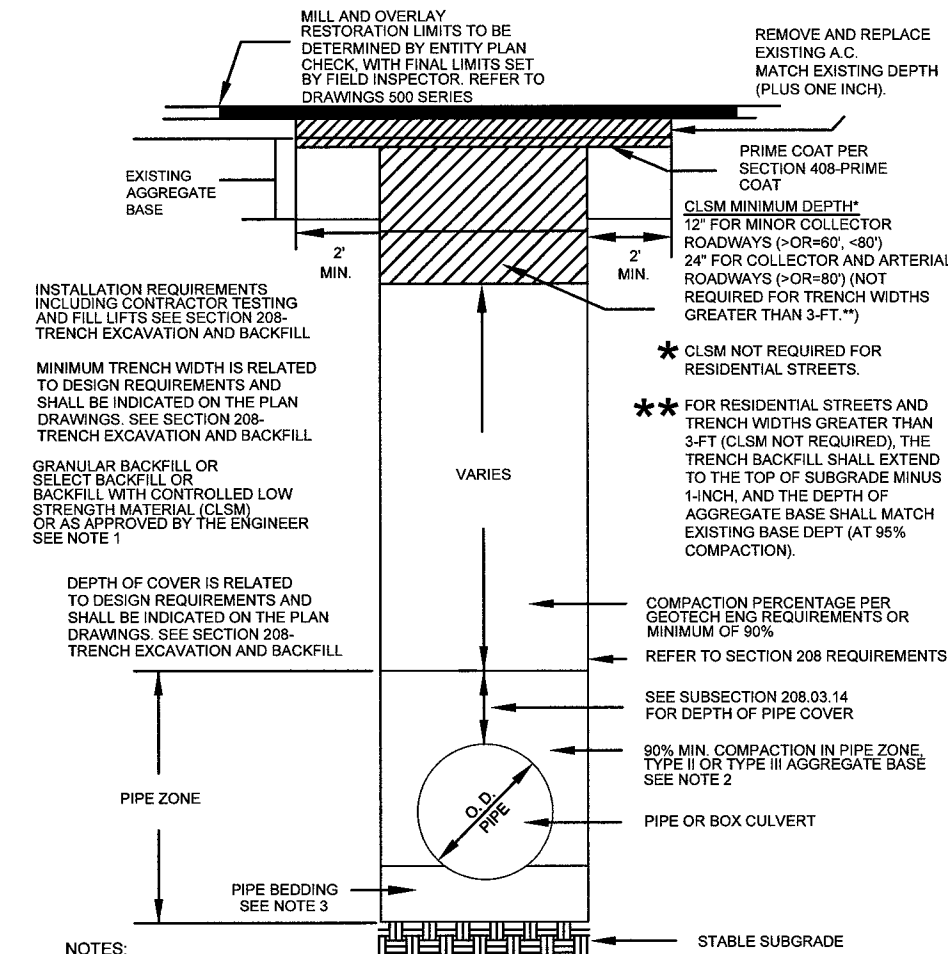

MATCHLINE - SEE SHEET 6 FOR CONTINUATION

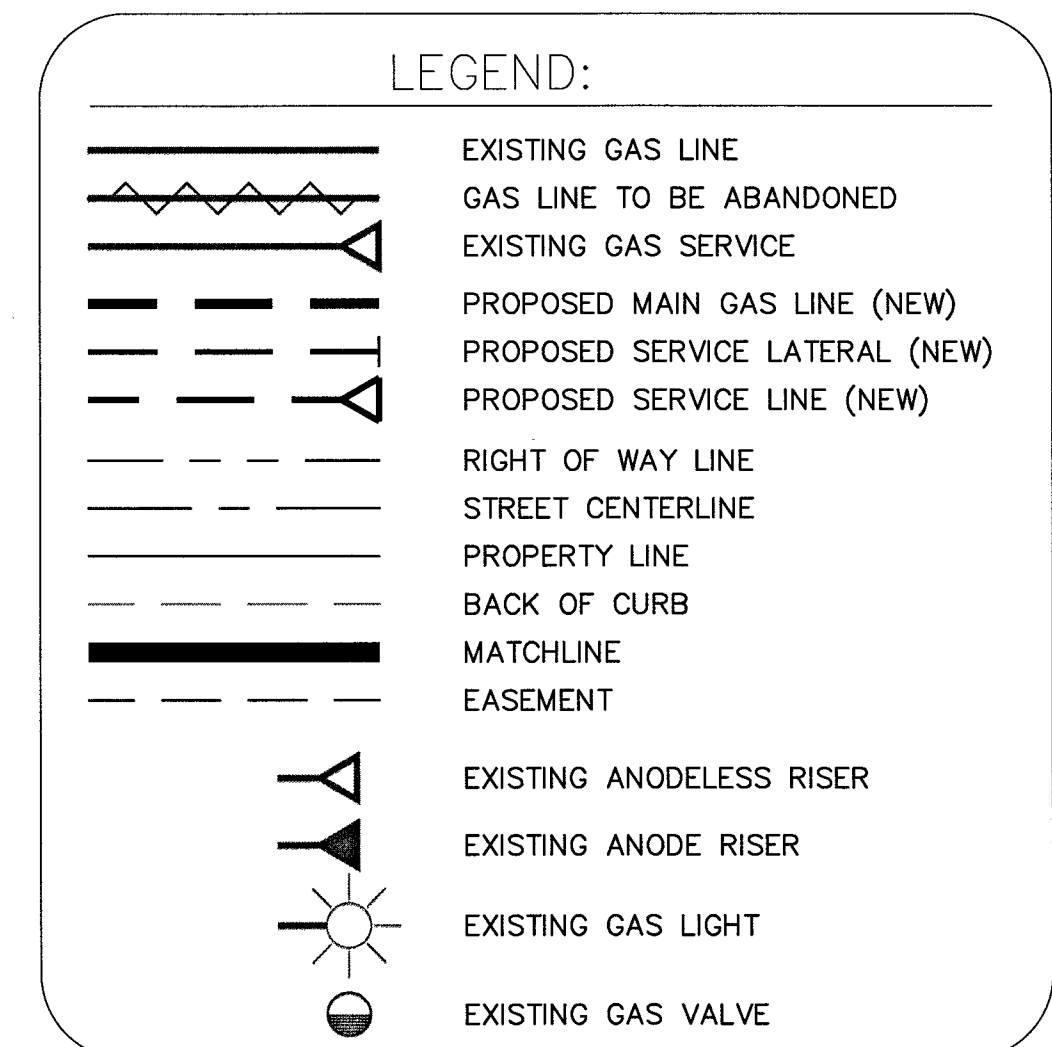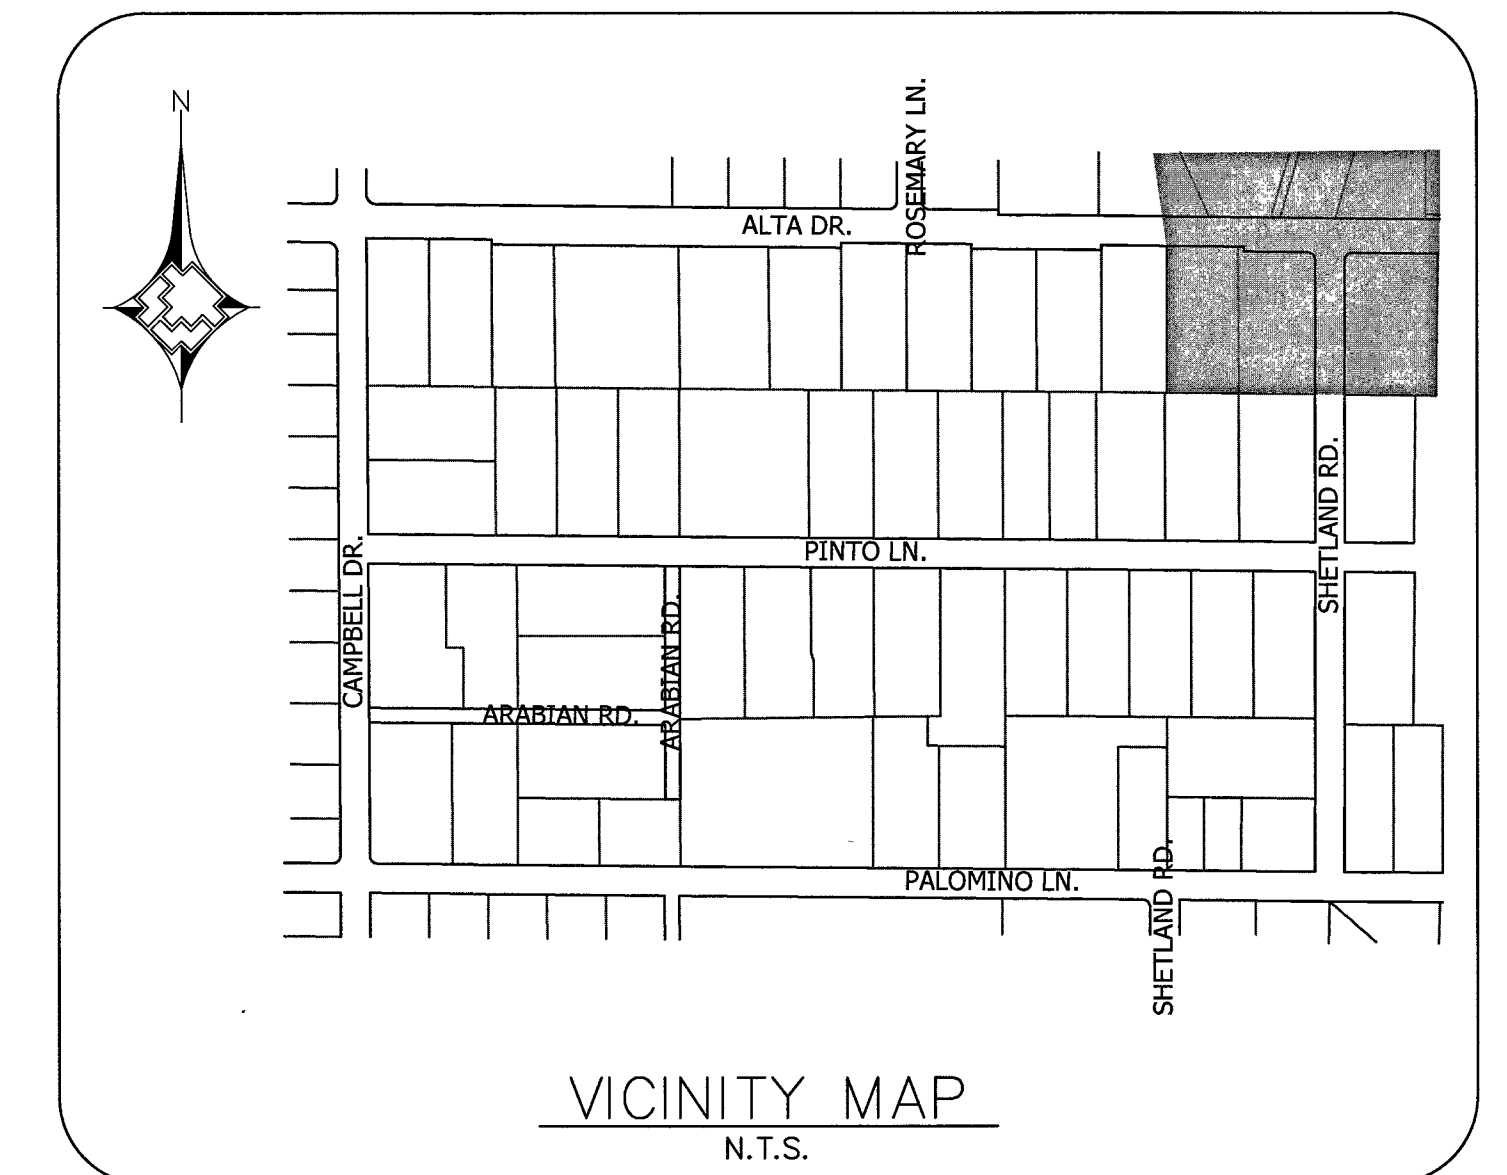

5 NEW 4" PE MAIN - 202'
BUTT FUSION

PAVEMENT REPAIR SHALL CONFORM TO RTC
STANDARD(S):

A3 503



4.	AS-BUILT SUBMITTAL FOR FINAL CLOSE	SWG	8/9/17	☒	
NO.	DESCRIPTION	BY	DATE	APPVD.	
REVISIONS					
TAX CODES	UNIT NO.	UNIT TYPE	INSTL. PROPOSED	RETIRED COMPLETED	
PROPERTY UNITS					

AS-BUILT DRAWING-PRESSURE TEST DATA

PIPE DIA. _____	☐ AIR	☐ GAUGE
PIPE LENGTH _____	☐ NITROGEN	☐ CHART
PIPE TYPE _____	☐ WATER	GAUGE/ PRESS REC SN# _____
MIN. DURATION _____	☐ SOAP	

TEST PRES. (PSIG) _____	START _____
TIME _____	END _____
DATE _____	
PERFORMED BY _____	

VISUAL INSPECTION CERTIFICATION

I HAVE VISUALLY INSPECTED ALL HEATED FUSIONS, SOLVENT CEMENT, MECHANICAL JOINTS, AND WELDS THAT I HAVE PERFORMED

NAME _____	DATE _____
INSPECTOR _____	
FOREMAN _____	
REVIEWED BY _____	

AS-BUILTS ACCEPTED BY _____	DATE _____
POSTED BY _____	DATE _____
POSTING QC'D BY _____	DATE _____

CONSTRUCTION

CITY OF LAS VEGAS, NV

TAX CODE 02-0200

ISOLATION AREA

095

W.R. NO.

3021514

LOCATION

T20S
R61E
SEC 32
M.D.M.

ATLAS #/TILE #

x618y514

ENGINEER/TECH: ARIANA ALANIZ


ACCOUNT REP: _____

PROJECT CONTACT: ARIANA ALANIZ


SHEET NO: 11 OF 15 SCALE: 1" = 40' DATE: 01/07/16

DWN. BY: ZONE ENG. CHKD. BY: _____ APPVD. BY: _____

GIR-CLV-PINTO & SHETLAND - STEEL REPLACEMENT

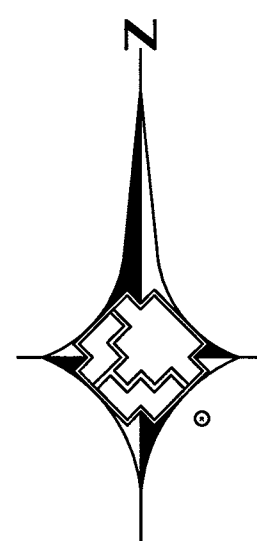

0 1" = 40' 40

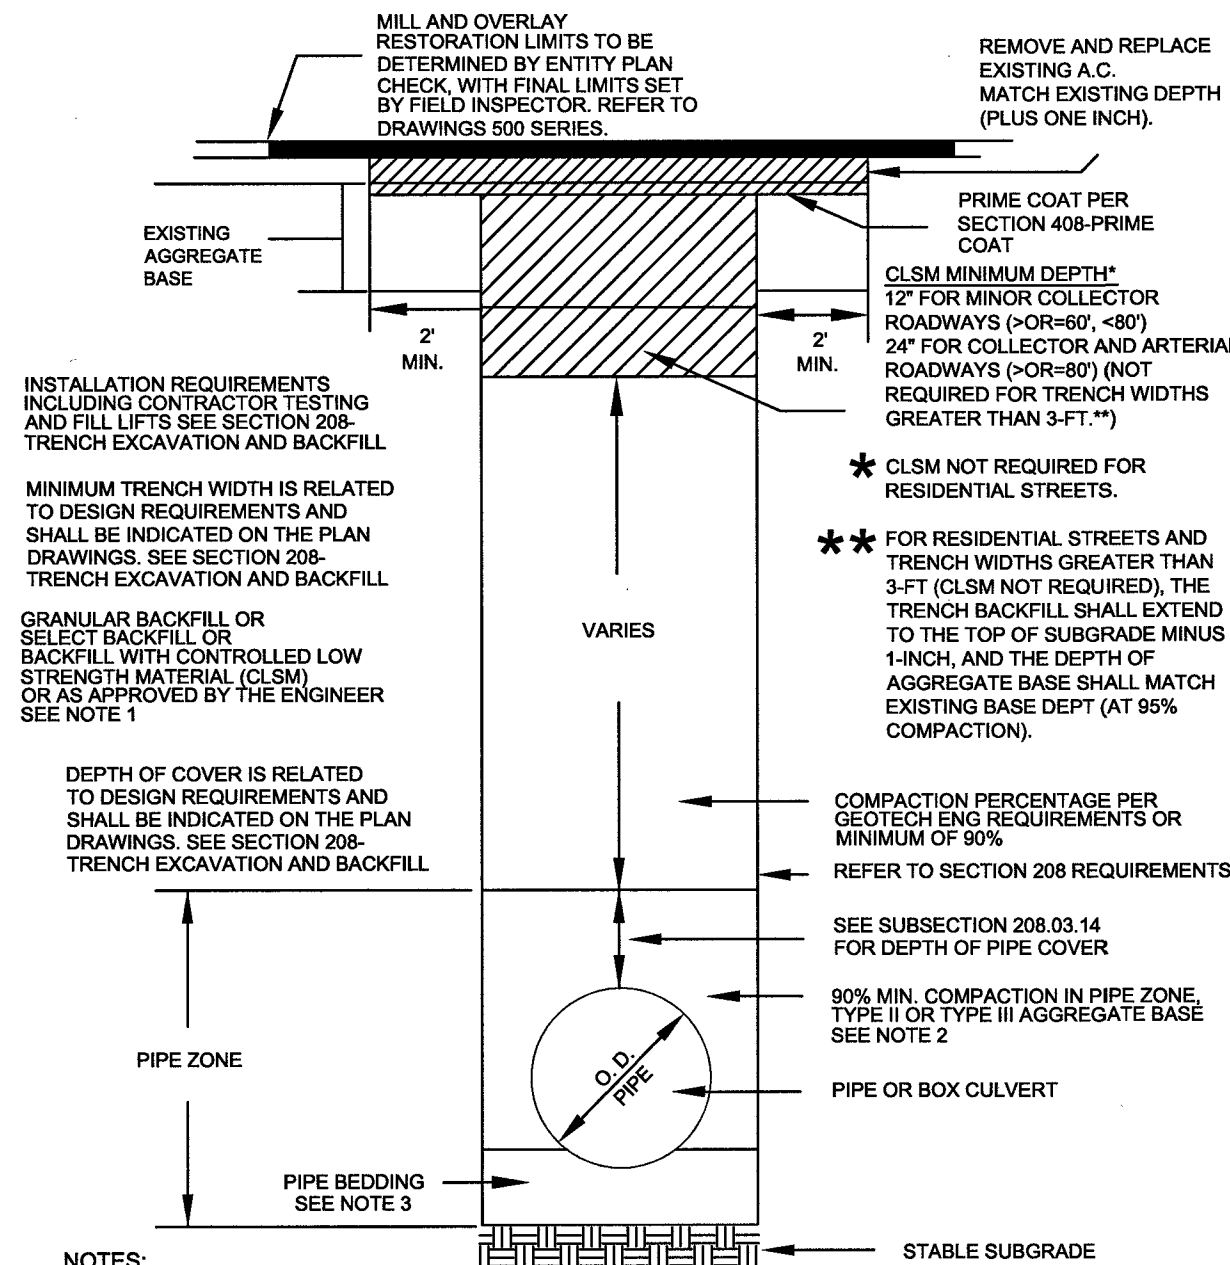


- NOTES:
1. NO STONES OR LUMPS GREATER THAN 3" PERMITTED IN TRENCH 2' OR LESS IN WIDTH.
 2. TRENCH WIDTH, BEDDING, SUBGRADE AND PIPE ZONE REQUIREMENTS FOR UTILITY INSTALLATIONS SHALL CONFORM TO THE RESPECTIVE ENTITY REQUIREMENTS.
 3. CRUSHED ROCK MAY BE USED FOR PIPE BEDDING ONLY IF MATERIAL USE HAS BEEN SPECIFICALLY APPROVED BY THE GOVERNING AGENCY. SEE STANDARD DRAWING NO. 505 FOR PIPE BEDDING METHODS.
 4. LAS VEGAS VALLEY WATER DISTRICT REQUIRES PIPE BEDDING AND BACKFILL WITHIN THE PIPE ZONE TO BE OF THE SAME MATERIAL.


RTC STD DWG 503



Know what's below.
Call before you dig.

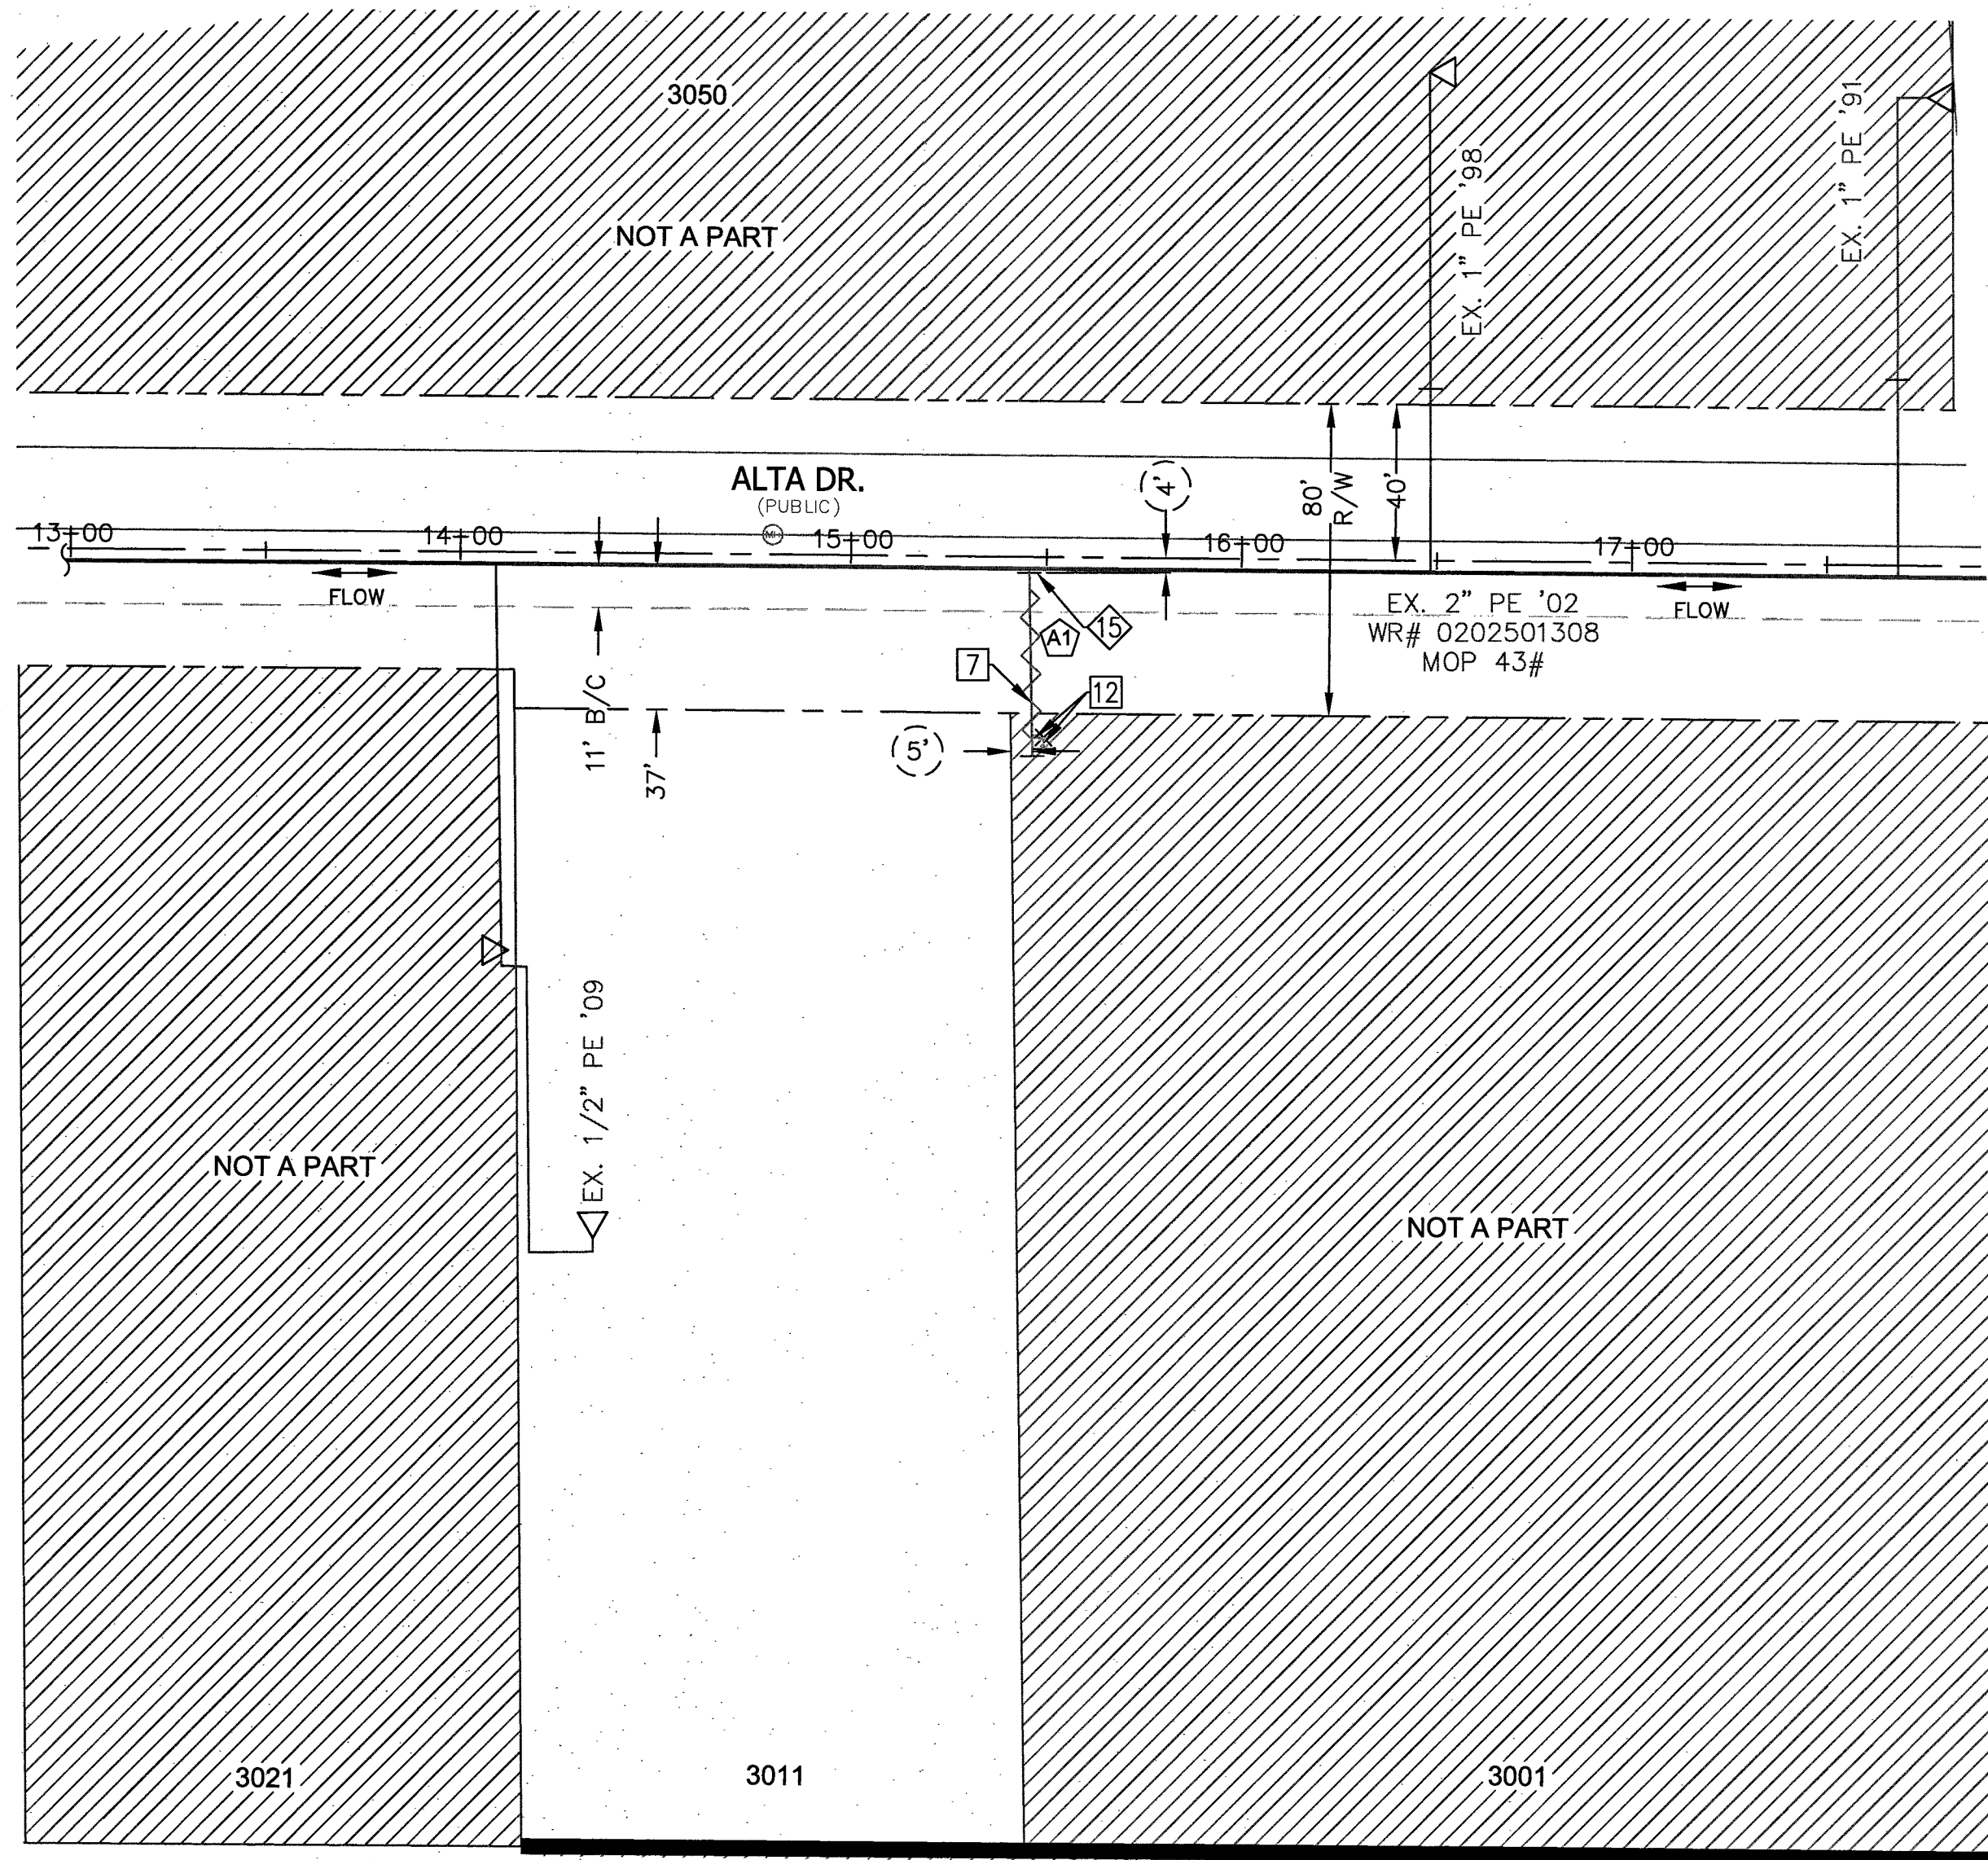


MATCHLINE - SEE SHEET 4
FOR CONTINUATION

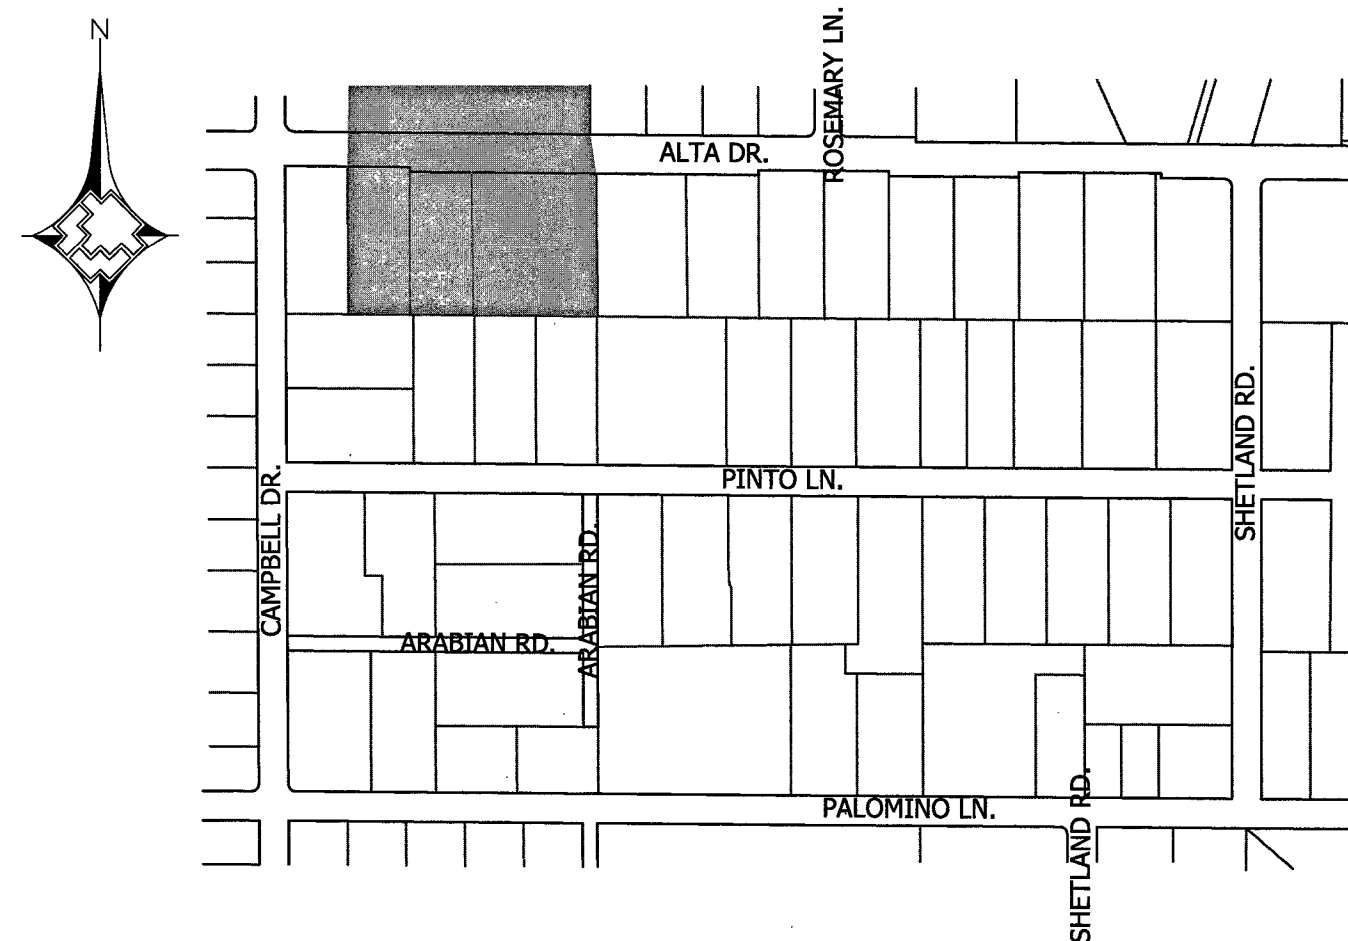

VICINITY MAP
N.T.S.

LEGEND:

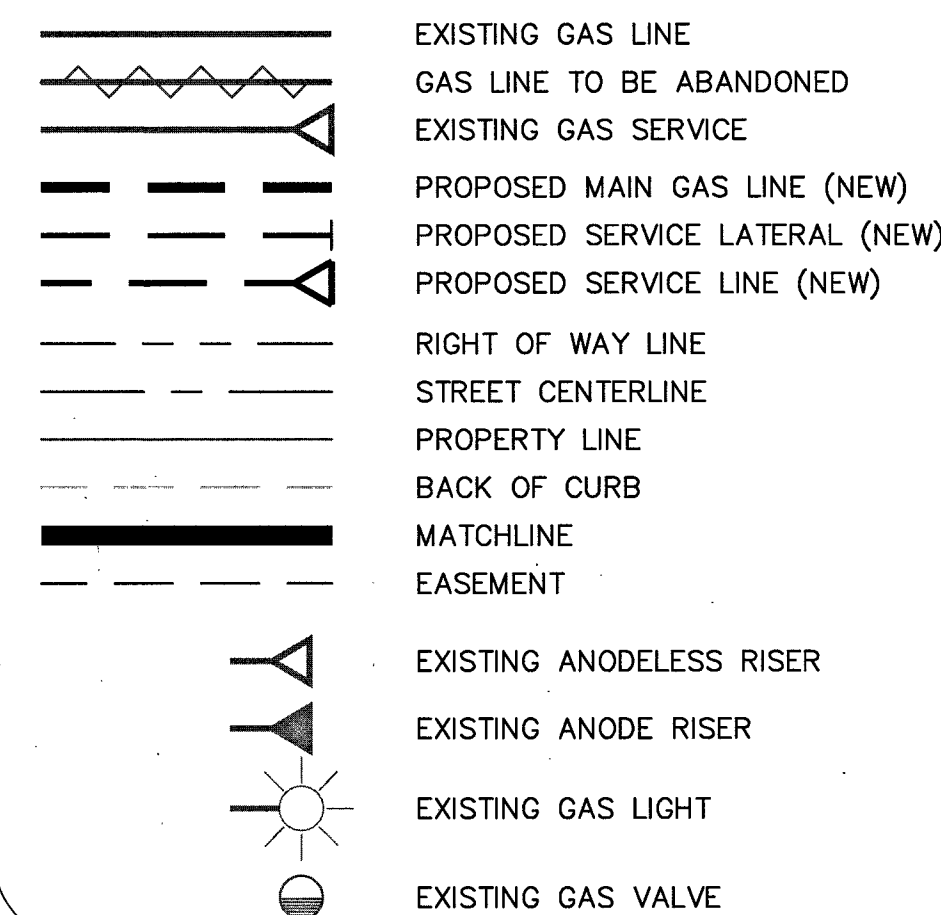

PROPOSED FACILITIES:

- 15 PROP. 1/2" PE CAP (850-9446)

ABANDONED FACILITIES:

- 7 ABANDON EX. 1/2" PE '02 SVC
- 12 ABANDON EX. 1/2" PVC '68 SVC

RTC NOTES:

PAVEMENT REPAIR SHALL CONFORM TO RTC STANDARD(S):

- A1 500.4

NO.	DESCRIPTION	BY	DATE	APPVD.
1.				
2.				
3.				
4.				

REVISIONS



SOUTHWEST GAS CORPORATION

TAX CODES	UNIT NO.	UNIT TYPE	INSTL.	RETIRED	INSTL.	RETIRED
			PROPOSED	COMPLETED		

SEE SHEET 2

AS-BUILT DRAWING-PRESSURE TEST DATA

PIPE DIA.	TEST MEDIUM	TEST METHOD
PIPE LENGTH	☐ AIR ☐ NITROGEN ☐ WATER	☐ GAUGE ☐ CHART
PIPE TYPE	☐ SOAP	☐ GAUGE/ PRESS REC SN#
MIN. DURATION	START	END
TEST PRES. (PSIG)		
TIME		
DATE		
PERFORMED BY		

VISUAL INSPECTION CERTIFICATION

I HAVE VISUALLY INSPECTED ALL HEATED FUSIONS, SOLVENT CEMENT, MECHANICAL JOINTS, AND WELDS THAT I HAVE PERFORMED	
NAME	DATE
INSPECTOR	
FOREMAN	
REVIEWED BY	
AS-BUILTS ACCEPTED BY	DATE
POSTED BY	DATE
POSTING QC'D BY	DATE

CONSTRUCTION

INSPECTOR

FOREMAN

REVIEWED BY




PERMIT INFORMATION

CITY OF LAS VEGAS, NV

TAX CODE 02-0200

ISOLATION AREA	W.R. NO.
095	3021514
LOCATION	ATLAS #/TILE #
T20S R61E SEC 32 M.D.M.	x618y514


ENGINEER/TECH: ARIANA ALANIZ	PHONE: 702-365-2027
ACCOUNT REP:	PHONE:
PROJECT CONTACT: ARIANA ALANIZ	PHONE: 702-365-2027
SHEET NO: 12 OF 15	SCALE: 1" = 40'
DWN. BY: ZONE ENG.	CHKD. BY:
APPVD. BY:	
TITLE	
GIR-CLV-PINTO & SHETLAND - STEEL REPLACEMENT	

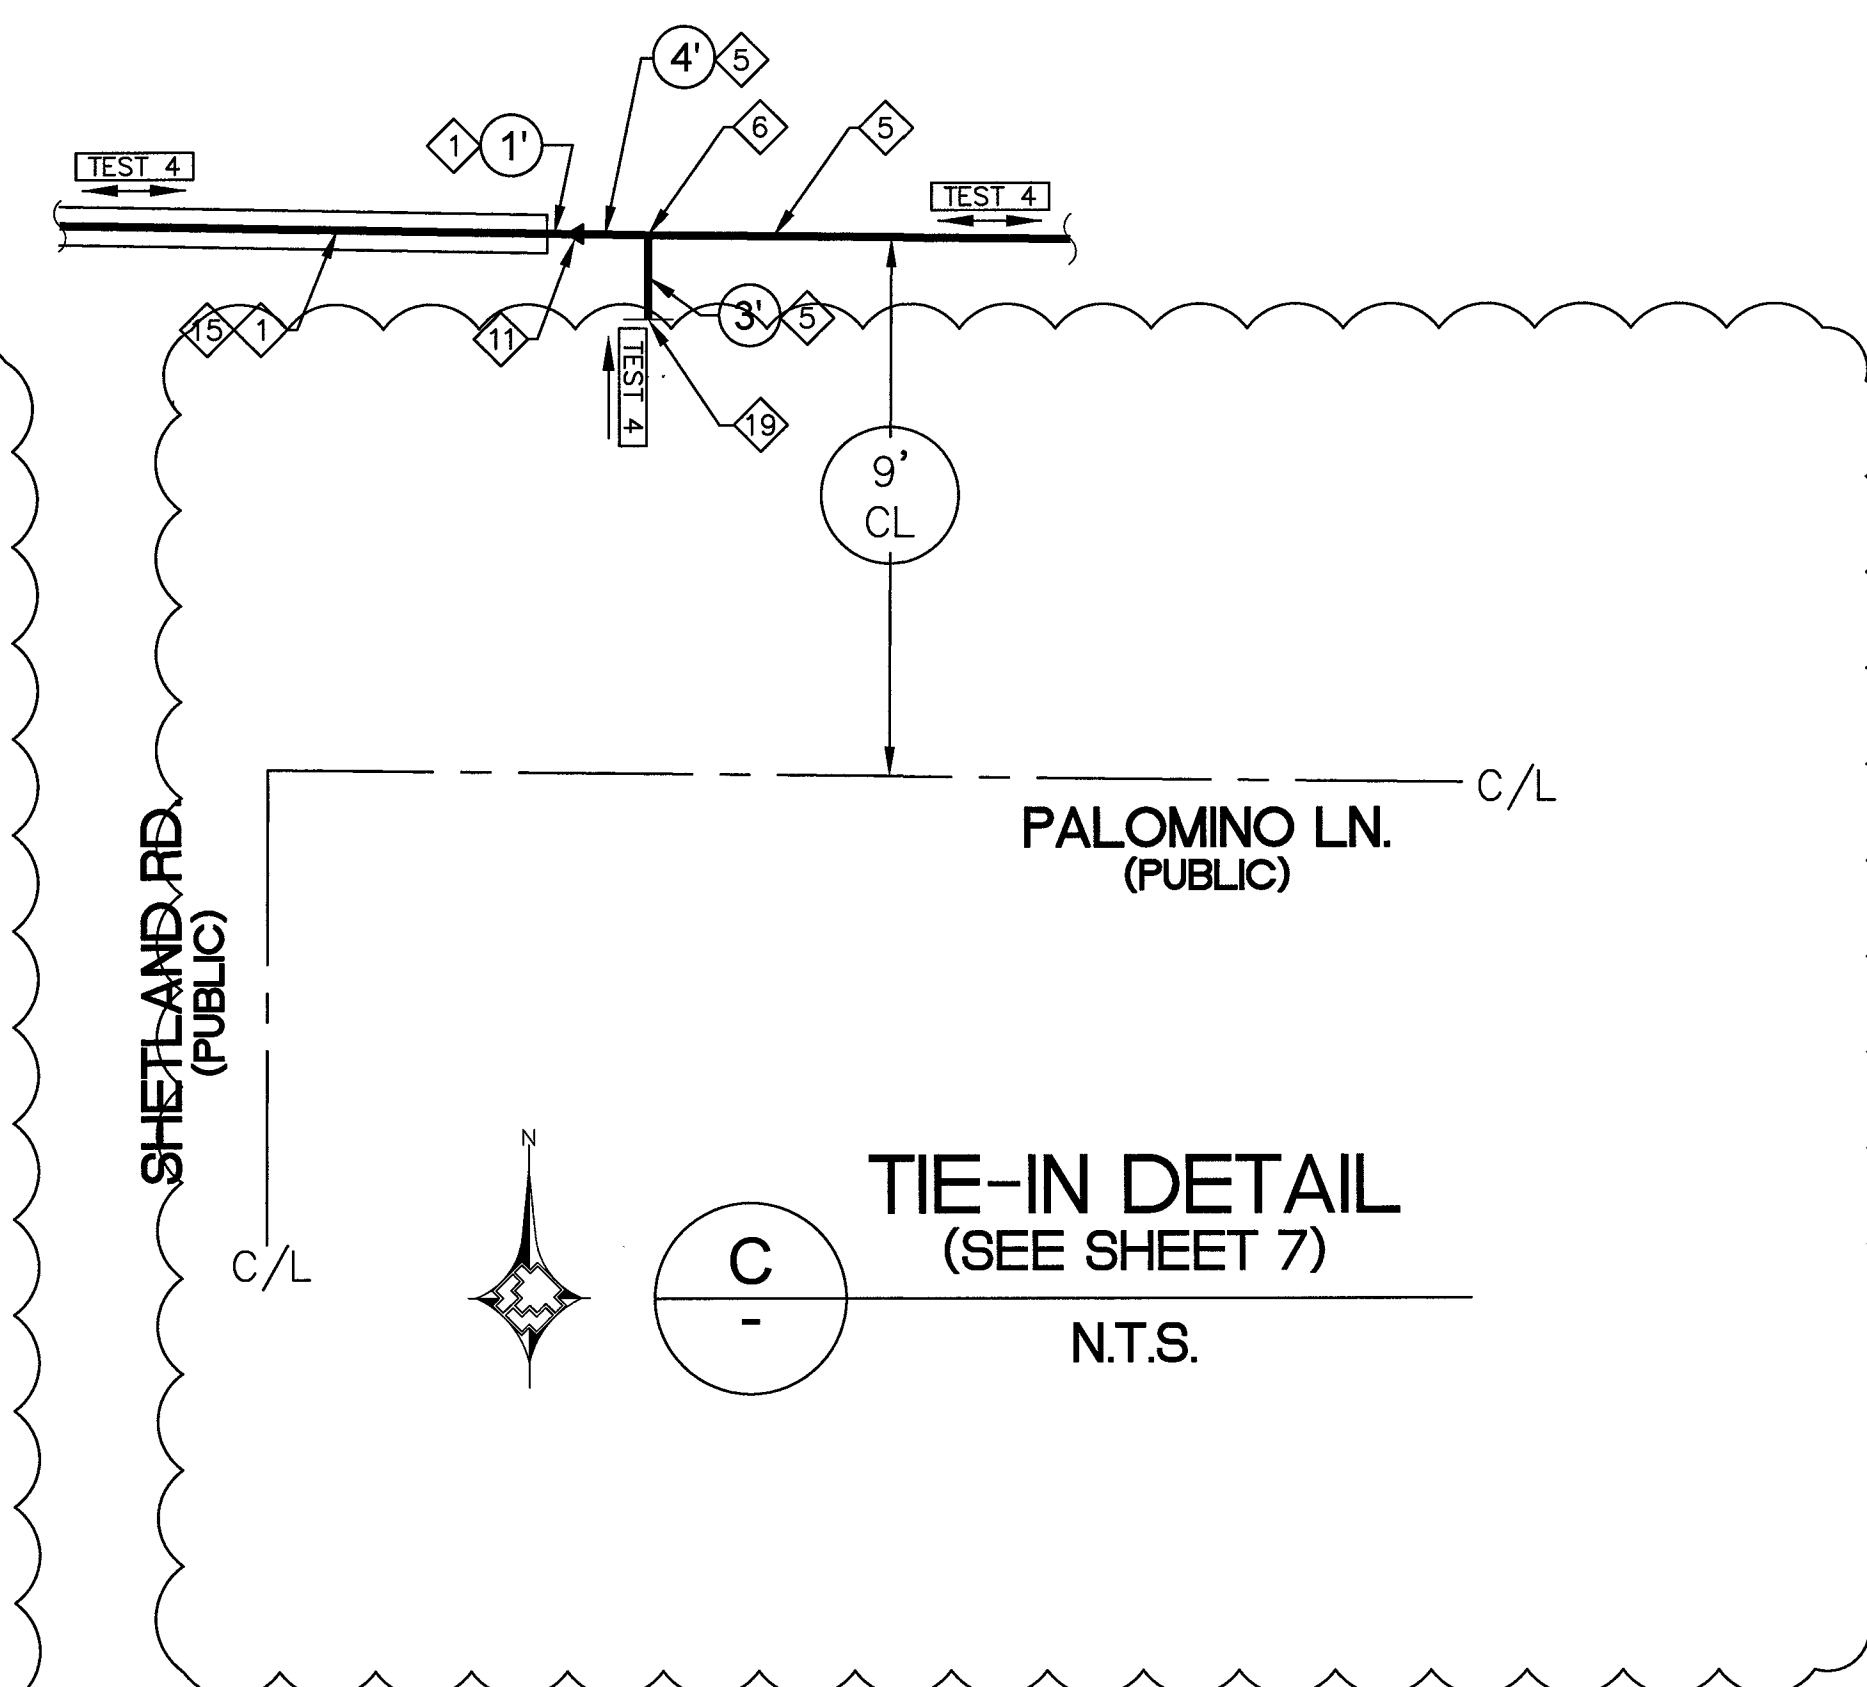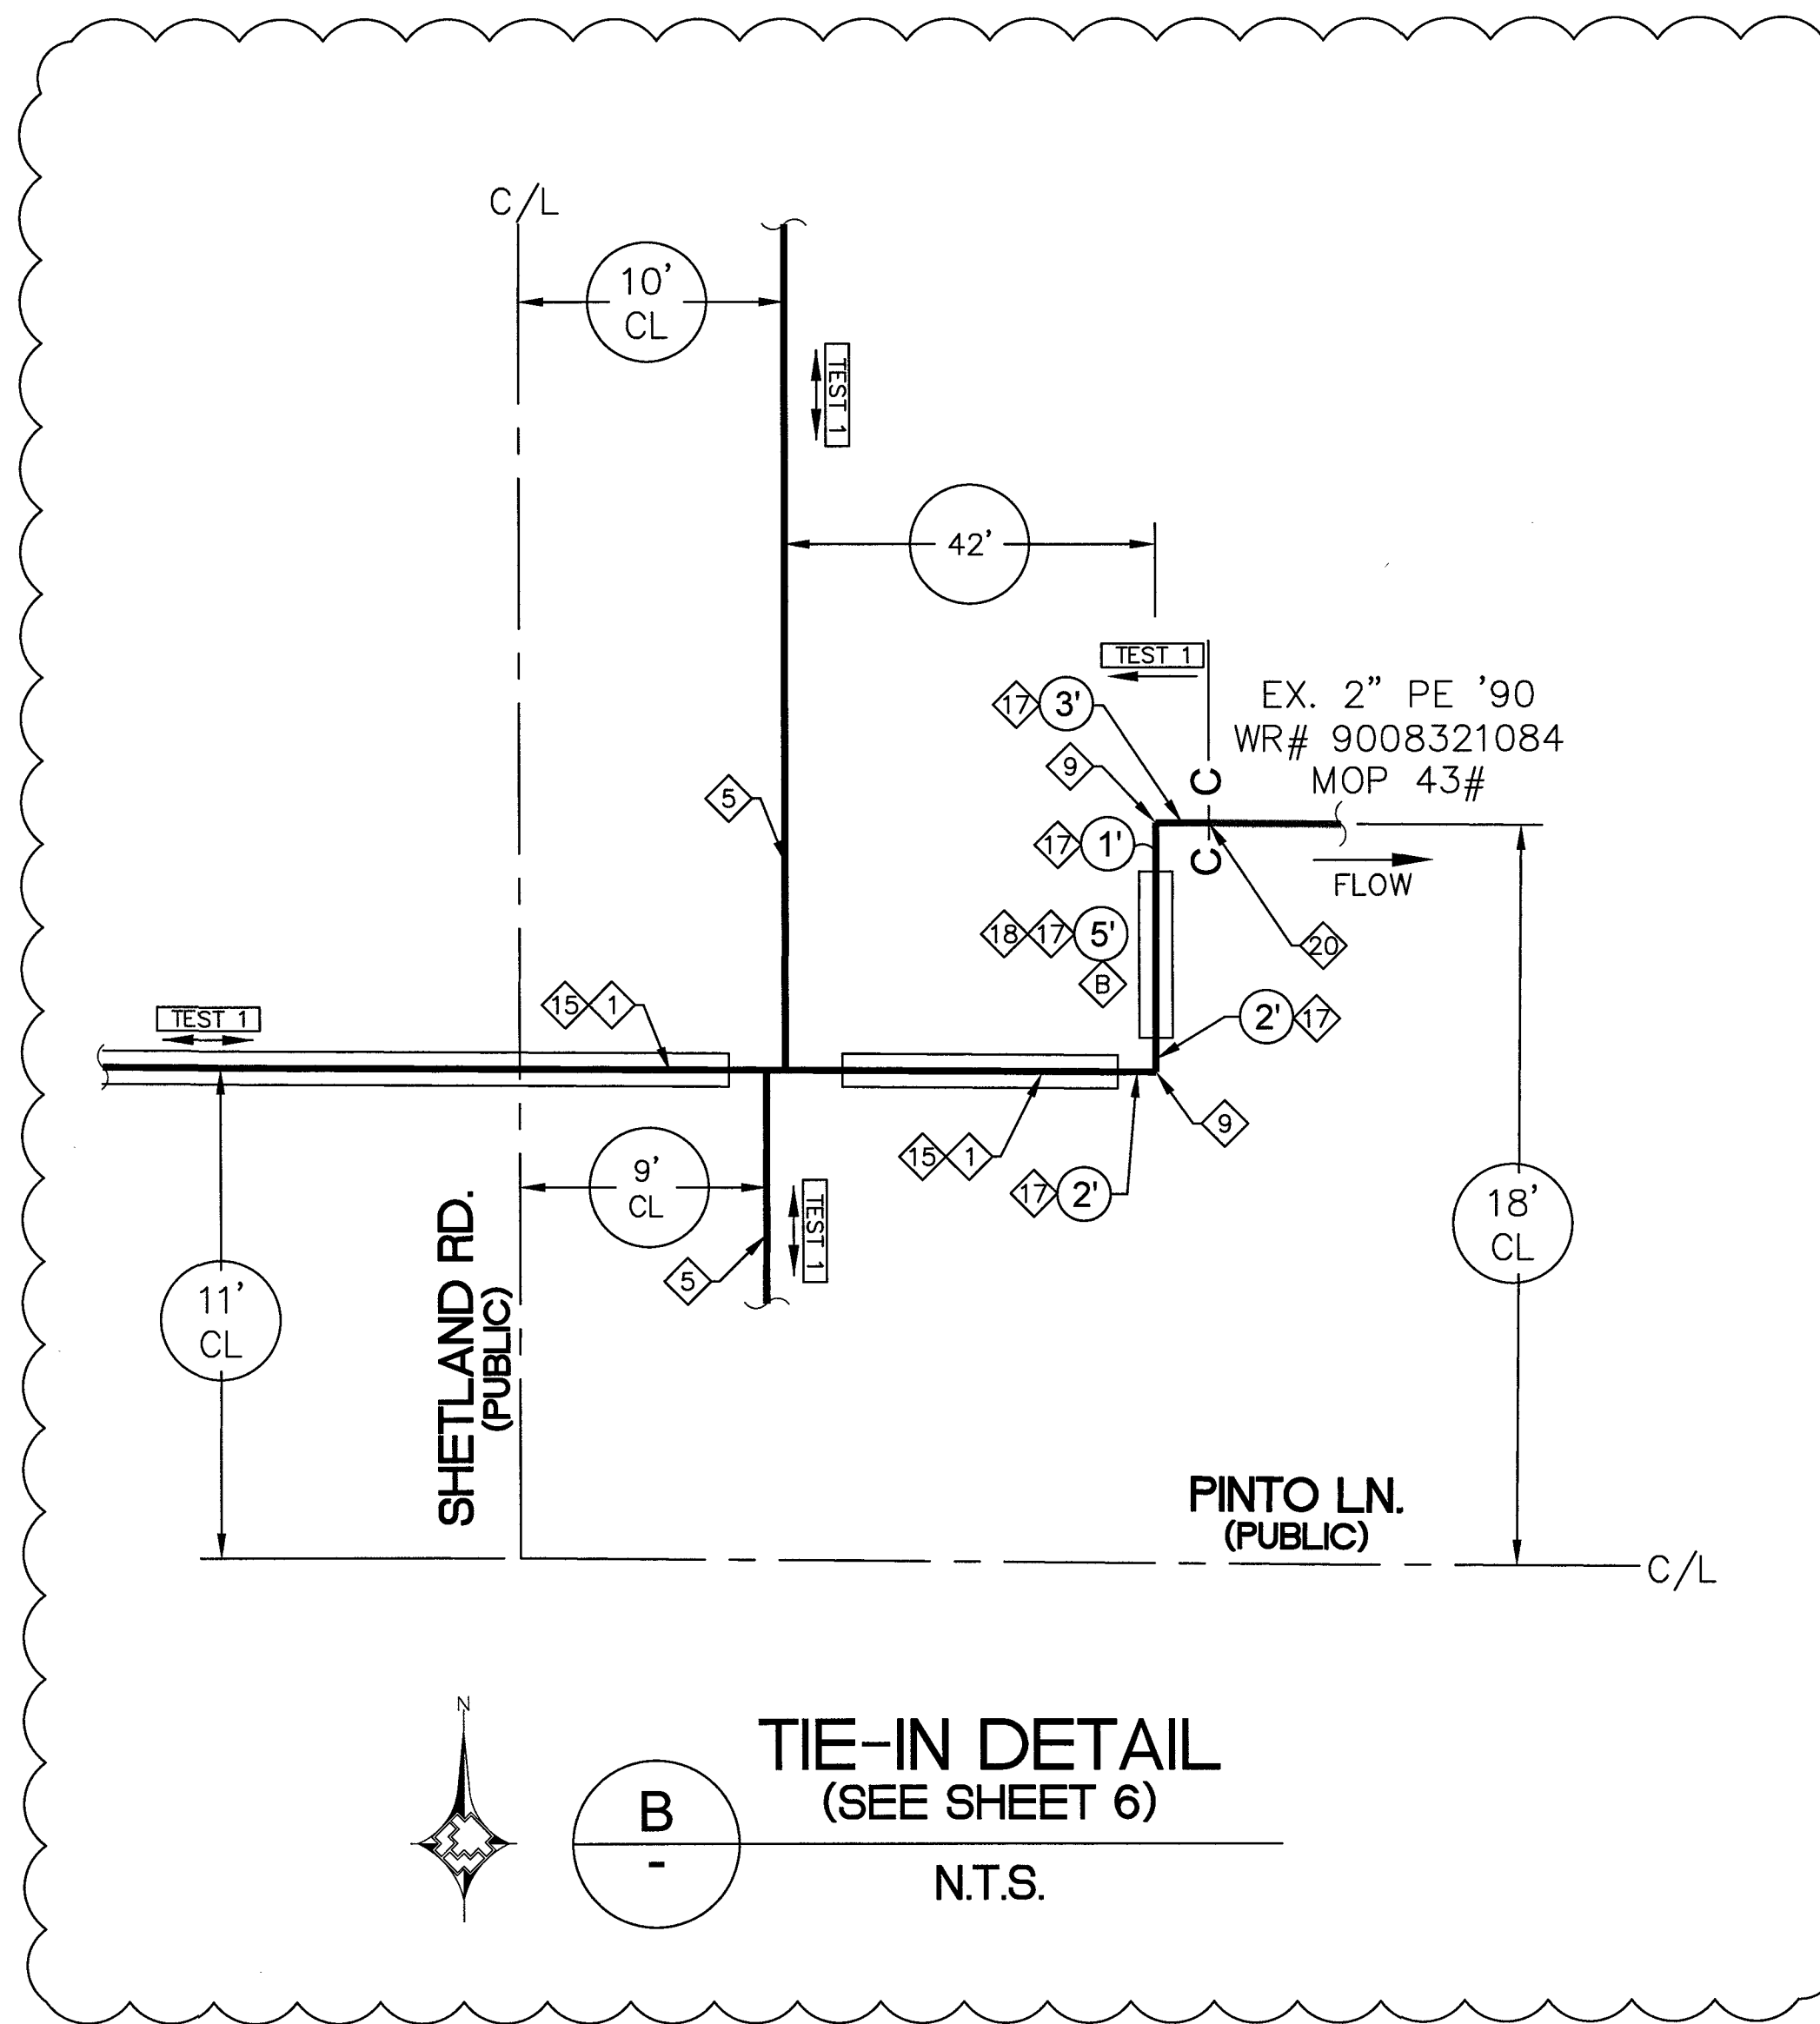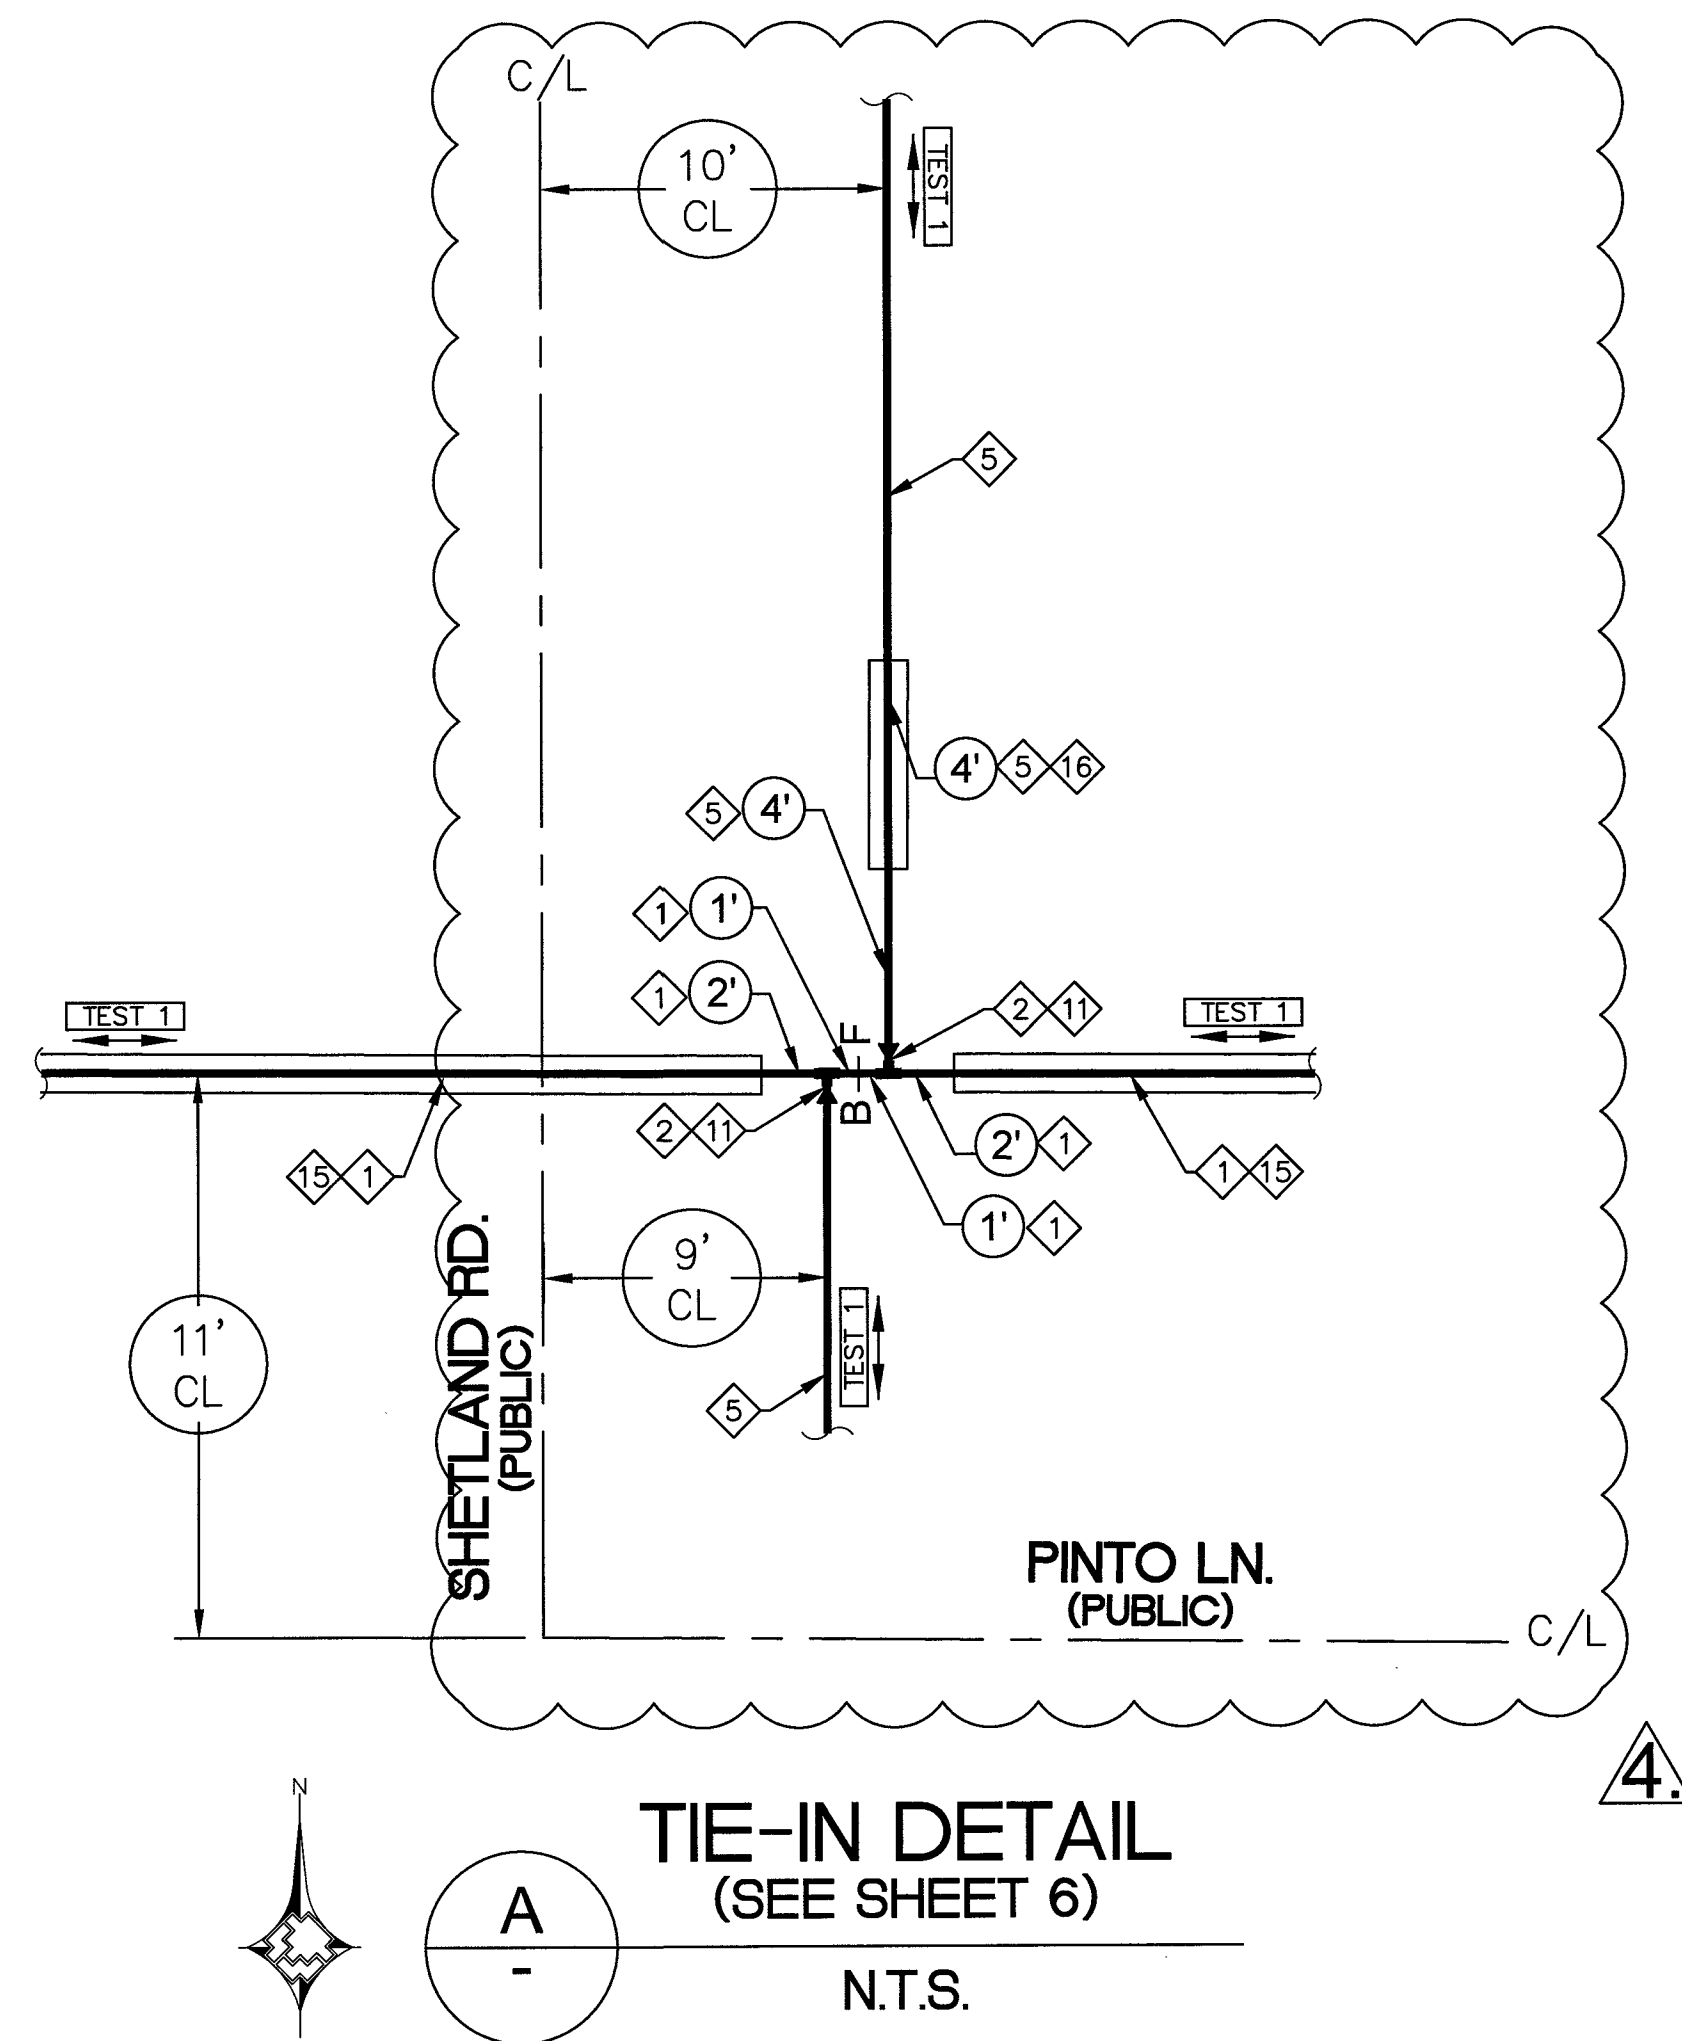

NEW FACILITIES:



- ① NEW 2" PE MAIN - 7'
- ② NEW 2" PE FULL FLOW TEE (140-3074) - 2
- ⑤ NEW 4" PE MAIN - 15'
- ⑥ NEW 4" PE FULL FLOW TEE (140-3076) - 1
- ⑨ NEW 2" PE 90° ELBOW (140-3067) - 1
- ⑪ NEW 4" X 2" PE REDUCER (140-5118) - 3
- ⑫ NEW 6" PE SLEEVING (100-8066) - 4
- ⑬ NEW 2" PE STRAIGHT STICK (100-5133) - 13
- ⑭ NEW 3" SLEEVING PVC STICK 20' JOINTS (100-8997) - 5
- ⑮ NEW 4" PE COUPLING (140-3530) - 1
- ⑯ NEW 2" METFIT COUPLING (140-3504) - 1
- ⓑ BORE

B-F BUTT FUSION

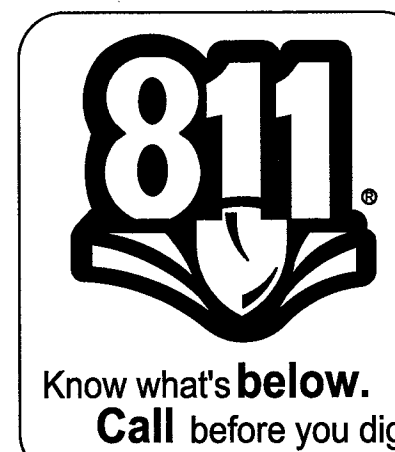

4. AS-BUILT SUBMITTAL FOR FINAL CLOSE				SWG	8/9/17		
NO.	DESCRIPTION	BY	DATE	APPVD			
REVISIONS							
SOUTHWEST GAS CORPORATION							
TAX CODES	UNIT NO.	UNIT TYPE	INSTL. PROPOSED	RETIRED	INSTL. COMPLETED	RETIRED	
PROPERTY UNITS							
AS-BUILT DRAWING-PRESSURE TEST DATA							
PIPE DIA.				TEST MEDIUM			
PIPE LENGTH				TEST METHOD			
PIPE TYPE				GAUGE			
MIN. DURATION				CHART			
TEST PRES. (PSIG)				WATER			
TIME				GAUGE/ PRESS REG SN#			
DATE				END			
PERFORMED BY							
VISUAL INSPECTION CERTIFICATION							
I HAVE VISUALLY INSPECTED ALL HEATED FUSIONS, SOLWENT CEMENT, MECHANICAL JOINTS, AND WELDS THAT HAVE BEEN PERFORMED							
NAME				DATE			
CONSTRUCTION							
INSPECTOR				FOREMAN			
REVIEWED BY				SEE SHEET 2			
PERMIT INFORMATION							
CITY OF LAS VEGAS, NV							
TAX CODE 02-0200							
ISOLATION AREA		W.R. NO.		ENGINEER/TECH: ARIANA ALANIZ		PHONE: 702-365-2027	
095		3021514		ACCOUNT REP:		PHONE:	
LOCATION		ATLAS #/TITLE #		PROJECT CONTACT: ARIANA ALANIZ		PHONE: 702-365-2027	
T20S R61E SEC 32 M.D.M.		x618y514		SHEET NO: 13 OF 15		SCALE: N.T.S.	
				DWN. BY: ZONE ENG.		DATE: 01/07/16	
				CHKD. BY:		APPVD. BY:	
GIR-CLV-PINTO & SHETLAND - STEEL REPLACEMENT							



4.

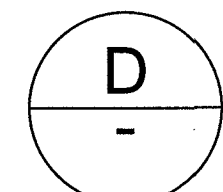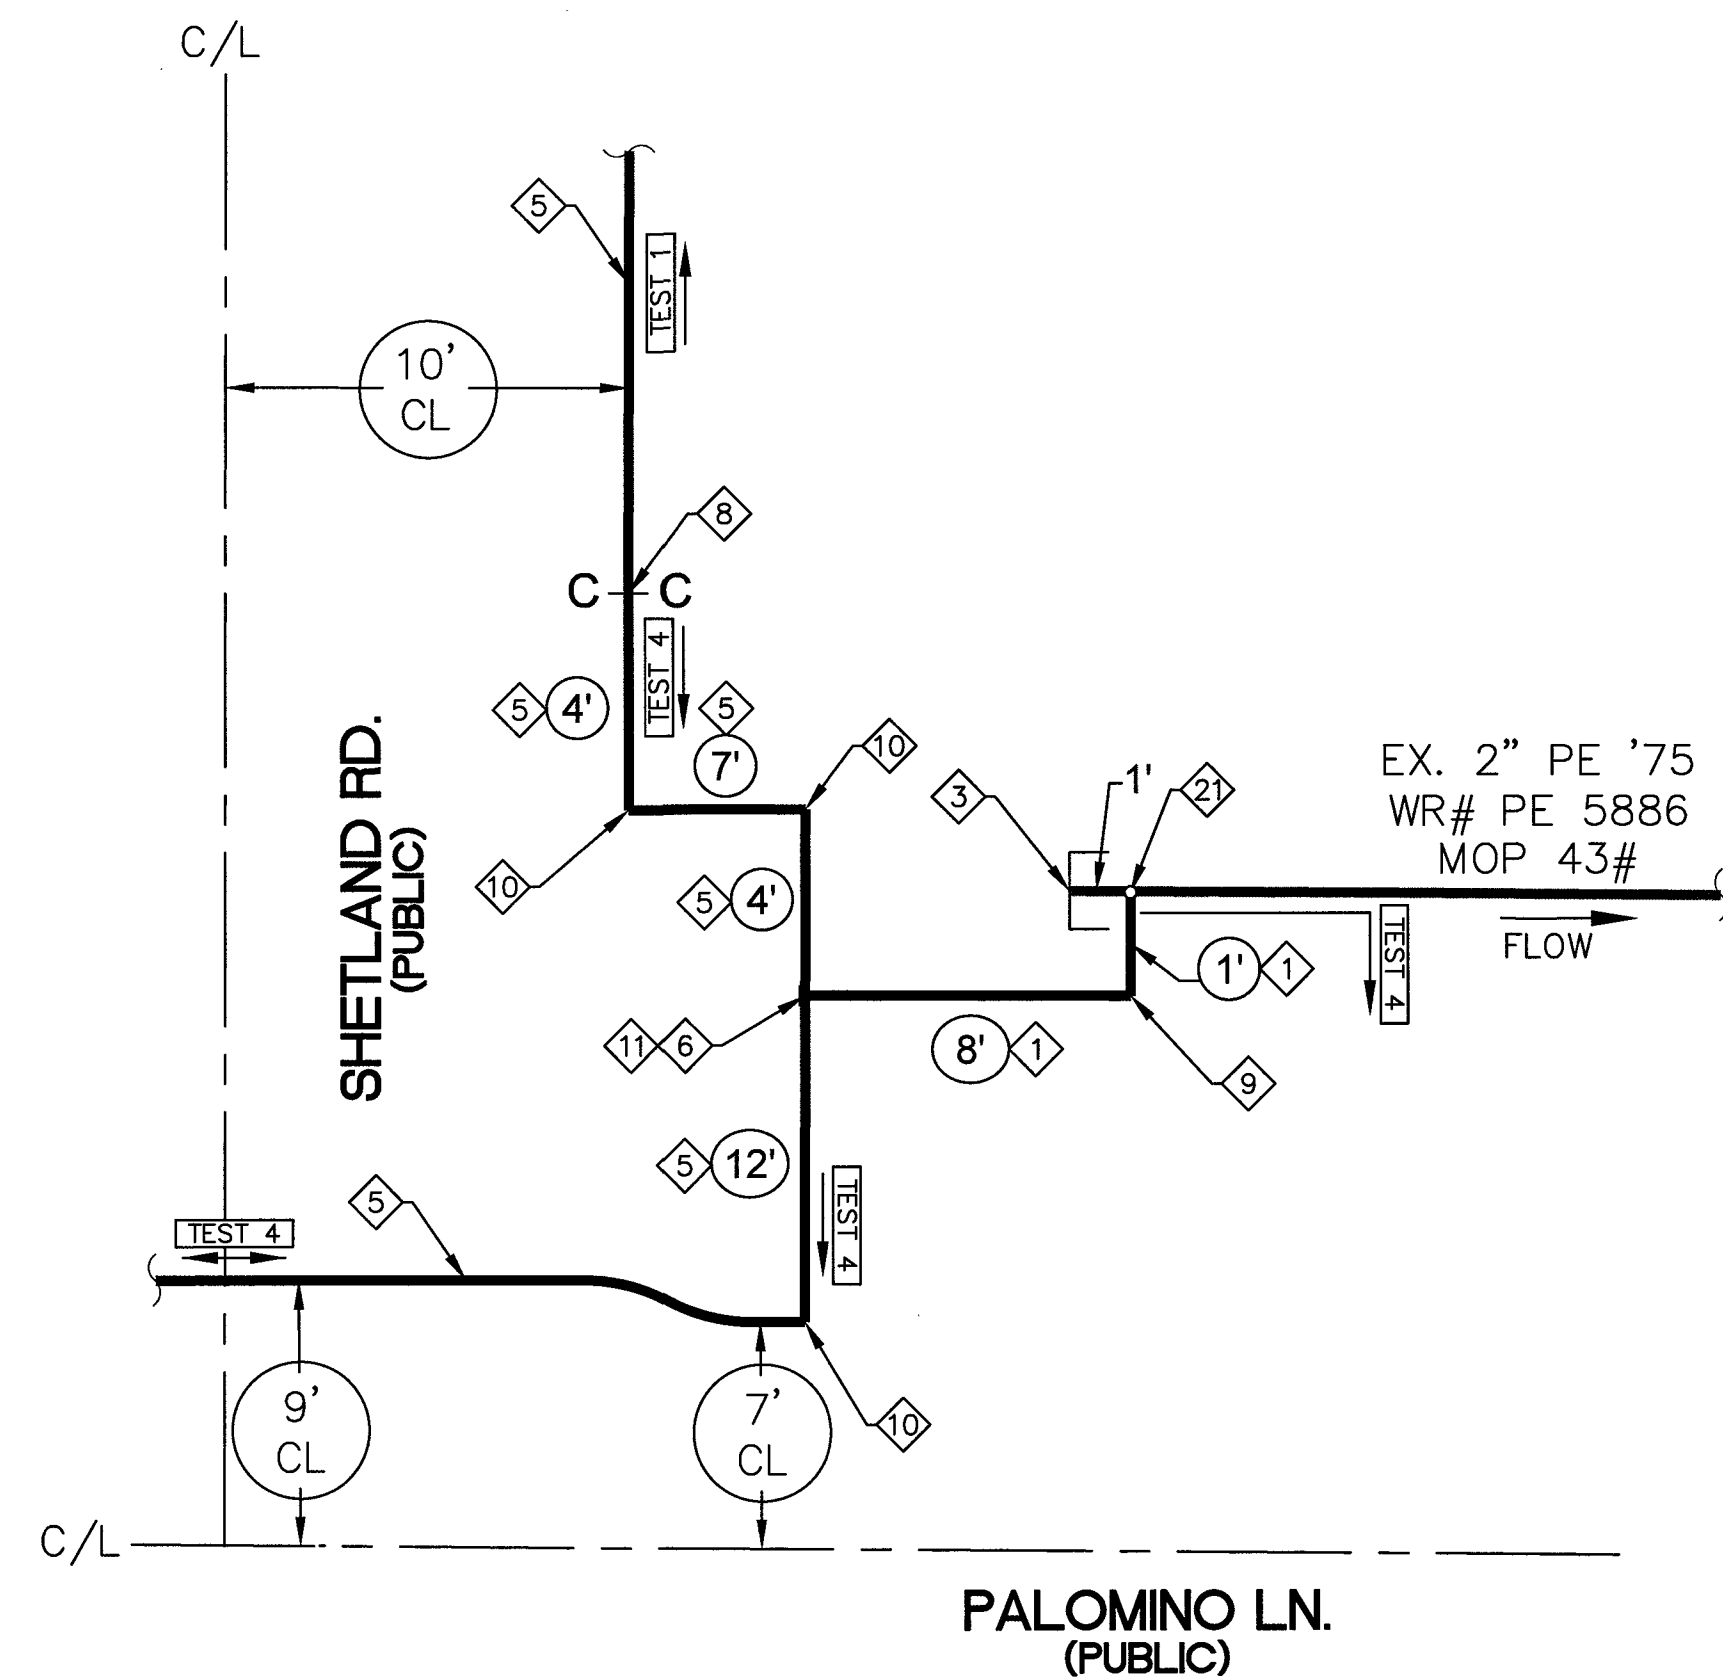

TIE-IN DETAIL
(SEE SHEET 7)

N.T.S.



ALTA DR.
(PUBLIC)

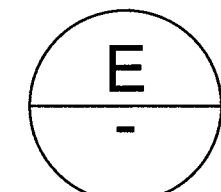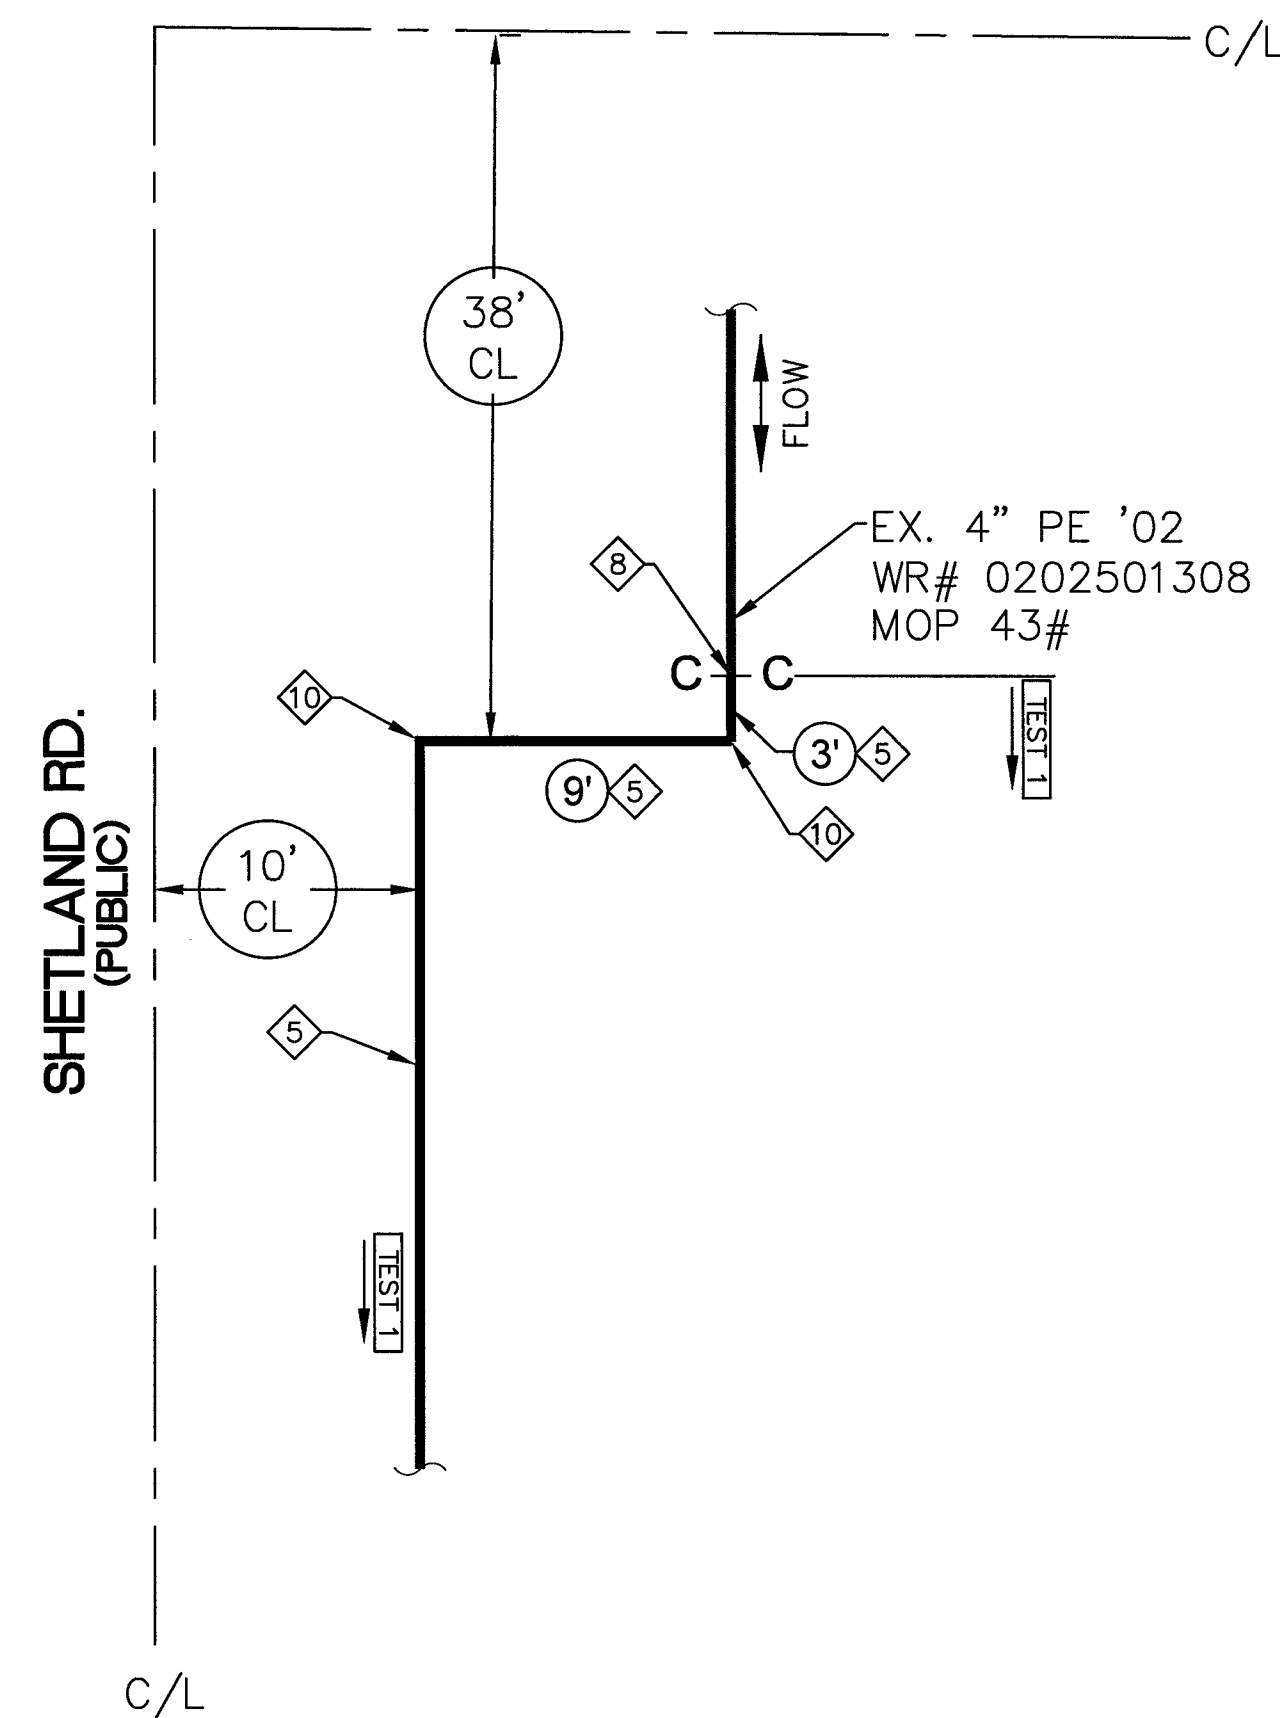

TIE-IN DETAIL
(SEE SHEET 11)

N.T.S.

PALOMINO LN.
(PUBLIC)

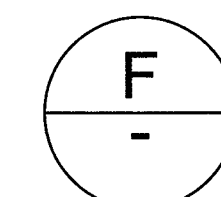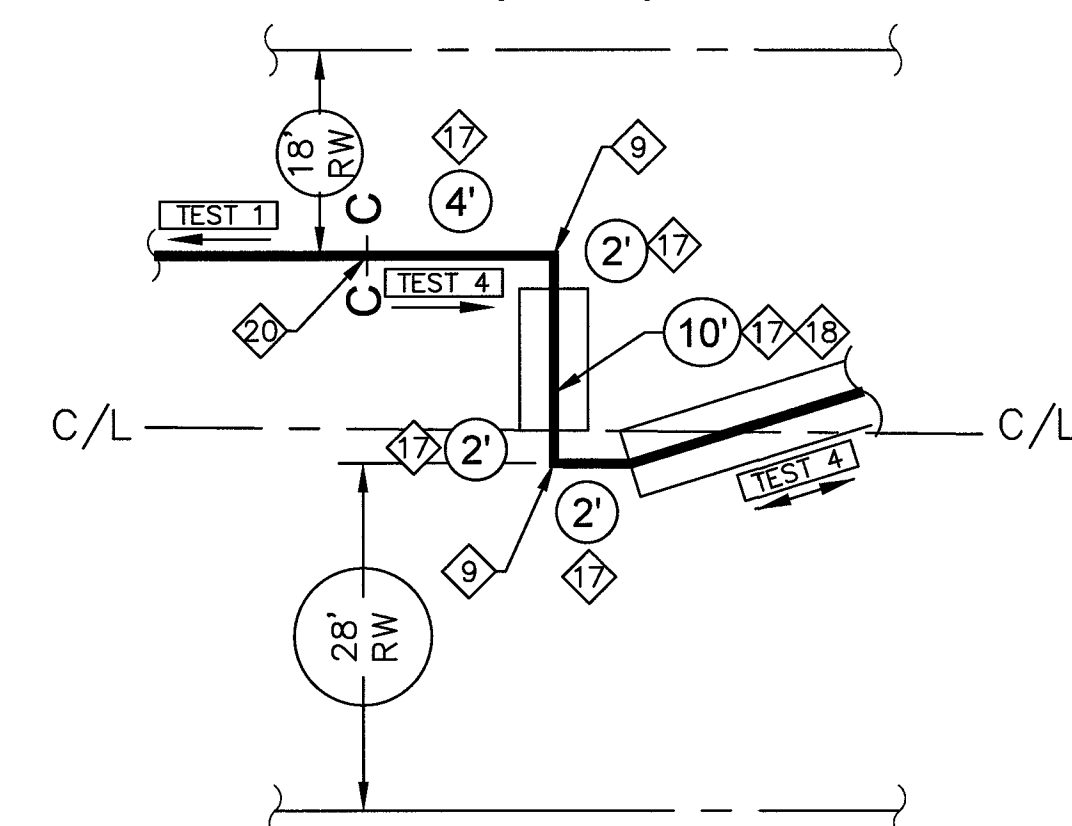

TIE-IN DETAIL
(SEE SHEET 9)

N.T.S.

NEW FACILITIES:

- 1 NEW 2" PE MAIN - 9'
- 3 NEW 2" PE CAP (140-3060) - 1
- 5 NEW 4" PE MAIN - 39'
- 6 NEW 4" PE FULL FLOW TEE (140-3076) - 1
- 8 NEW 4" PERFECTION COUPLING (140-3530) - 2
- 9 NEW 2" PE 90° ELBOW (140-3067) - 3
- 10 NEW 4" PE 90° ELBOW (140-3069) - 4
- 11 NEW 4" X 2" PE REDUCER (140-5118) 1
- 17 NEW 2" PE STRAIGHT STICK (100-5133) - 20'
- 18 NEW 3" SLEEVING PVC STICK 20' JOINTS (100-8997) - 10'
- 20 NEW 2" METFIT COUPLING (140-3504) - 1
- 21 NEW 2" HVTT TAP TEE (160-8171) - 1
- B BORE

B-F BUTT FUSION



4.	AS-BUILT SUBMITTAL FOR FINAL CLOSE	SWG	8/9/17	
NO.	DESCRIPTION	BY	DATE	APPVD.
REVISIONS				



TAX CODES	UNIT NO.	UNIT TYPE	INSTL. PROPOSED	RETIRED	INSTL. COMPLETED	RETIRED
PROPERTY UNITS						

AS-BUILT DRAWING-PRESSURE TEST DATA

PIPE DIA.	TEST MEDIUM	TEST METHOD
PIPE LENGTH	☐ AIR ☐ NITROGEN	☐ GAUGE ☐ CHART
PIPE TYPE	☐ WATER ☐ SOAP	☐ GAUGE/ PRESS REC SN#
MIN. DURATION	START	END
TEST PRES. (PSIG)		
TIME		
DATE		
PERFORMED BY		

VISUAL INSPECTION CERTIFICATION

I HAVE VISUALLY INSPECTED ALL HEATED FUSIONS, SOLVENT CEMENT, MECHANICAL JOINTS, AND WELDS THAT I HAVE PERFORMED

NAME	DATE
INSPECTOR	
FOREMAN	
REVIEWED BY	

AS-BUILTS ACCEPTED BY DATE

POSTED BY DATE

POSTING QC'D BY DATE

CONSTRUCTION

CITY OF LAS VEGAS, NV

TAX CODE 02-0200

ISOLATION AREA

095

LOCATION T20S R61E SEC 32 M.D.M.

W.R. NO.

3021514

ATLAS #/TILE # x618y514

ENGINEER/TECH: ARIANA ALANIZ

ACCOUNT REP. ARIANA ALANIZ

PROJECT CONTACT: ARIANA ALANIZ

SHEET NO: 14 OF 15 SCALE: N.T.S.


DWN. BY: ZONE ENG. CHKD. BY: APPVD. BY:

PHONE: 702-365-2027

PHONE: 702-365-2027


DATE: 01/07/16

GIR-CLV-PINTO & SHETLAND
- STEEL REPLACEMENT

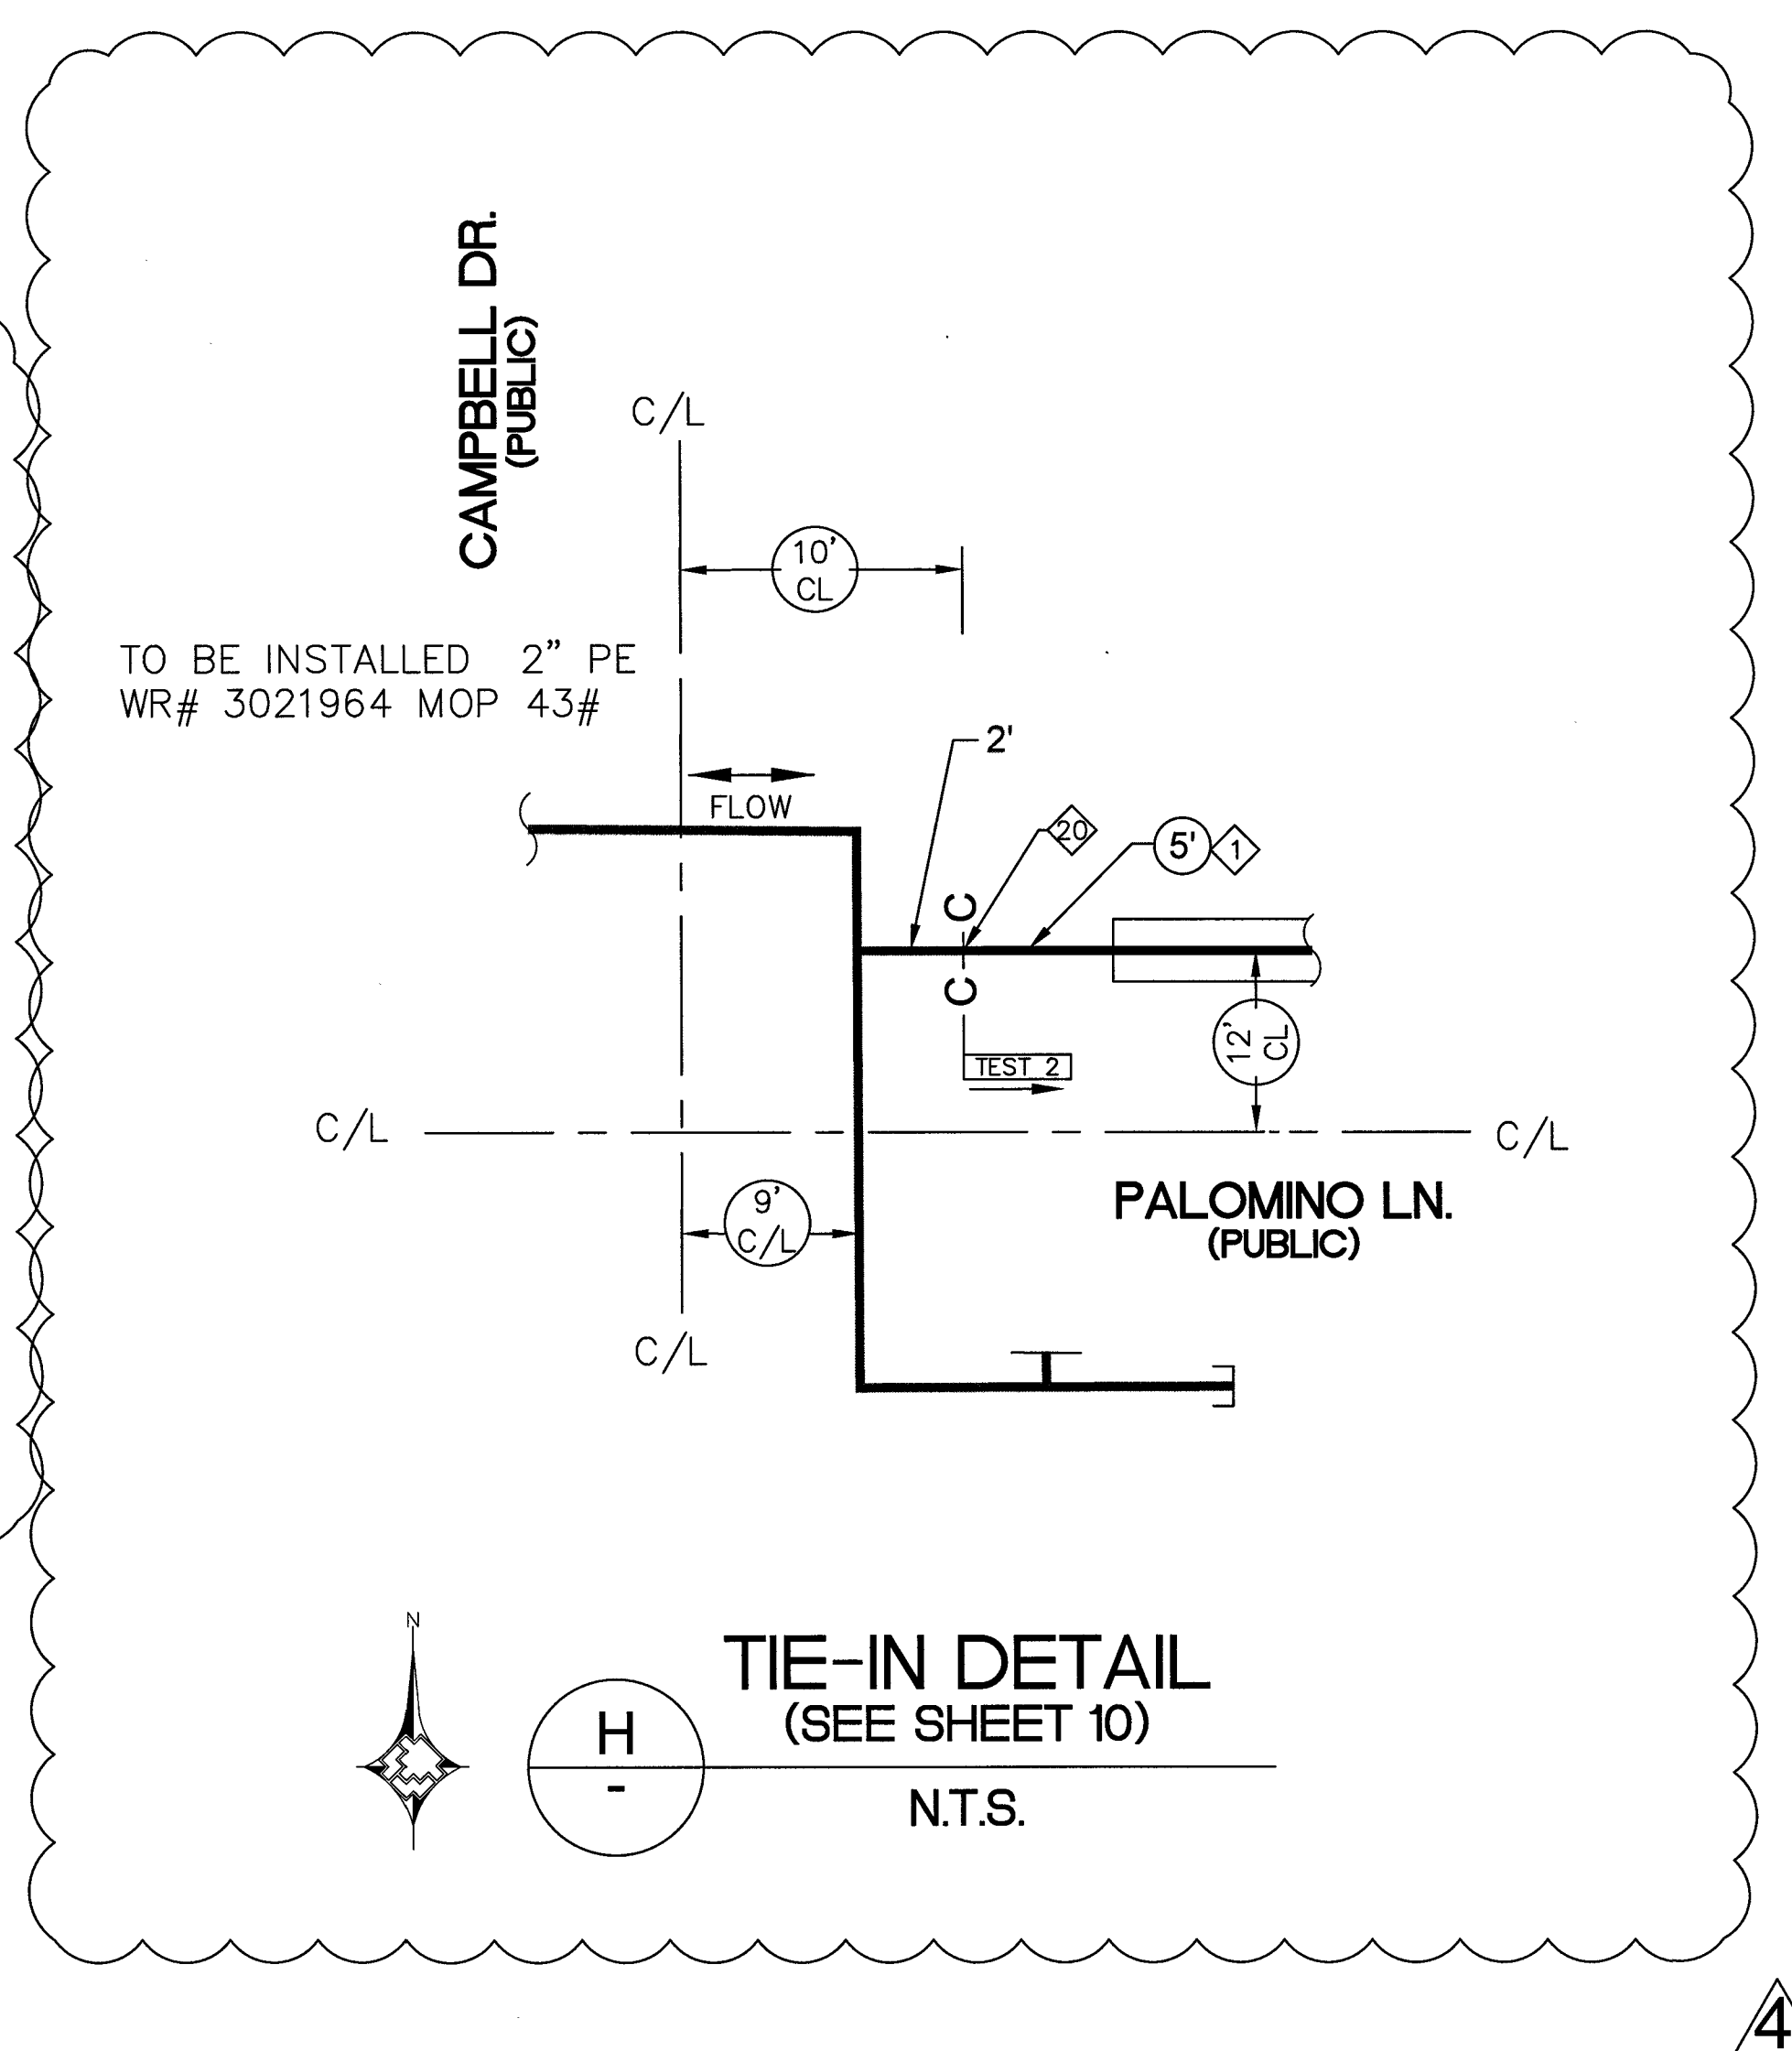

- ① 4" STEEL 3-WAY SHORTSTOPP TEE (160-8030) - 1
- ② 4" STEEL WELD CAP (140-3309) - 1
- ③ TRANSITION 4" FITTING STEEL TO PE NMDA - 1

1	NEW 2" PE MAIN - 5'
5	NEW 4" PE MAIN - 29'
8	NEW 4" PERFECTION COUPLING (140-3530) - 1
10	NEW 4" PE 90° ELBOW (140-3069) - 1
20	NEW 2" METFIT COUPLING (140-3504) - 1

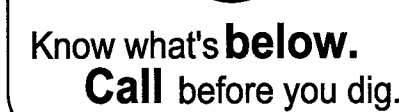[illegible]