

UTILITY AS-BUILT MAP
HIGHPOINTE AT SUMMERLIN
UNIT 1

NOTE:
WATER METER AND SEWER SERVICE LOCATIONS AS SHOWN
ON THIS MAP WERE PROVIDED BY THE CONTRACTOR. ALPHA
ENGINEERING ASSUMES NO LIABILITY FOR MISPLACED SERVICES
REPRESENTED ON THIS MAP.



UNIT 1
QUANTITIES
WATER QUANTITIES

10" WATER	651 L.F.
6" WATER	238 L.F.
8" WATER	1856 L.F.
1 8" GATE VALVE	4 EA.
2 8" TEE	2 EA.
3 8" CROSS	1 EA.
STANDARD FIRE HYDRANT ASSEMBLY	5 EA.
3/4" WATER METER W/ SERVICE	50 EA.
2" BLOWOFF	3 EA.

STREET LIGHT QUANTITIES

100 W.H.P.S. TYPE 3	14 EA.
1 1/4" CONDUIT W/ CABLE	2360

SEWER QUANTITIES
(PUBLIC)

8" SEWER	2351 L.F.
48" MANHOLE	10 EA.
SEWER SERVICE	53 EA.

STREET SIGN QUANTITIES

STD. STREET SIGN W/ POLE (PER STD. DWG. No. 250)	4 EA.
---	-------

UTILITY AS-BUILT MAP

HIGHPOINTE AT SUMMERLIN
UNIT 1

JOB # N3-76-15

NAME SMD

DATE 6-1-98

SCALE 1" = 50'

PAGE 1


7615/UTL.DWG OF 1

NOTICE!

EXISTING UTILITIES ARE SHOWN
ON PLANS FOR THE CONVENI-
ENCE OF THE CONTRACTOR.
ONLY. THE CONTRACTOR IS
RESPONSIBLE FOR THE PRO-
TECTION OF ALL UTILITIES.
THE ENGINEER BEARS NO RES-
PONSIBILITY FOR UTILITIES NOT
SHOWN OR SHOWN INCORRECTLY.

Call
Digs
BEFORE YOU
Dig

1-800-227-2600
UNDERGROUND SERVICE, USA

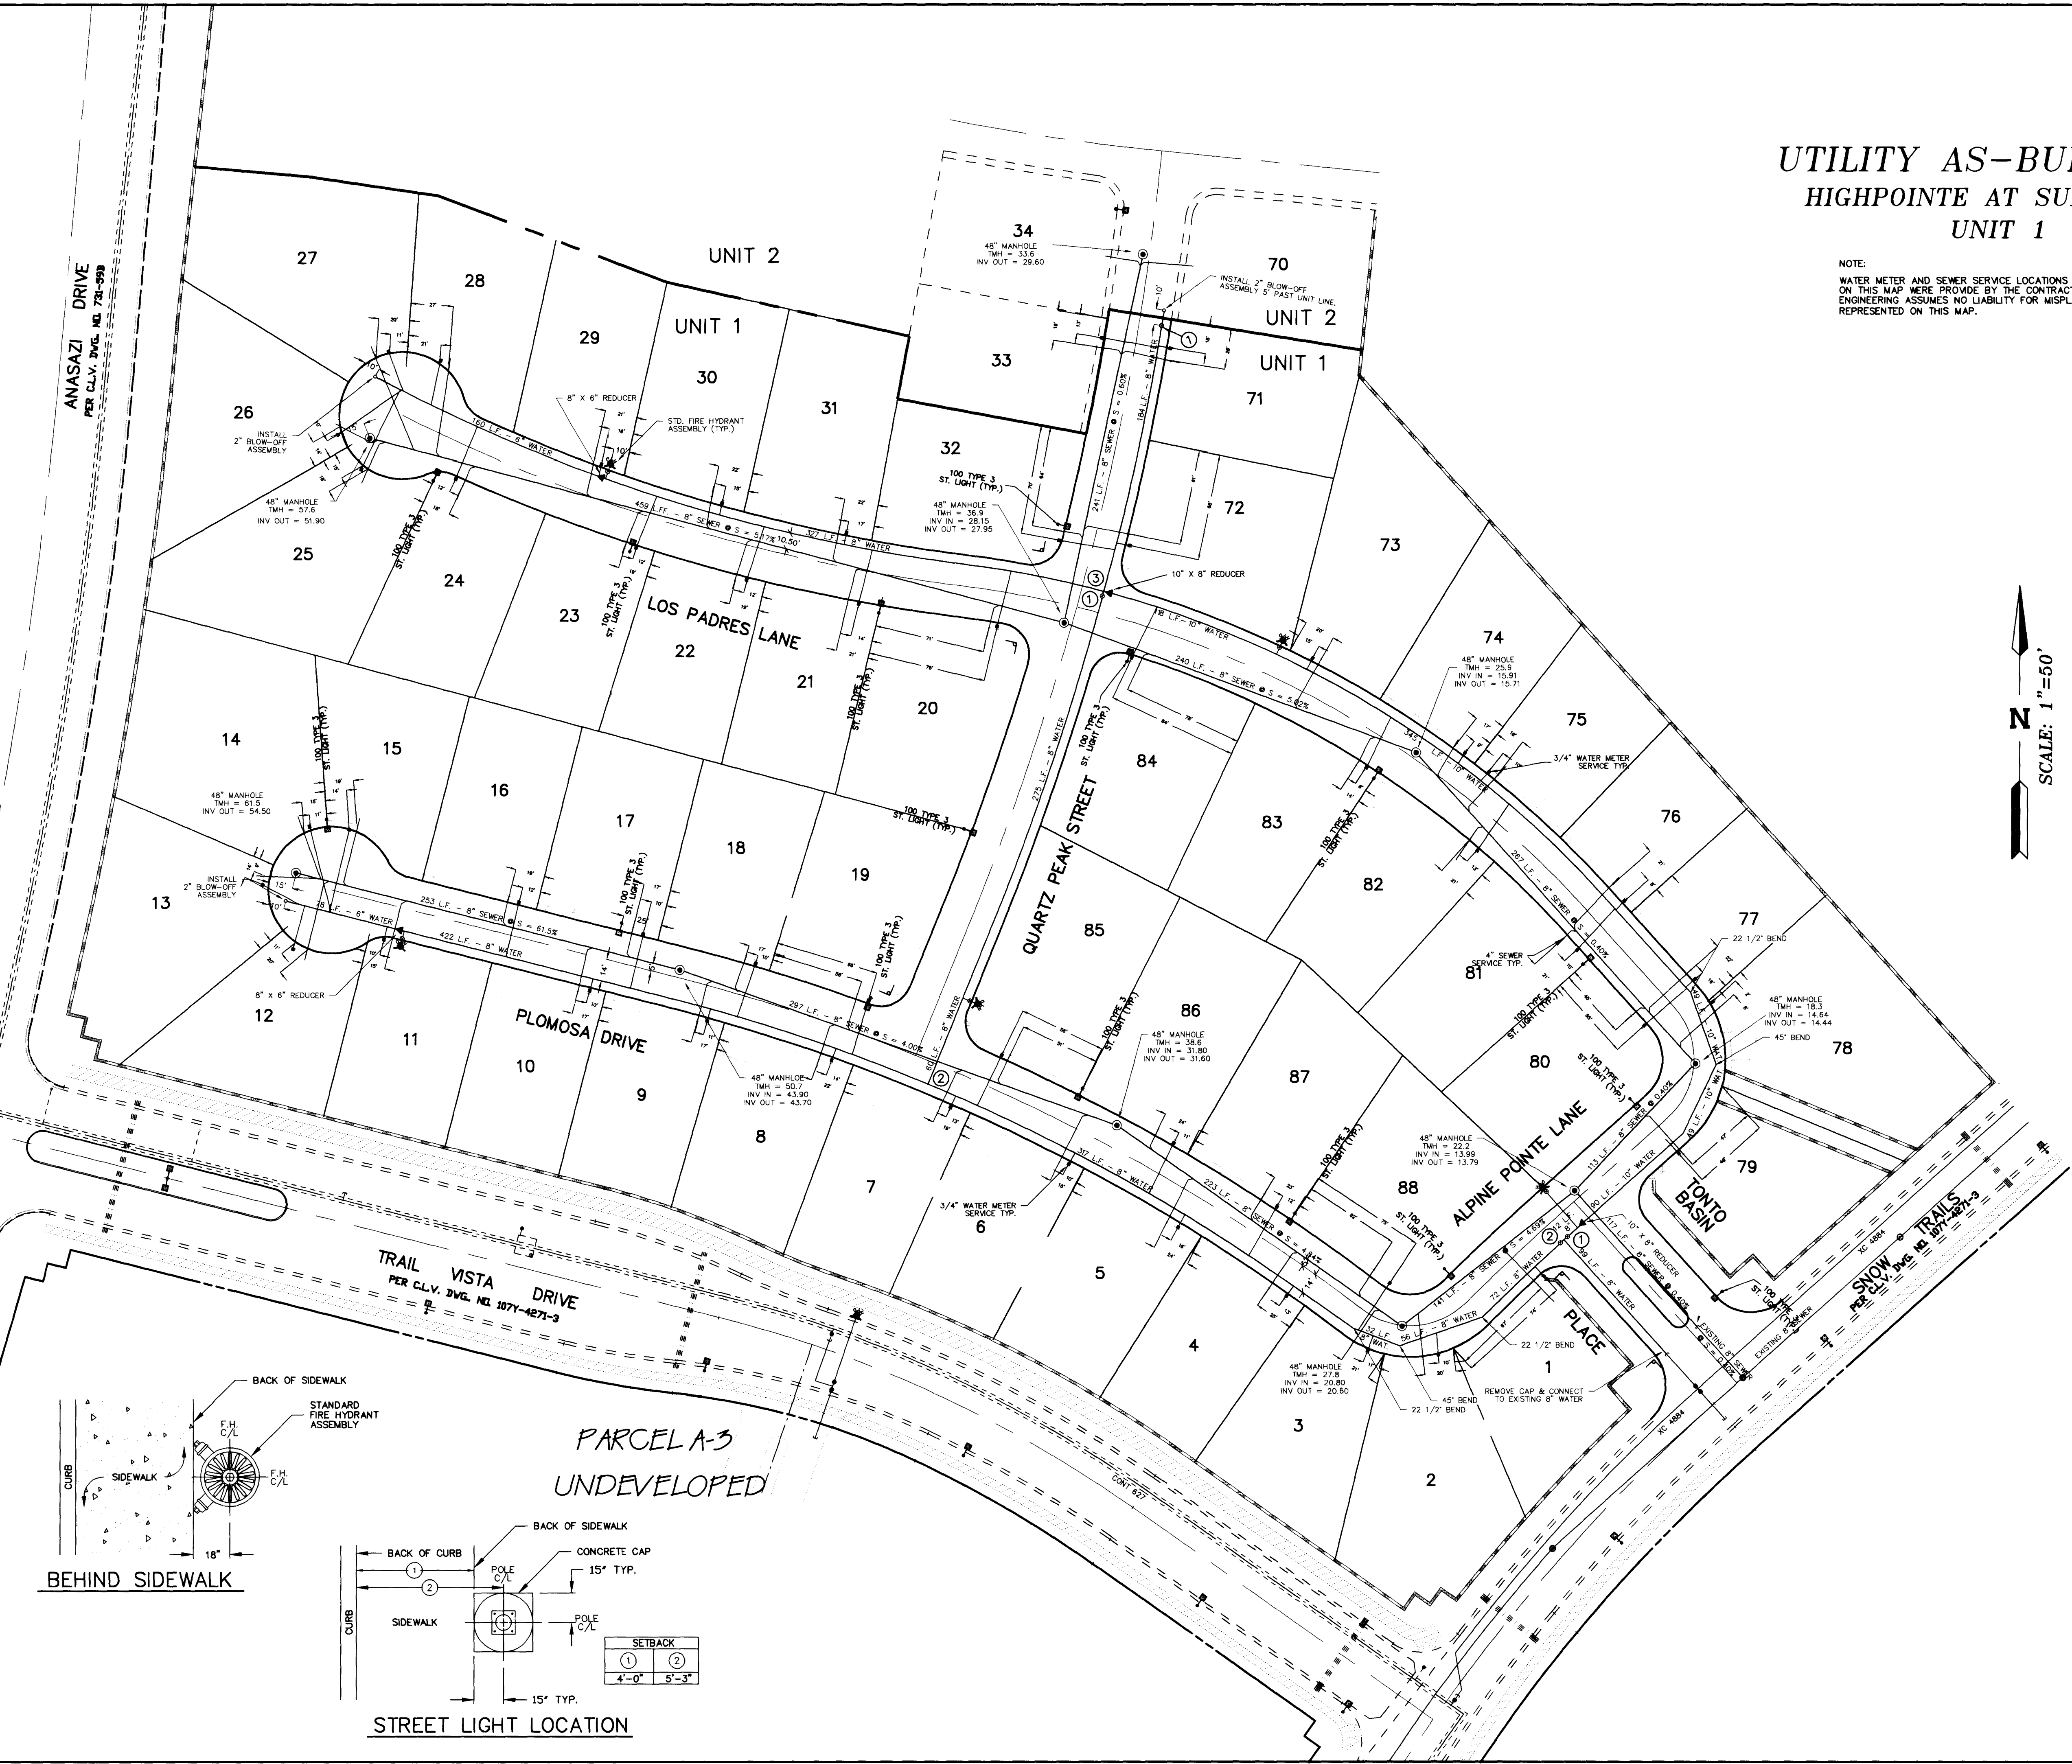

UTILITY AS-BUILT MAP HIGHPOINTS AT SUMNERJUN UNIT 1

STANDARD



UNIT 1 QUANTITIES

WATER QUANTITIES

1" DIA	100.00
1 1/2" DIA	100.00
2" DIA	100.00
3" DIA	100.00
4" DIA	100.00
6" DIA	100.00
8" DIA	100.00
10" DIA	100.00
12" DIA	100.00
15" DIA	100.00
18" DIA	100.00
24" DIA	100.00
30" DIA	100.00
36" DIA	100.00
42" DIA	100.00
48" DIA	100.00
54" DIA	100.00
60" DIA	100.00
72" DIA	100.00
84" DIA	100.00
96" DIA	100.00
108" DIA	100.00
120" DIA	100.00

STREET LIGHT QUANTITIES

STREET LIGHT	100.00
1" DIA	100.00
1 1/2" DIA	100.00
2" DIA	100.00
3" DIA	100.00
4" DIA	100.00
6" DIA	100.00
8" DIA	100.00
10" DIA	100.00
12" DIA	100.00
15" DIA	100.00
18" DIA	100.00
24" DIA	100.00
30" DIA	100.00
36" DIA	100.00
42" DIA	100.00
48" DIA	100.00
54" DIA	100.00
60" DIA	100.00
72" DIA	100.00
84" DIA	100.00
96" DIA	100.00
108" DIA	100.00
120" DIA	100.00

SEWER QUANTITIES

1" DIA	100.00
1 1/2" DIA	100.00
2" DIA	100.00
3" DIA	100.00
4" DIA	100.00
6" DIA	100.00
8" DIA	100.00
10" DIA	100.00
12" DIA	100.00
15" DIA	100.00
18" DIA	100.00
24" DIA	100.00
30" DIA	100.00
36" DIA	100.00
42" DIA	100.00
48" DIA	100.00
54" DIA	100.00
60" DIA	100.00
72" DIA	100.00
84" DIA	100.00
96" DIA	100.00
108" DIA	100.00
120" DIA	100.00

STREET SIGN QUANTITIES

STREET SIGN	100.00
1" DIA	100.00
1 1/2" DIA	100.00
2" DIA	100.00
3" DIA	100.00
4" DIA	100.00
6" DIA	100.00
8" DIA	100.00
10" DIA	100.00
12" DIA	100.00
15" DIA	100.00
18" DIA	100.00
24" DIA	100.00
30" DIA	100.00
36" DIA	100.00
42" DIA	100.00
48" DIA	100.00
54" DIA	100.00
60" DIA	100.00
72" DIA	100.00
84" DIA	100.00
96" DIA	100.00
108" DIA	100.00
120" DIA	100.00

ALPHA
OZ

UTILITY AS-BUILT MAP
HIGHPOINTS AT SUMNERJUN
UNIT 1

DATE	10/10/10
BY	10/10/10
CHK	10/10/10
APP	10/10/10

NO.	1
-----	---