

QUANTITY ESTIMATE

8" VCP SEWER MAIN 1915 LF
4" VCP SEWER MAIN 2134 LF
STANDARD MANHOLE 8 EA.

GENERAL NOTES

- HOUSE SERVICES SHALL COMPLY WITH WESTERN PLUMBING CODE AS THE SEPARATION DISTANCE.
- ALL HOUSES TO BE SERVED INDIVIDUALLY AS PER SECTION 313 OF THE UNIFORM PLUMBING CODE.
- CONTRACTOR SHALL FURNISH THE ENGINEER WITH AS-BUILT DRAWINGS SHOWING THE EXACT LOCATIONS OF ALL HOUSE CONNECTIONS.
- CONCRETE COLLARS TO BE CONSTRUCTED AROUND ALL MANHOLES AND WATER VALVES.
- CHISEL S OR C WHEREVER SEWER OR GAS LINES PASS UNDER CURB.

SEWER LATERAL TIES



SEWER LATERAL "AS-BUILT" CERTIFICATION

BYRON E. JOHNSON, P.L.S.
NEVADA CERT. NO. 9390
3-25-92

APPROVED
CLV CITY ENGINEER DATE
CLV SANITATION ENGINEER DATE
CLV FIELD OPERATIONS ENGINEER DATE
CLV QUALITY CONTROL ENGINEER DATE

W/S # 2717

QUANTITY ESTIMATE


STREET SEWER MAIN
 48" DIA. SEWER MAIN
 STANDARD MANHOLE

PER LF
 STA. 12
 TO STA.

NOTES

1. SEE PLAN FOR LOCATION OF ALL SEWER MAINS AND MANHOLES.
2. SEE PLAN FOR LOCATION OF ALL SEWER MAINS AND MANHOLES.
3. SEE PLAN FOR LOCATION OF ALL SEWER MAINS AND MANHOLES.
4. SEE PLAN FOR LOCATION OF ALL SEWER MAINS AND MANHOLES.
5. SEE PLAN FOR LOCATION OF ALL SEWER MAINS AND MANHOLES.
6. SEE PLAN FOR LOCATION OF ALL SEWER MAINS AND MANHOLES.
7. SEE PLAN FOR LOCATION OF ALL SEWER MAINS AND MANHOLES.
8. SEE PLAN FOR LOCATION OF ALL SEWER MAINS AND MANHOLES.
9. SEE PLAN FOR LOCATION OF ALL SEWER MAINS AND MANHOLES.
10. SEE PLAN FOR LOCATION OF ALL SEWER MAINS AND MANHOLES.

SEWER LATERAL TEST

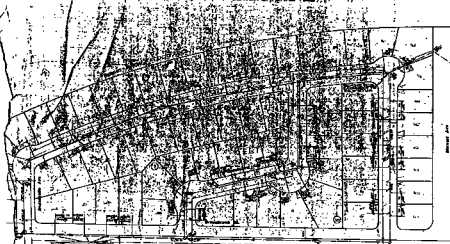

SEWER LATERAL, MANHOLE
 ORIFICATION



Scale 1" = 10'

SEWER LATERAL, UNIT #10
 SEWER LATERAL, UNIT #10

SEWER LATERAL, UNIT #10

SEWER LATERAL, UNIT #10