



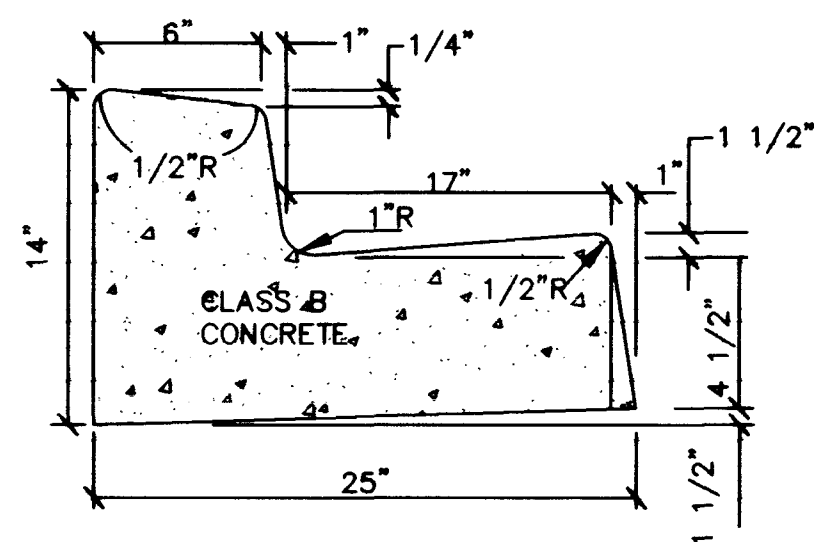


8" TYPE "L" CURB

NTS 1
D1

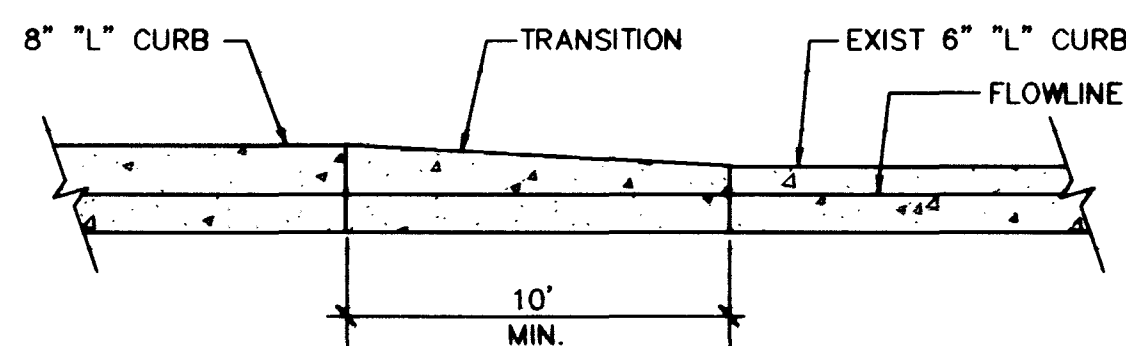


6" "L" CURB TO 8" "L" CURB
TRANSITION

NTS 3
D1

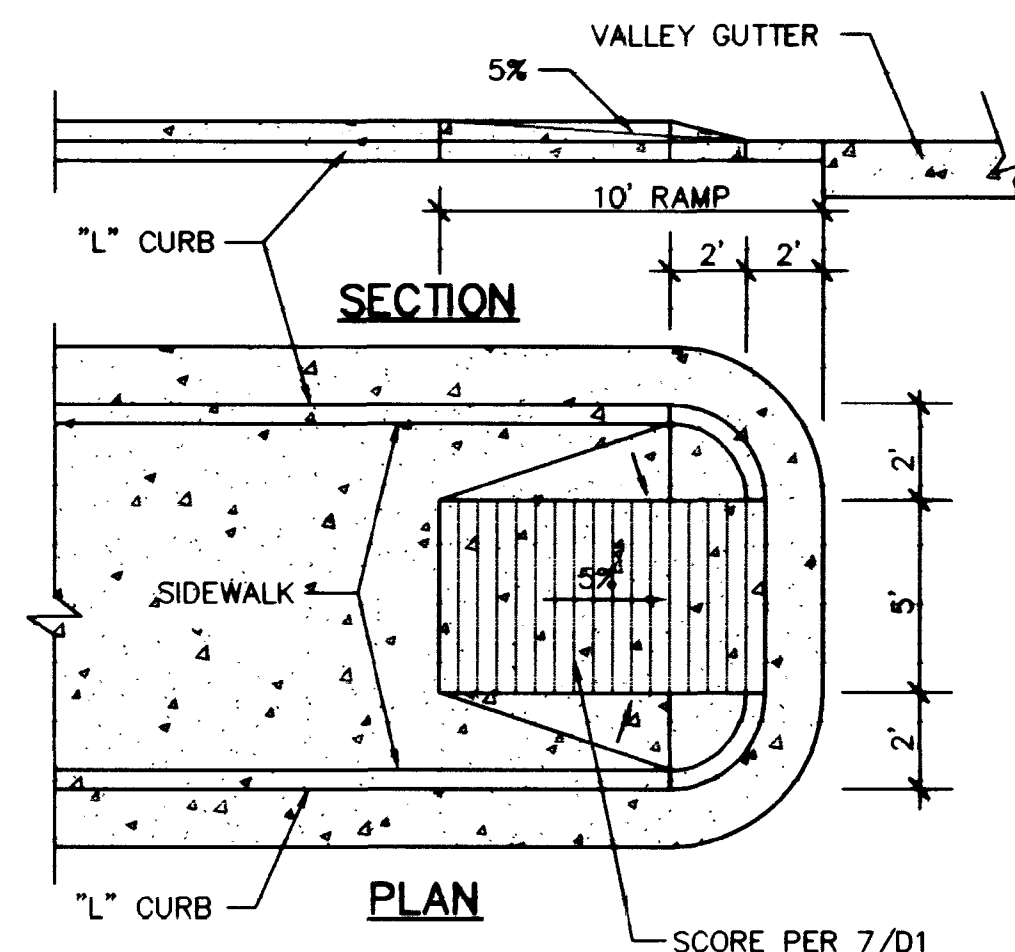


SIDEWALK RAMP

NTS 6
D1

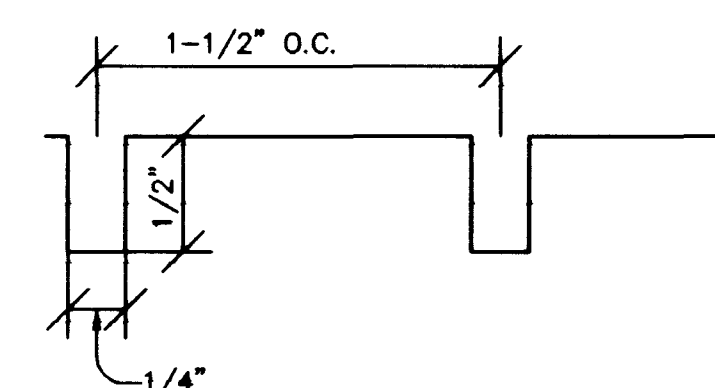


SCORE DETAIL

NTS 7
D1

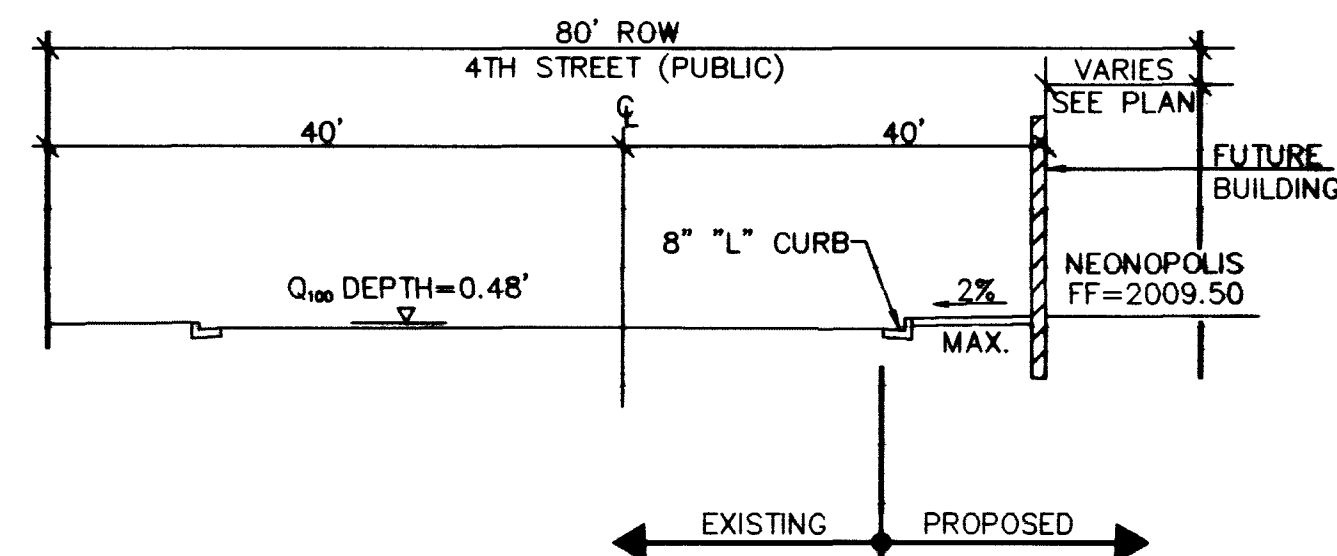


4TH STREET (PUBLIC)

NTS 8
D1

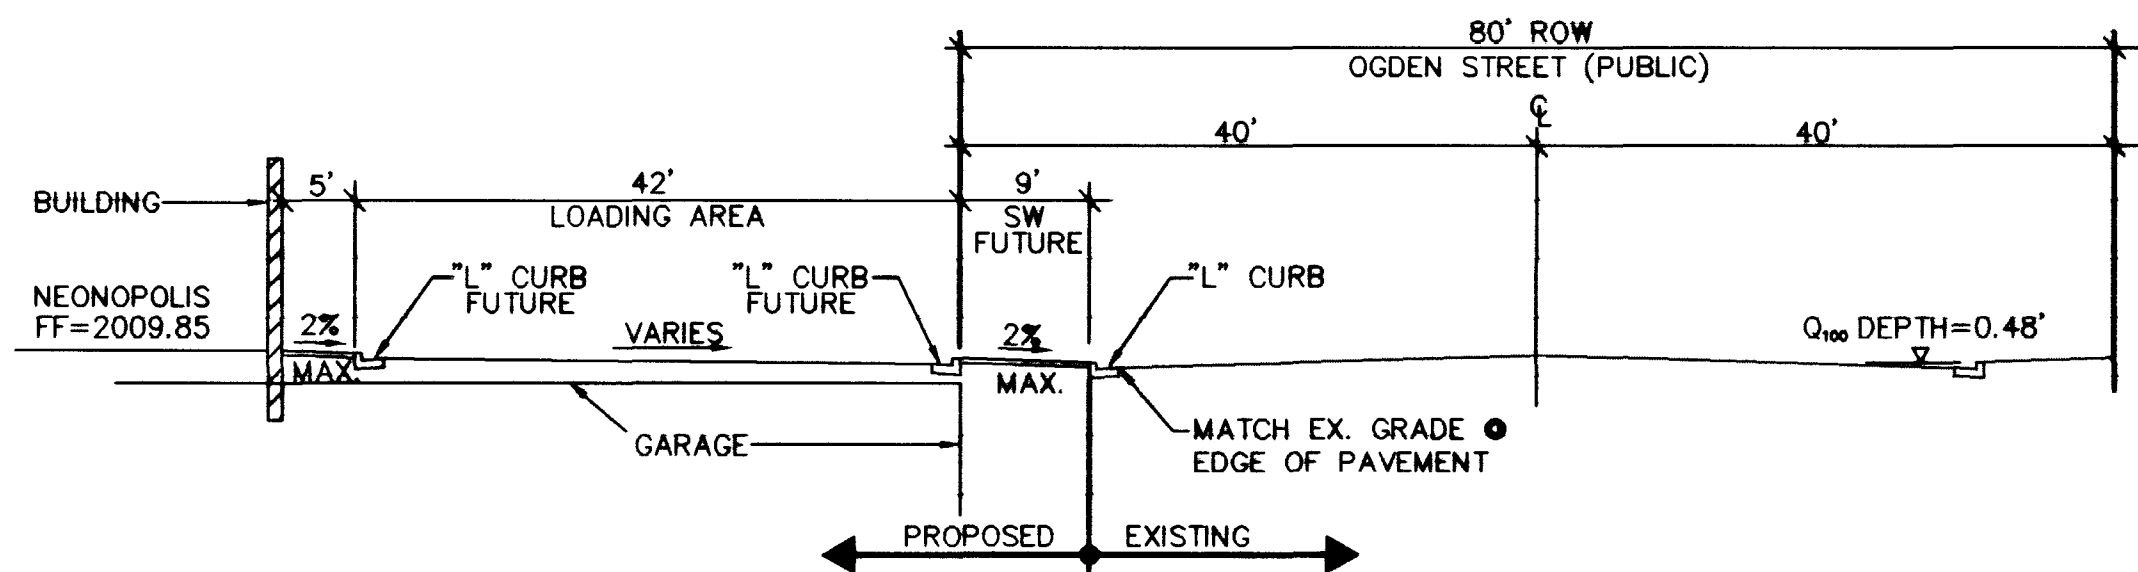

OGDEN STREET (PUBLIC)

NTS 9
D1

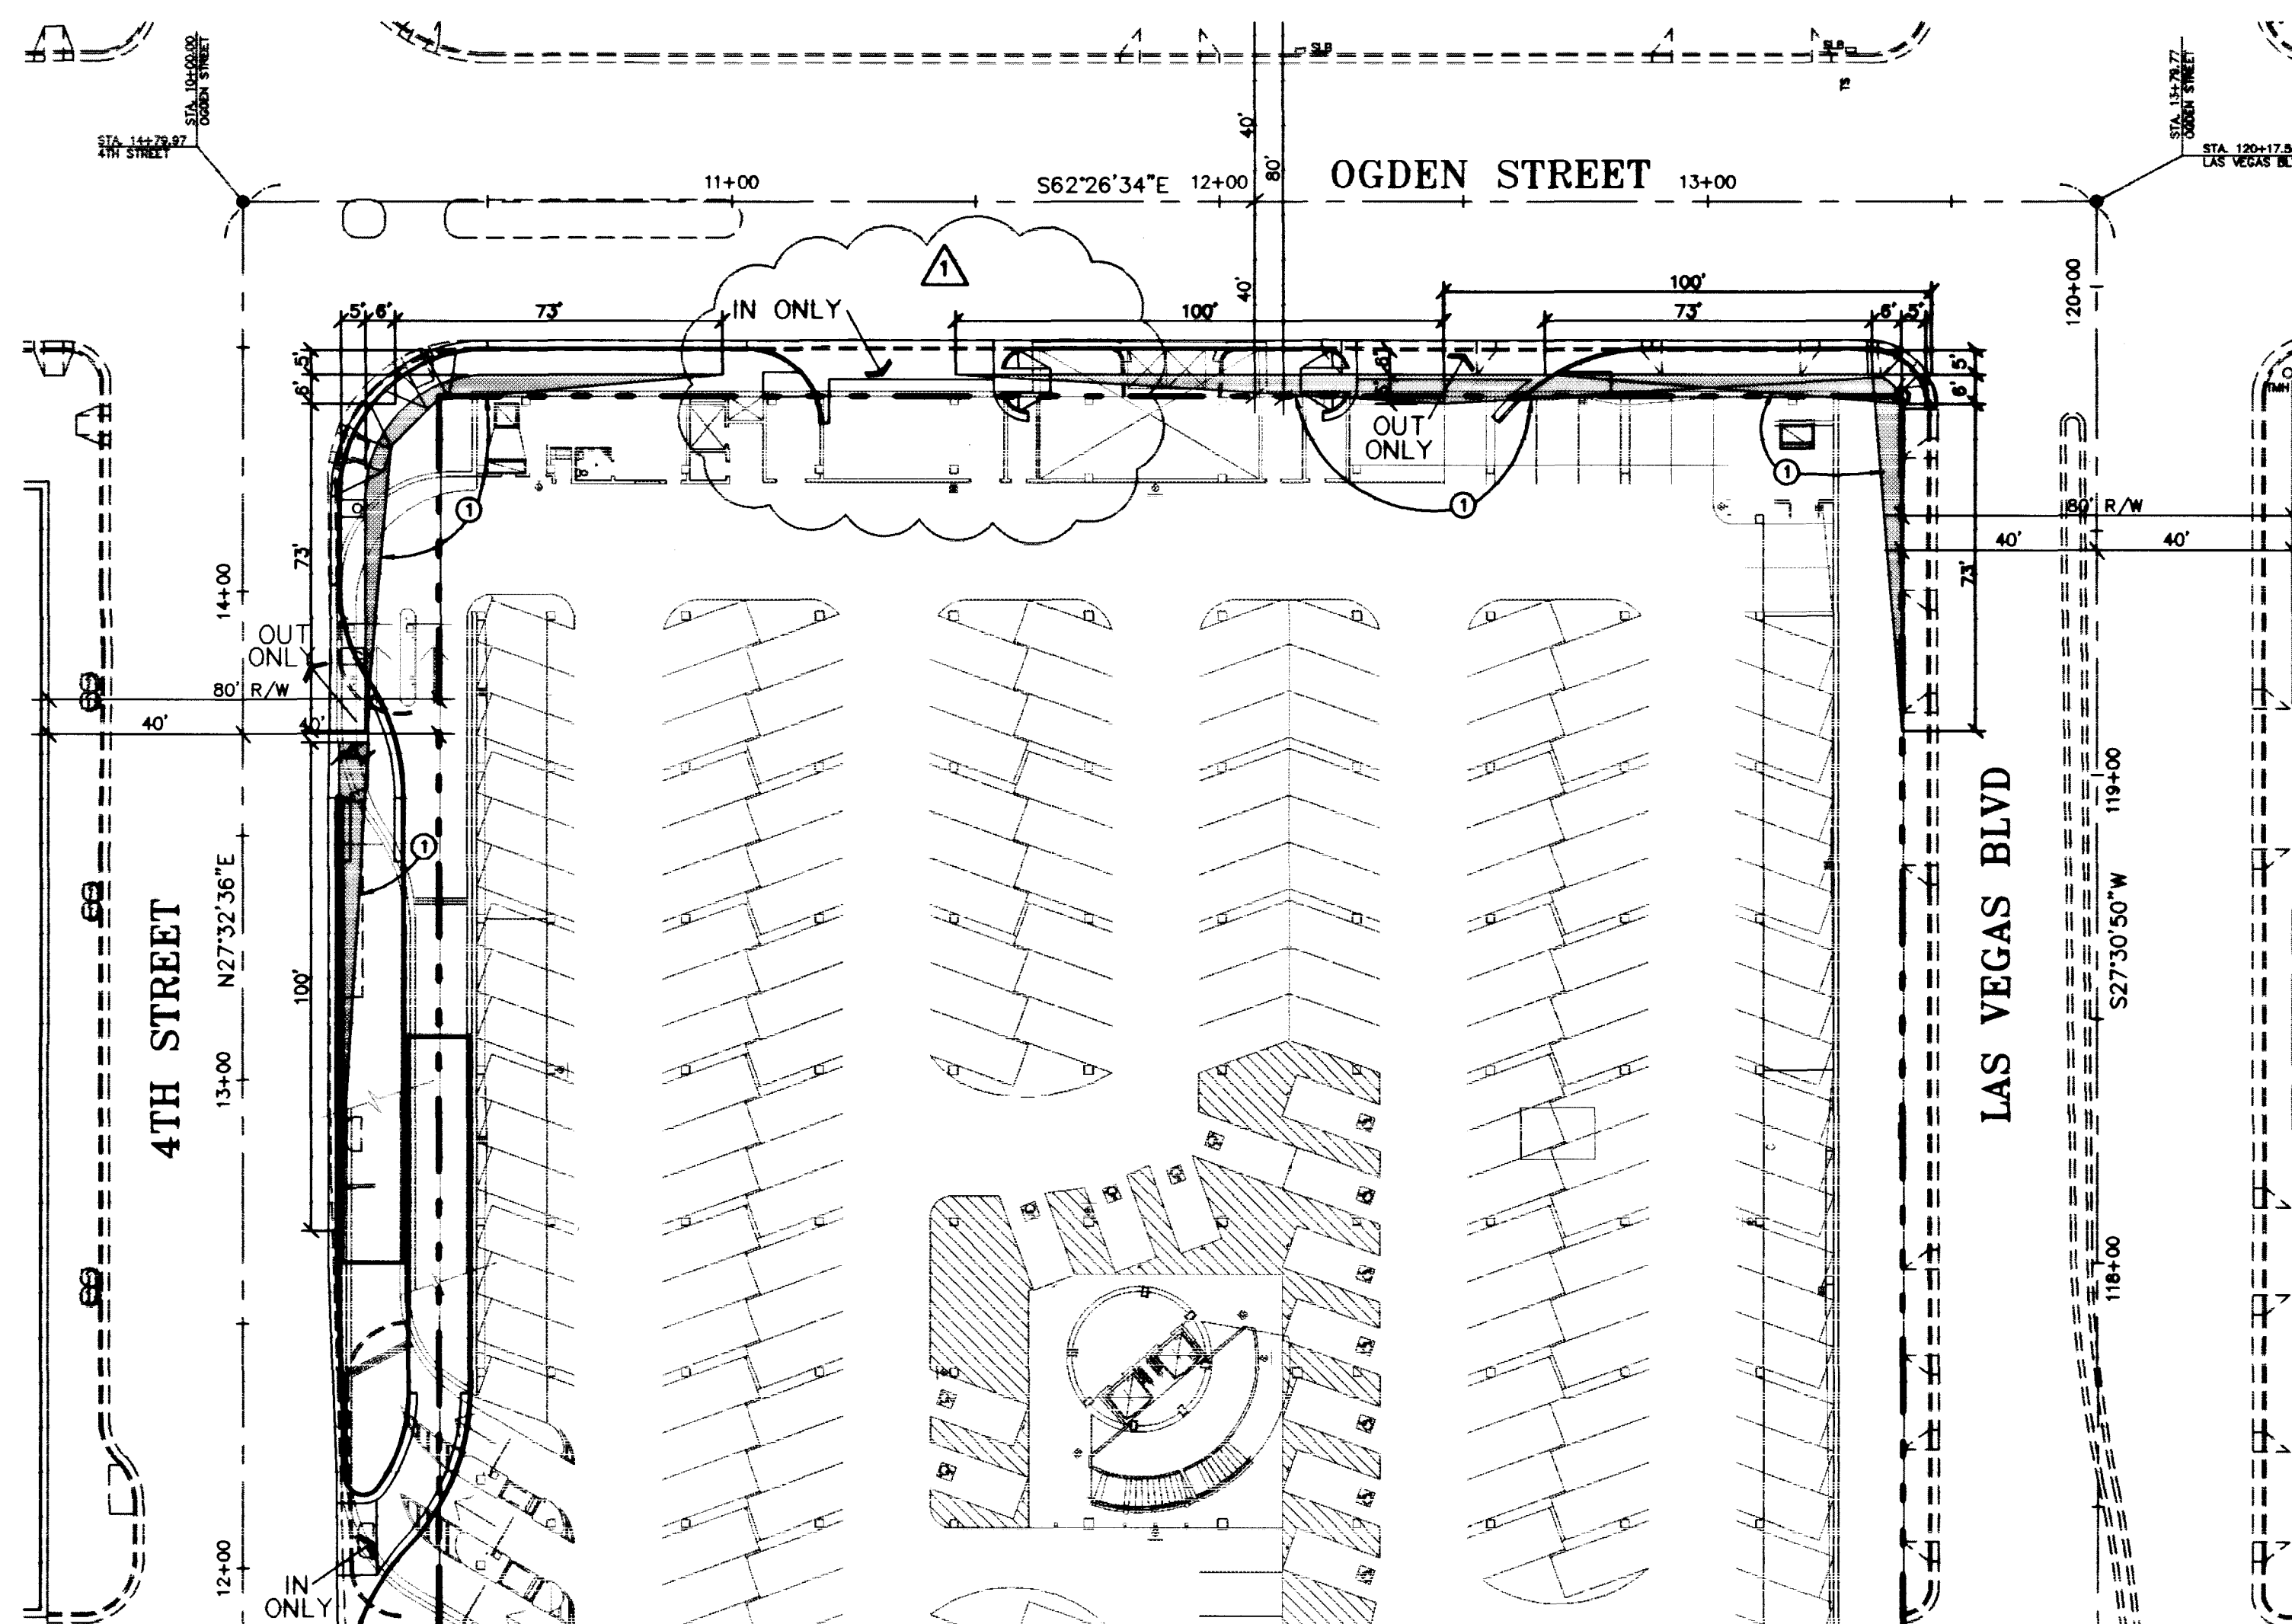

SIGHT DISTANCE


SCALE 1" = 30'

10
D1

① INTERSECTION SIGHT VISIBILITY ZONE:
NO WALLS, FENCES, TREES, SHRUBS, UTILITY
APPURTENANCES OR ANY OTHER OBJECT, OTHER
THAN TRAFFIC CONTROL DEVICES AND STREET LIGHT
POLES, MAY BE CONSTRUCTED OR INSTALLED WITHIN
THE SIGHT VISIBILITY ZONE UNLESS SAID OBJECT IS
MAINTAINED AT LESS THAN 24 INCHES IN HEIGHT,
MEASURED FROM THE TOP OF CURB, OR WHERE NO
CURB EXISTS, A HEIGHT OF 27 INCHES MEASURED
FROM TOP OF ADJACENT ASPHALT, GRAVEL OR
PAVEMENT STREET SURFACE.

ISSUED FOR BIDDING 12-30-98

PLAN CHECK REVISIONS 12-28-98

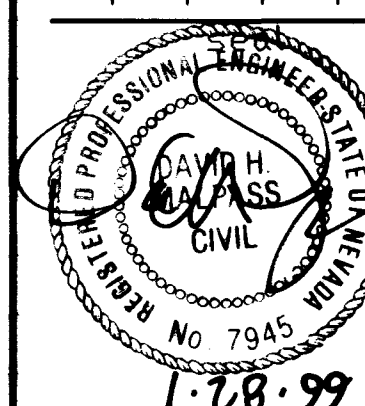

1-28-99
sheet

D1

SHEET 9 OF 9

drawing number
107-V3037

DETAIL SHEET

Sheet

date 12-30-98

job number 1671.00

design by J. BETTENCOURT

drawn by V. WINFORD

checked by D. MALPASS, P.E.

title

GARAGE PLANS FOR

NEONOPOLIS

@ FREMONT STREET EXPERIENCE

MARTIN & MARTIN

CIVIL ENGINEERS

2101 SOUTH JONES BLVD., SUITE A

LAS VEGAS, NEVADA 89146

PHONE (702) 248-8000

WORLD ENTERTAINMENT CENTERS

LAS VEGAS, INC.

233 SOUTH FOURTH STREET, SUITE 201

LAS VEGAS, NEVADA 89101

PHONE (702) 477-9470

REVISIONS

no

description of revisions

date

name

1-18-99

JB

REVISE DRIVEWAY. ADD STORM DRAIN



N^o TYPE "L" CURVE



S⁺ "L" CURVE TO S⁺ "L" CURVE TRANSITION



STOWWALK RAMP




SACRAMENTO DISTRICT.



4TH STUDENT (PUBLIC)



OSWEN STREET (PUBLIC)

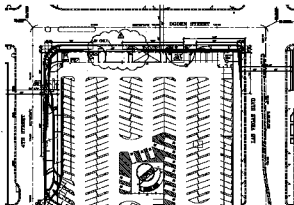

WINDY DISTANCE

