


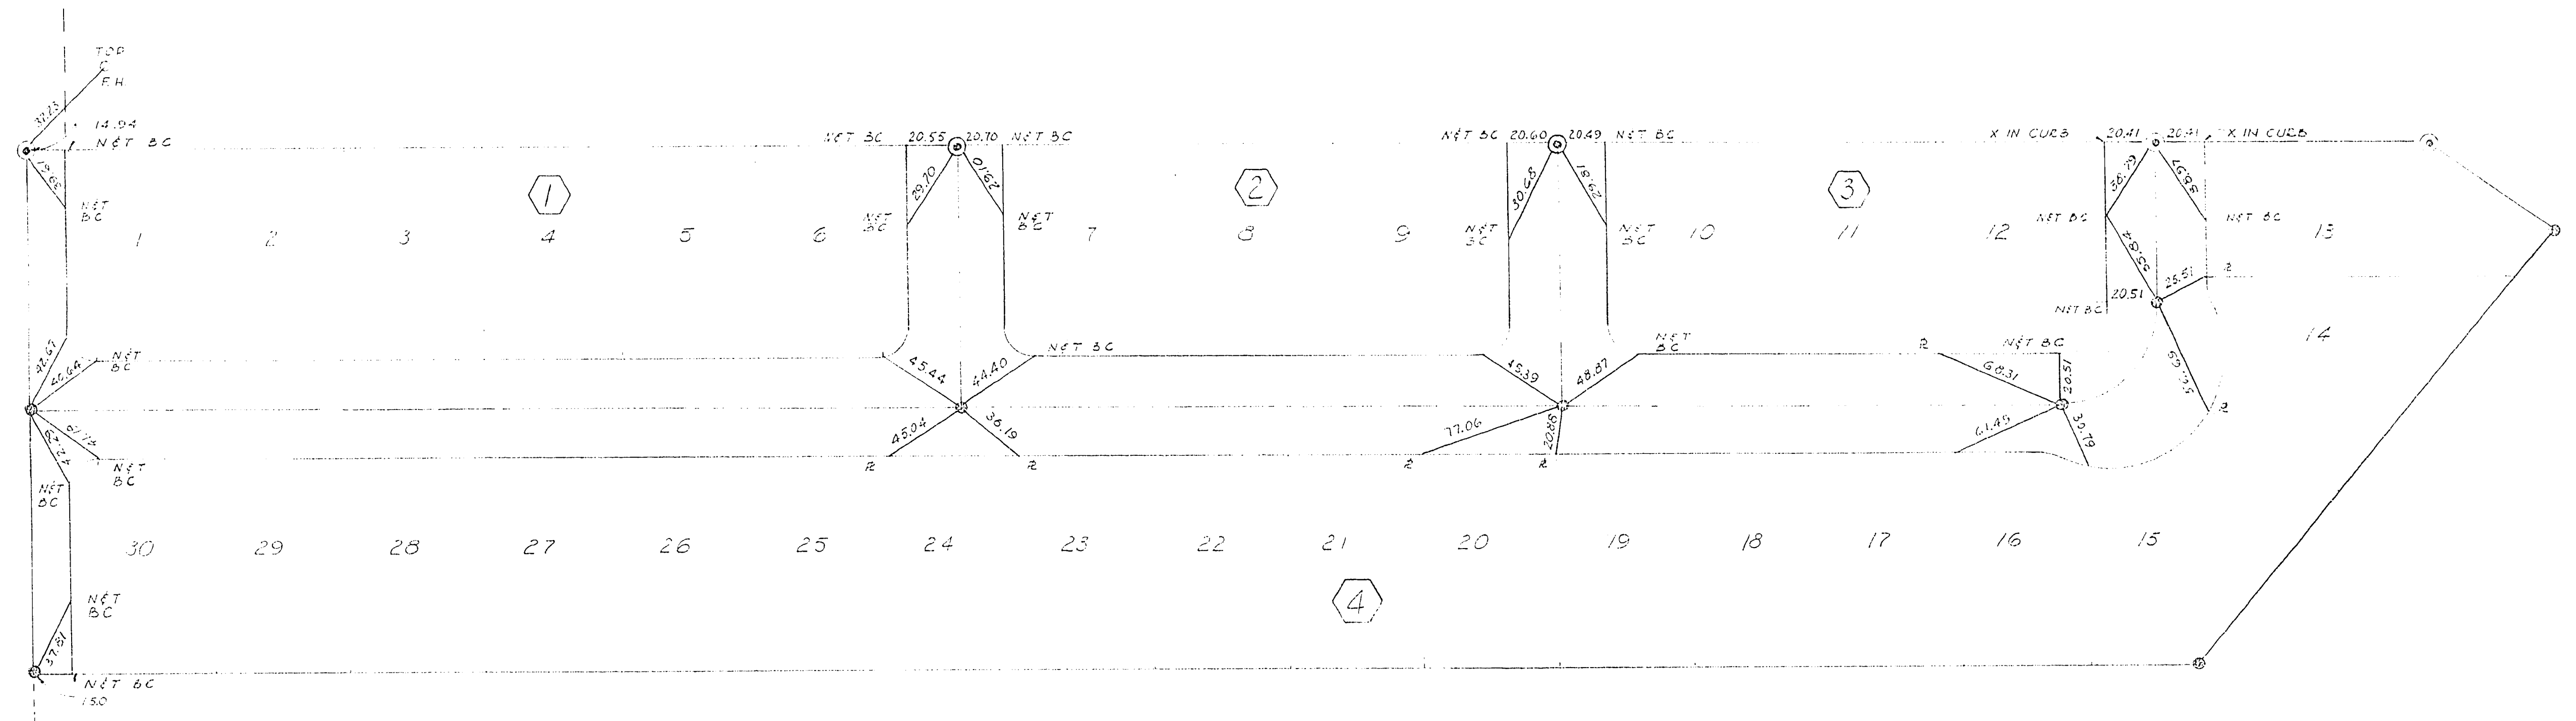

SCALE: 1" = 50'

LEGEND

- 3 STREET NUMBER
- 4 BLOCK NUMBER
- ⊙ MONUMENT FOUND
- ⊗ CONC. MONUMENT SET


058-1540-3

MONUMENT MAP	
GLEN HEATHER ESTATES	
UNIT No. 3	
POR. OF SW 1/4, SEC. 4, T.21 S., R.61 E., M.D.B. & M. CITY OF LAS VEGAS, COUNTY OF CLARK, STATE OF NEVADA	
DESIGNED	WESTERN ENGINEERS, INC.
DRAWN JL	LAS VEGAS NEVADA
CHECKED	APPROVED <i>[Signature]</i> DATE 11/1/62

SHEET 1
OF 1

058-1540-3

4-6-66

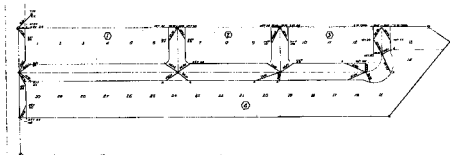

LEGEND

- ① Entry House
- ② Store House
- ③ Workshop
- ④ Camp, Mess Hall, etc.

HONOLULU MAP
 GLEN HEATHER ESTATES
 UNIT No. 3
 MAP OF THE GLEN HEATHER ESTATES
 SHOWING THE LOCATION OF THE
 GLEN HEATHER ESTATES
 MAP No. 3
 MAP OF THE GLEN HEATHER ESTATES
 SHOWING THE LOCATION OF THE
 GLEN HEATHER ESTATES