



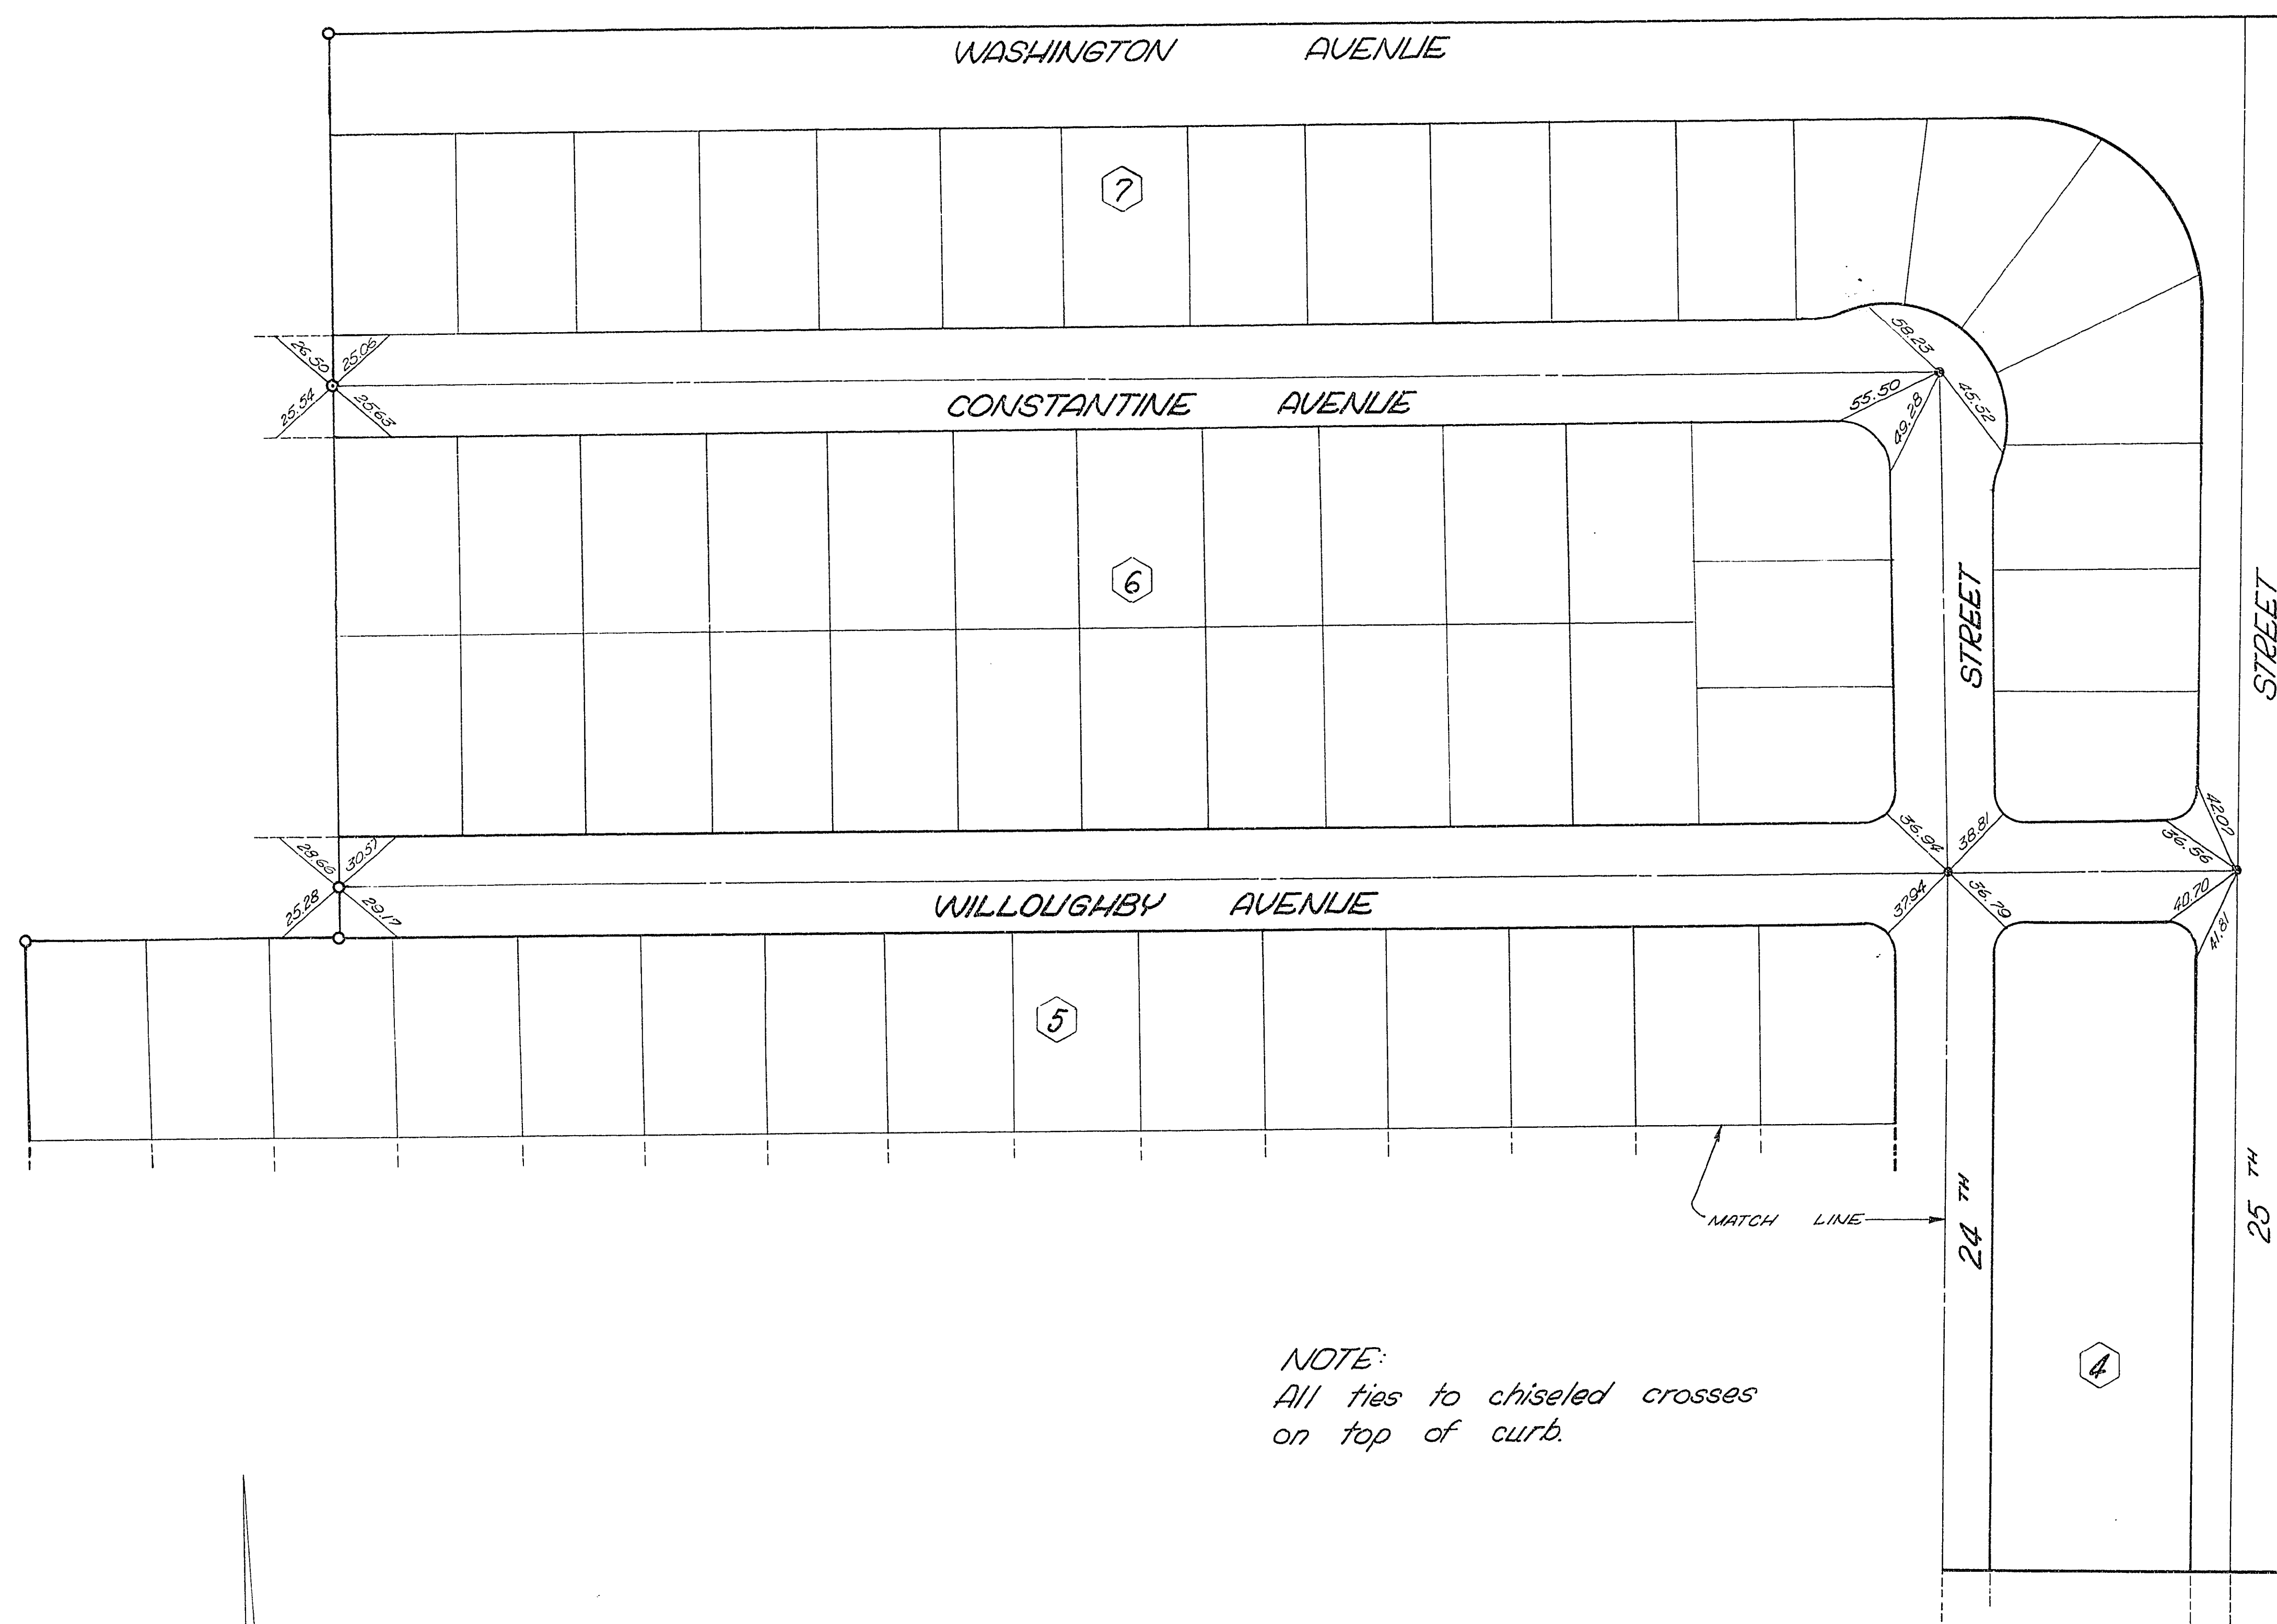

NOTE:
All ties to chiseled crosses
on top of curb.

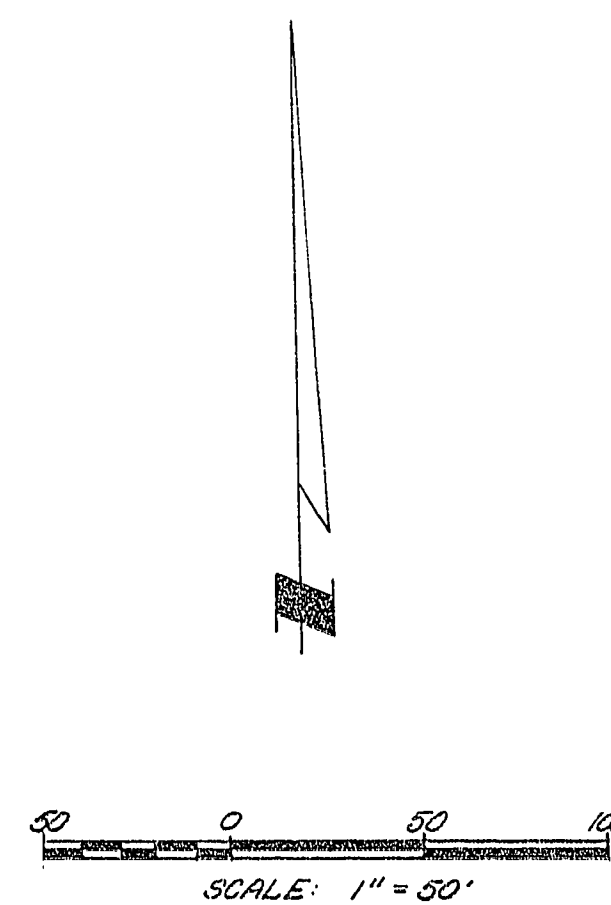

GREATER LAS VEGAS ADDITION 3, UNIT 4		
MONUMENT MAP		
DESIGNED	WESTERN ENGINEERS, INC.	SHEET 1
DRAWN Pmb	LAS VEGAS, NEVADA	OF 2
CHECKED	APPROVED <i>[Signature]</i> DATE 11/16/63	

058-1640-3-4
11-6-60
12/2