


# JUBILEE TRACT

BEING A SUBDIVISION OF A PORTION OF THE W 1/4 OF  
GOVERNMENT LOT 4 SECTION 1, T21S, R61E, M.D.B.E.M.  
CITY OF LAS VEGAS - CLARK COUNTY - NEVADA

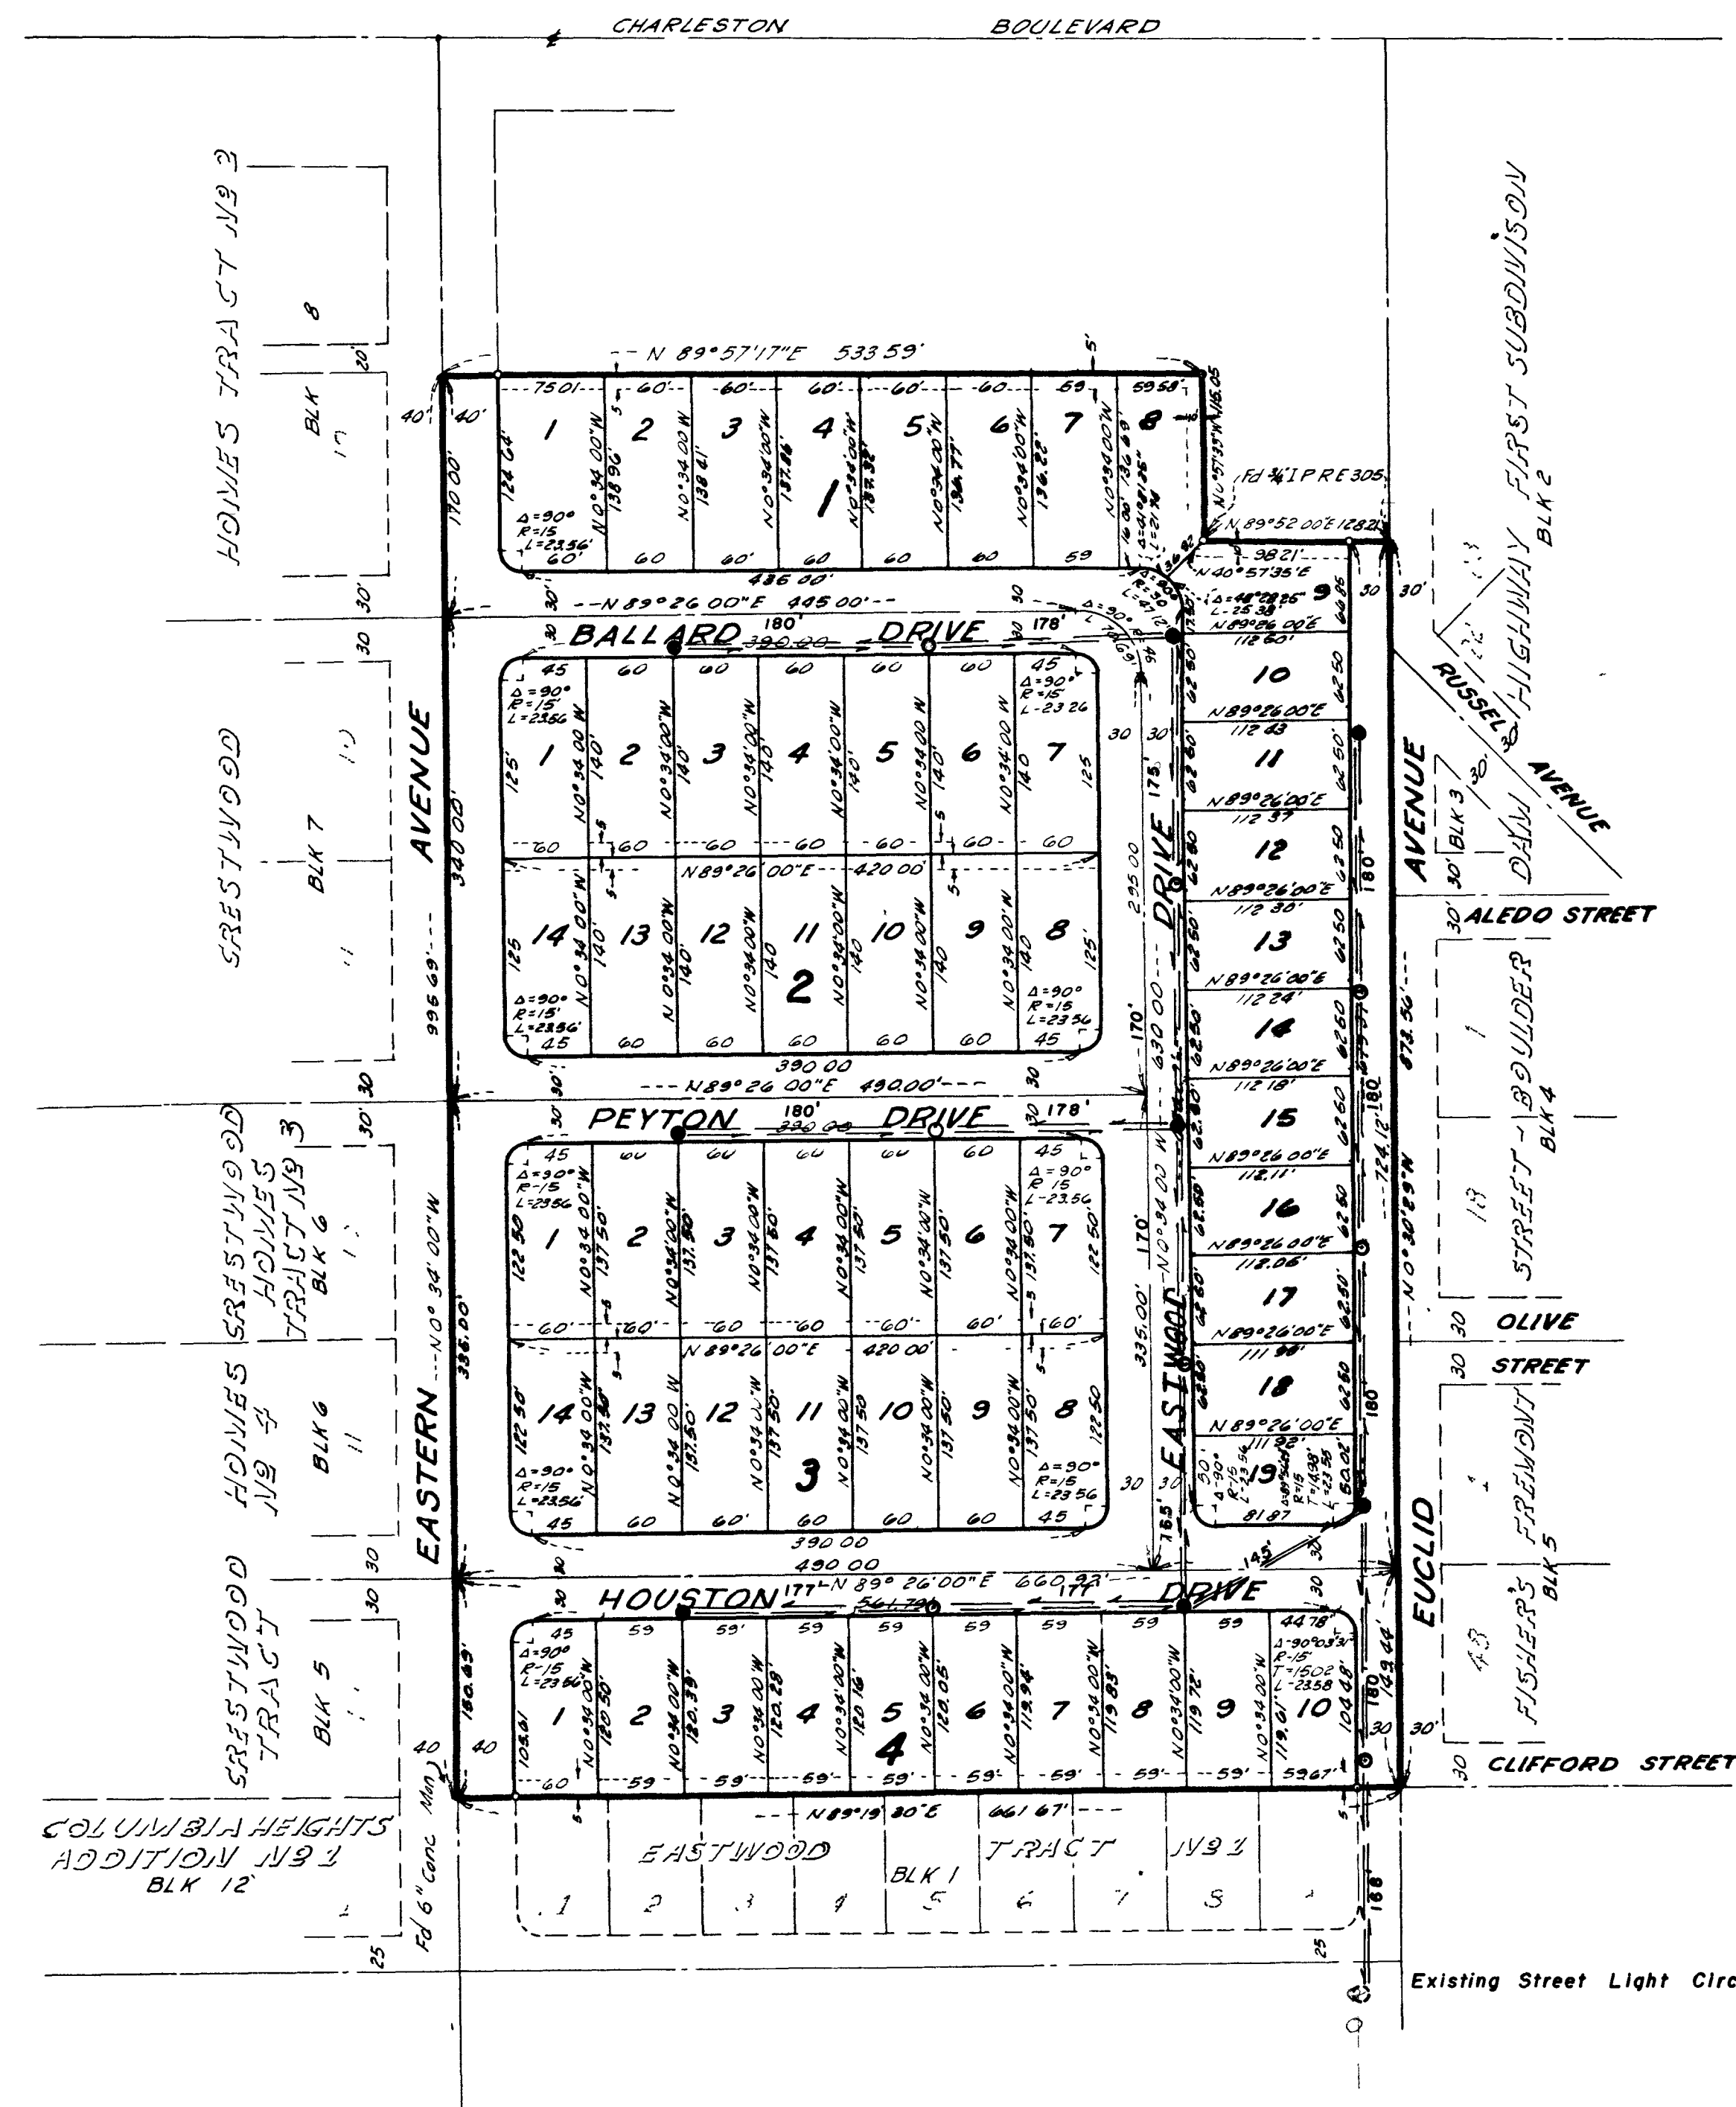

## STREET LIGHTING

### SPECIFICATION -

Lighting standard shall be Union Metal design H-300-B1, design #400 or approved equal.  
Luminaire shall be Line Material Co., Catalog No.-603800-C628 with 1-1/4" slip fitter,  
or approved equal with 2500 lumen lamp, 6.6 group replacement.  
Luminaire shall be Type III distribution.  
Wire shall be No. 6 bare, medium-hard drawn.  
Wire from overhead line to luminaire shall be No. 8 - type R.R. - 5000 volt.  
Maximum pole spacing - 180 feet.

### LEGEND -

- 3" Gage pole 5
- 1 1/2" Gage pole 5
- == Overhead line 5600'

### APPROVED -

*[Signature]* 3/15/54  
City Engineer Date  
*[Signature]* 3/15/54  
City Electrician Date

**AS BUILT**


PREPARED BY  
**KARSTEN T. BRONKEN**  
CONSULTING ENGINEER  
LAS VEGAS NEVADA

C-4-14

16-7-6 207Y-1880-1

# JUBILEE TRACT.

BEING A SUBDIVISION OF A PORTION OF THE E. 1/4 OF  
SECTION 16, T. 24 S., R. 24 E., NEBRASKA  
CITY OF LAS VEGAS - CLARK COUNTY - NEVADA

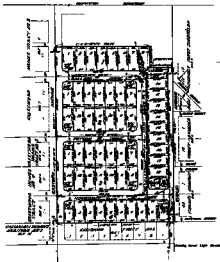

## STREET LIGHTING

### SPECIFICATION-

Lighting system shall be 150 Watt High Pressure Sodium Vapor (HPSV) or equivalent and  
capable of being changed to, without re-connection of the main line, to 100 Watt  
or smaller, and 100 Watt High Pressure Sodium Vapor (HPSV) or equivalent,  
capable and so set as to operate  
any one or all of the following items:  
The first connected to the system shall be the 150 Watt HPSV or equivalent  
The second 100 Watt HPSV or equivalent

### COMMENTS

- 1. 150 Watt HPSV
- 2. 100 Watt HPSV

### APPROVED

*[Signature]*  
*[Signature]*

## AS BUILT

RECORD OF  
MARTIN T. BARNETT  
REGISTRATION NUMBER  
100 1000 1000