


JUBILEE TRACT

BEING A SUBDIVISION OF A PORTION OF THE N 1/4 OF
GOVERNMENT LOT 4 SECTION 1, T21S, R61E, M.R.B.M.
CITY OF LAS VEGAS - CLARK COUNTY - NEVADA

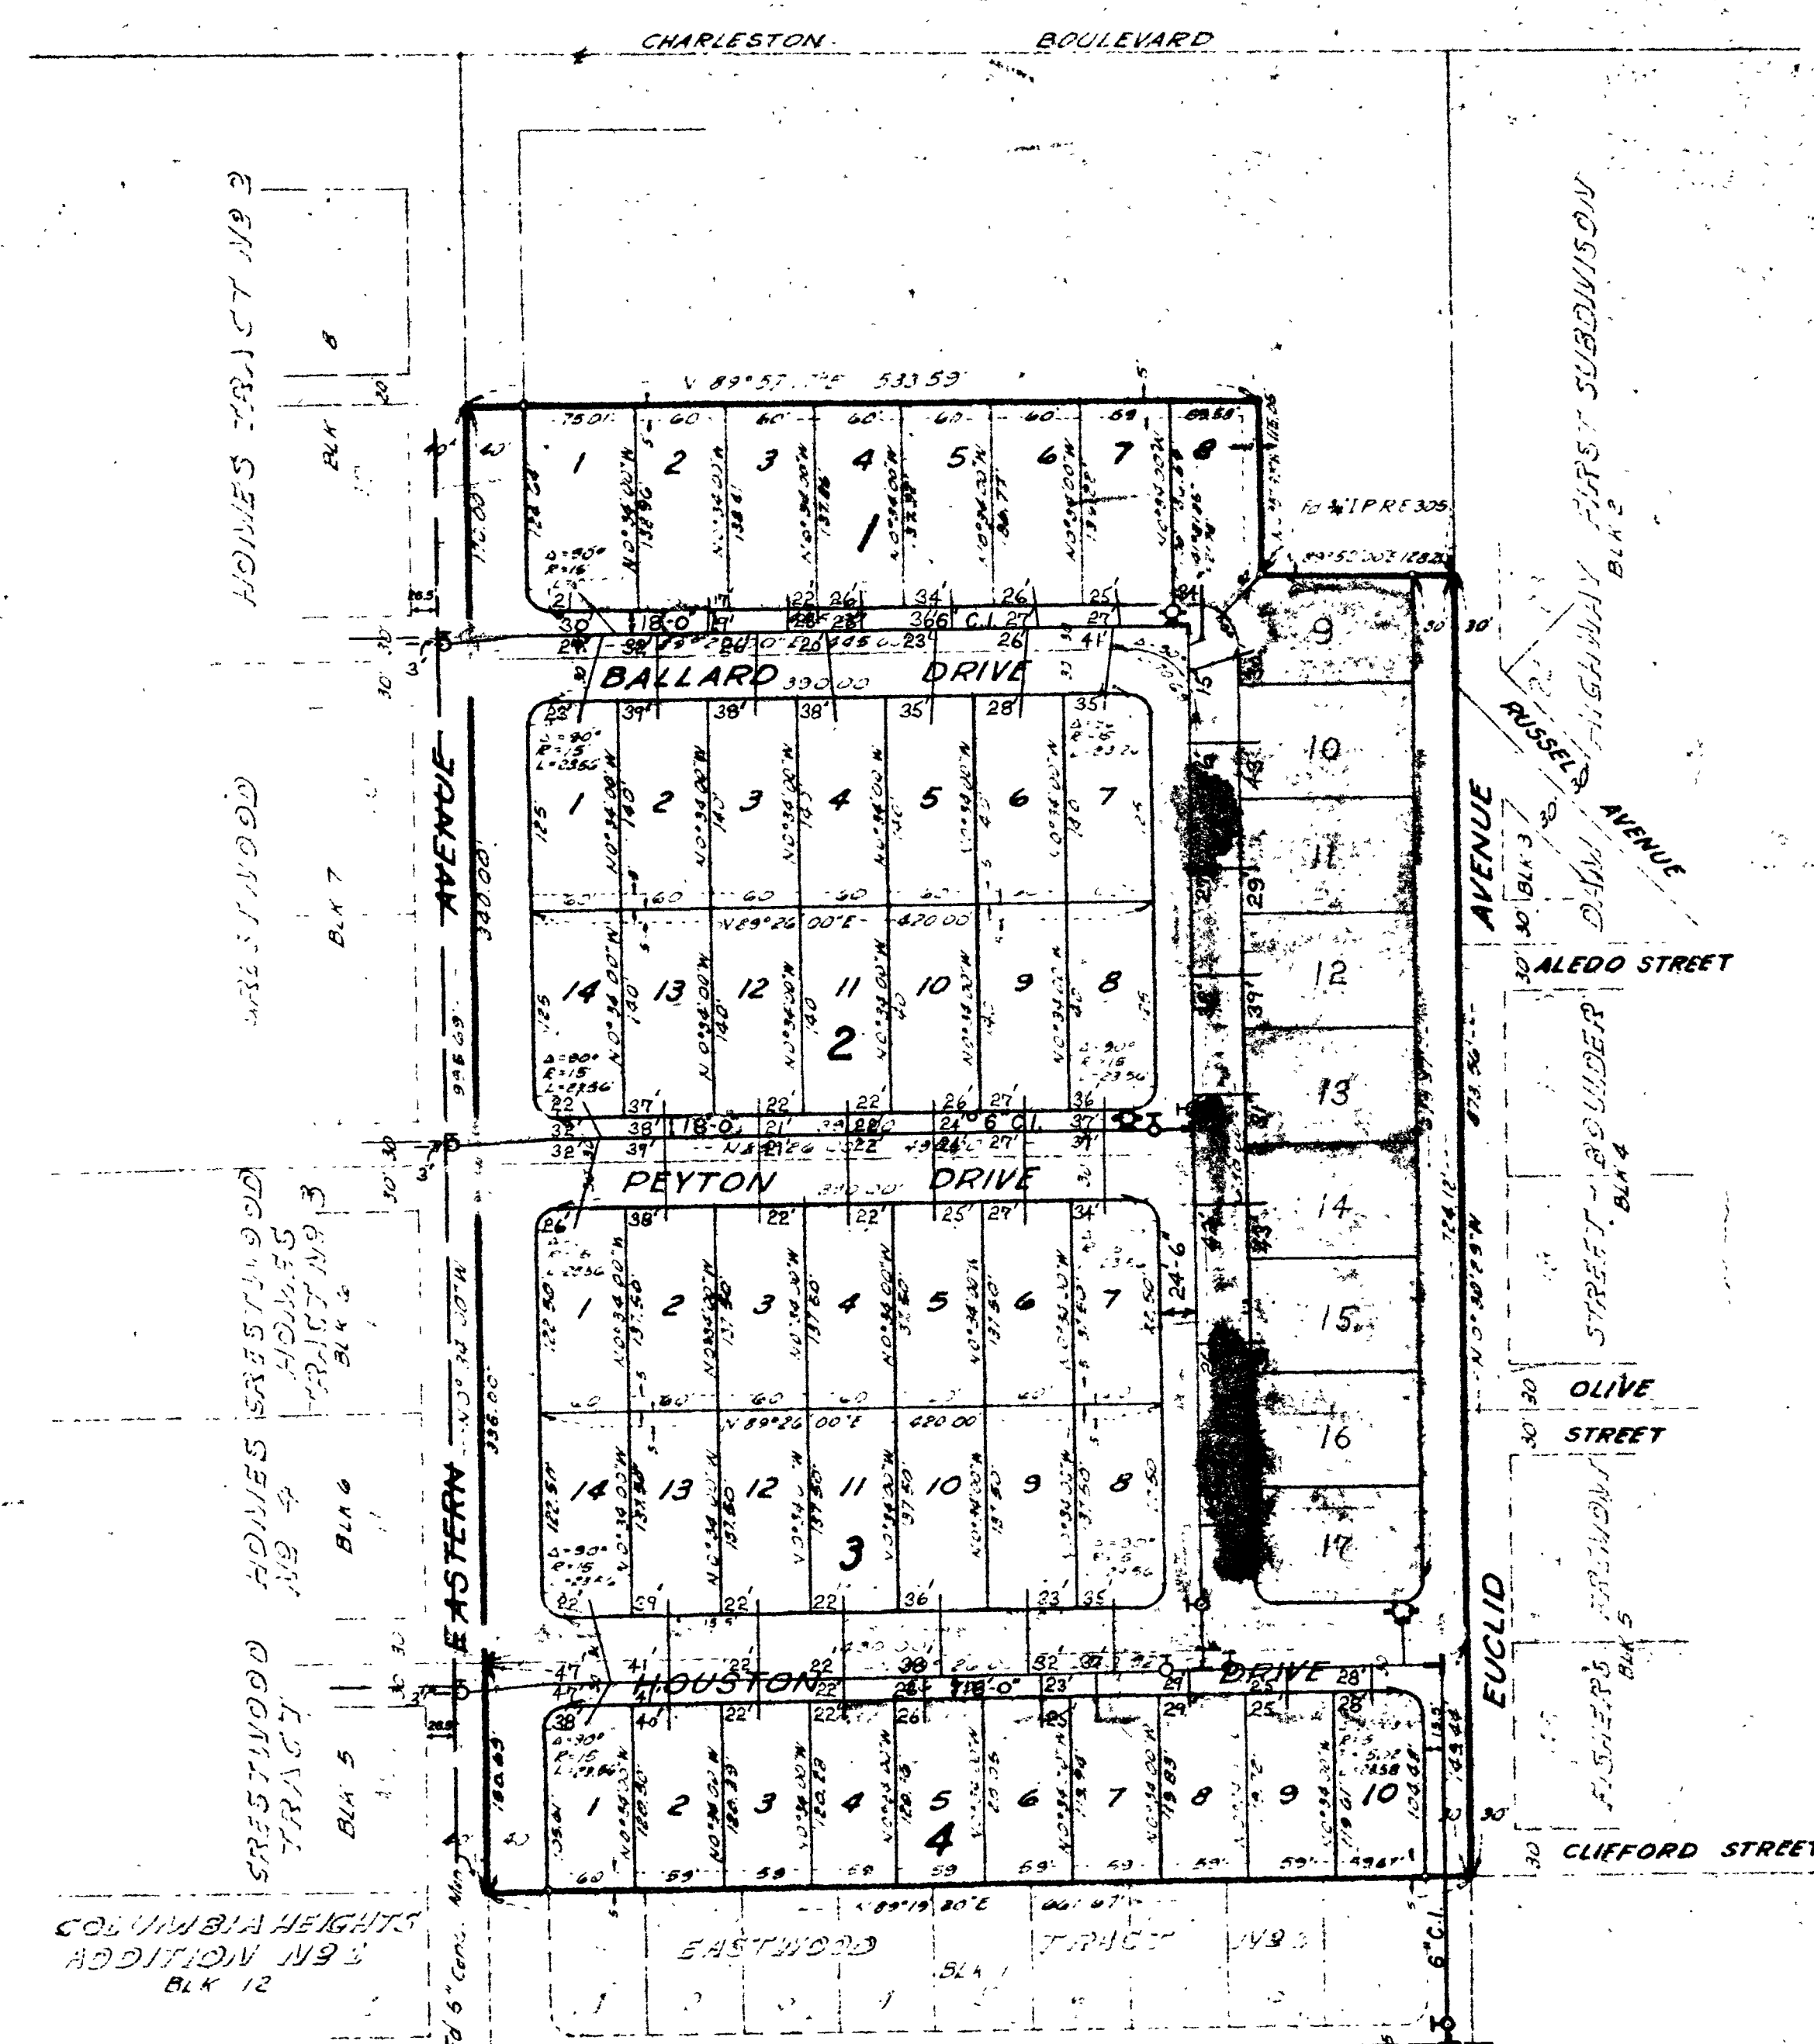

FIRE HYDRANT LOCATION

AS BUILT PLAN-WATER SYSTEM

APPROVAL:

[Signature] 3/17/54
City Engineer Date

[Signature] 3/17/54
Fire Chief Date


APPROVAL:

Las Vegas Land and Water Co. 3/17/54
Date

LEGEND:


- 6" C.I. Water line
- Existing Water line
- ⊗ Valve
- ⊕ Tee
- ⬢ Fire Hydrant

Note: All service connection measurements are from property lines

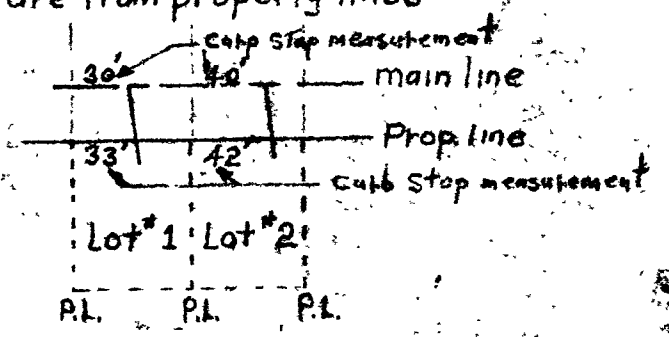

JUBILEE TRACK

ISSUED A SUBPOENA OF A PORTION OF THE INFO OF
GOVERNMENT 1014, SECTION 1, INFO, MEMPHIS
CITY OF LOS ANGELES - CLARK COUNTY - ALABAMA

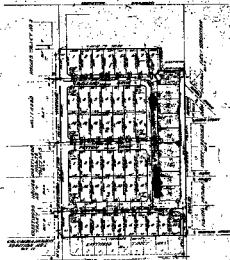

FIRE HYDRANT LOCATION

REFERENCES

John A. Smith

E. P. The ...

AS BUILT
PLAN-WATER SYSTEM

APPROVED FOR RELEASE

Abstract

Company	Officer	Address	Phone
...	...	...	...
...	...	...	...
...	...	...	...
...	...	...	...

Abstract

Figure 1 is a line graph titled "Figure 1: Percentage of respondents reporting a change in their use of a specific substance from 1980 to 1990." The Y-axis is labeled "Percentage of respondents" and ranges from 0 to 100 in increments of 20. The X-axis is labeled "Year" and ranges from 1980 to 1990. There are five data series represented by different line styles: Cocaine (solid line with circles), Heroin (dashed line with squares), Marijuana (solid line with triangles), Alcohol (dashed line with diamonds), and Other (solid line with crosses). Cocaine and Heroin show a sharp increase in the percentage of respondents reporting a change in use, starting around 20% in 1980 and rising to approximately 80% by 1990. Marijuana, Alcohol, and Other show a much more gradual increase, starting around 10% in 1980 and rising to approximately 30% by 1990.

Year	Cocaine	Heroin	Marijuana	Alcohol	Other
1980	20	20	10	10	10
1981	25	25	12	12	12
1982	30	30	15	15	15
1983	35	35	18	18	18
1984	40	40	20	20	20
1985	45	45	22	22	22
1986	50	50	25	25	25
1987	55	55	28	28	28
1988	60	60	30	30	30
1989	65	65	32	32	32
1990	80	80	35	35	35

CONTRACT NO.