



13-13-32

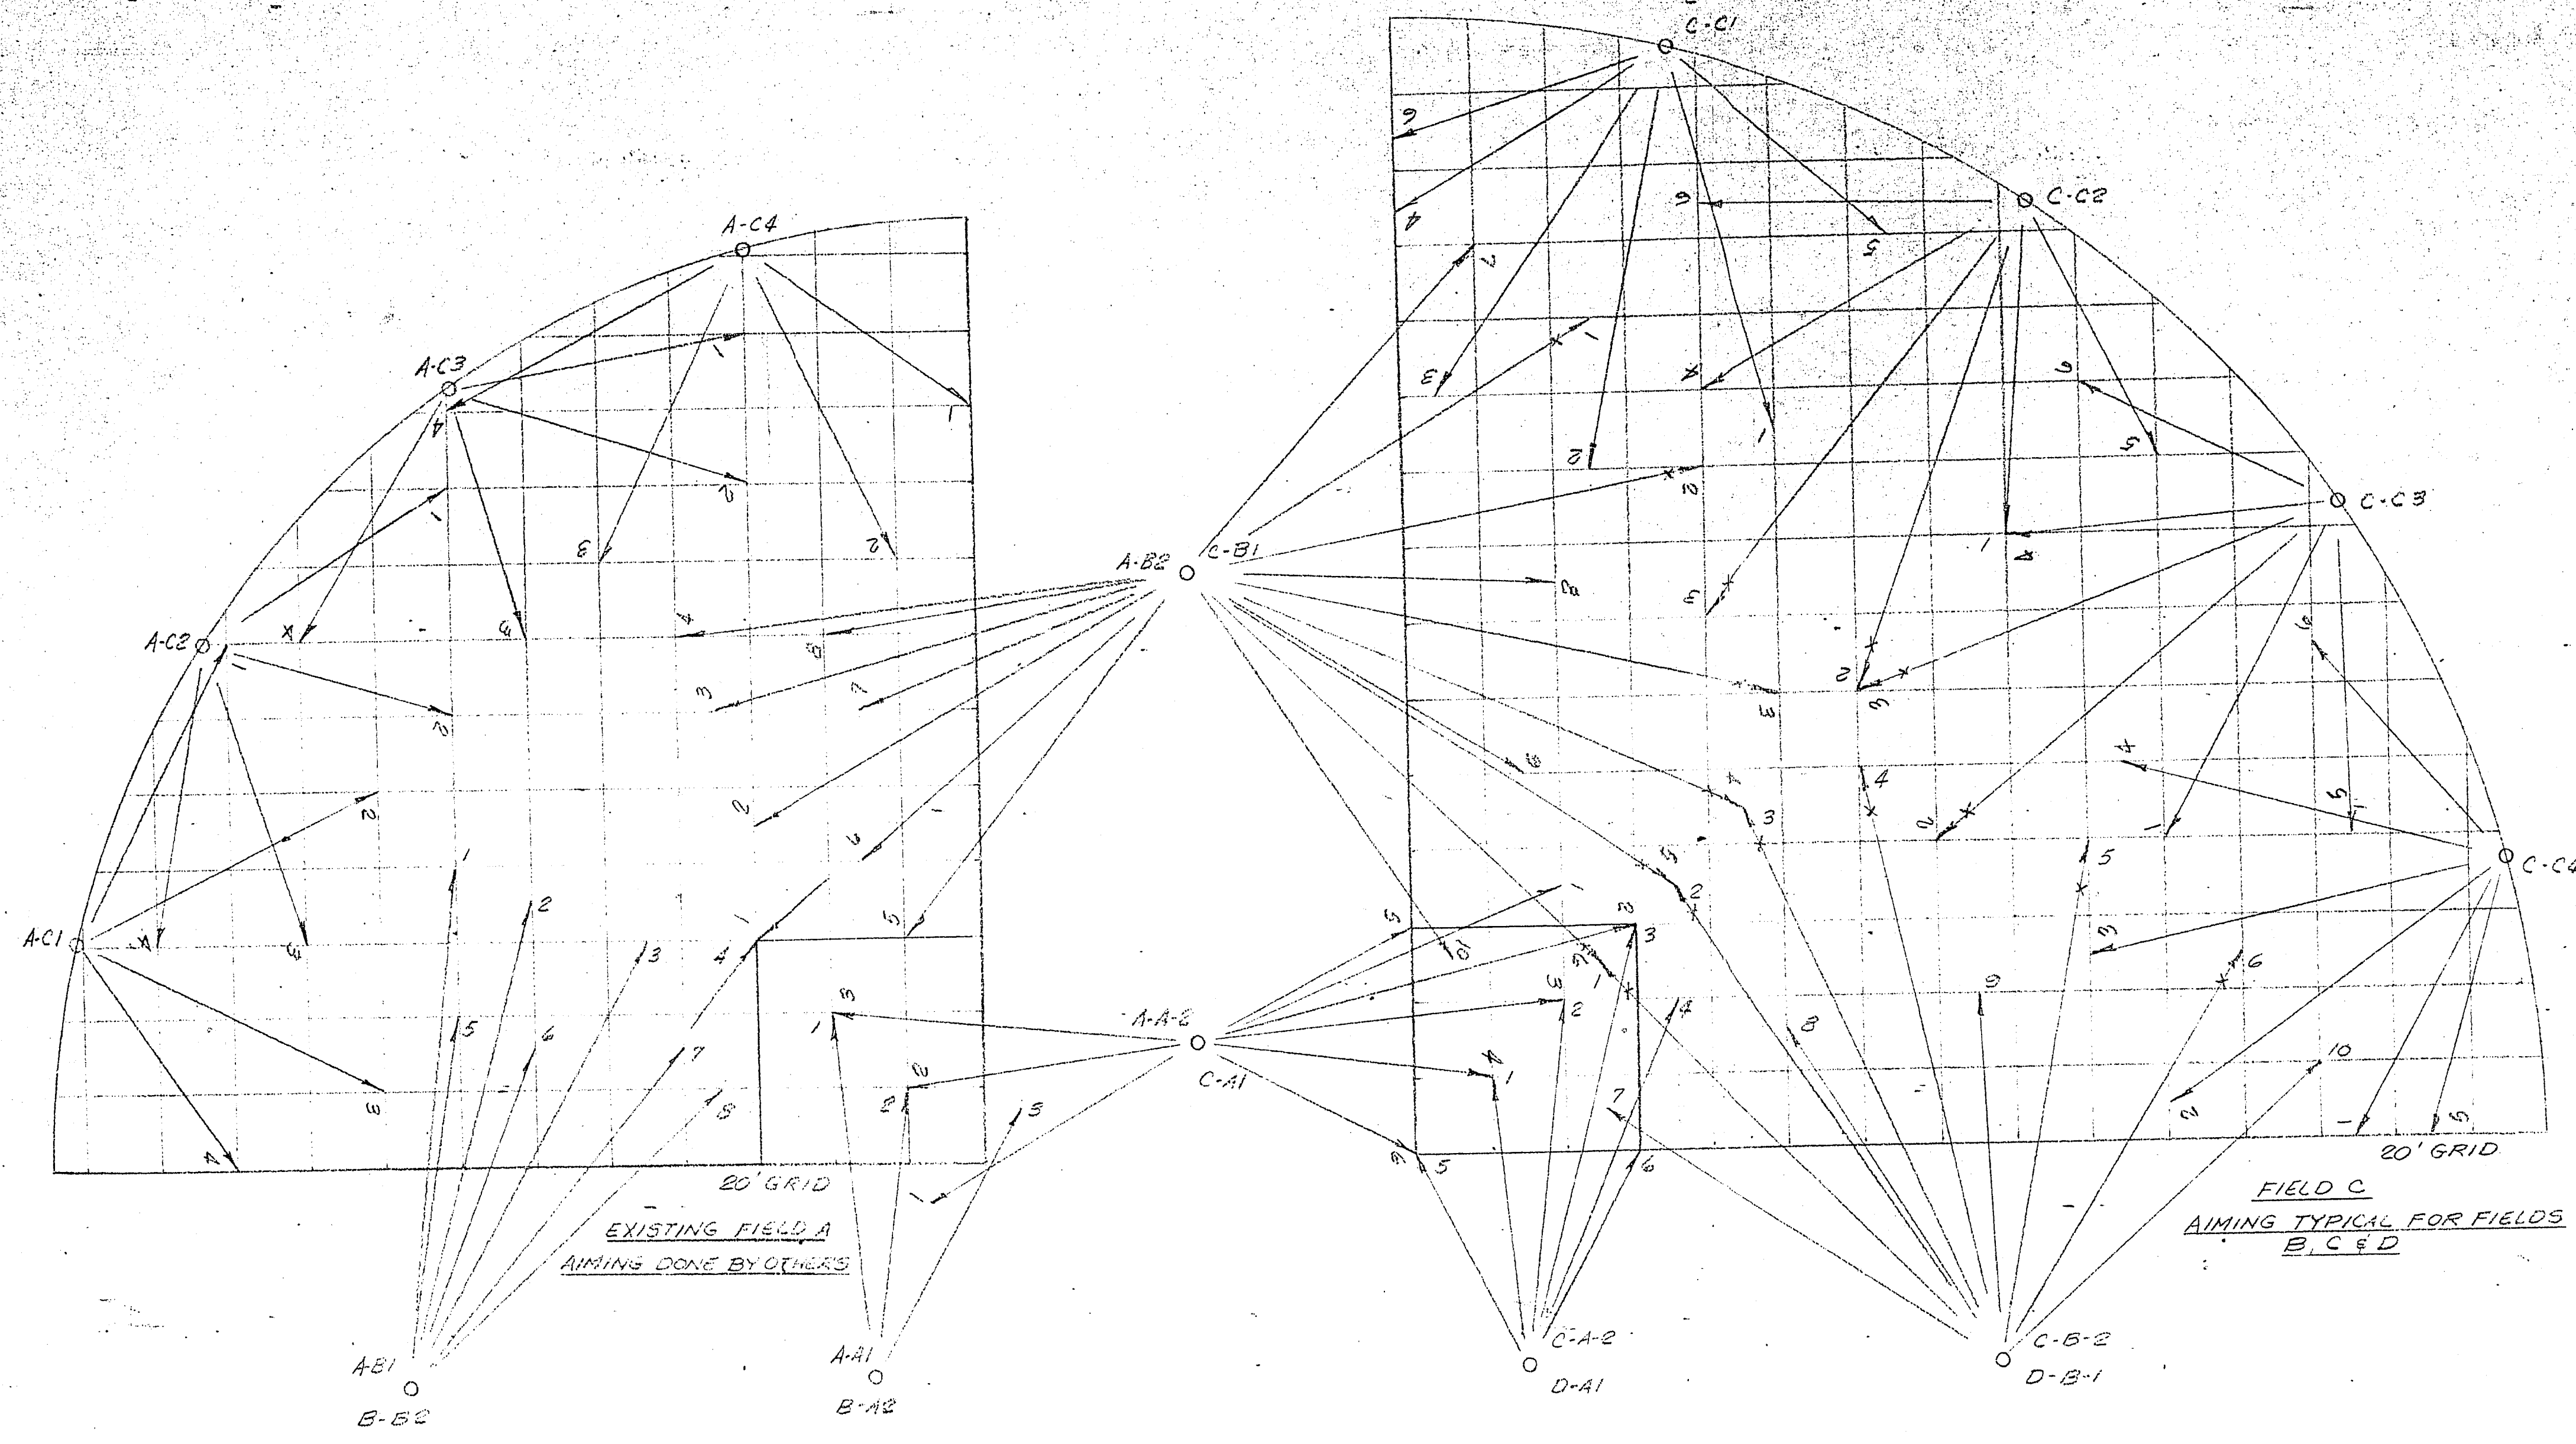

FLOODLIGHT DISTRIBUTION

POLE NO	FLOODS PER POLE	650W
A1, A2	6	6
B1, B2	10	4
C1, C4	6	6
C2, C3	6	4
TOTALS	168	120

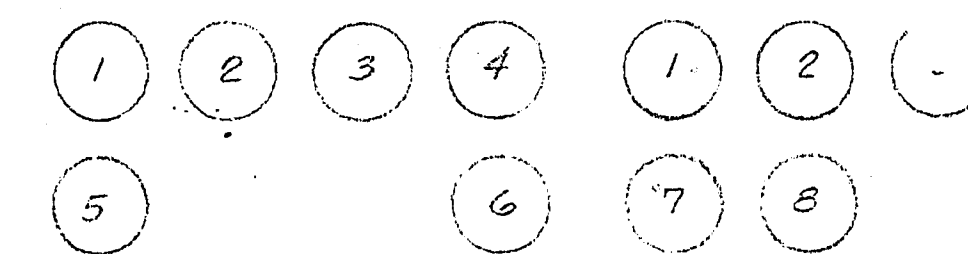

A&C POLES - FIELDS
B, C & D
78'-30' MTG. HGT.

B POLES - FIELDS
B, C & D
78'-80' MTG. HGT.

NOTE - FLOODLIGHT POSITIONS ARE NUMBERED
AS THEY WOULD BE SEEN FROM BEHIND
FACING THE PLAYING FIELD

EQUIPMENT REQUIRED

120" 650W-1500-480H-CFB HEAVY DUTY FLOODLIGHT,
TYPE 3, WITH INTEGRAL 480 VOLT BALLAST,
CROSSARM, BRACKET & CHARCOAL FILTER, FOR A
1500 WATT METAL HALIDE LAMP

48" 640W-1500-480H-CFB FLOODLIGHT, AS ABOVE,
EXCEPT TYPE 4

AIM CENTER OF BEAM AT POINT ON FIELD
INDICATED BY ARROW

AS BUILT

lighting division			
TITLE AIMING PLAN FOR BASEBALL FIELDS B, C & D, LORENZO PARK, LAS VEGAS, NEVADA			
REVISED	DWN	DATE	NO.
		5-15-73	LL-73-356
	APPROV	SCALE	
	JB	1"=30'	

LIGHTING DIVISION HARVEY HUBBELL INC., ELECTRIC WAY, CHRISTIANBURG, VA. 24073

650.19-22 B