

PLAN	DATE
BY	
CHECKED	
NOTE BOOK	
NO.	

PROFILE	DATE
BY	
CHECKED	
NOTE BOOK	
NO.	

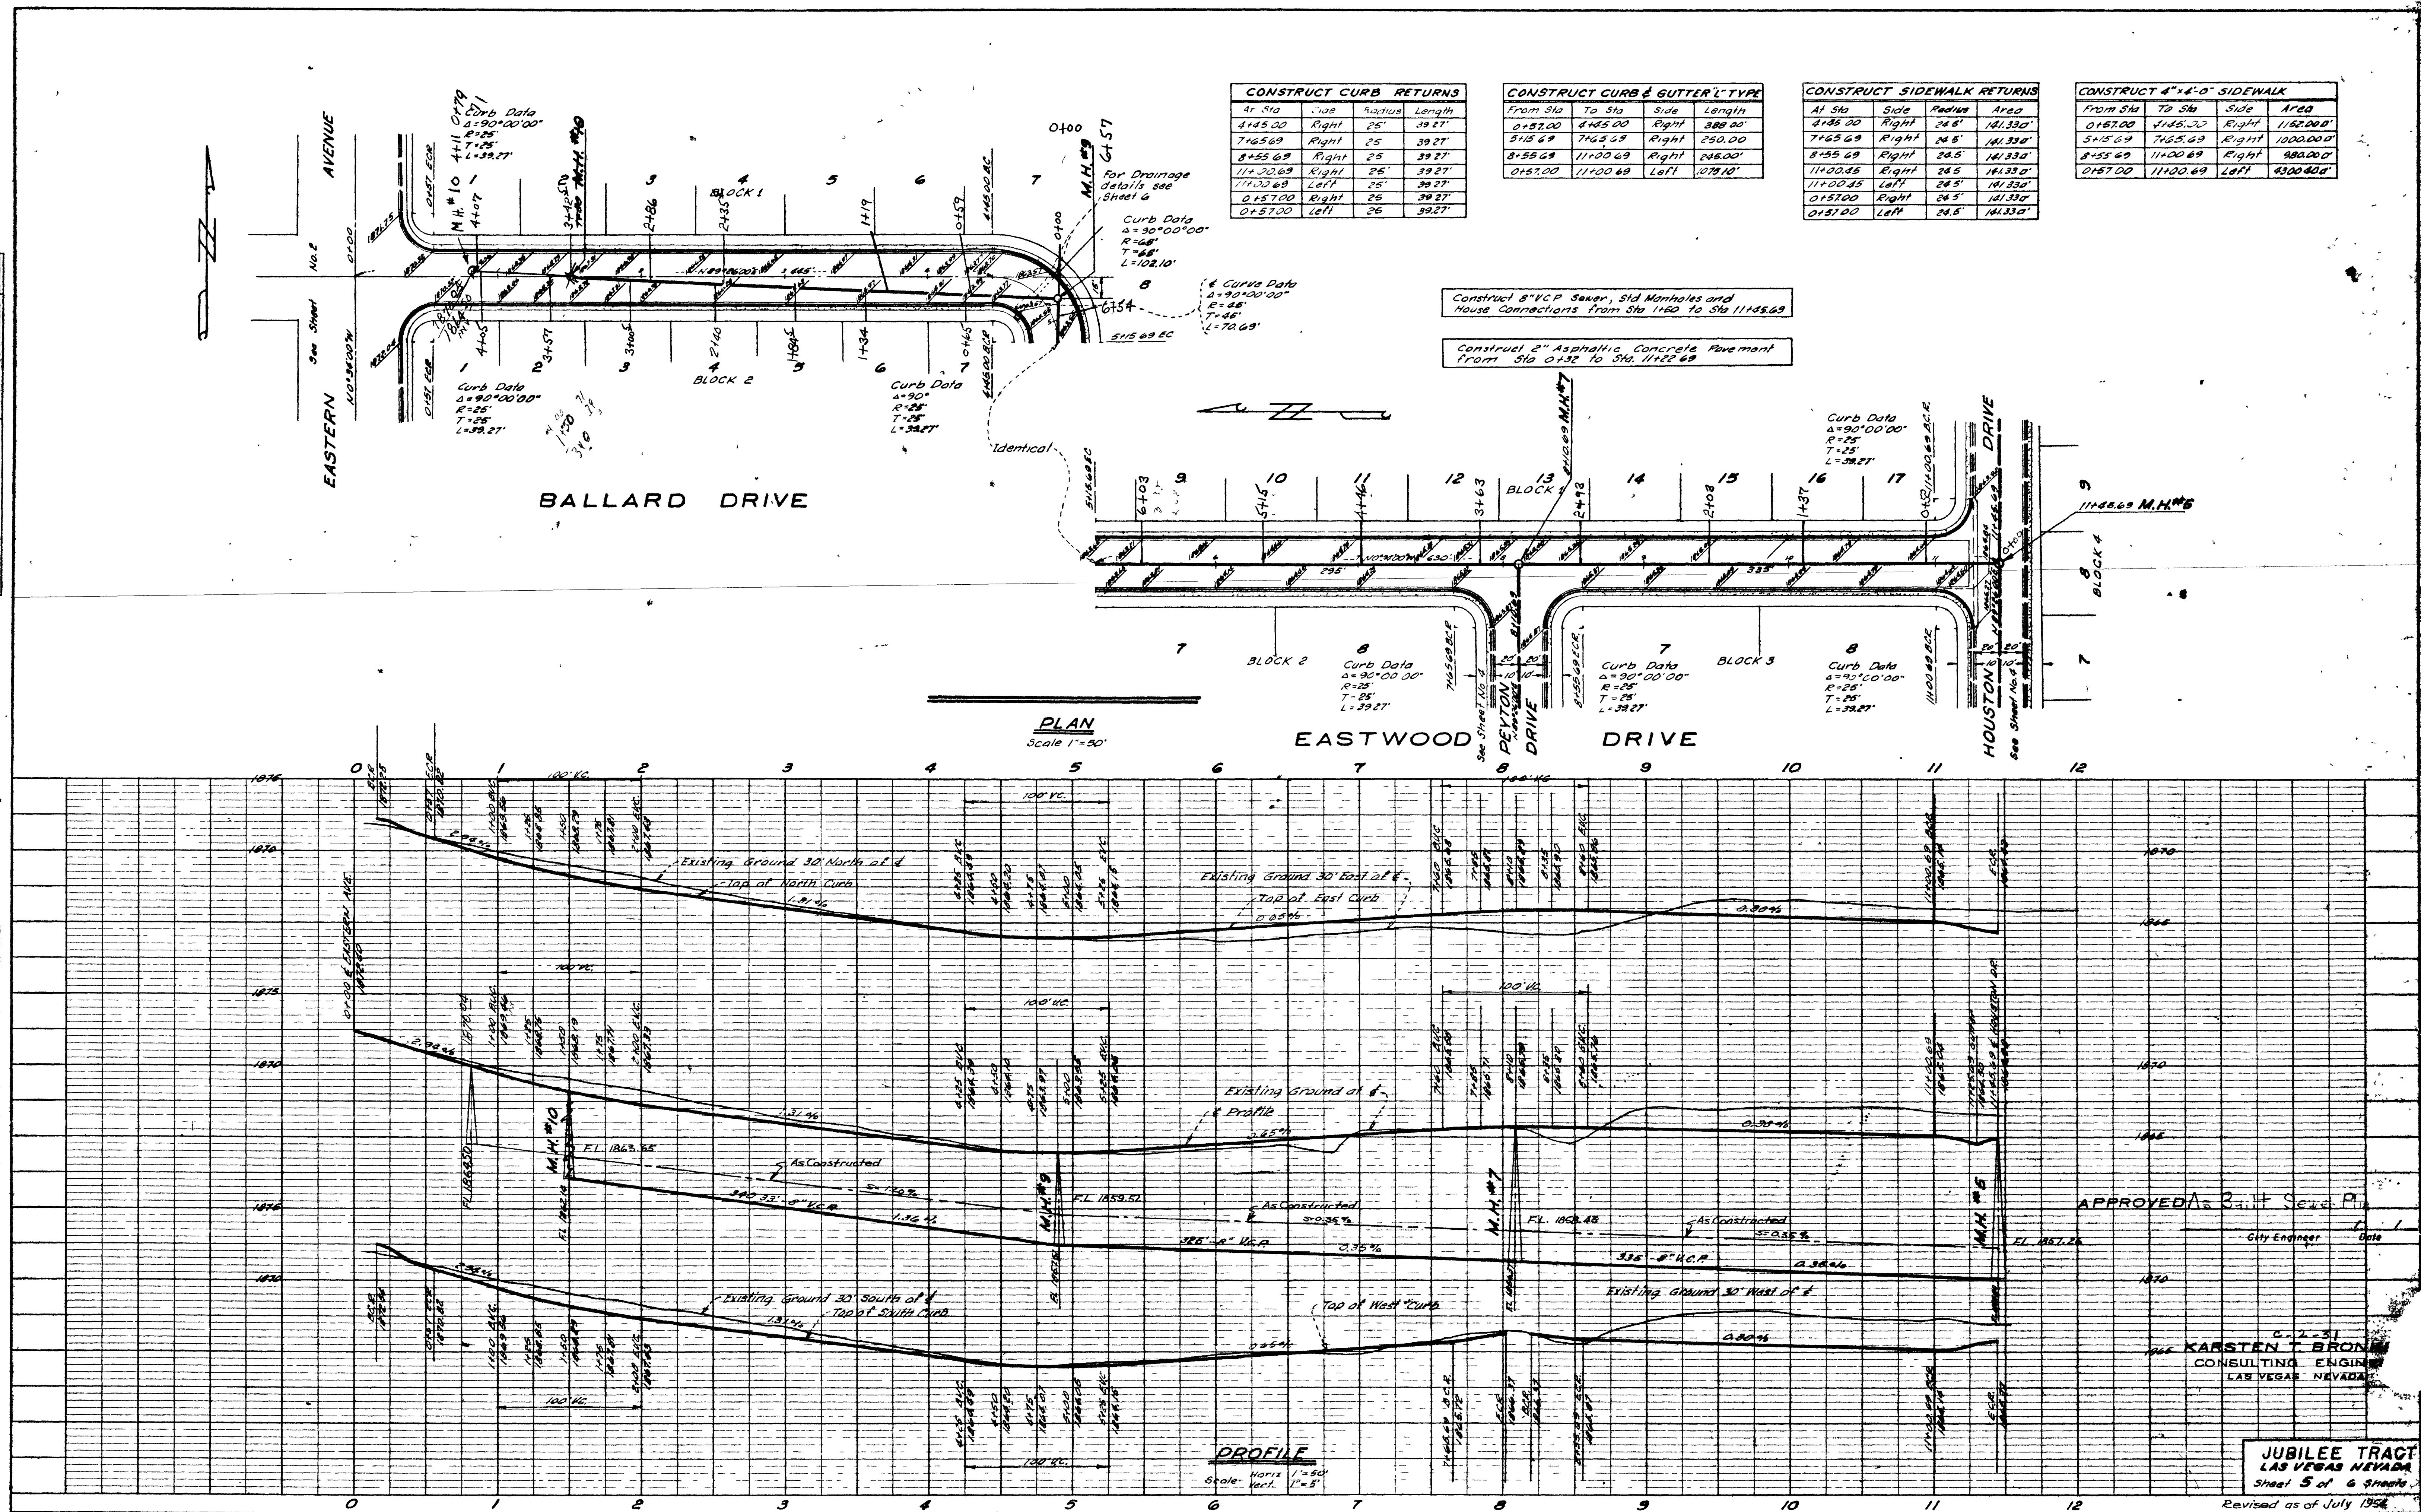


PLATE 1 - PLAN-PROFILE OF P.R.R.E. STANDARD
KEUFFEL & ESSER CO. NEW YORK
K & E Co. No. 348-10

APPROVED As Built Sewer Plan
City Engineer Date
KARSTEN T. BRON
CONSULTING ENGINEER
LAS VEGAS, NEVADA

JUBILEE TRACT
LAS VEGAS, NEVADA
Sheet 5 of 6 Sheets
Revised as of July 1954

307Y-1880-1 31
307Y-1880-1

