


**BENCH MARK**

BENCH MARK NO 0613602 - CITY OF LAS VEGAS BOLT AND PLATE IN TOP OF CURB AT THE NORTHWEST CORNER OF SUNRISE AVENUE AND MOJAVE ROAD. ELEVATION 1815.20 CLV DATUM

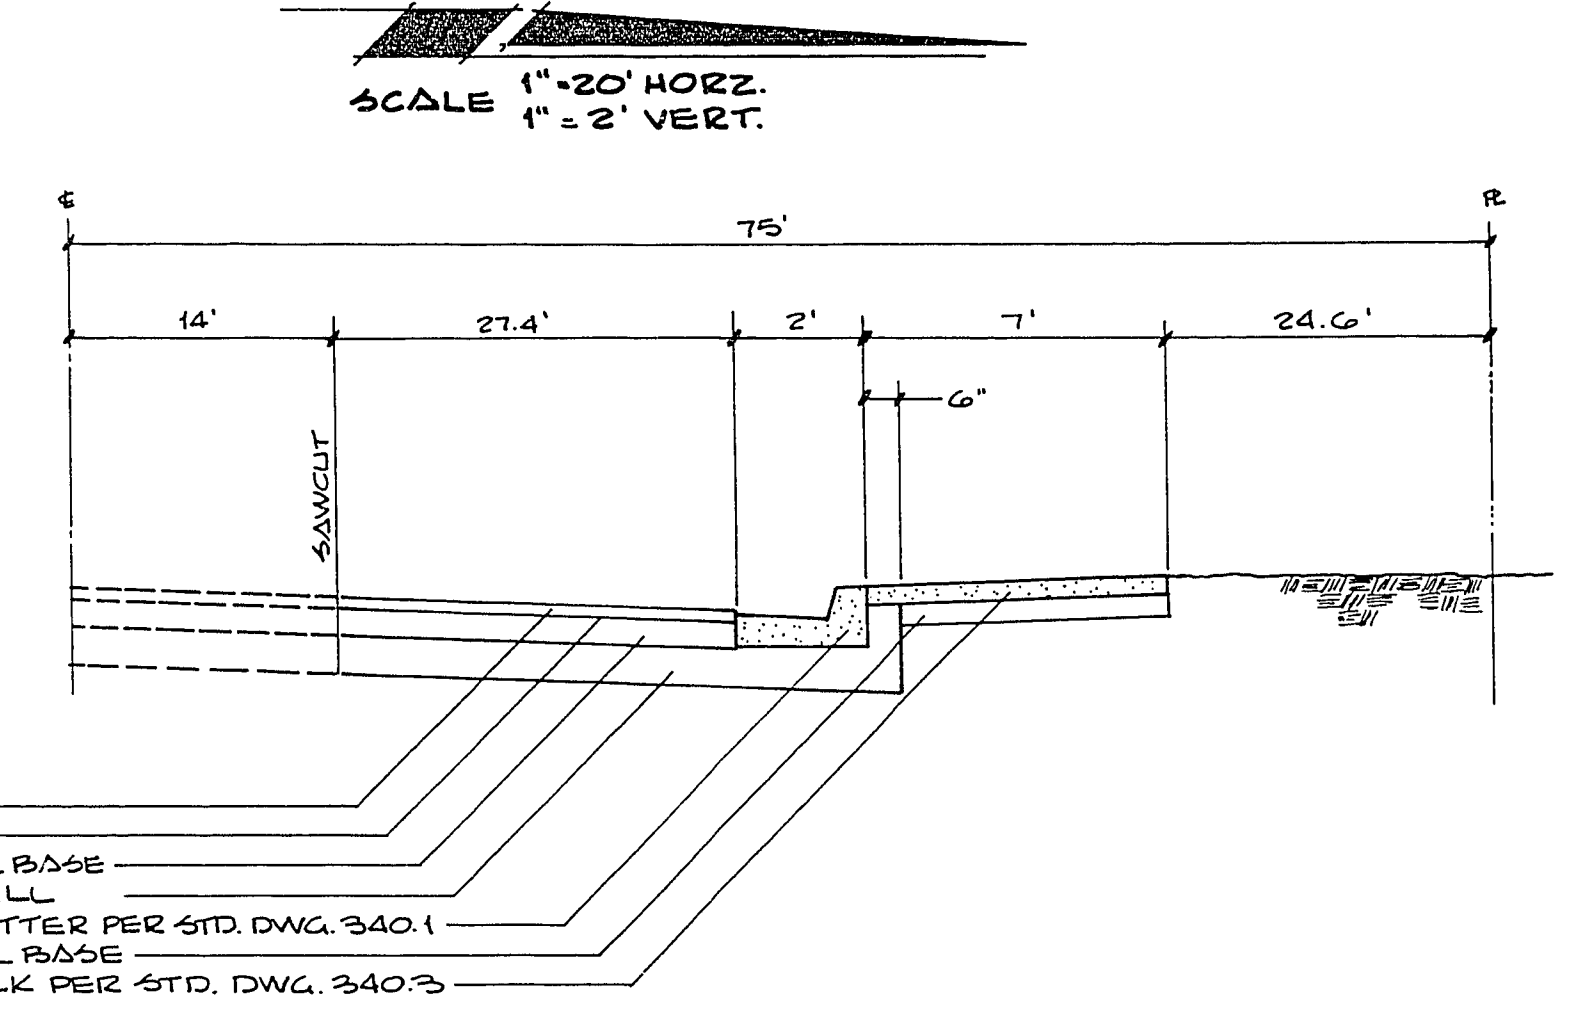

**STREET SECTION**

**APPROVALS**

*[Signature]*  
CITY OF LAS VEGAS QUALITY CONTROL ENGINEER  
DATE 9/16/77

*[Signature]*  
CITY OF LAS VEGAS FIELD OPERATIONS ENGINEER  
DATE 9-15-77

*[Signature]*  
CITY OF LAS VEGAS ELECTRICAL SUPERINTENDENT  
DATE 9-12-77

*[Signature]*  
CITY OF LAS VEGAS ELECTRICAL COORDINATOR  
DATE 9/16/77


*[Signature]*  
CITY OF LAS VEGAS ENGINEERING DEPT.  
DATE 9/16/77

*[Signature]*  
NEVADA POWER CO.  
DATE 10-20-77

**NOTES**

1. ALL CONSTRUCTION SHALL CONFORM TO THE LATEST REVISED UNIFORM STANDARD SPECIFICATIONS AND DRAWINGS FOR PUBLIC WORKS CONSTRUCTION FOR CLARK COUNTY AREA CLARK COUNTY, NEVADA & APPLICABLE CITY OF LAS VEGAS STANDARDS & SPECIFICATIONS.
2. COMPLIANCE WITH AIR POLLUTION CONTROL REGULATIONS WILL BE REQUIRED AT ALL TIMES.
3. STREET LIGHT POWER SOURCE TO BE DETERMINED BY NEVADA POWER CO.

Nevada Power Company approves the point of service to the street light system. This detail may be deemed to consent to the placement of the light poles which may be in conflict with Nevada Power Company's prior rights and/or facilities.  
10-20-77  
*[Signature]*  
NEVADA POWER CO.

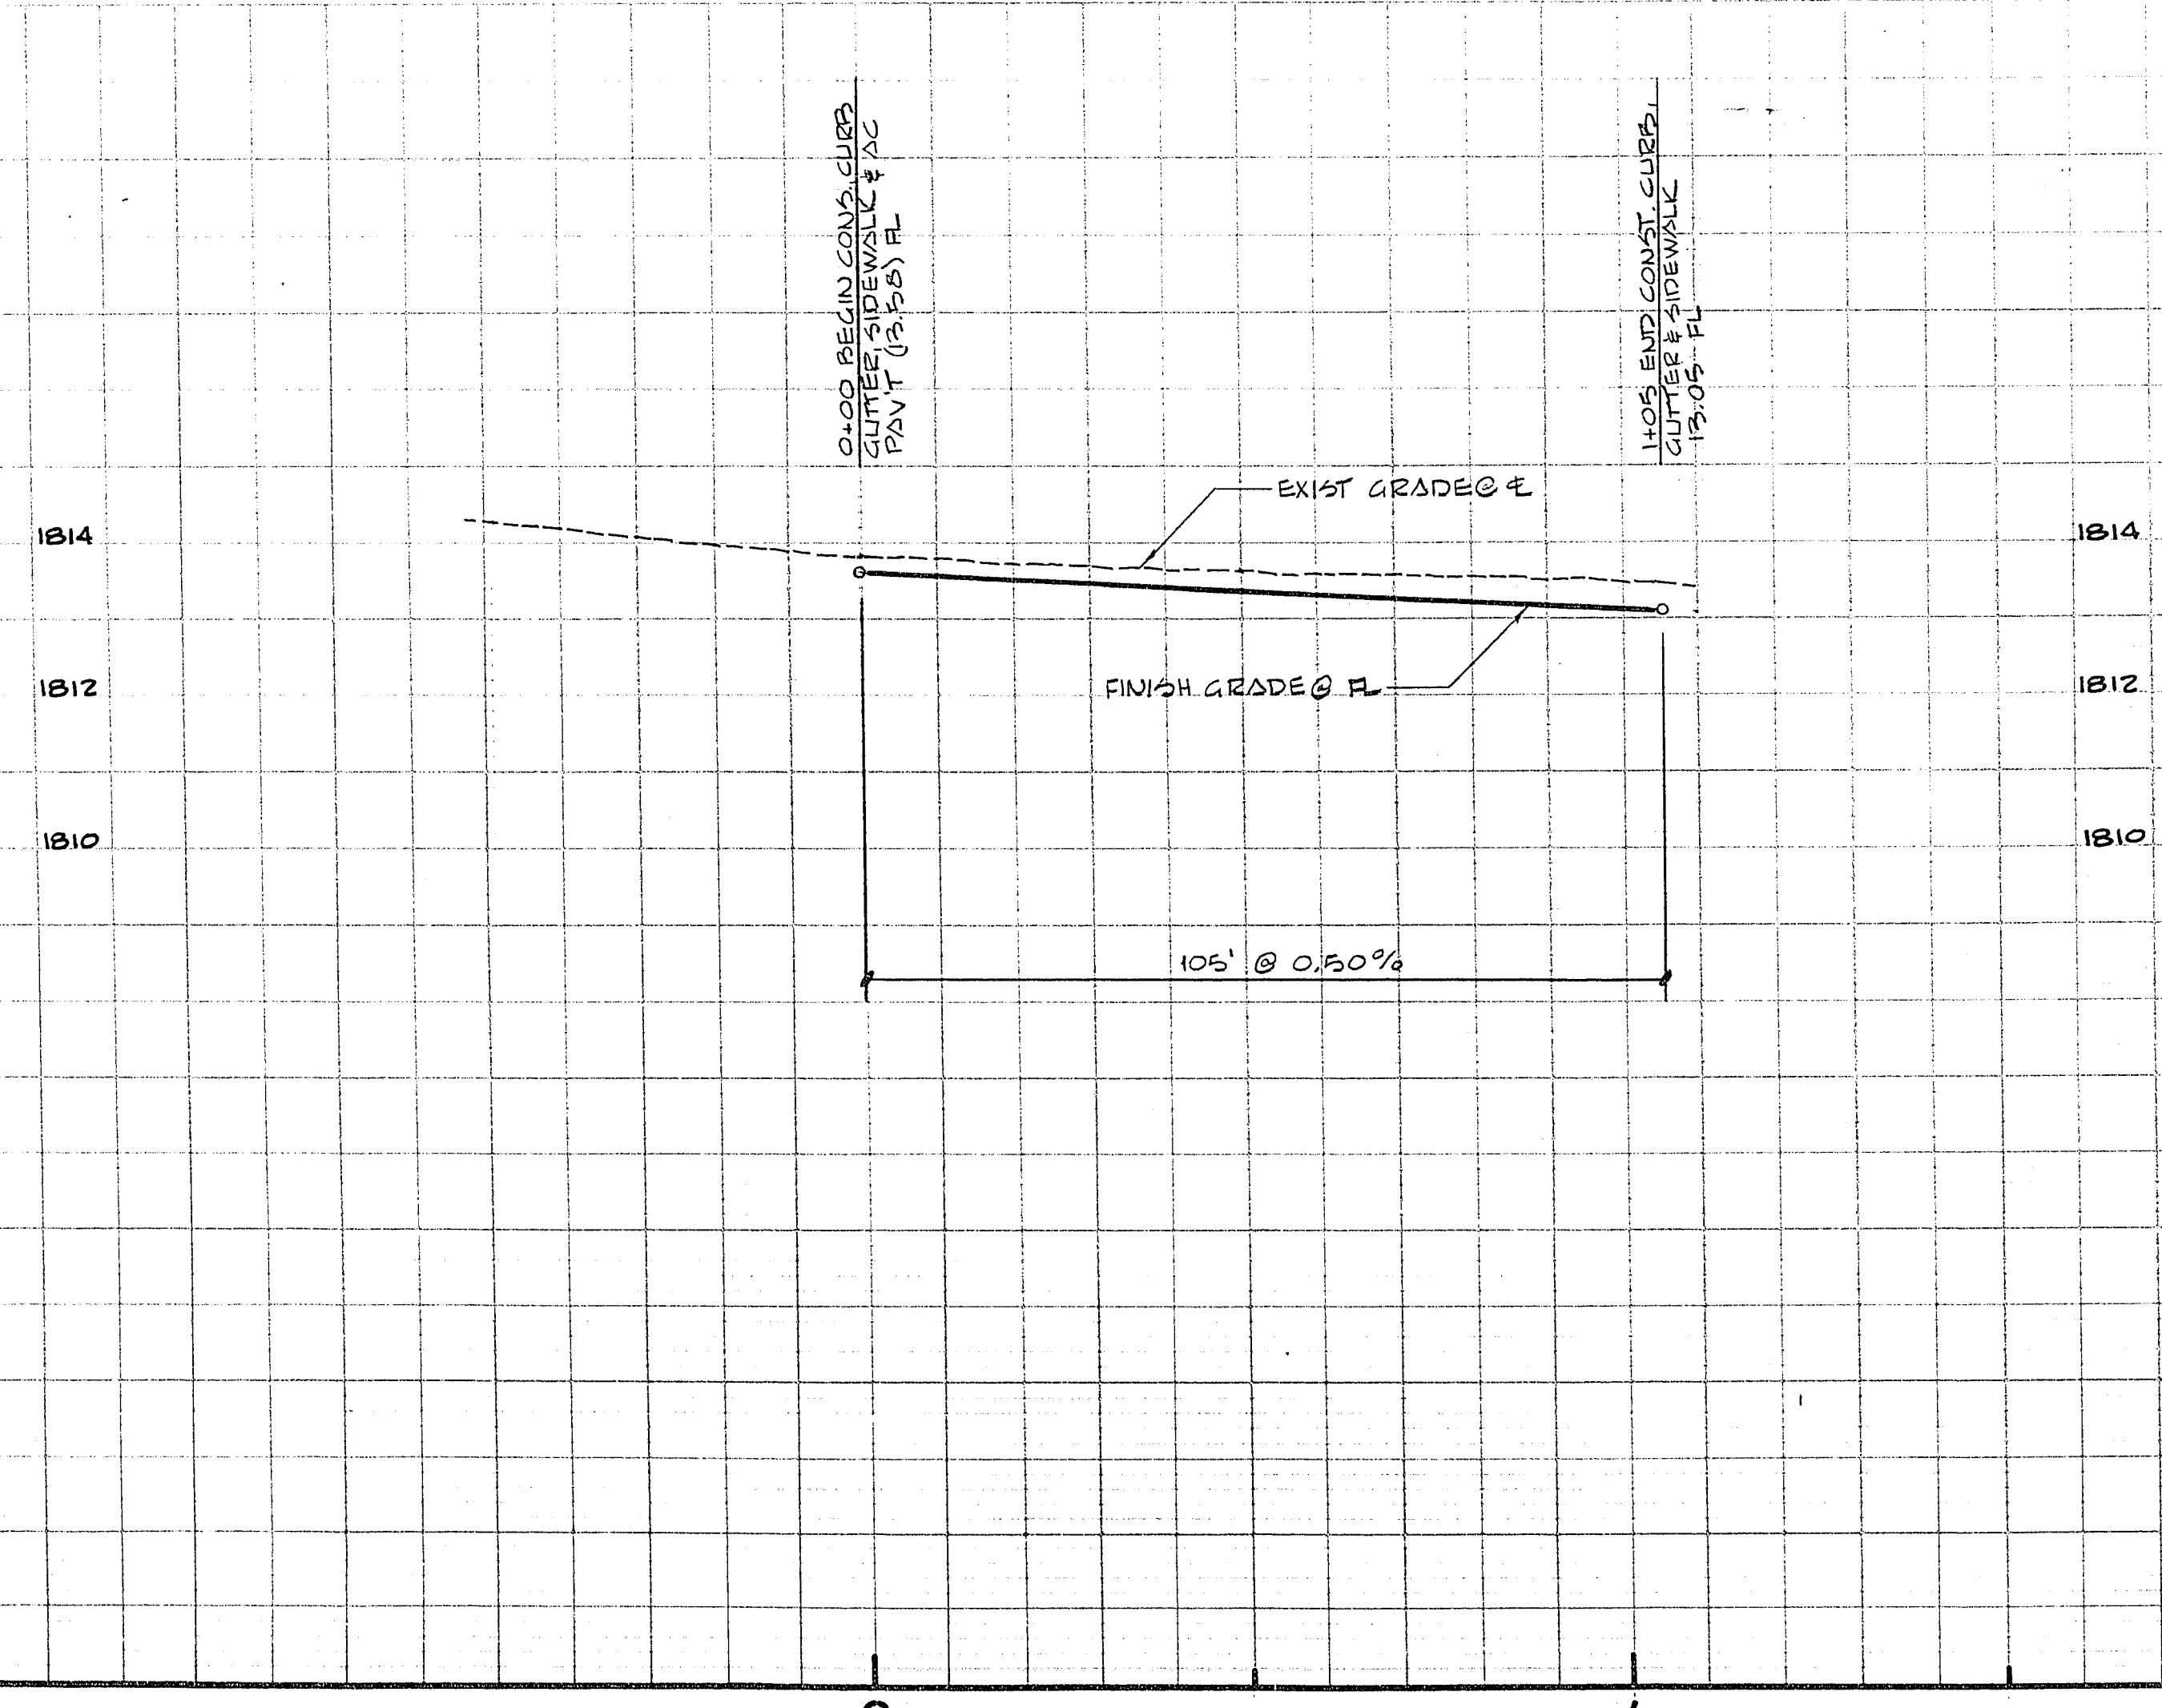

REVISIONS  
DATE NO. REVISIONS  
4/25/77 REVISED AS BUILT

PREPARED FOR: **GENE CRAWFORD**

DATE: 8-10-77  
DESIGN: JPM  
DRAWN: JPM  
CHECK: EJP  
SCALE: 1"=50'

**BAUGHMAN & TURNER**  
MINING ENGINEERS  
LAND SURVEYORS  
3335 WEST CHARLESTON BOULEVARD  
LAS VEGAS, NEVADA 89102  
702-870-8771

**STREET & STREET LIGHT DESIGN**

WITHIN A PORTION OF THE 1/2 OF SECTION 36, TOWNSHIP 20-SOUTH, RANGE 01 EAST, MERIDIAN CITY OF LAS VEGAS, NEVADA

PROJ. NO. 107-49  
SHEET 1 OF 2  
DATE: 9/16/77

NOTE: UTILITY INFORMATION WAS DERIVED FROM DATA FURNISHED BY UTILITY COMPANIES. CONTRACTOR MUST CONFIRM LOCATION OF UTILITIES BEFORE COMMENCING EXCAVATION.

