

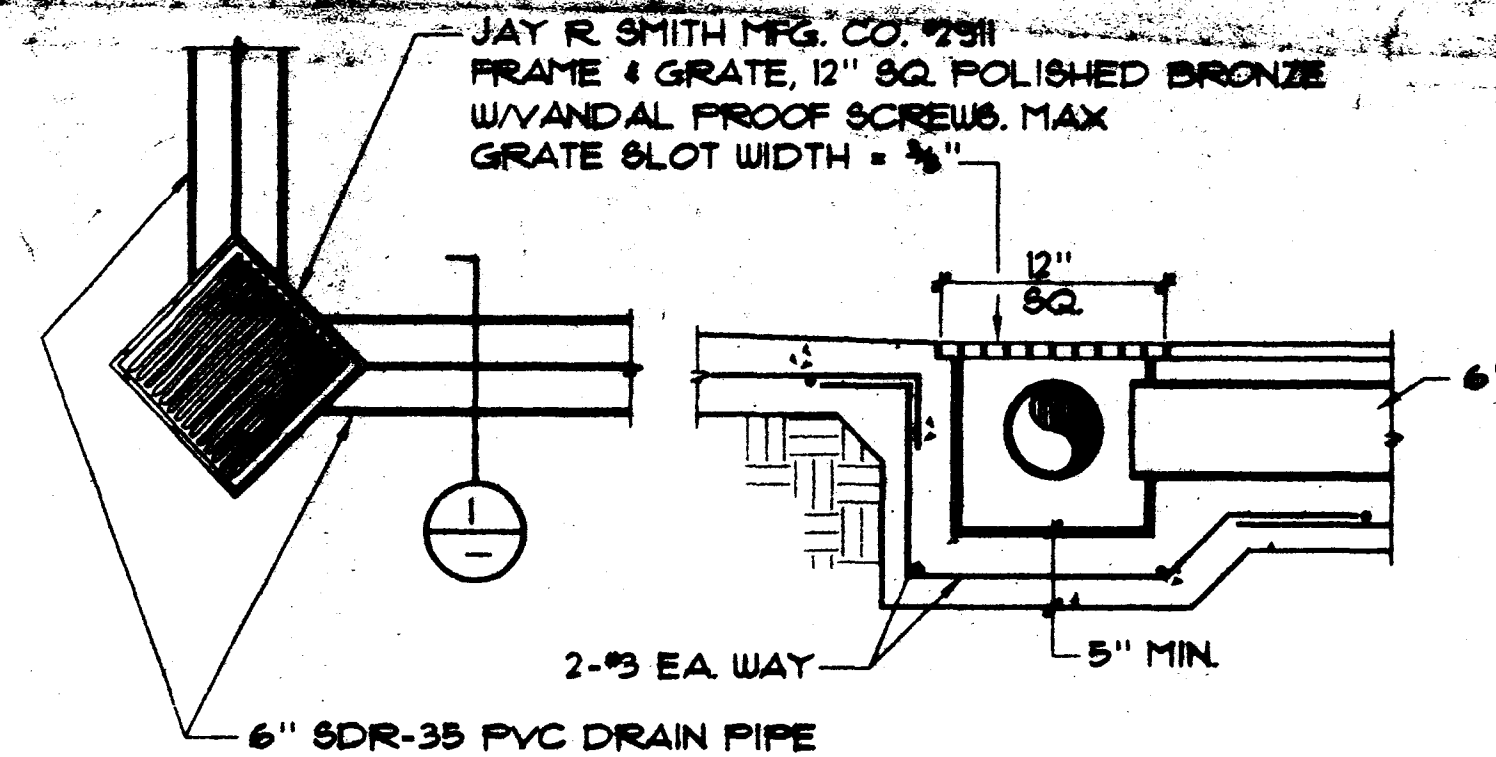


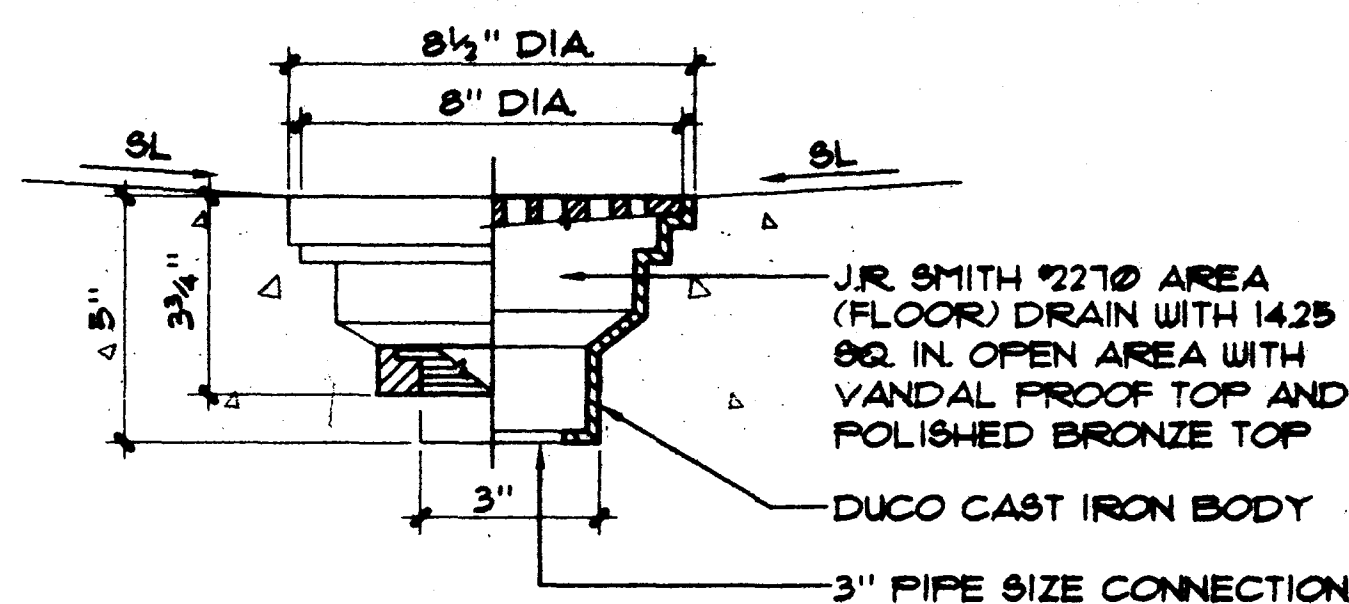

SLOT DRAIN CLEAN OUT

1 1/2" x 1'-0"

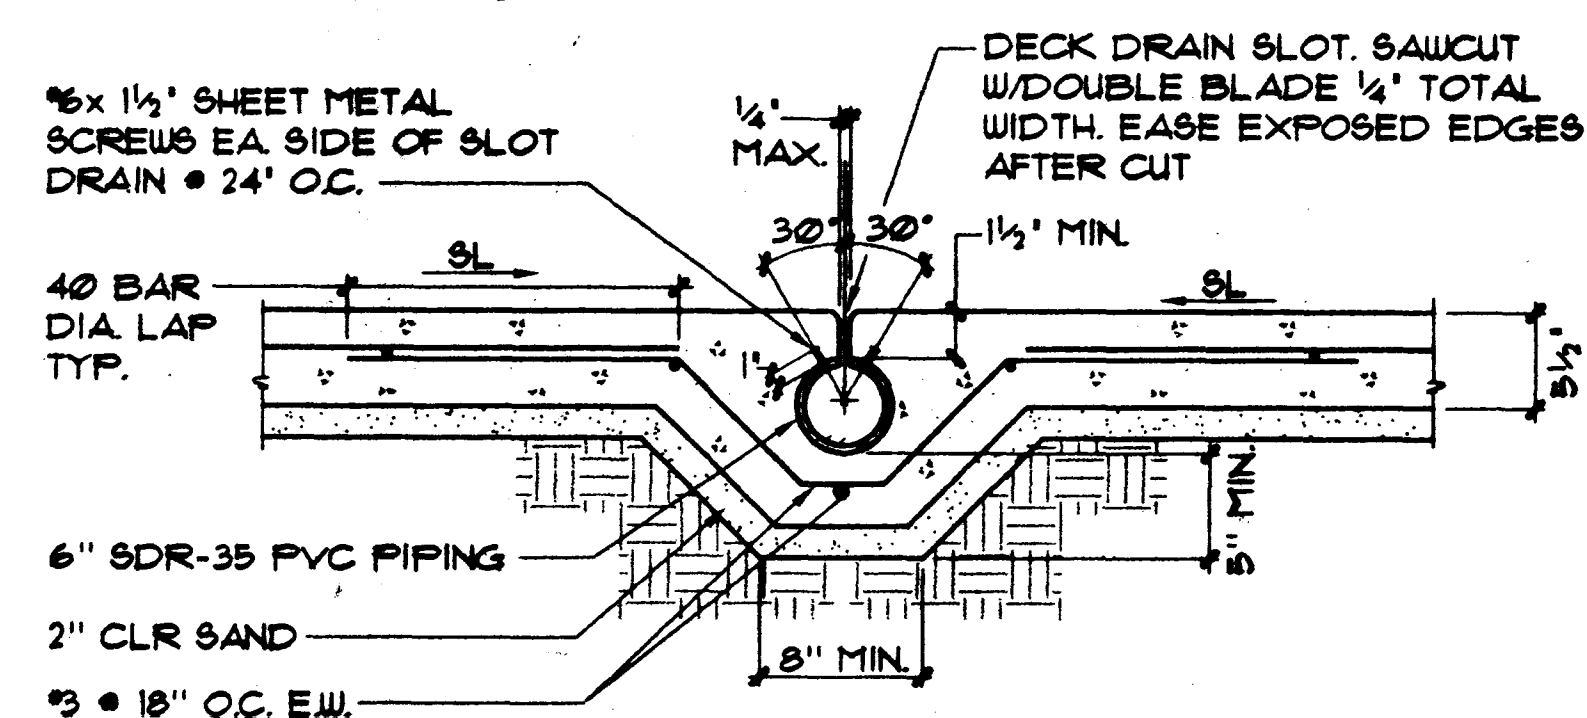

DECK/AREA DRAIN DETAIL

3" x 1'-0"

SWISHER & HALL
AIA, LIMITED
ARCHITECTURE AND PLANNING
140 NORTH TENNESSEE AVE., SUITE C
LAS VEGAS, NEVADA 89101
702.885.2222 702.885.0000 (FAX)


AS BUILT
DETAILS
MUNICIPAL POOL AT DULA CENTER
CITY OF LAS VEGAS

Job no.
9700400
date
10/10/97
drawn by
NFC
checked by
S.F.

Issued for
PLAN
REVIEW

Sheet no.
SP-11
65 Of 104

074-22

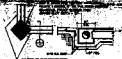

SLOT DRAIN CLEAN OUT



GULLY AREA DRAIN DETAIL

SLOT DRAIN

SWINER & HALL

AS

DETAILS

SWINER & HALL

SWINER & HALL

SWINER & HALL

SWINER & HALL