


7/20/97 PLOTTED BY: HEDD DATE: 12/24/97 TIME: 08:27 SCALE FACTOR: 1=1 PLOT: A4.PLOT

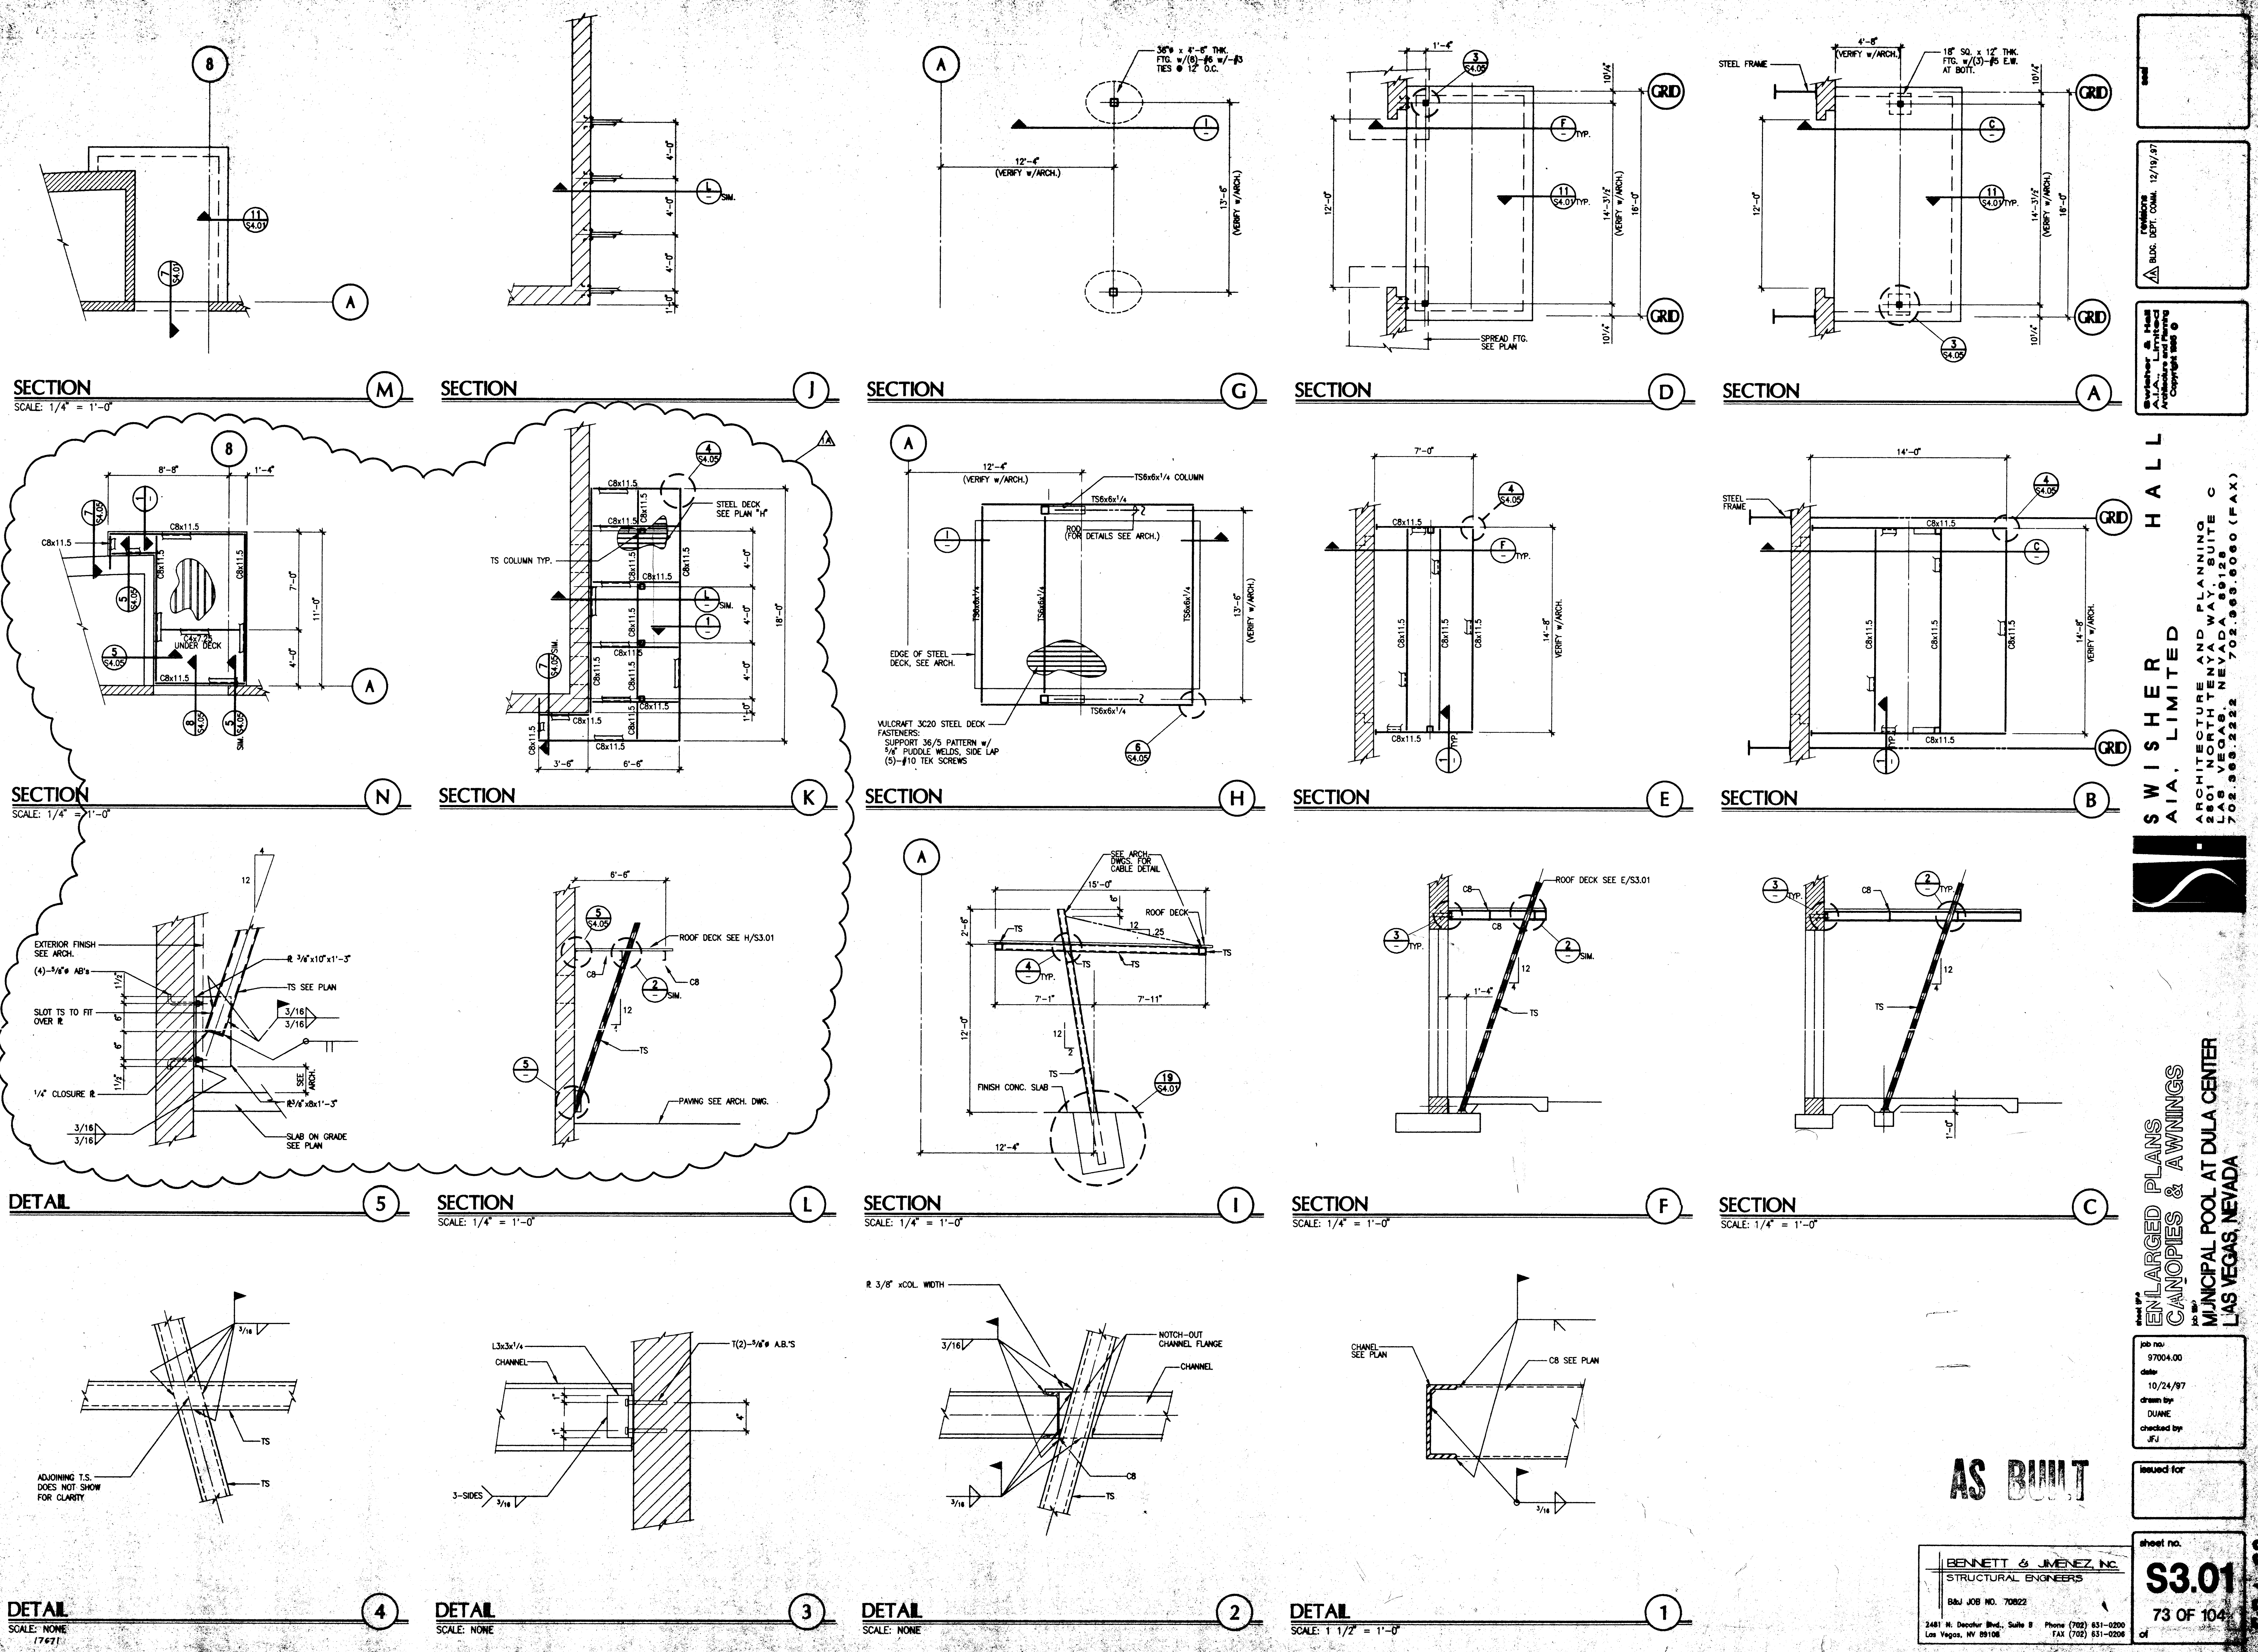

Swisher AIA, Limited
Architects
12/19/97
BUD. DEPT. COMM.

SWISHER
AIA, LIMITED
ARCHITECTURE AND PLANNING
2801 NORTH TENAYA WAY, SUITE C
LAS VEGAS, NEVADA 89128
702.969.2222 702.969.6060 (FAX)

ENLARGED PLANS
CANOPIES & AWNINGS
MUNICIPAL POOL AT DULA CENTER
LAS VEGAS, NEVADA

job no.
97004.00
date
10/24/97
drawn by
DUME
checked by
JFU

issued for

sheet no.
S3.01
73 OF 104

BENNETT & JIMENEZ INC.
STRUCTURAL ENGINEERS
B&J JOB NO. 70822
2481 N. Decatur Blvd., Suite B Phone (702) 631-0200
Las Vegas, NV 89108 FAX (702) 631-0200

AS BUILT

