


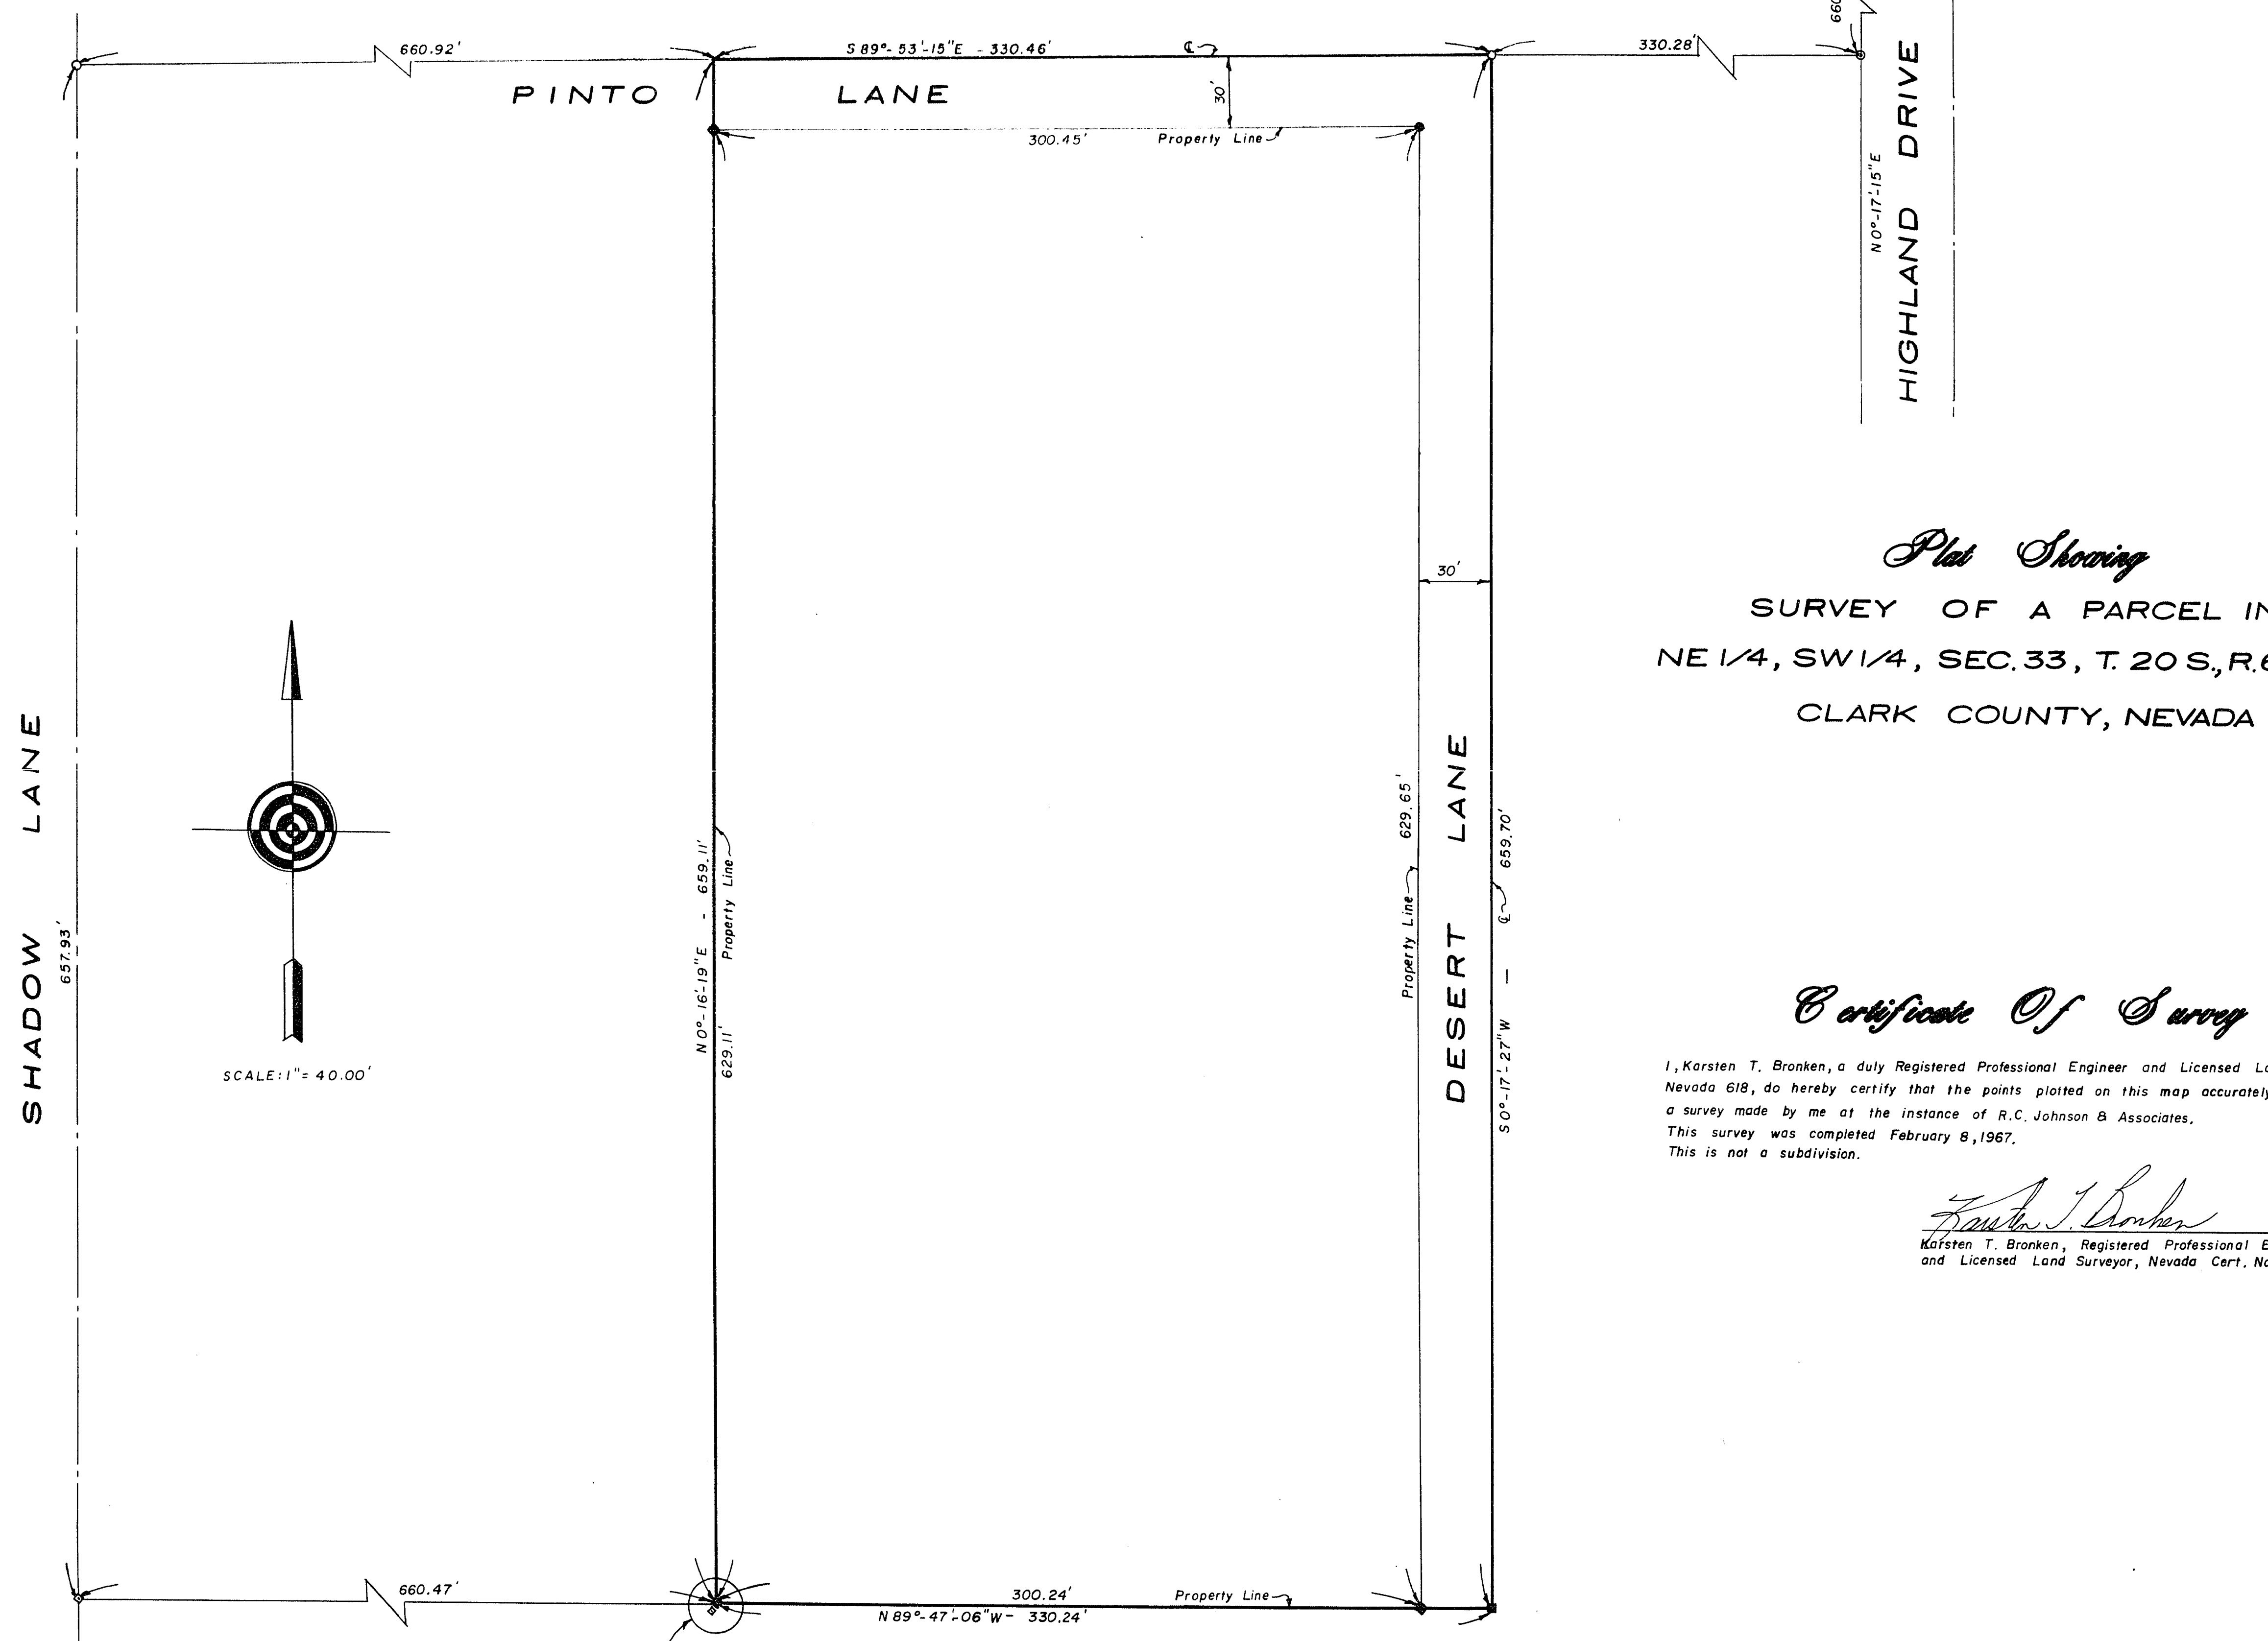


Plat Showing

SURVEY OF A PARCEL IN THE
NE 1/4, SW 1/4, SEC. 33, T. 20 S., R. 61 E., M.D.B. & M.
CLARK COUNTY, NEVADA

Certificate Of Survey

I, Karsten T. Bronken, a duly Registered Professional Engineer and Licensed Land Surveyor, Nevada 618, do hereby certify that the points plotted on this map accurately represent a survey made by me at the instance of R.C. Johnson & Associates. This survey was completed February 8, 1967. This is not a subdivision.

Karsten T. Bronken
Karsten T. Bronken, Registered Professional Engineer
and Licensed Land Surveyor, Nevada Cert. No. 618

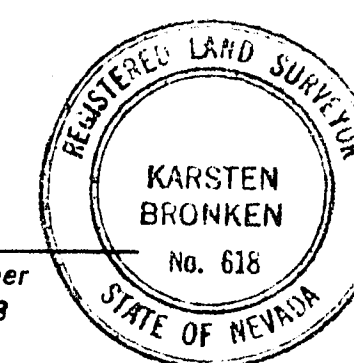

LEGEND

- Found C.L.V. Tag
- ⊙ Found Nail & Shiner
- Set 1/2" Rebar
- ⊞ Found Iron Bolt in Conc.
- Found Hub & Tack
- ◇ Found Conc. Monument
- ◆ Set Conc. Monument, R.E. 618

BASIS OF BEARING

Basis of Bearings for this map is in Book 2, Page 95
Engineers File, Clark County, Nevada.

624034

No. 624034
RECORDED AT THE REQUEST OF
KARSTEN T. BRONKEN
Date 2-9-67 9:34 A.M.
FILE 17 - PAGE 30
of SURVEYS
OFFICIAL RECORDS BOOK NO. 177
CLARK COUNTY, NEVADA, RECORDS
PAUL E. HORN, RECORDER
Fee \$ 2.50 E.M. Deputy

055-591
FILE 17 PAGE 30