


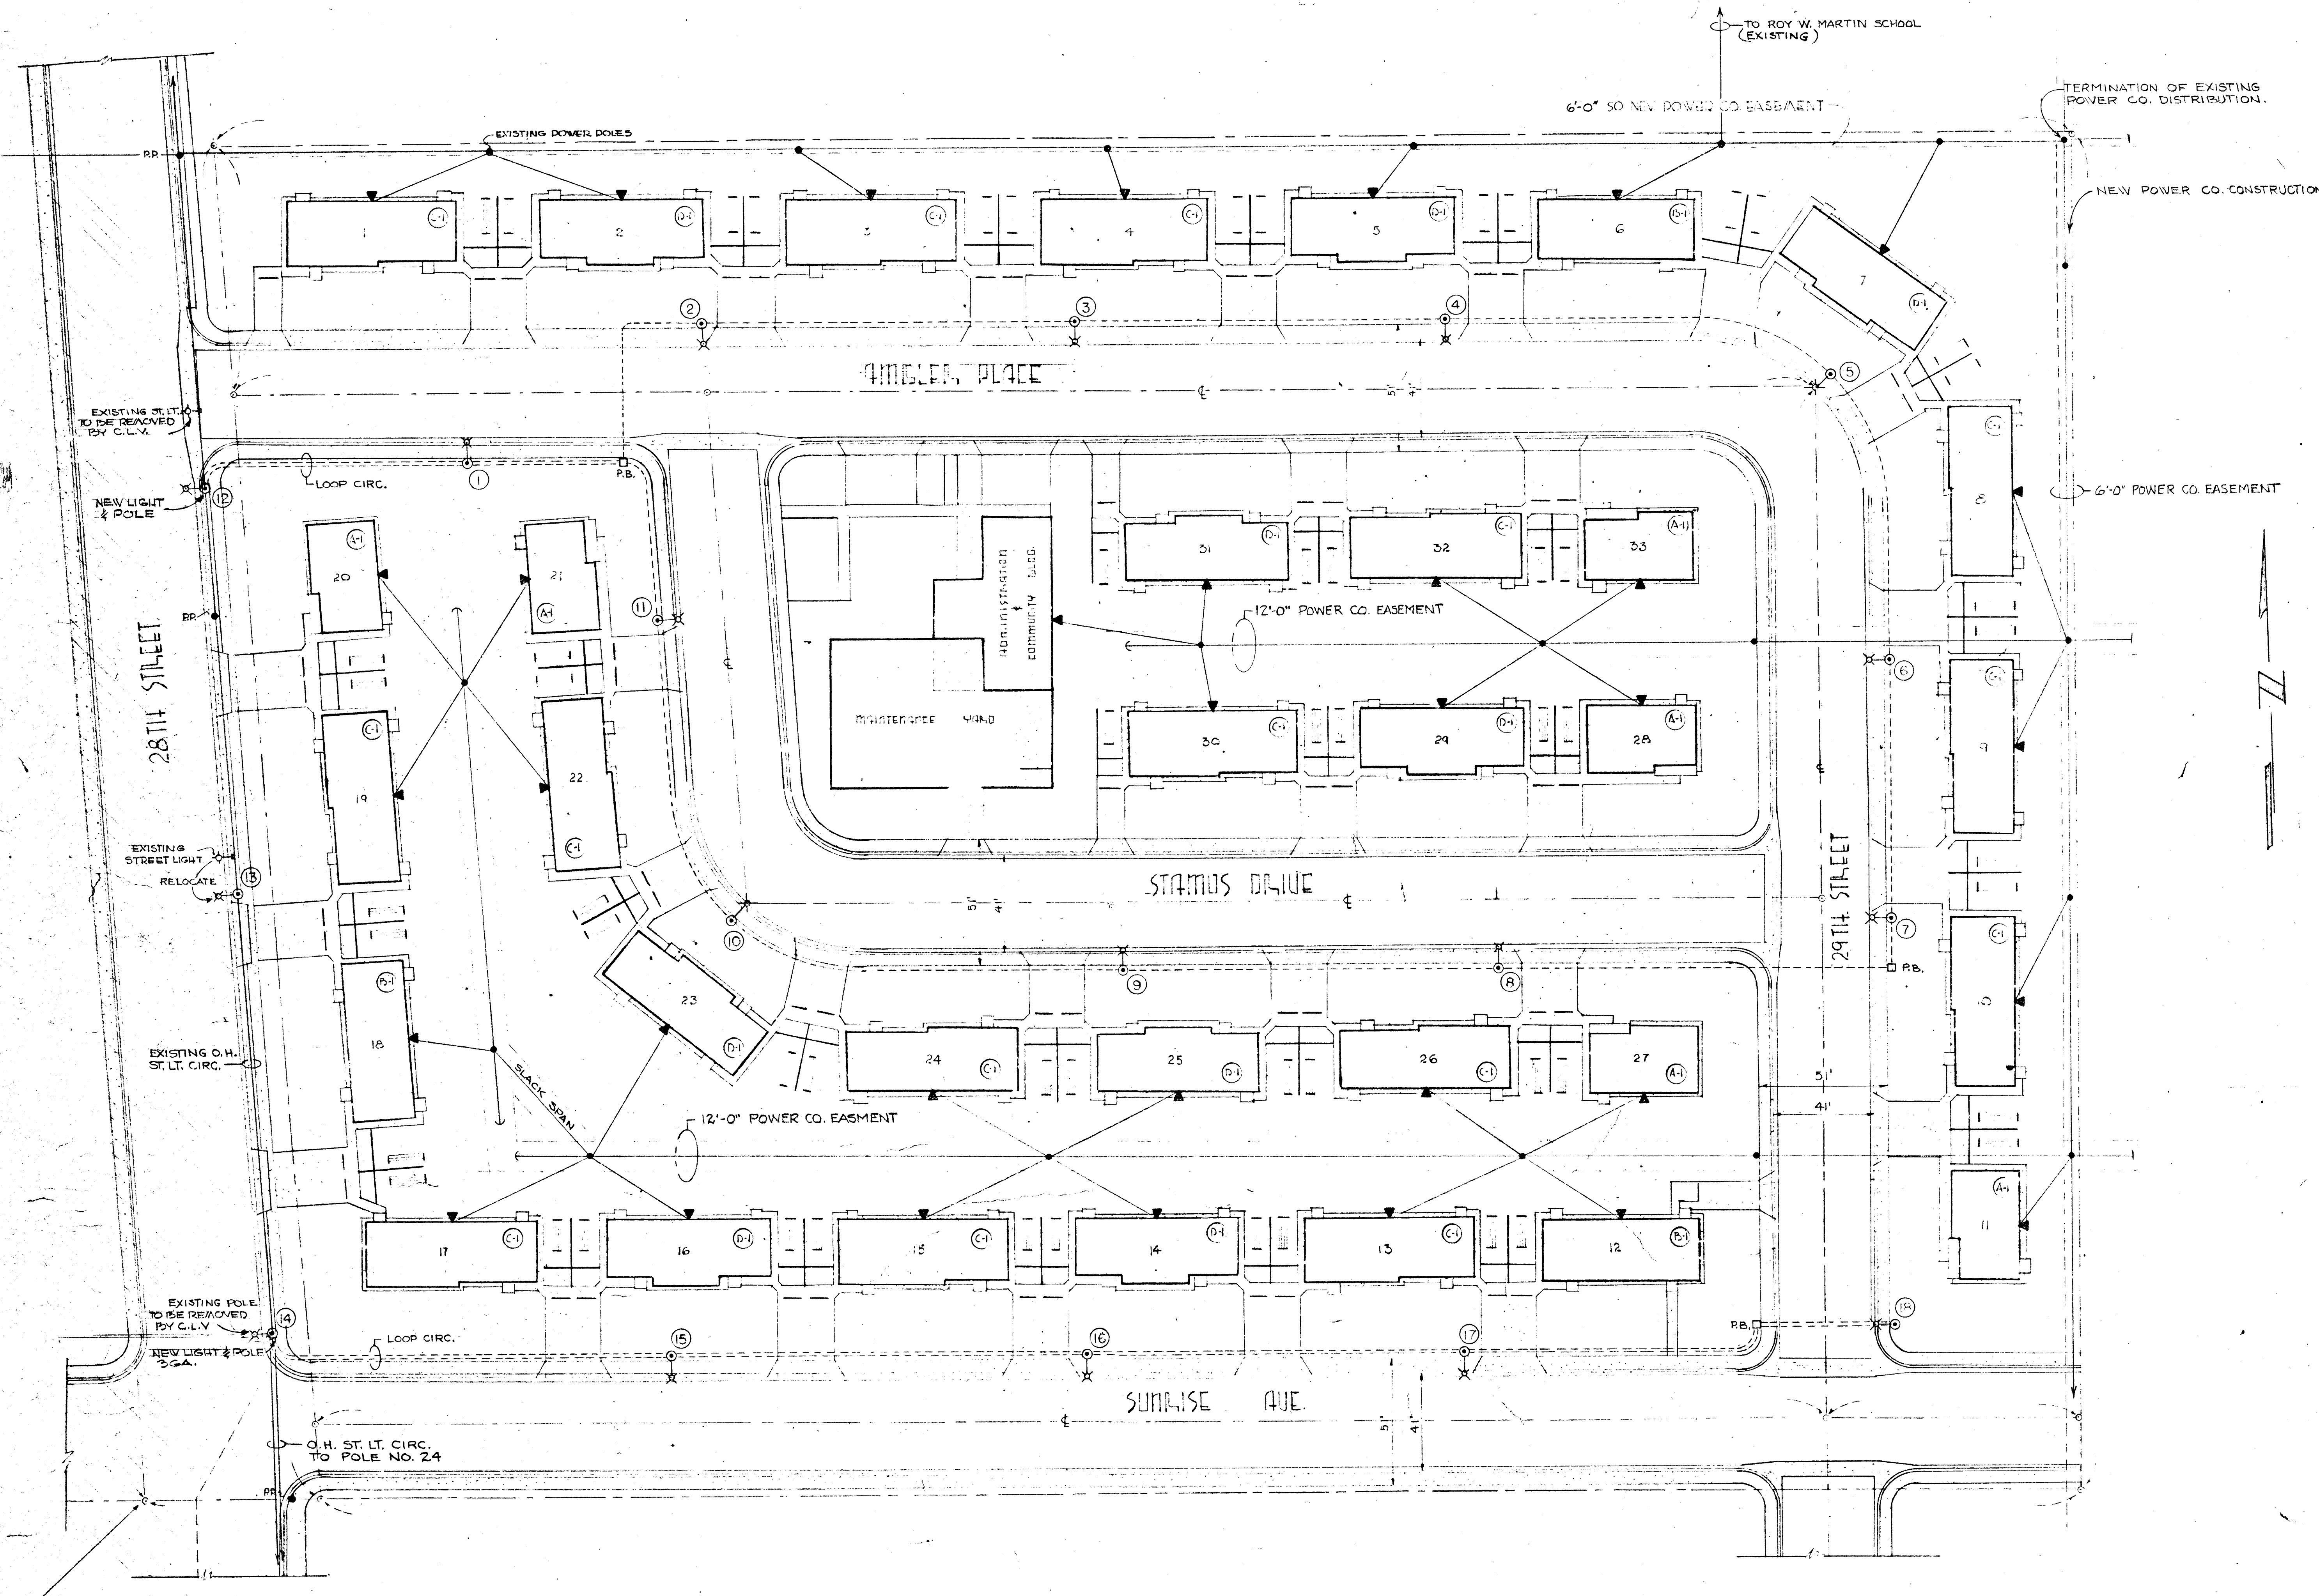

SCALE 1"=30'
SEE SHEET E-1 FOR LEGEND

SOUTHERN NEVADA POWER COMPANY
APPROVED BY: *[Signature]*
DATE: 8-8-60

CITY OF LAS VEGAS, NEVADA
OFFICE OF THE CITY ENGINEER
APPROVED BY: *[Signature]*
DATE: 8 Aug 1960

AS BUILT
FINAL DRAWINGS

MEMBERS OF THE A. I. A.	
FROM THE OFFICE OF: ARCHITECTS ZICK & SHARP 1808 S. MAIN ST. LAS VEGAS, NEVADA PH. 5350	
NO. DATE	BY
SHEET TITLE PROJECT: BY STREET LIGHTING & POWER DISTRIBUTION	
JOB TITLE: 125 DWELLING UNIT HOUSING PROJECT FOR THE CITY OF LAS VEGAS, LAS VEGAS, NEVADA	
JOB NUMBER	NEV. 2-4
DATE	6-24-60
DRAWN BY:	C.H.
CHECKED	WZ - H.S.
SHEET NUMBER	E-2