


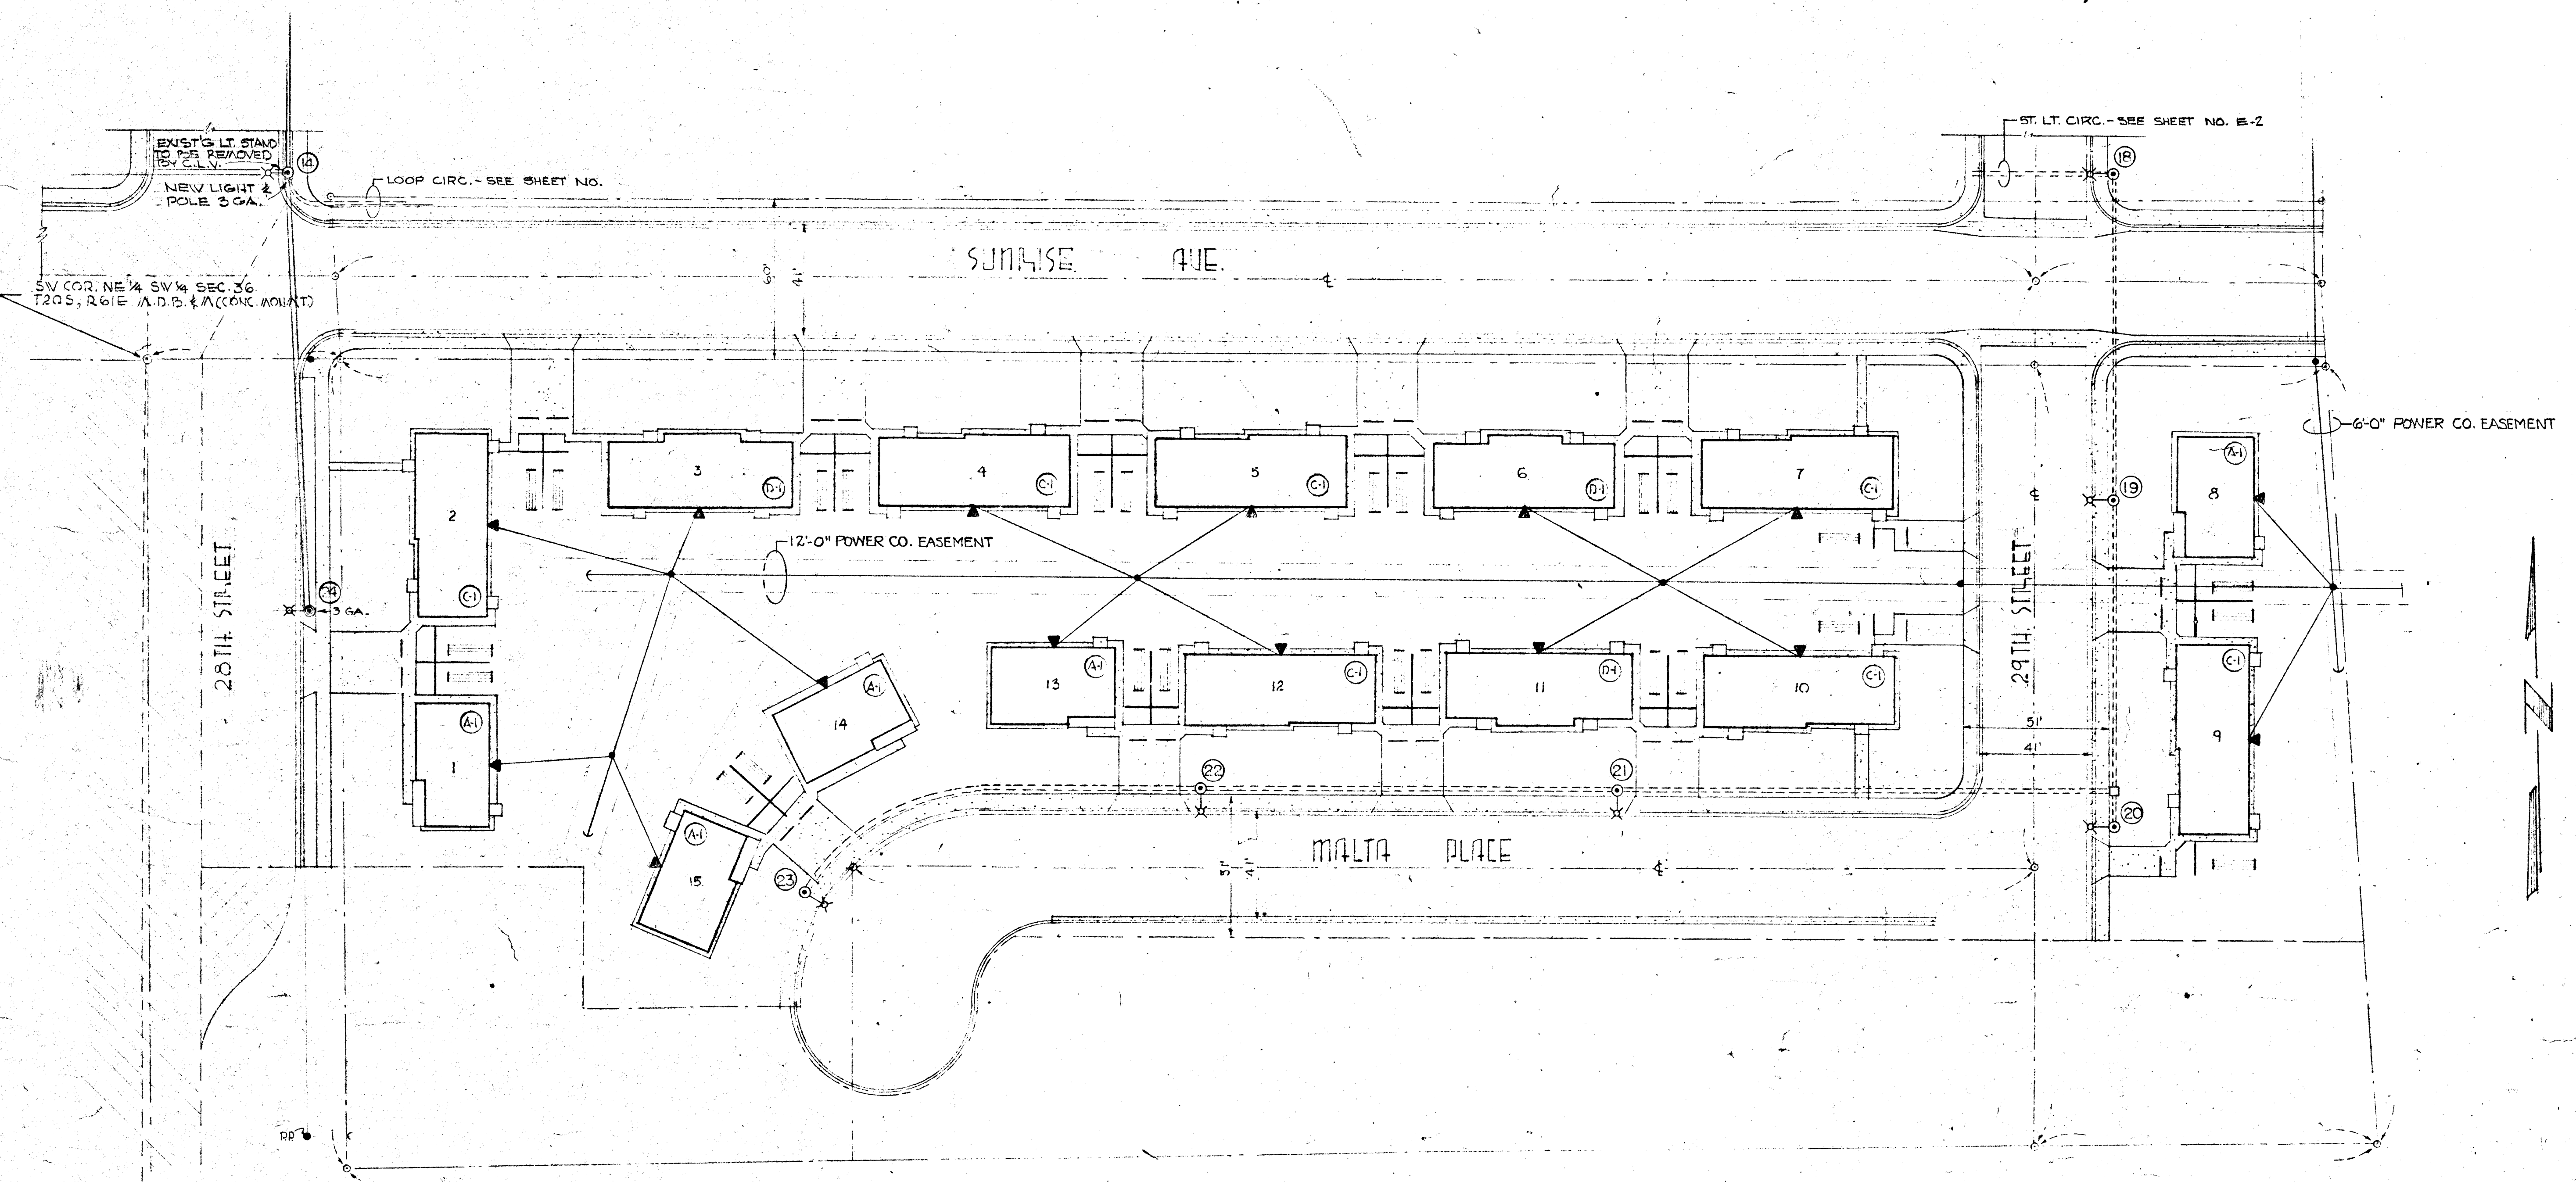

SCALE 1" = 30'
SEE SHEET E-1 FOR LEGEND

SOUTHERN NEVADA POWER COMPANY

APPROVED BY: *[Signature]*
DATE: 8/8/60

CITY OF LAS VEGAS, NEVADA
OFFICE OF THE CITY ENGINEER

APPROVED BY: *[Signature]*
DATE: 8/8/60

AS BUILT

FINAL DRAWINGS

MEMBERS OF THE		ARCHITECTS		FROM THE OFFICE OF:	
A. I. A.		ZICK & SHARP		1808 S. MAIN ST. LAS VEGAS, NEVADA PH. 5320	
NO.	DATE	REVISION	BY	VERIFIED ALL DIMENSIONS AND CONDITIONS AT THE SITE	
1					
2					
SHEET TITLE PROJECT 'C' STREET LIGHTING 2. POWER DISTRIBUTION JOB TITLE DWELLING UNIT HOUSING PROJECT FOR THE HOUSING AUTHORITY OF THE CITY OF LAS VEGAS LAS VEGAS, NEVADA					
JOB NUMBER NEV. 2-4					
DATE 6-24-60					
DRAWN BY E.H.					
CHECKED W.Z. - L.S.					
SHEET NUMBER 12-3					
OF 7					