



SW COR. NW 1/4 SE 1/4
FOUND 6" CON MON.
16" DEEP, TAGGED
R.E. 209

(BASIS OF BEARINGS)

N 0° 52' 20" E
1335.16'

CENTER OF SEC. 22
SET 6" CON. MON. TAGGED R.L.S. 361
12" DEEP

CURVE DATA
P.A. = 17° 30' 22"
D.A. = 2914.76'
L = 890.51'

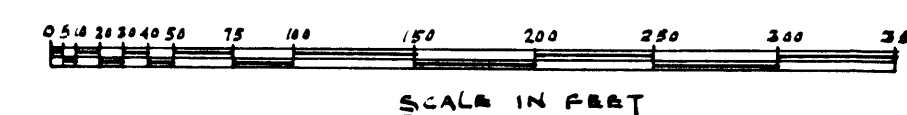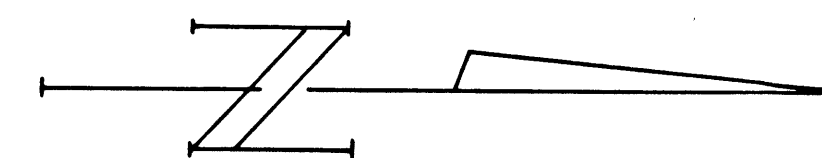


LEGEND
O = SET 2" X 2" HUB & R.L.S. TAG 361
• = SET 3/4" IRON PIPE & R.L.S. TAG 361

BASIS OF BEARINGS
BEARINGS ARE BASED ON PLAT OF SURVEY, RECORDED
IN R.P.E. FILE 1, PAGE 1 IN THE OFFICE OF THE
COUNTY RECORDER, CLARK COUNTY, NEVADA.

NOTE:
NW COR. OF SE 1/4 OF SEC. 22, WAS
RE-ESTABLISHED FROM DATA SHOWN ON
PLAT OF SURVEY RECORDED IN R.P.E. FILE 1,
Pg. 1, CLARK COUNTY RECORDS.

ENGINEER'S CERTIFICATE

THIS IS TO CERTIFY THAT THIS MAP CONSISTING OF
ONE SHEET, ACCURATELY DELINEATES THE RESULTS
OF A SURVEY MADE BY ME AT THE INSTANCE OF
ELIZABETH T., LOUIS F. & CARL T. WANKA AND WAS
COMPLETED ON THE 7TH DAY OF SEPTEMBER, 1956;
THAT THE POINTS FOUND AND THE POINTS SET ARE
CORRECTLY SHOWN HEREON; AND THAT IT IS NOT INTENDED TO
BE A SUBDIVISION.
Frank D. Radburn, Jr.
REGISTERED PROFESSIONAL ENGINEER AND
LICENSED LAND SURVEYOR NEVADA CERT. NO. 361

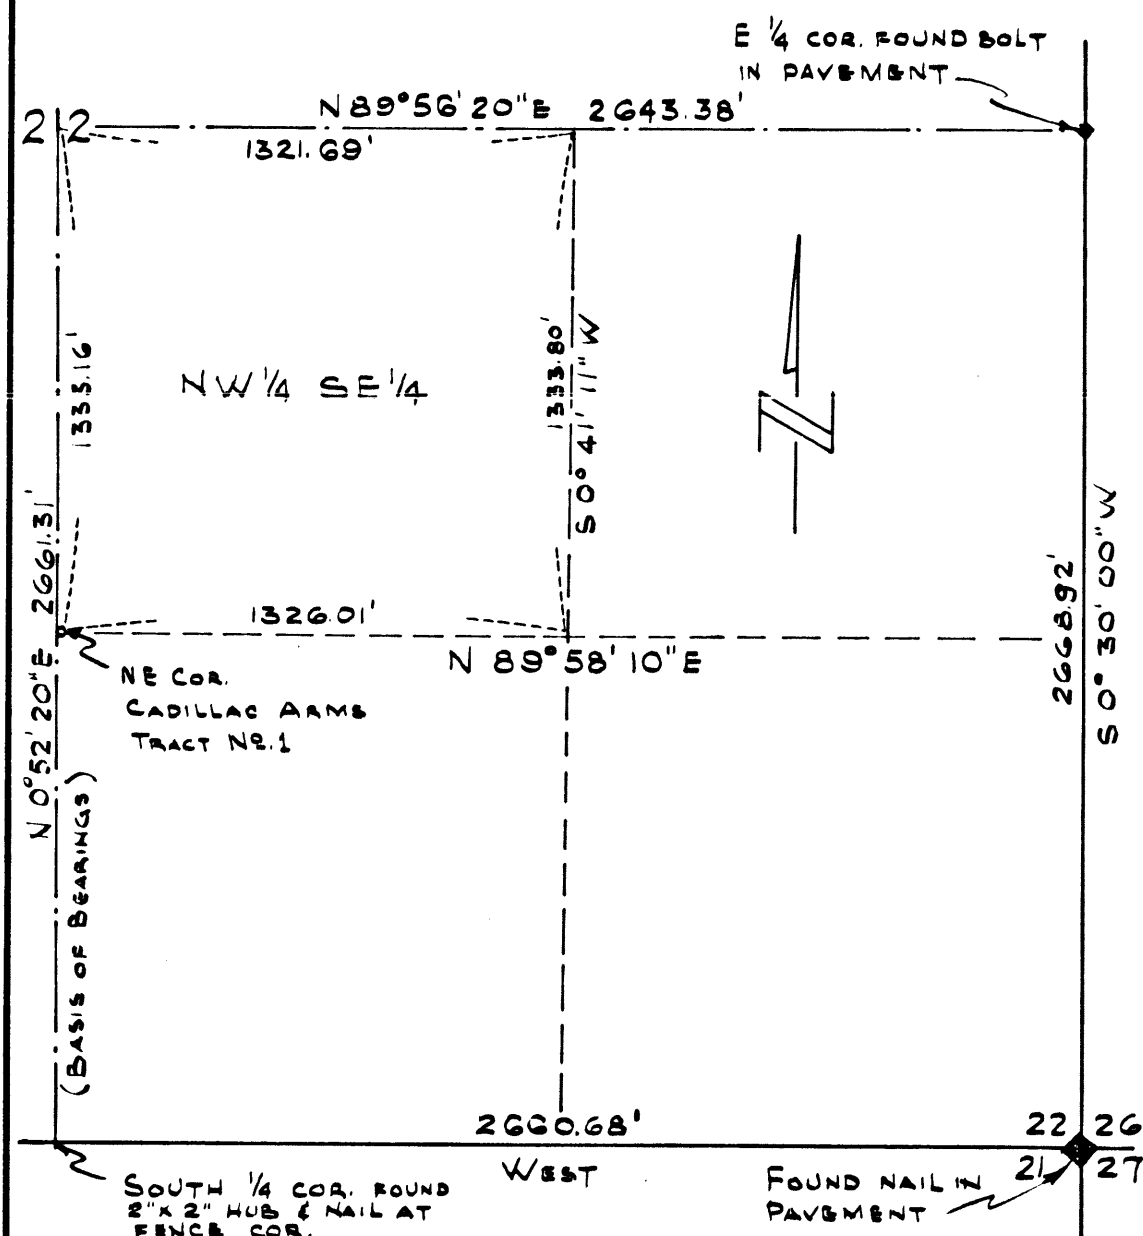

KEY MAP
SHOWING SURVEY OF SE 1/4
OF SEC. 22,
T.20 S., R.61 E., M.D.B. & M.
SCALE 1" = 500 FT.

NW 1/4 OF SE 1/4 OF SECTION 22,
T. 20 S., R. 61 E., M.D.B. & M.

89893
Frank D. Radburn, Jr.
9-25-56
6-53
CLARK COUNTY, NEVADA
FILED IN FINAL REF. 109
670 620

MAP OF SURVEY
FOR
ELIZABETH T., LOUIS F. & CARL T. WANKA
OF
NW 1/4 OF THE SE 1/4
OF SECTION 22,
T.20 S., R. 61 E., M.D.B. & M.
CLARK COUNTY, 717.2-13 NEVADA.

