
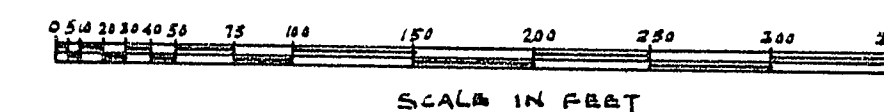


SW COR. NW 1/4 SE 1/4
FOUND 6" CON. MON.
16" DEEP, TAGGED
R.E. 209

(BASIS OF BEARINGS)
N 0° 52' 20" E
1333.16'

CENTER OF SEC. 22
SET 6" CON. MON. TAGGED R.L.S. 361
12" DEEP

89893

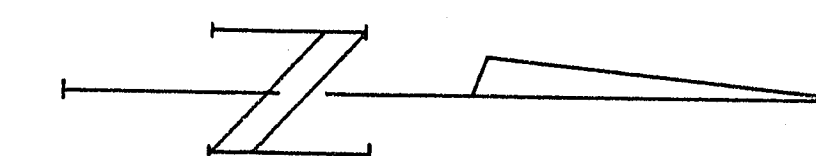


LEGEND
O = SET 2" X 2" HUB & R.L.S. TAG 361
• = SET 1/2" IRON PIPE & R.L.S. TAG 361

BASIS OF BEARINGS
BEARINGS ARE BASED ON PLAT OF SURVEY, RECORDED
IN R.E. FILE 1, PAGE 1 IN THE OFFICE OF THE
COUNTY RECORDER, CLARK COUNTY, NEVADA.


NOTE:
NW COR. OF SE 1/4 OF SEC 22, WAS
RE-ESTABLISHED FROM DATA SHOWN ON
PLAT OF SURVEY RECORDED IN R.E. FILE 1,
PG. 1, CLARK COUNTY RECORDS.

ENGINEER'S CERTIFICATE

THIS IS TO CERTIFY THAT THIS MAP CONSISTING OF
ONE SHEET, ACCURATELY DELINEATES THE RESULTS
OF A SURVEY MADE BY ME AT THE INSTANCE OF
ELIZABETH T., LOUIS F. AND CARL T. WANKA AND WAS
COMPLETED ON THE 7TH DAY OF SEPTEMBER, 1950;
THAT THE POINTS FOUND AND THE POINTS SET ARE
CORRECTLY SHOWN HEREON; AND THAT IT IS NOT INTENDED
TO BE A SUBDIVISION.
Frank D. Redburn, Jr.
REGISTERED PROFESSIONAL ENGINEER AND
LICENSED LAND SURVEYOR NEVADA CERT. NO. 361

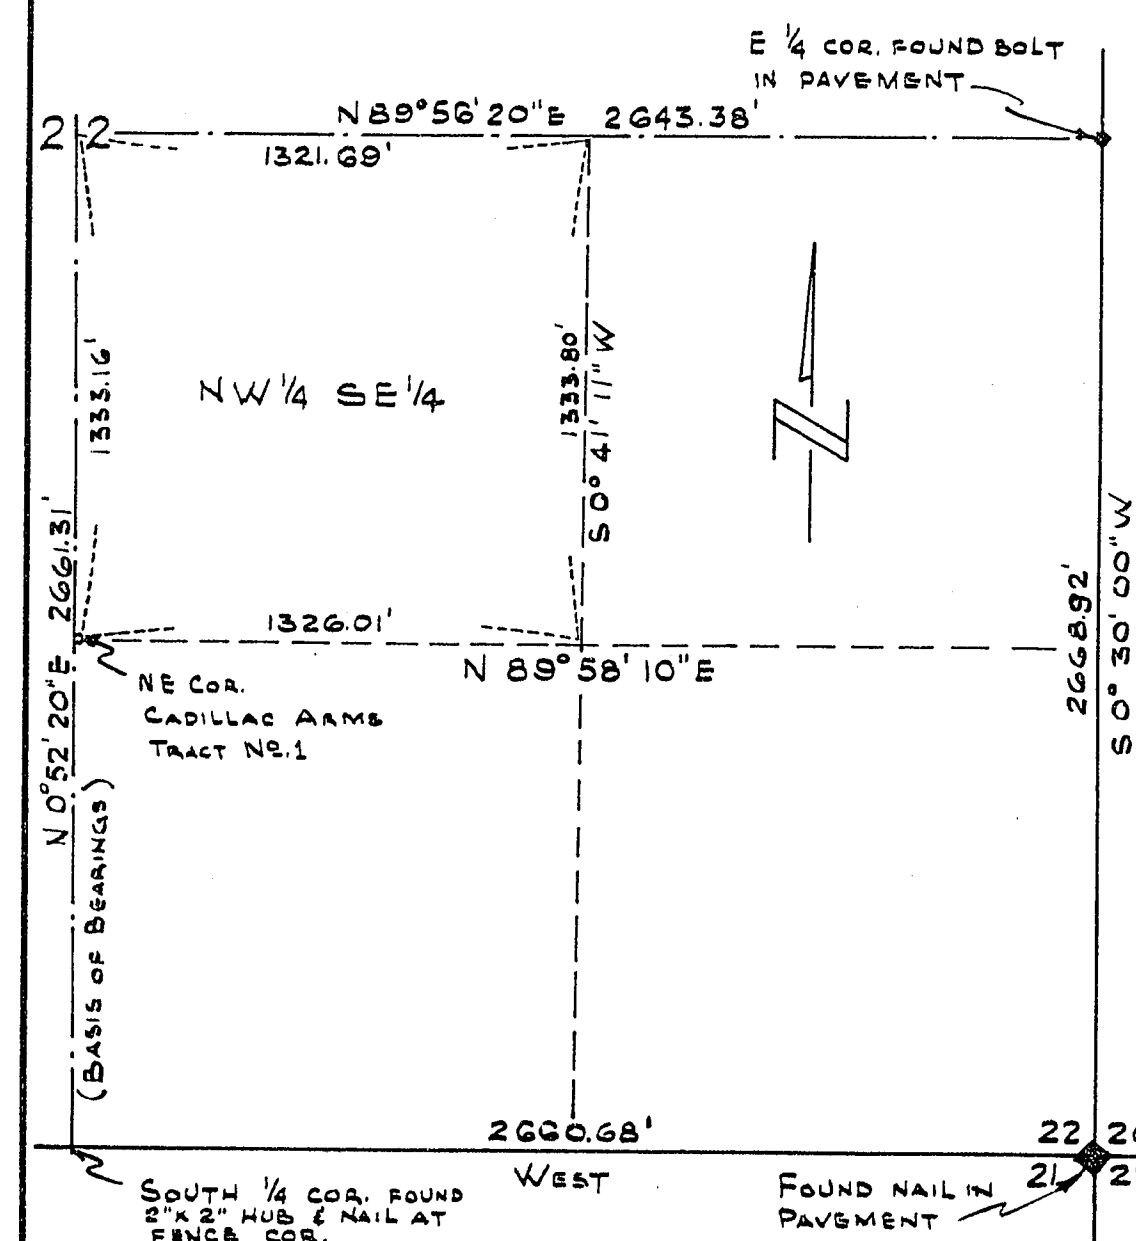

KEY MAP
SHOWING SURVEY OF SE 1/4
OF SEC. 22,
T. 20 S., R. 61 E., M.D.B. & M.
SCALE 1 IN. = 500 FT.

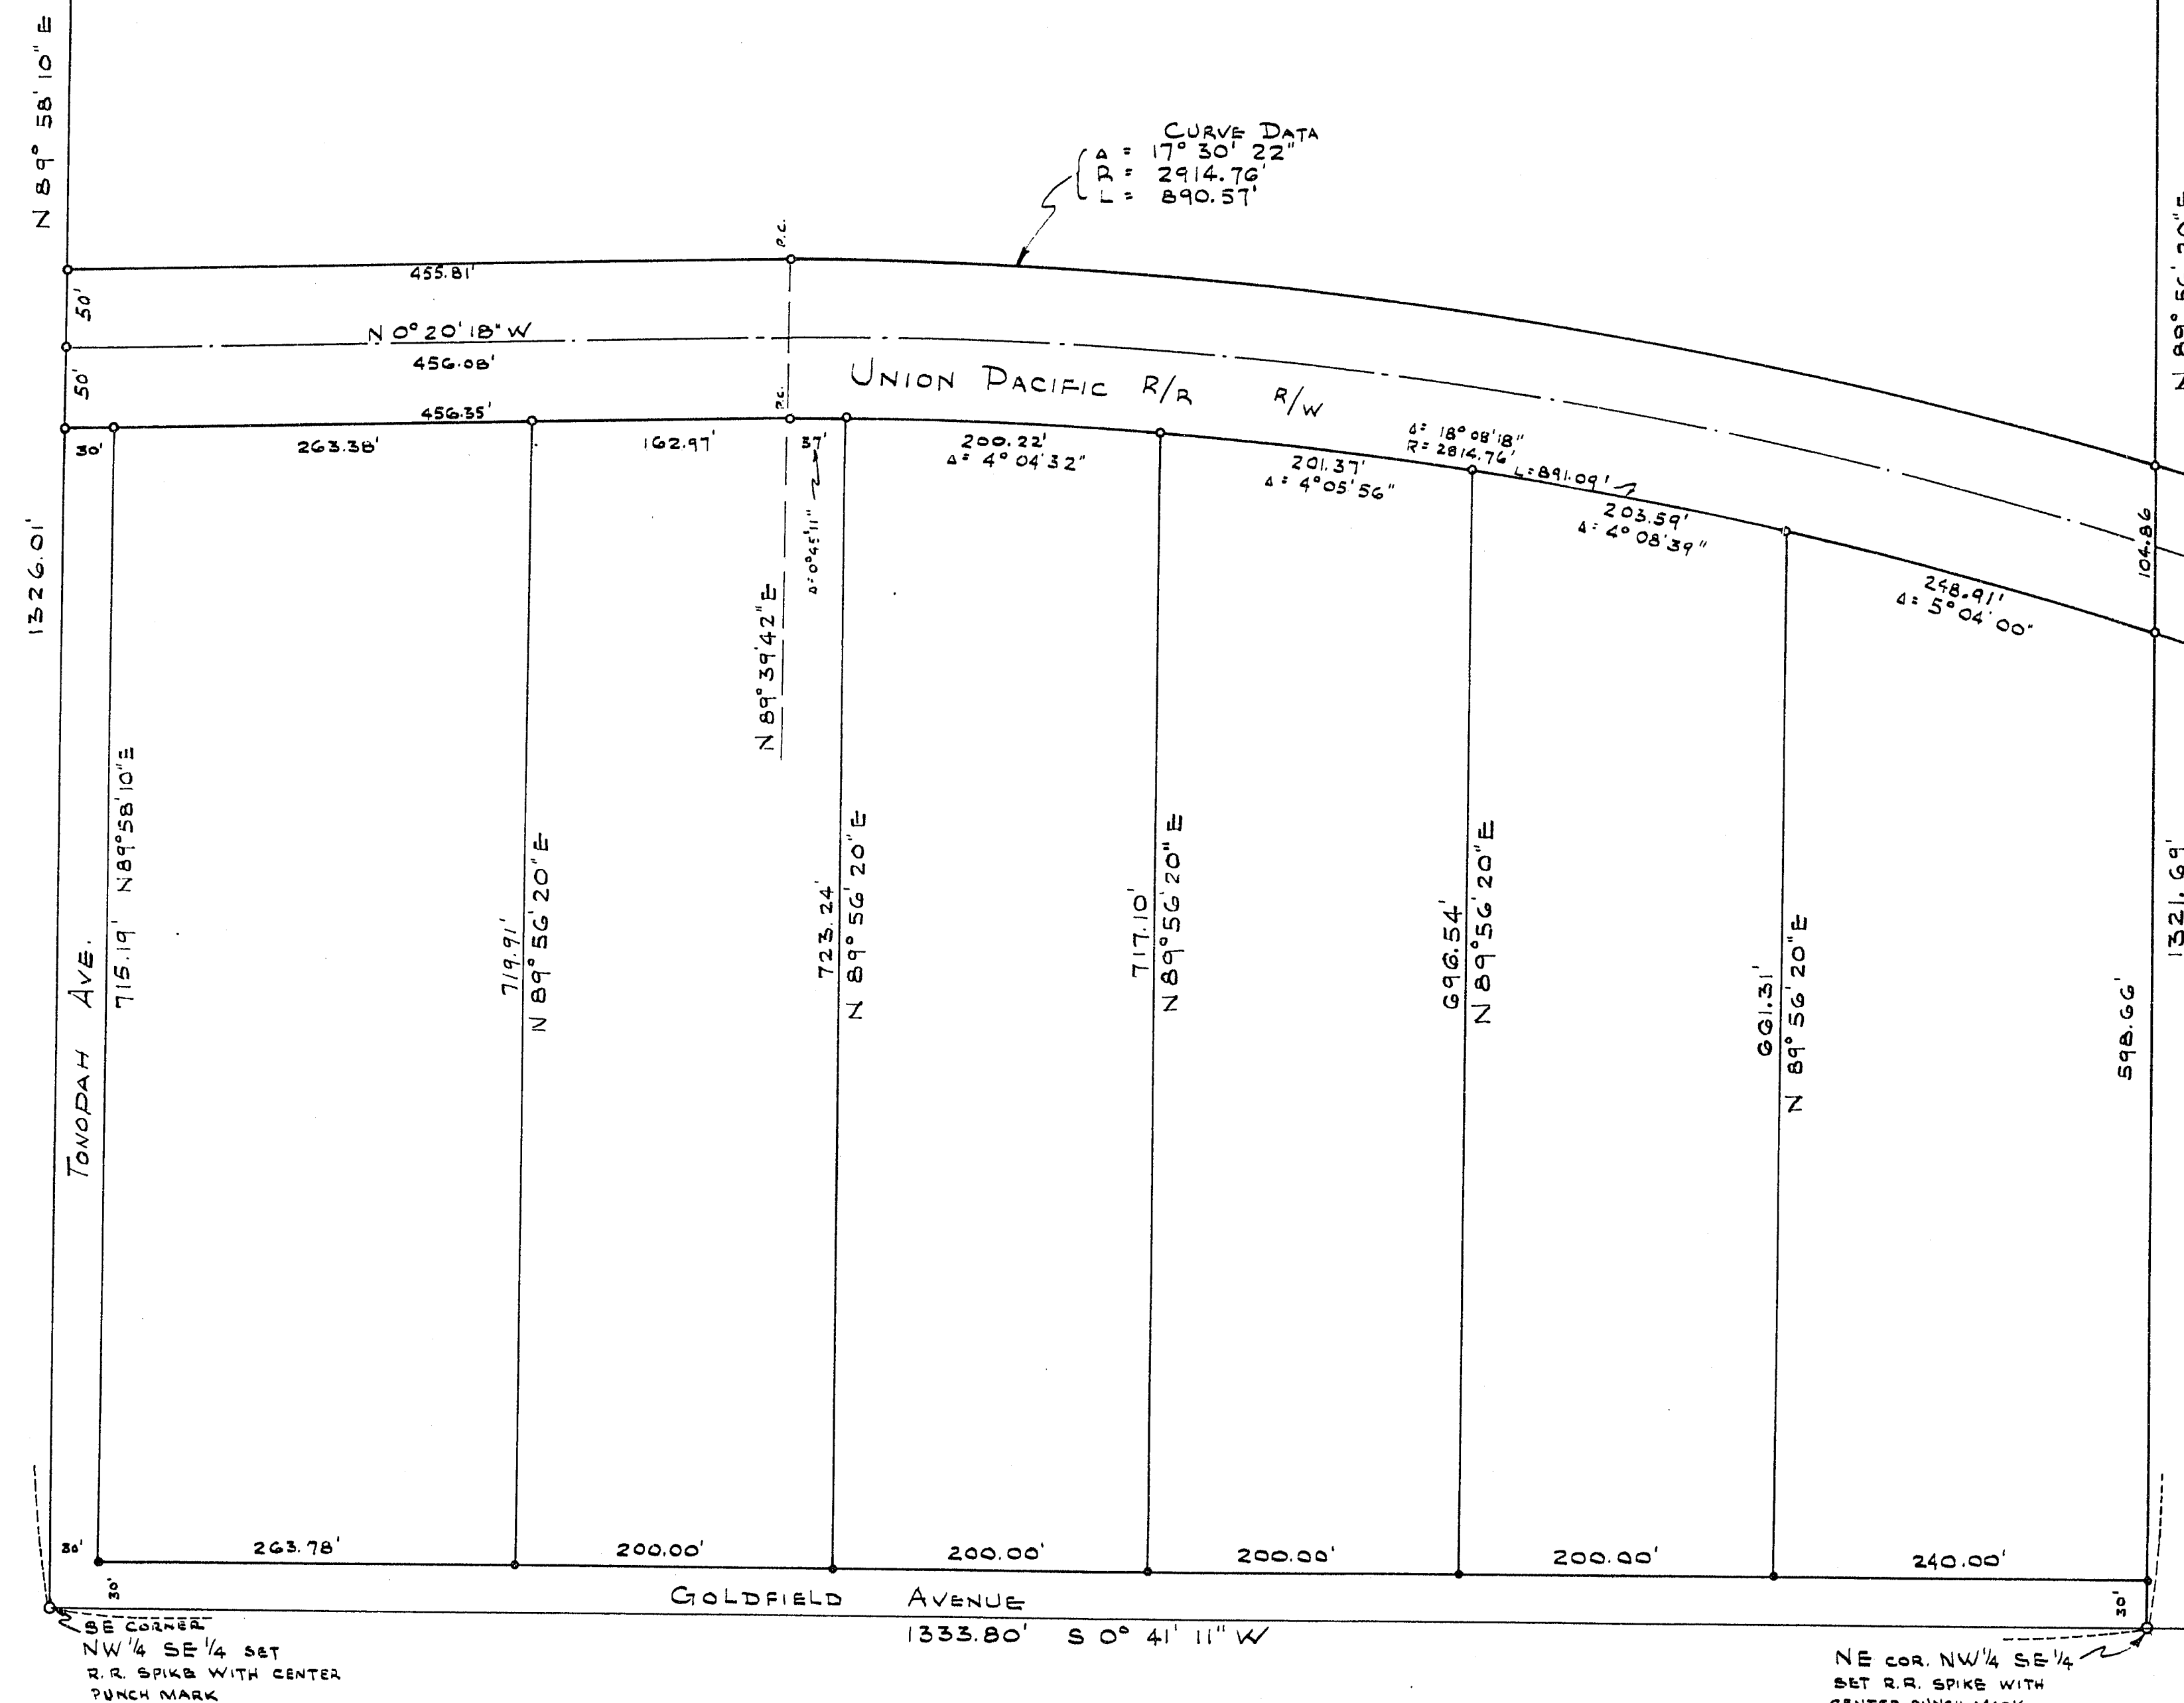

NW 1/4 OF SE 1/4 OF SECTION 22,
T. 20 S., R. 61 E., M.D.B. & M.

89893

Frank D. Redburn, Jr.
7-25-56
6-25-53
CLARK COUNTY, NEVADA
REGISTERED PROFESSIONAL ENGINEER AND
LICENSED LAND SURVEYOR

Frank D. Redburn, Jr.
7-25-56
6-25-53
CLARK COUNTY, NEVADA
REGISTERED PROFESSIONAL ENGINEER AND
LICENSED LAND SURVEYOR

MAP OF SURVEY
FOR
ELIZABETH T., LOUIS F. & CARL T. WANKA
OF
NW 1/4 OF THE SE 1/4
OF SECTION 22,
T. 20 S., R. 61 E., M.D.B. & M.
CLARK COUNTY, NEVADA.