


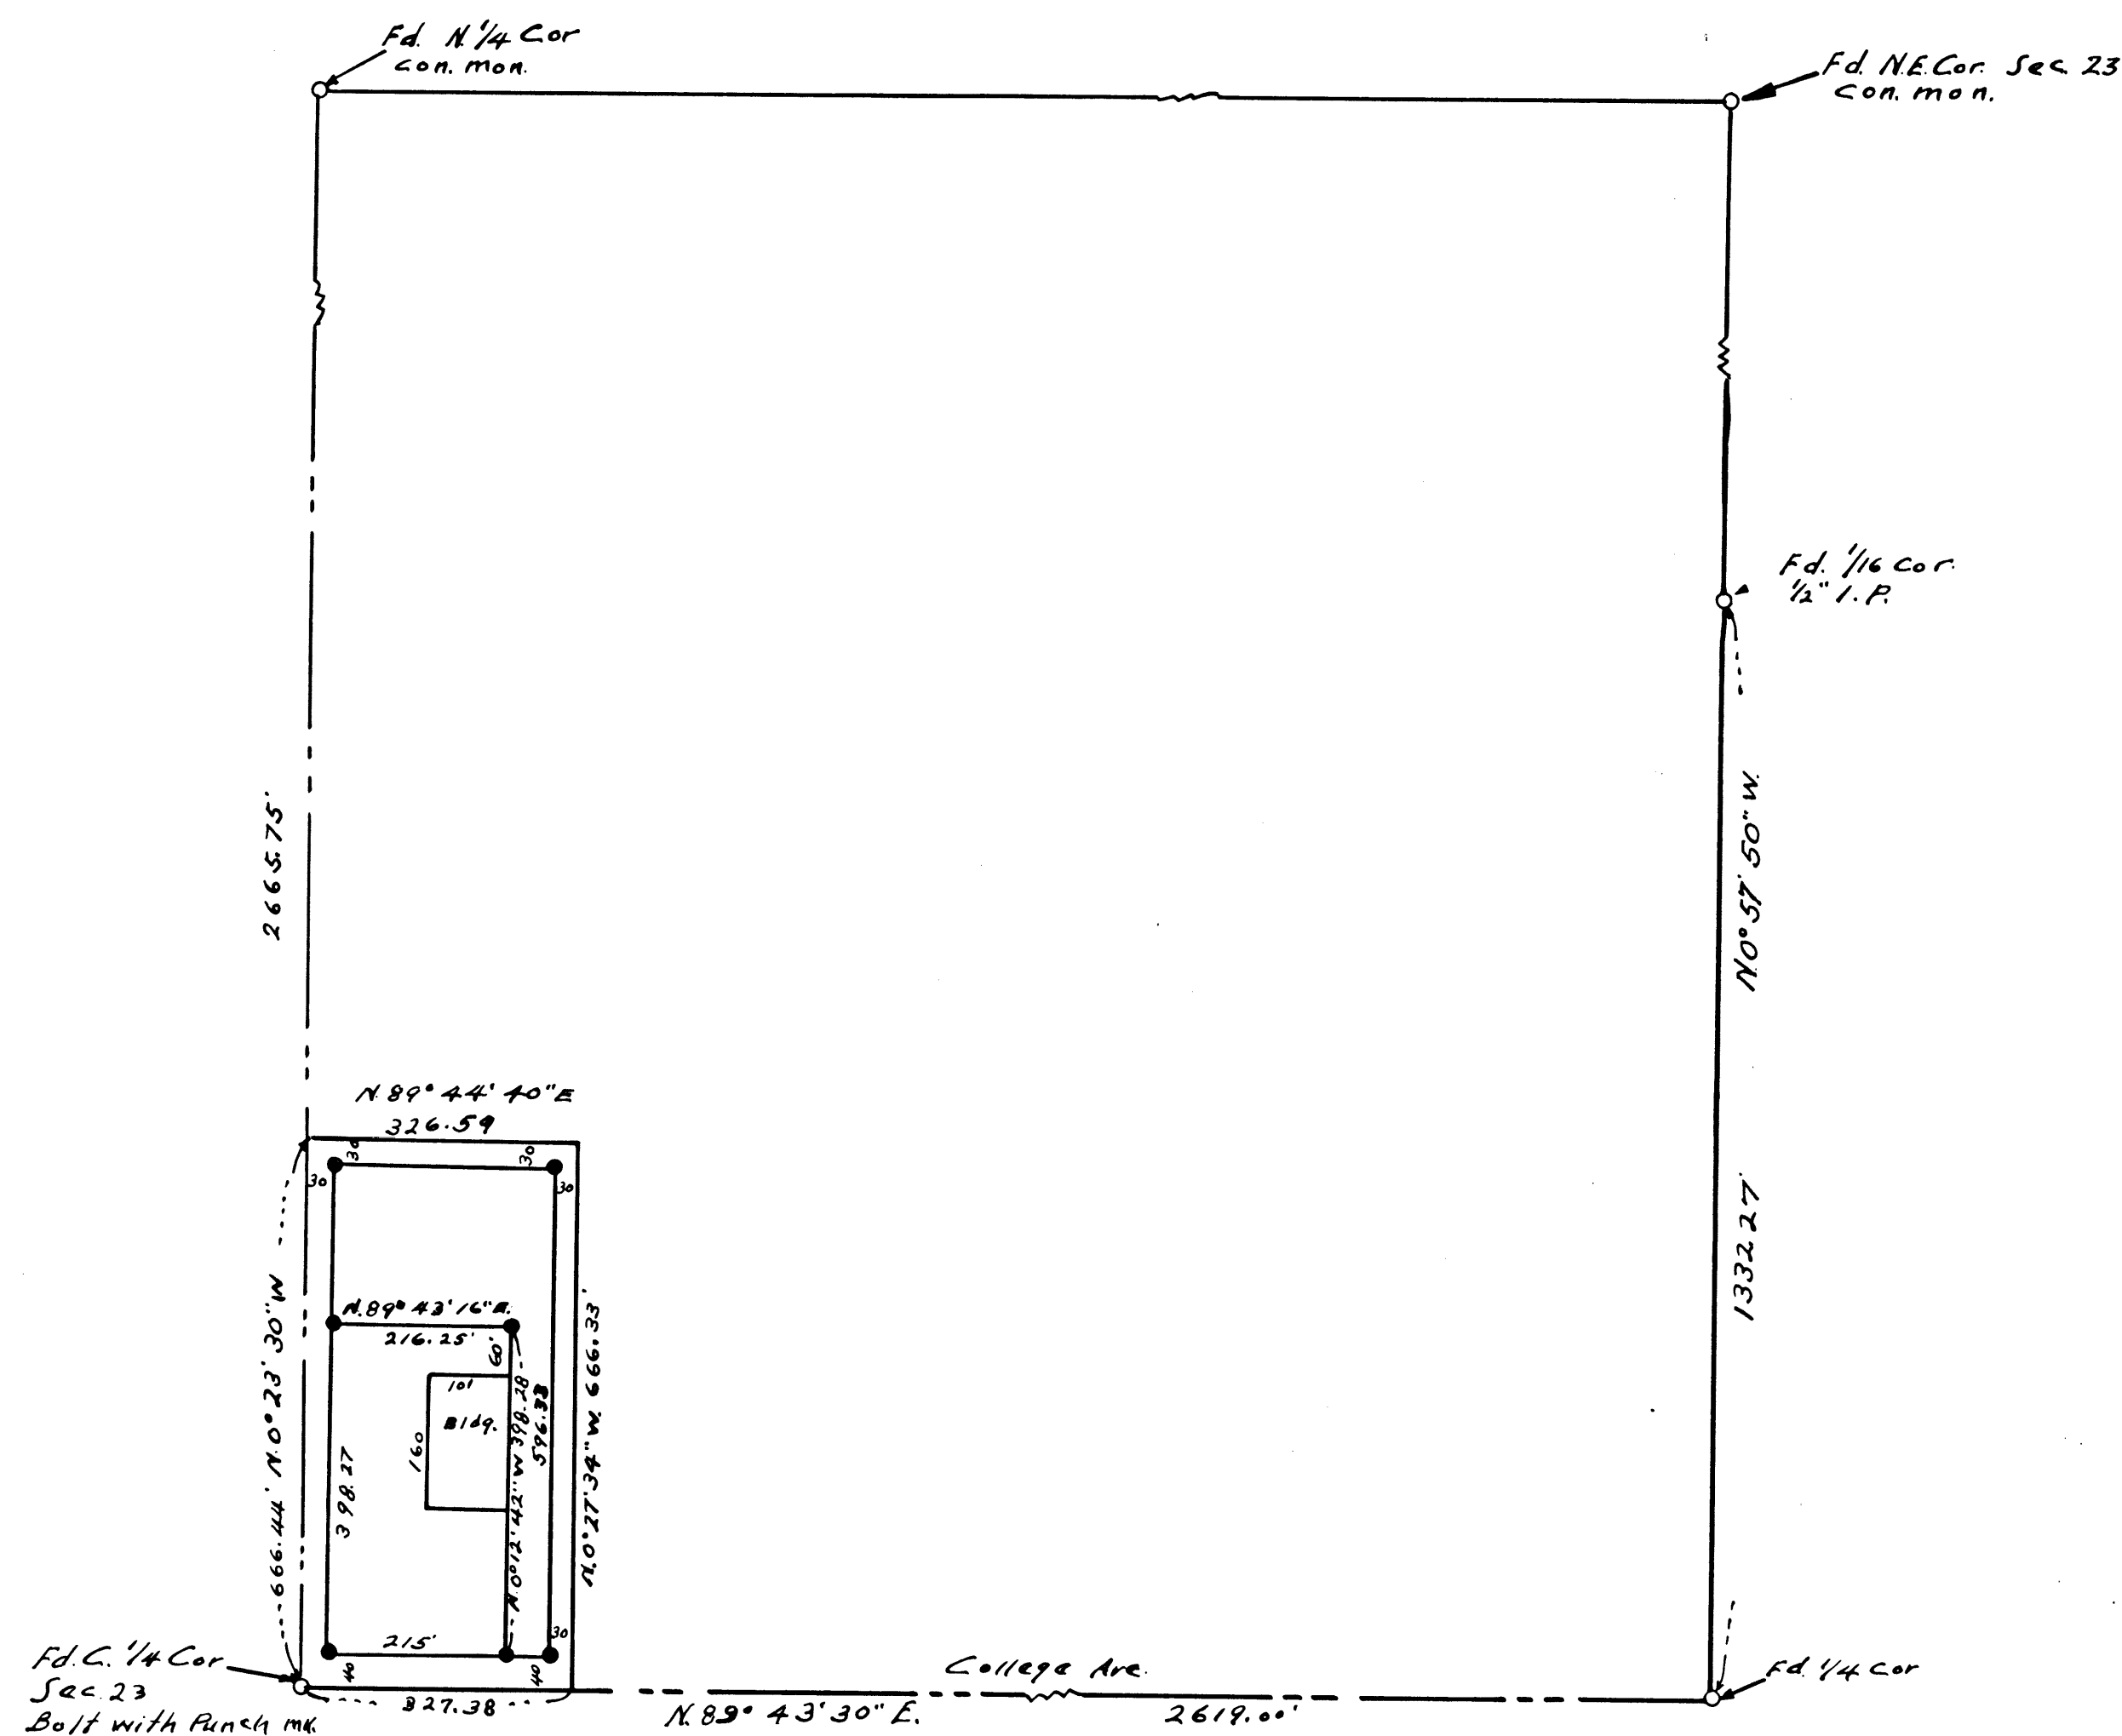

I, L.A. Harris, a duly registered engineer and land surveyor, do hereby certify that this map truly and correctly represents the results of a survey made by me at the request of Yee Cho and completed on the 13th day of October 1956

L. Q. Harris

Registered Engineer and Land Surveyor
RE 24

- Indicates Points Found
- Indicates Points Set

Basis of Bearings: North boundary Line of Williams Addition
Clark County, Nevada, as Recorded in Book 1, of Plats, Page 123, as
N. 89° 43' 00" E.

SCALE: 1-IN.=200 FT.



92566

L. A. Harris
10-29-56 4:18 P.
6 61

210

L. Q. Harris

146

210

N

SURVEY
OF
W $\frac{1}{2}$ SW $\frac{1}{4}$ SW $\frac{1}{4}$ NE $\frac{1}{4}$ SEC. 23
T.20S., R.61E., N.D.B. & M.
FOR
YEE CHO, LAS VEGAS, NEV.
717.2-14

NLV

FILE 6 PAGE 61

