



PALOMINO GARDENS

MONUMENT TIE MAP
SW 1/4 SE 1/4 SEC 32 T20S R61E MDM
CITY OF LAS VEGAS, CLARK COUNTY, NEV.
BOOK 26, PAGE 40

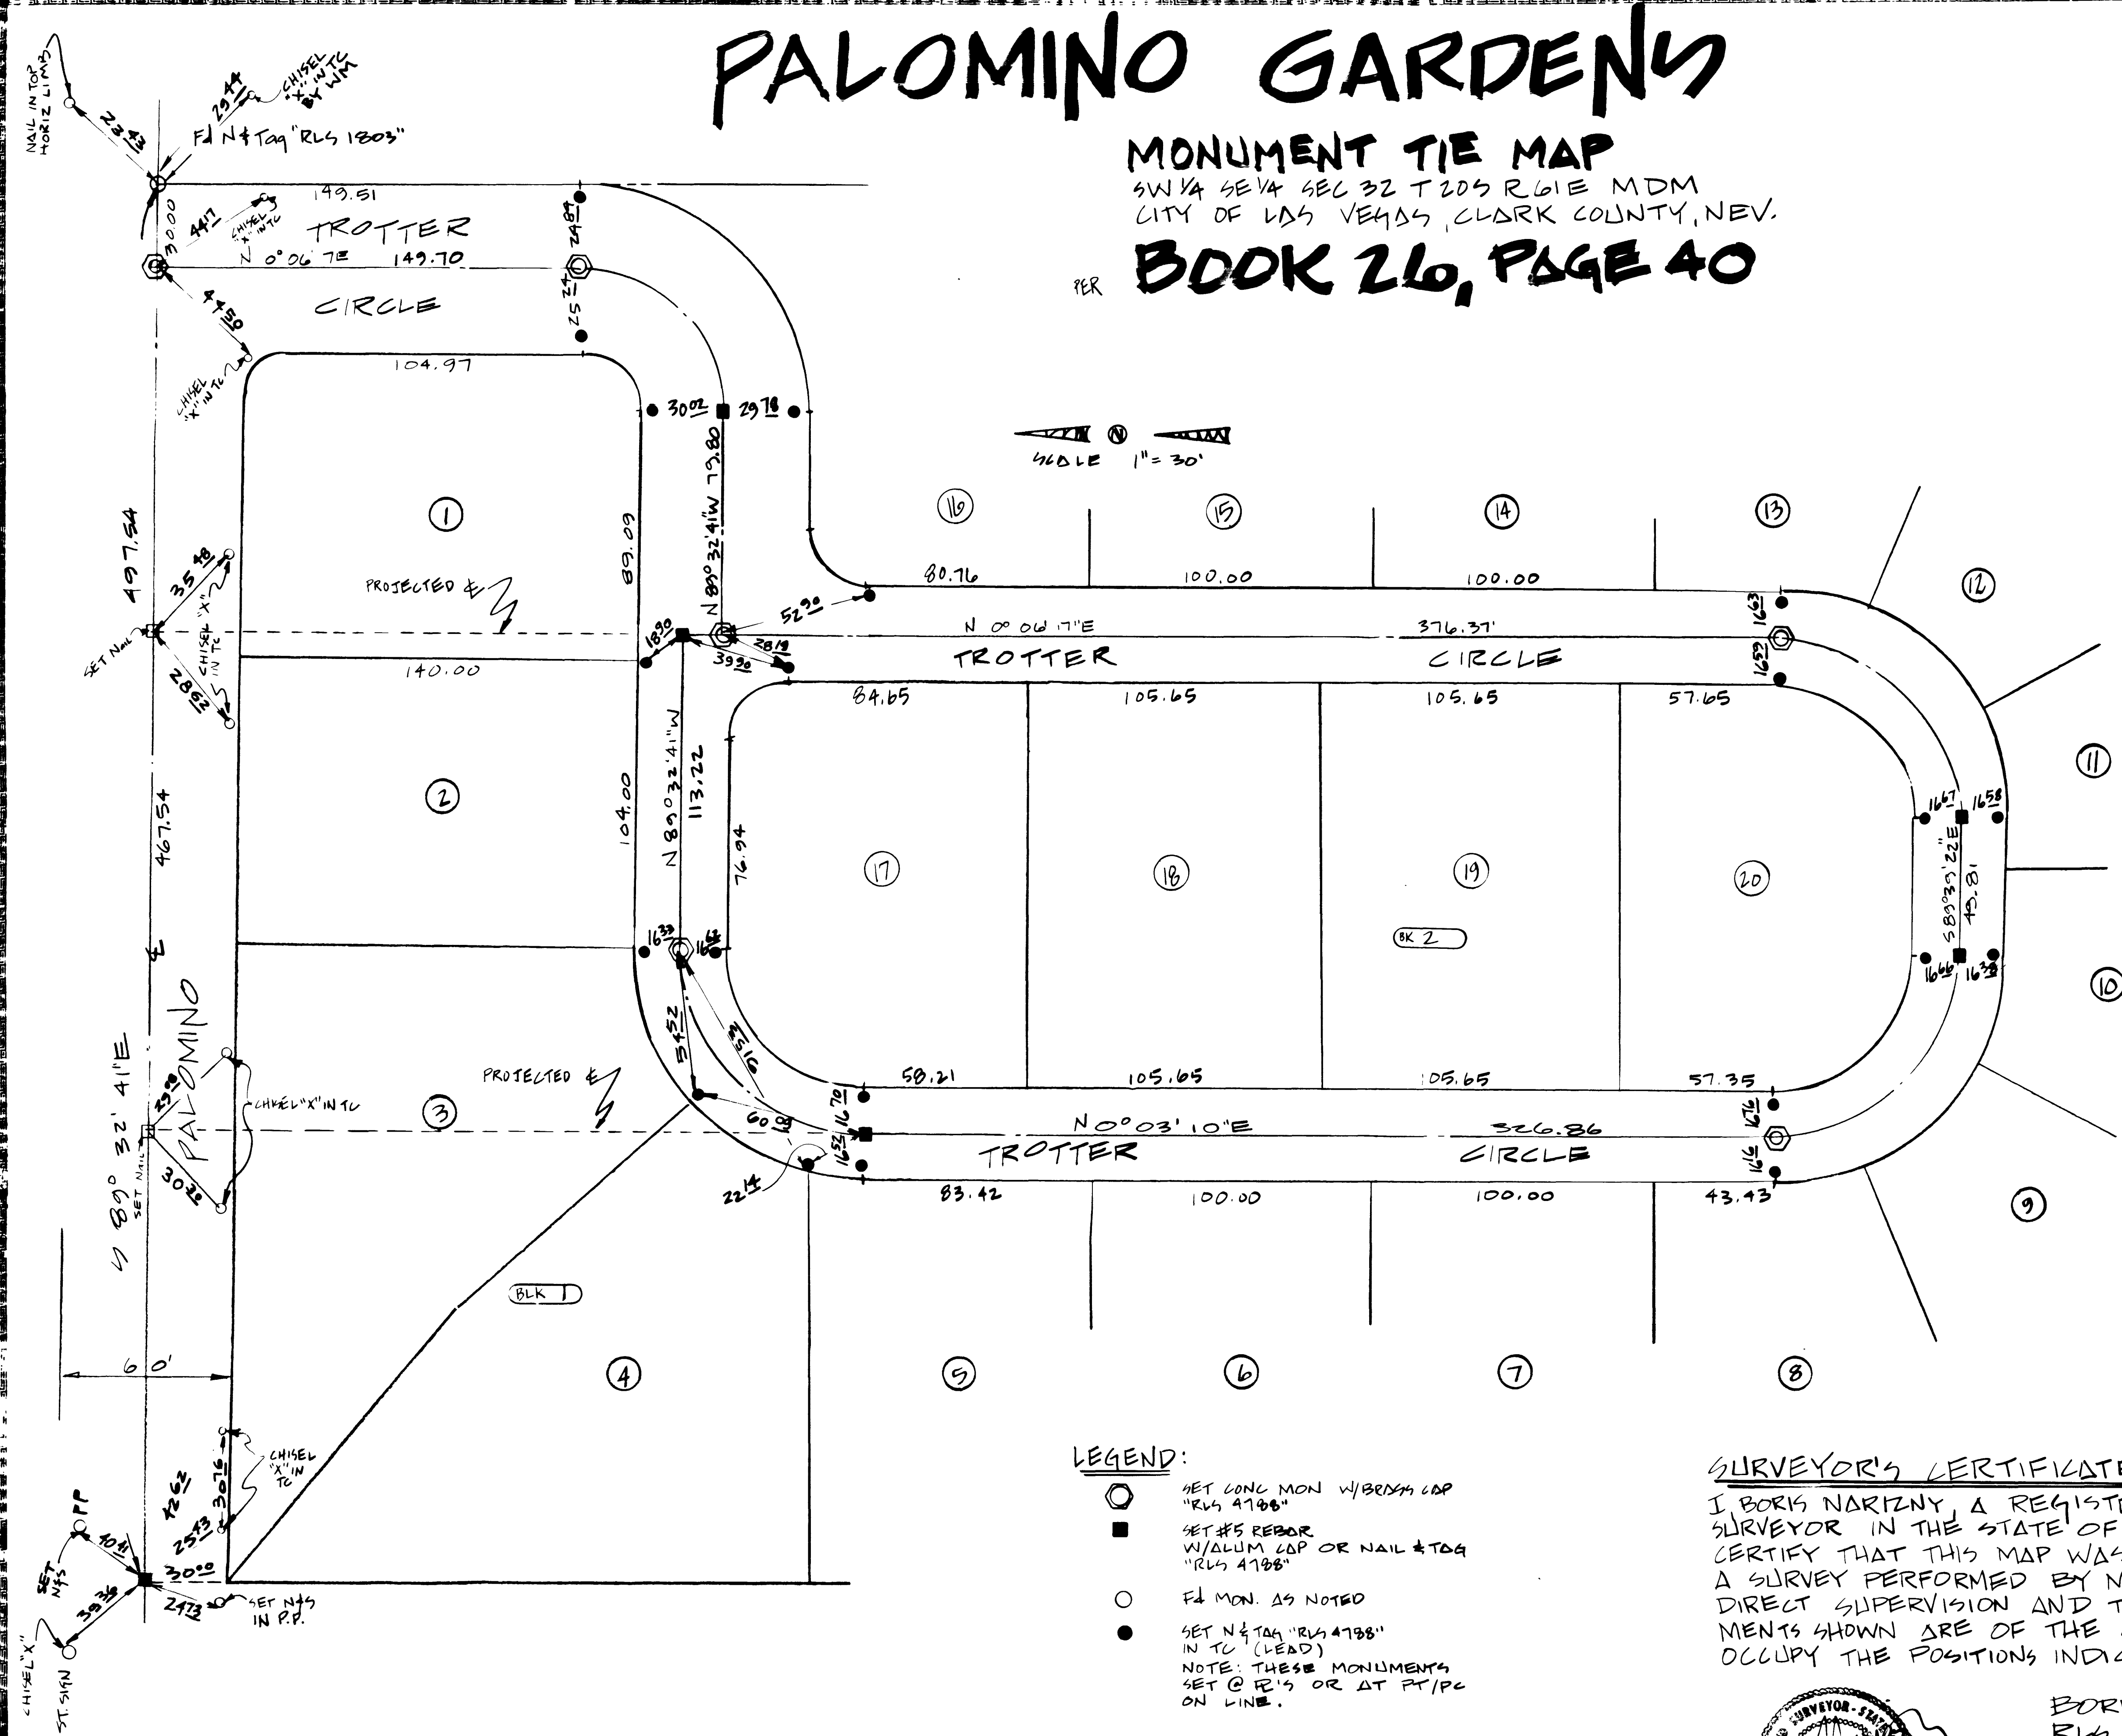

SURVEYOR'S CERTIFICATE
I, BORIS NARIZNY, A REGISTERED LAND SURVEYOR IN THE STATE OF NEVADA HEREBY CERTIFY THAT THIS MAP WAS PREPARED FROM A SURVEY PERFORMED BY ME OR UNDER MY DIRECT SUPERVISION AND THAT THE MONUMENTS SHOWN ARE OF THE CHARACTER AND OCCUPY THE POSITIONS INDICATED.

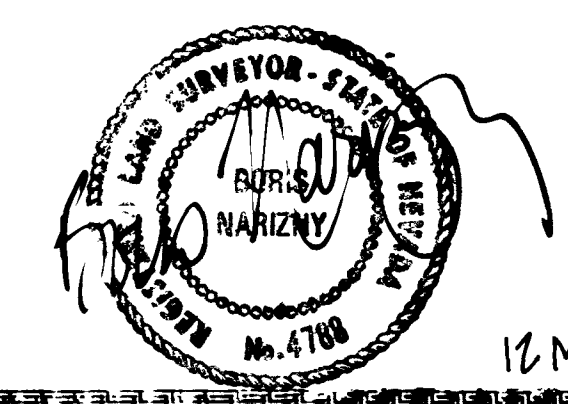

BORIS NARIZNY
RLS 4788

12 MAY 1989

MAP PREPARED BY: NEPTUNE SURVEYING & ENGINEERING
BLOG F SUITE 104 3111 S. VALLEY VIEW
LAS VEGAS, NEV. 89102 (702) 362-2850

2789

