


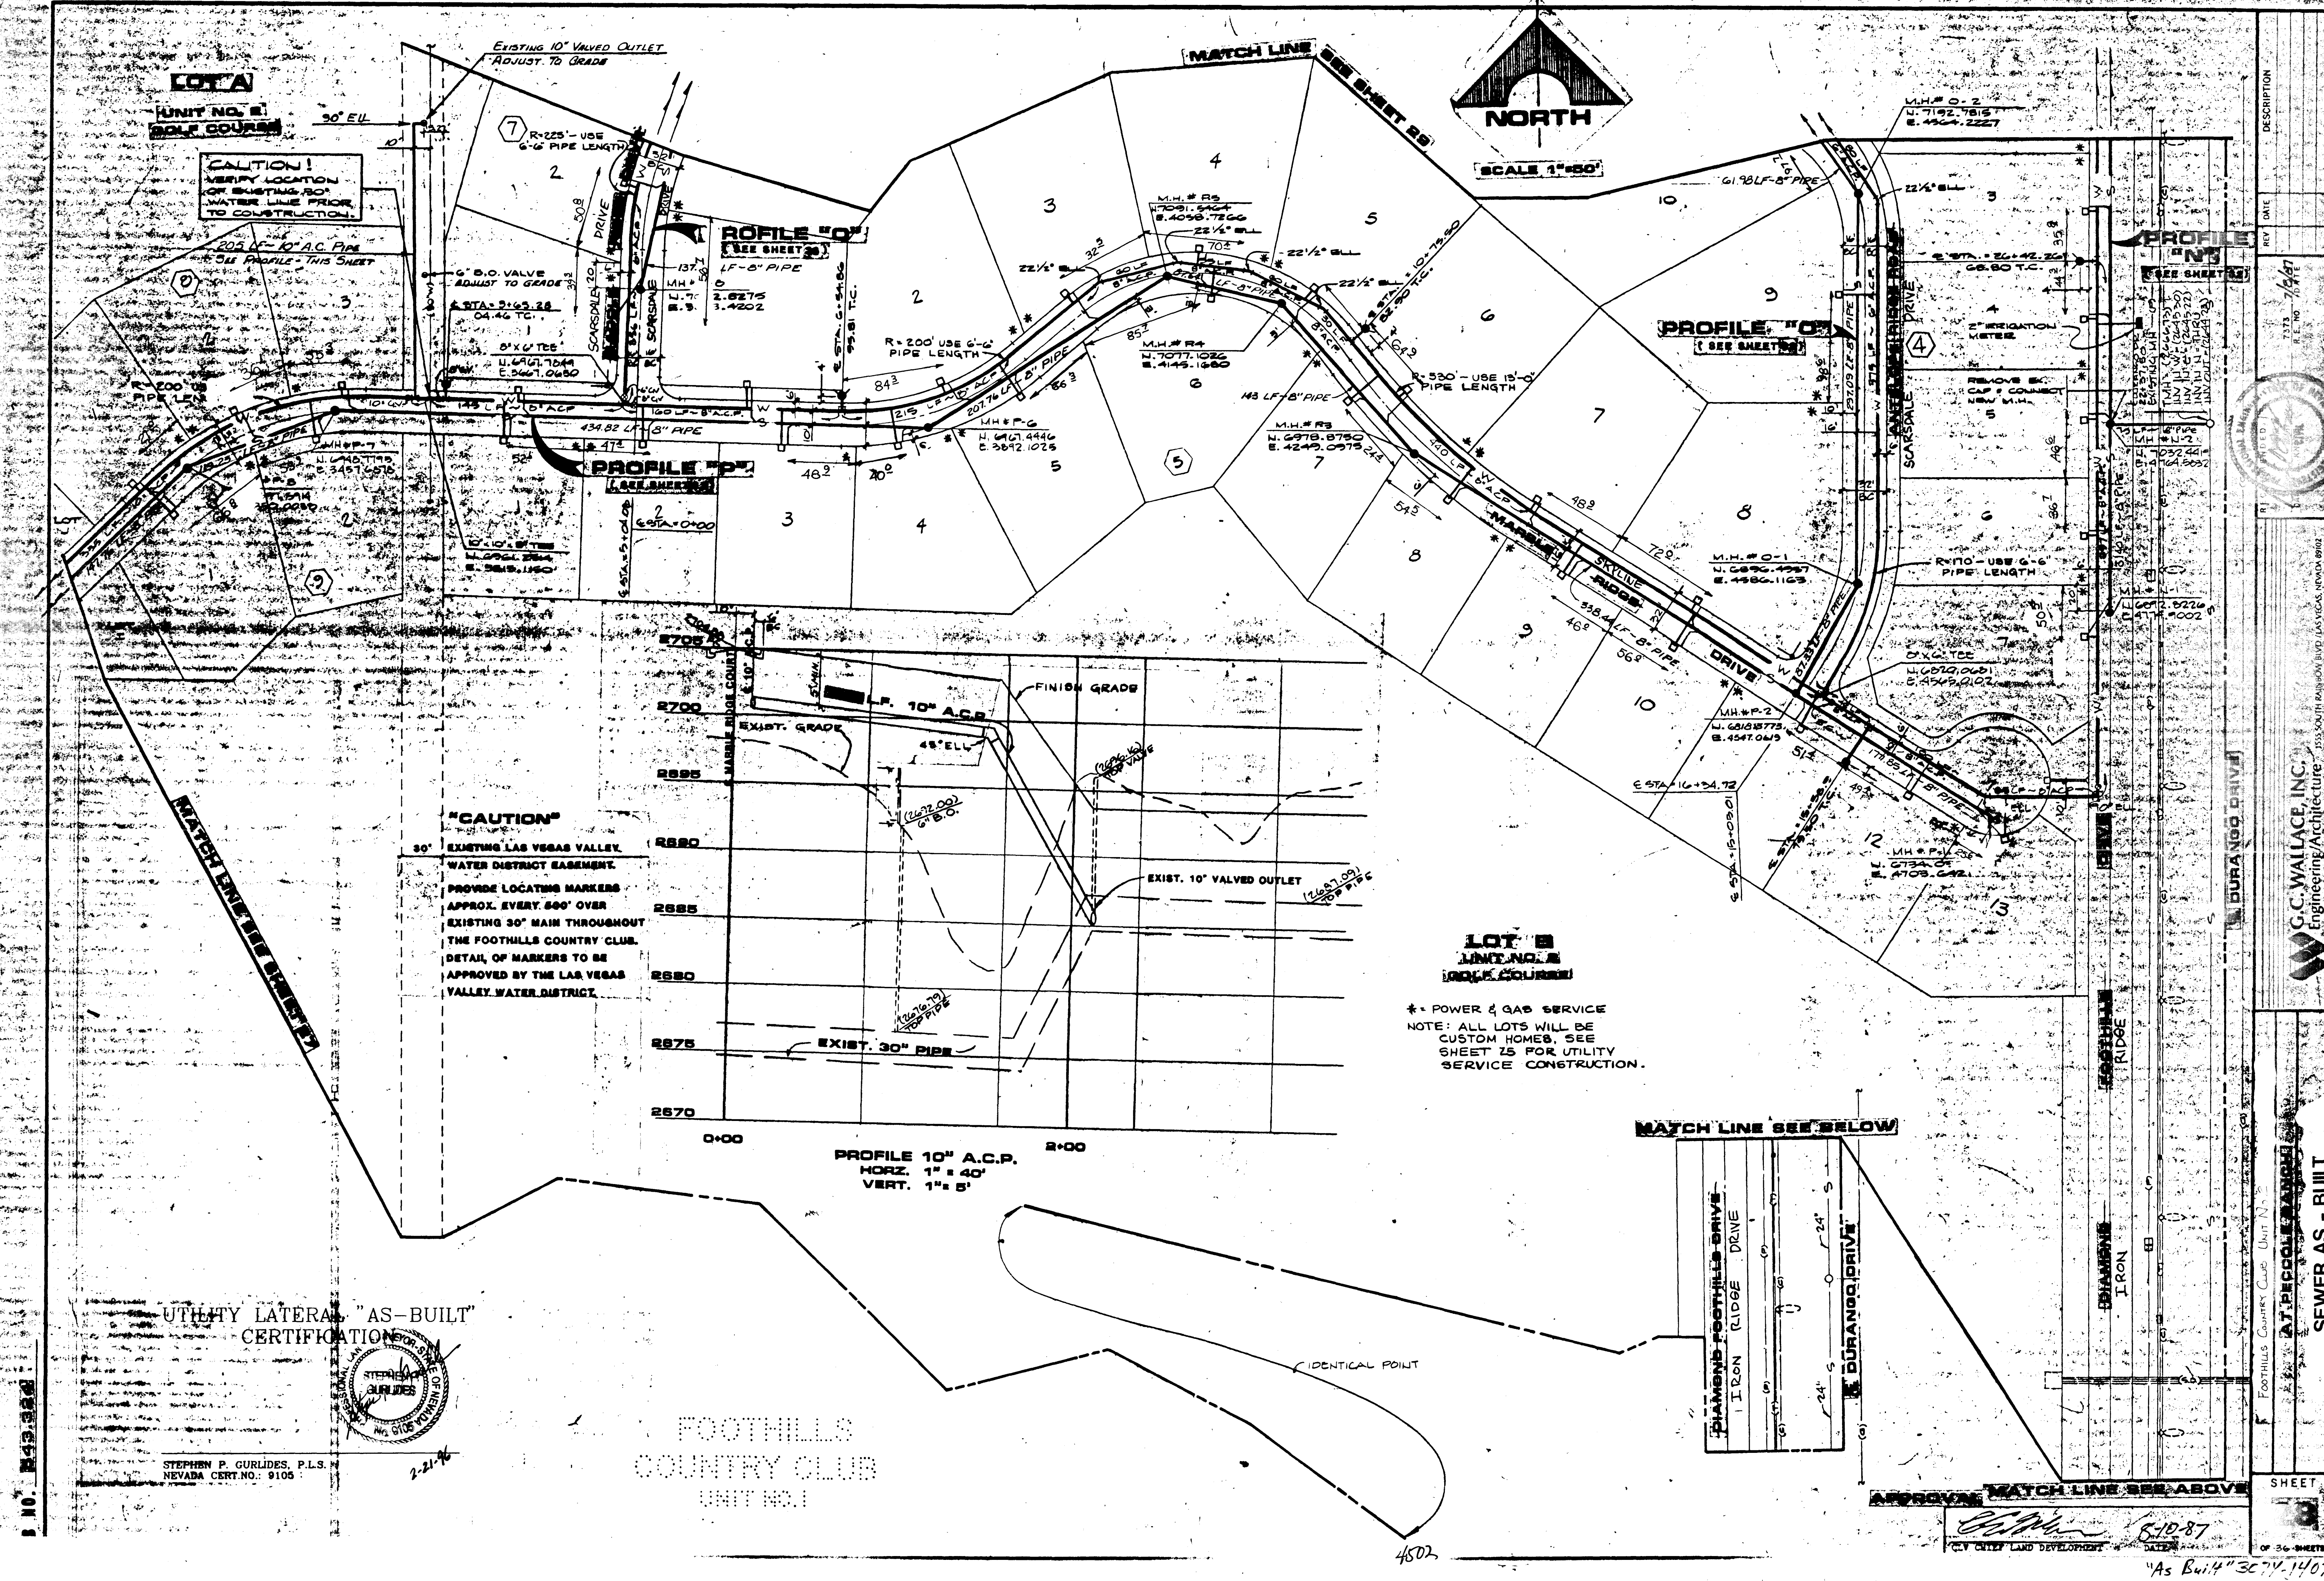


CAUTION!
VERIFY LOCATION
OF EXISTING 30"
WATER LINE PRIOR
TO CONSTRUCTION.

"CAUTION"
EXISTING LAS VEGAS VALLEY
WATER DISTRICT EASEMENT.
PROVIDE LOCATING MARKERS
APPROX. EVERY 500' OVER
EXISTING 30" MAIN THROUGHOUT
THE FOOTHILLS COUNTRY CLUB.
DETAIL OF MARKERS TO BE
APPROVED BY THE LAS VEGAS
VALLEY WATER DISTRICT.

POWER & GAS SERVICE
NOTE: ALL LOTS WILL BE
CUSTOM HOMES. SEE
SHEET 25 FOR UTILITY
SERVICE CONSTRUCTION.

UTILITY LATERAL "AS-BUILT"
CERTIFICATION

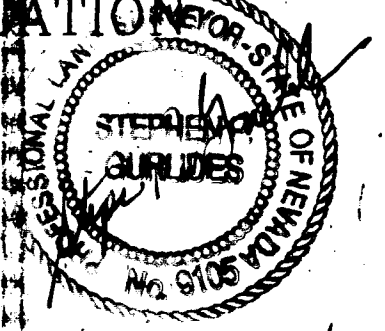

STEPHEN P. GURLIDES, P.L.S.
NEVADA CERT. NO. 9105

FOOTHILLS
COUNTRY CLUB
UNIT NO. 1

REVISIONS
DATE
DESCRIPTION
7/19/87
E. NO. 1407-2
G.C. WALLACE, INC.
Engineering/Architecture
1155 SOUTH RAINBOW BLVD. LAS VEGAS, NEVADA 89103
FOOTHILLS COUNTRY CLUB UNIT NO. 1
SEWER AS - BUILT
SHEET
OF 36 SHEETS
DATE
8-10-87
CLV ENTRY LAND DEVELOPMENT

