





MATCH LINE SEE SHEET 26  
E STA 46+47.71  
71.85 TC 4

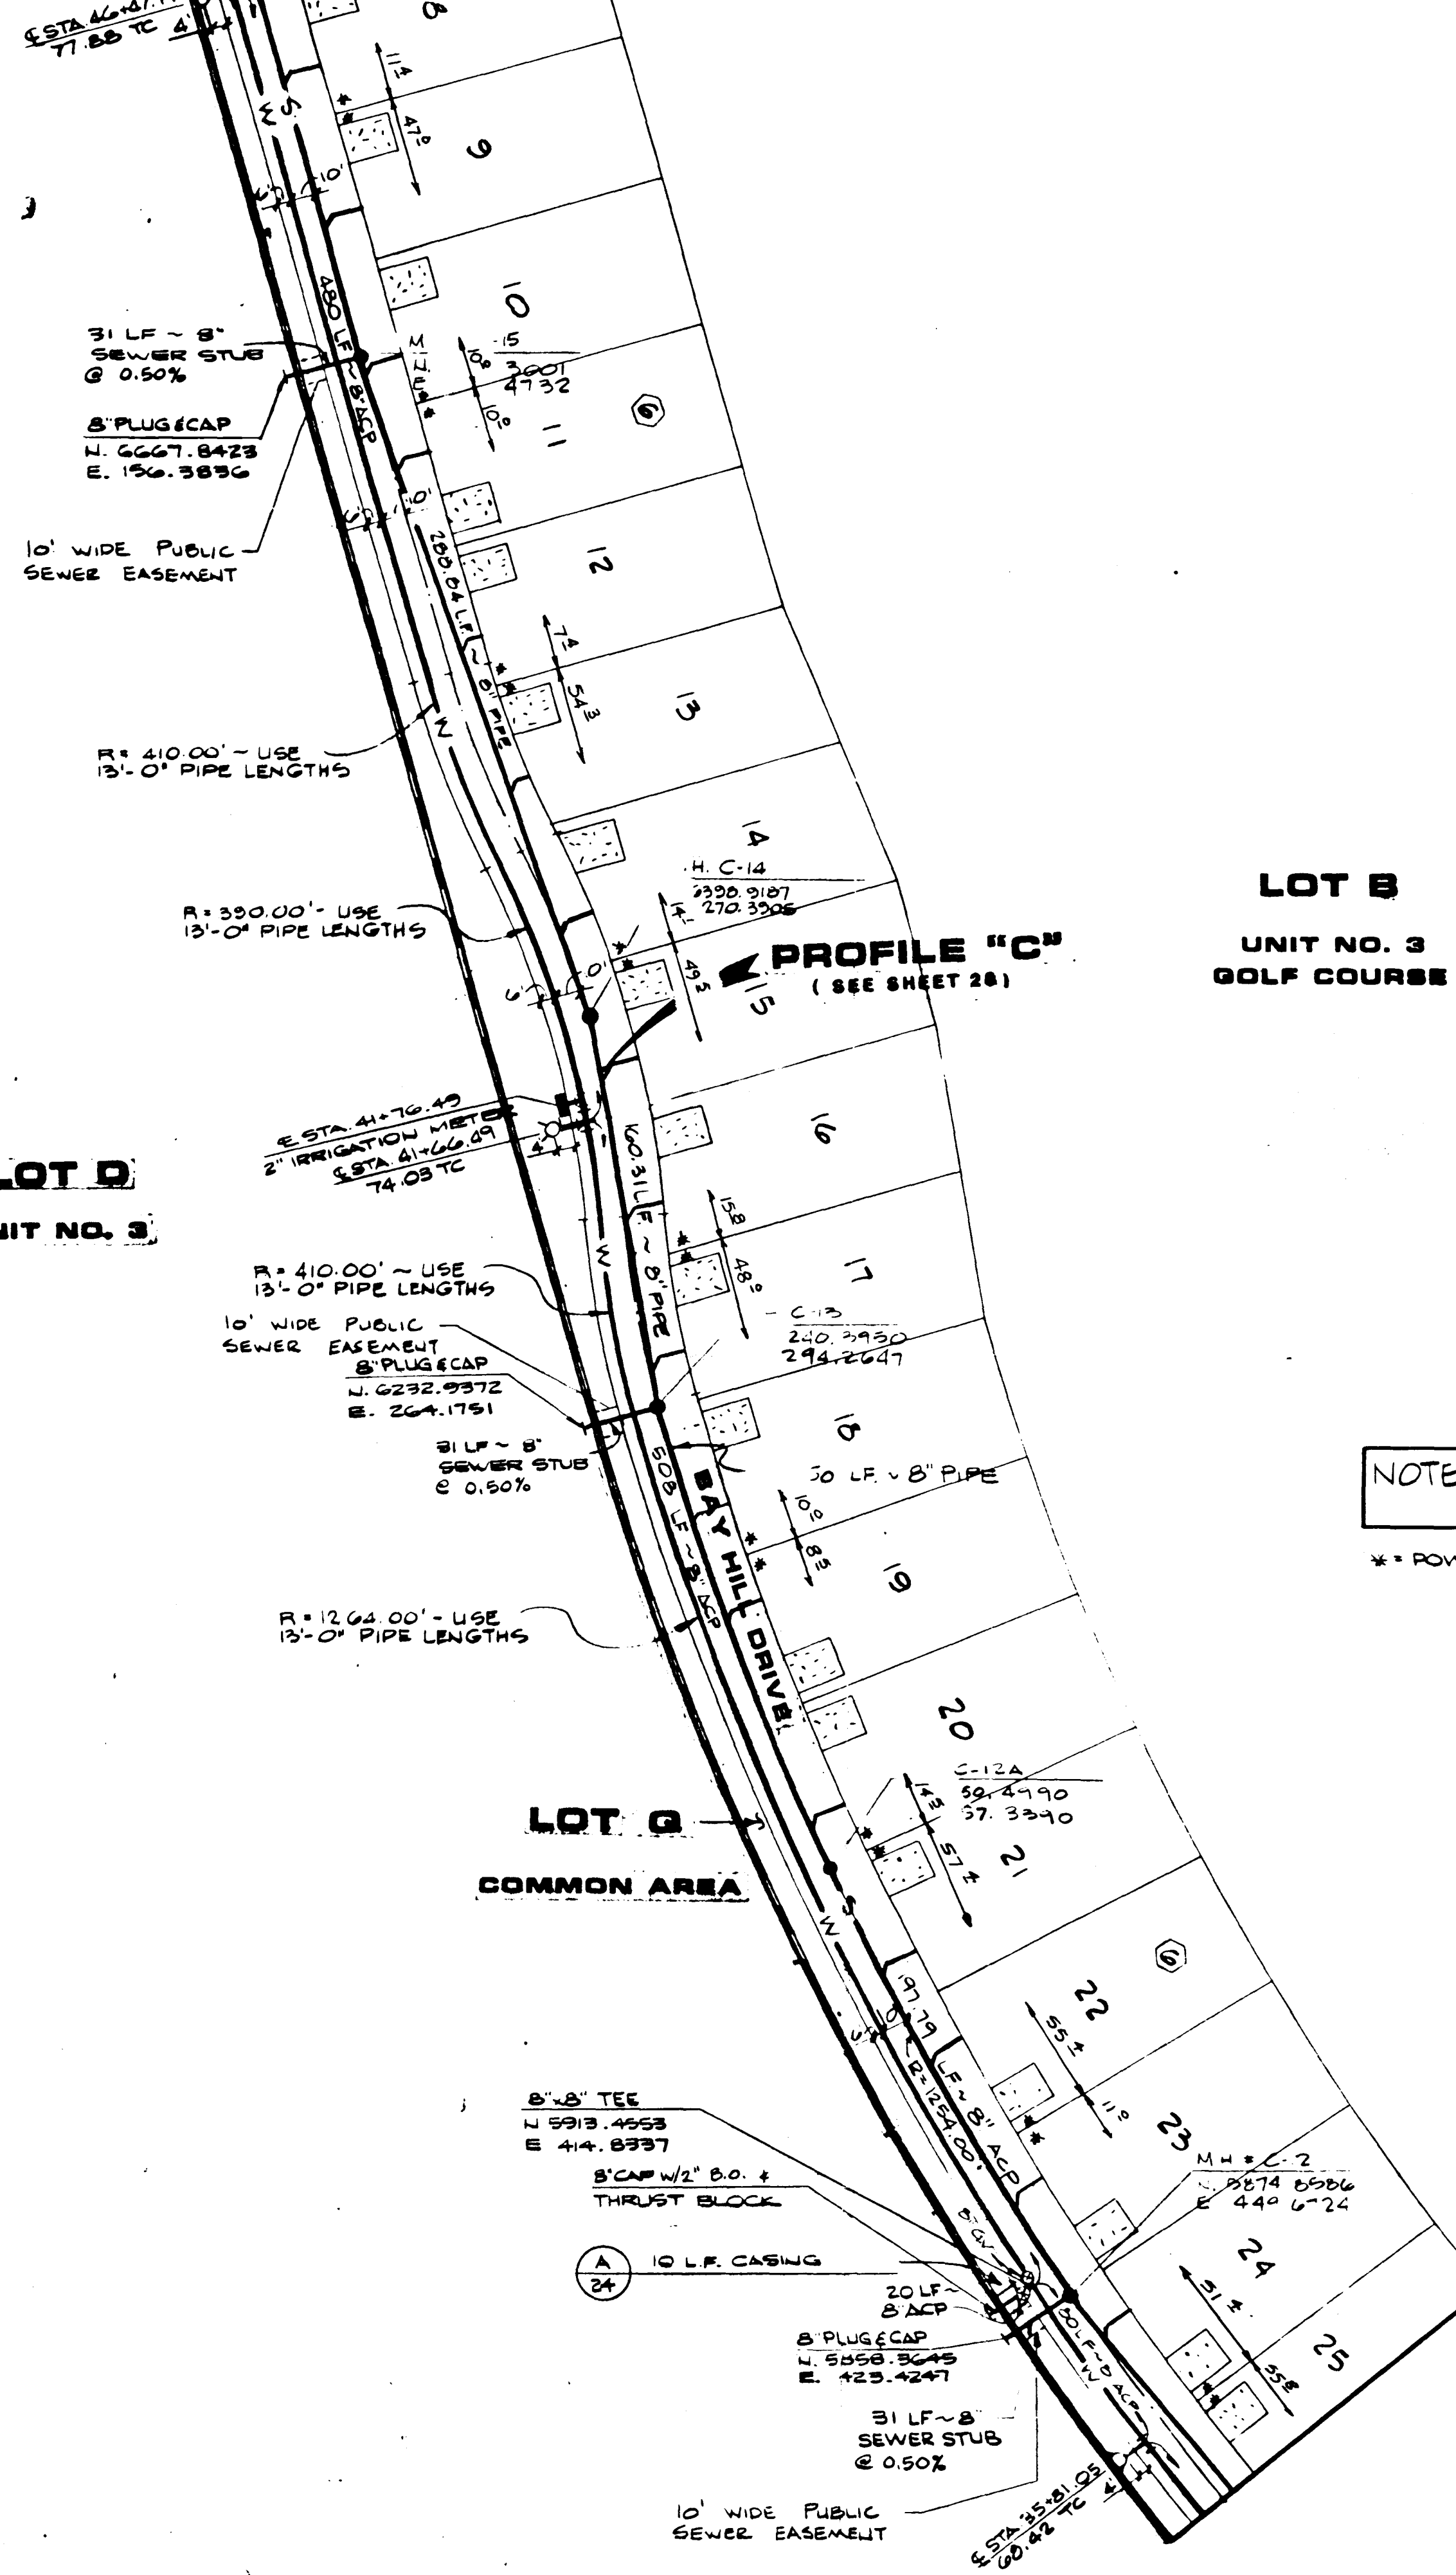

LOT B  
UNIT NO. 3  
GOLF COURSE

FUTURE FOOTHILLS COUNTRY CLUB  
UNIT NO. 4  
LOT C

UTILITY LATERAL "AS-BUILT"  
CERTIFICATION

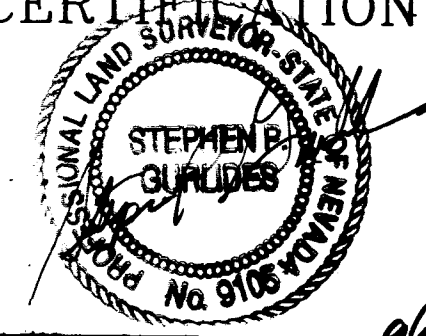

STEPHEN P. GURLIDES, P.L.S.  
NEVADA CERT. NO.: 9105

NOTE: LOTS 7-25, BLOCK 6  
RECEIVE 1" METERS BY L.V.V.W.D

\*\* POWER & GAS SERVICE LOCATION

MATCH LINE SEE SHEET 24

REV	DATE	DESCRIPTION
1	2/17/89	AS-BUILT

FOOTHILLS COUNTRY CLUB UNIT NO. 3	SEWER AS-BUILT
-----------------------------------	----------------


SHEET	25
OF 25 SHEETS	

James A. Miller  
LAS VEGAS VALLEY WATER DISTRICT  
DATE: 2/17/89

"As Built" 307Y-1407-3

B NO. 25000

#499

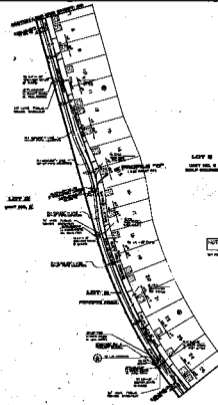

LOT 10  
 LOT 11 &  
 WINDMILL ROAD

PUTNAM PASTURELAND SUBDIVISION  
 LOT 12



NOTE: LOT 10, 11, 12, 13 &  
 14 ARE SUBJECT TO  
 THE PLANS & SPECIFICATIONS THEREON.

*James H. Miller*  
 100 West 10th Street, Suite 100  
 Oklahoma City, Oklahoma 73101  
 405-233-1111