


EXISTING MARC A. KAHRE ELEMENTARY SCHOOL

EXISTING DORTHY EISENBERG ELEMENTARY SCHOOL

SEWER AS-BUILT MAP FOXFIRE RANCH UNIT 5

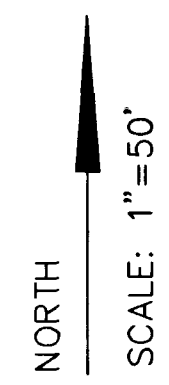

NOTE:
 1) SEWER SERVICE LOCATIONS AS SHOWN ON THIS MAP WERE PROVIDED BY THE CONTRACTOR. ALPHA ENGINEERING ASSUMES NO LIABILITY FOR MISPLACED SERVICES REPRESENTED ON THIS MAP.
 2) ALL SEWER MAIN MATERIALS SDR - 35.

SHEET		DRAWN BY: SMD		DATE: 02/10/99	
TITLE		DESIGNED BY:		PROJECT NO: 607621	
PULTE HOMES CORP. 1635 VILLAGE CENTER CIR LAS VEGAS NV (702)256-7900		ENGINEERING COMPANY		SCALE: 1"=50'	
ALPHA &		FOXFIRE RANCH UNITS 5		SHEET 1 OF 1 SHEETS	
REV. DATE BY		DRAWING NO. 307Y-4288-5		"As-Built"	

