

**SURVEYOR'S CERTIFICATE**

I, R. GUY DOTY, A PROFESSIONAL LAND SURVEYOR LICENSED IN THE STATE OF NEVADA, CERTIFY THAT:

1. THIS MAP IS AN ACCURATE REPRESENTATION OF THE LANDS SURVEYED UNDER MY DIRECT SUPERVISION AT THE INSTANCE OF: WELLS CARGO, INC.
2. THE LANDS SURVEYED LIE WITHIN SECTIONS 7, 8, 17, & 18, TOWNSHIP 19 SOUTH, RANGE 60 EAST, M.D.M., CLARK COUNTY, NEVADA, AND THE SURVEY WAS COMPLETED ON MAY 11, 2010.
3. THE MONUMENTS DEPICTED ON THE MAP ARE OF THE CHARACTER SHOWN, OCCUPY THE POSITIONS INDICATED AND ARE OF SUFFICIENT NUMBER AND DURABILITY.
4. THIS SURVEY PLAT DOES NOT CONSTITUTE A SUBDIVISION AS DEFINED BY NEVADA STATE LAW.

R. GUY DOTY  
PROFESSIONAL LAND SURVEYOR  
NEVADA CERTIFICATE NO. 7635  
EXPIRES DECEMBER 31, 2010



**BASIS OF BEARINGS**

SOUTH 89°09'50" EAST, BEING THE BEARING OF THE NORTH LINE OF THE NORTHEAST QUARTER (NE 1/4) OF THE NORTHEAST QUARTER (NE 1/4) OF SECTION 18, TOWNSHIP 19 SOUTH, RANGE 20 EAST, M.D.M., CLARK COUNTY, NEVADA, AS SHOWN ON THE CONSTRUCTION PLANS FOR THE "GRAND TETON STORM DRAIN - TEE PEE LANE TO US-95" FOR THE CITY OF LAS VEGAS, H.T.E. NO. 22726.


**NOTE**

ANY SUBSEQUENT CHANGES TO THIS MAP SHOULD BE EXAMINED AND MAY BE DETERMINED BY REFERENCE TO THE COUNTY RECORDER'S CUMULATIVE MAP INDEX, N.R.S. 278.5695.

THIS SURVEY IS FOR THE PURPOSE OF RESTORING MONUMENTATION ON GRAND TETON DRIVE AFTER STORM DRAIN IMPROVEMENT CONSTRUCTION.

**LEGEND**

- STREET / HIGHWAY CENTER LINE
- SECTION LINE
- QUARTER SECTION LINE
- SIXTEENTH SECTION LINE
- RIGHT-OF-WAY LINE
- FOUND MONUMENTATION AS SHOWN AND DESCRIBED
- △ FOUND REFERENCE MARKER AS SHOWN AND DESCRIBED
- ▲ SET REBAR & 1" ALUMINUM CAP REFERENCE MARKER W/ STAMPED TIE DISTANCE - P.L.S. 7635
- CONCRETE CURB & GUTTER
- EDGE OF ASPHALT PAVING

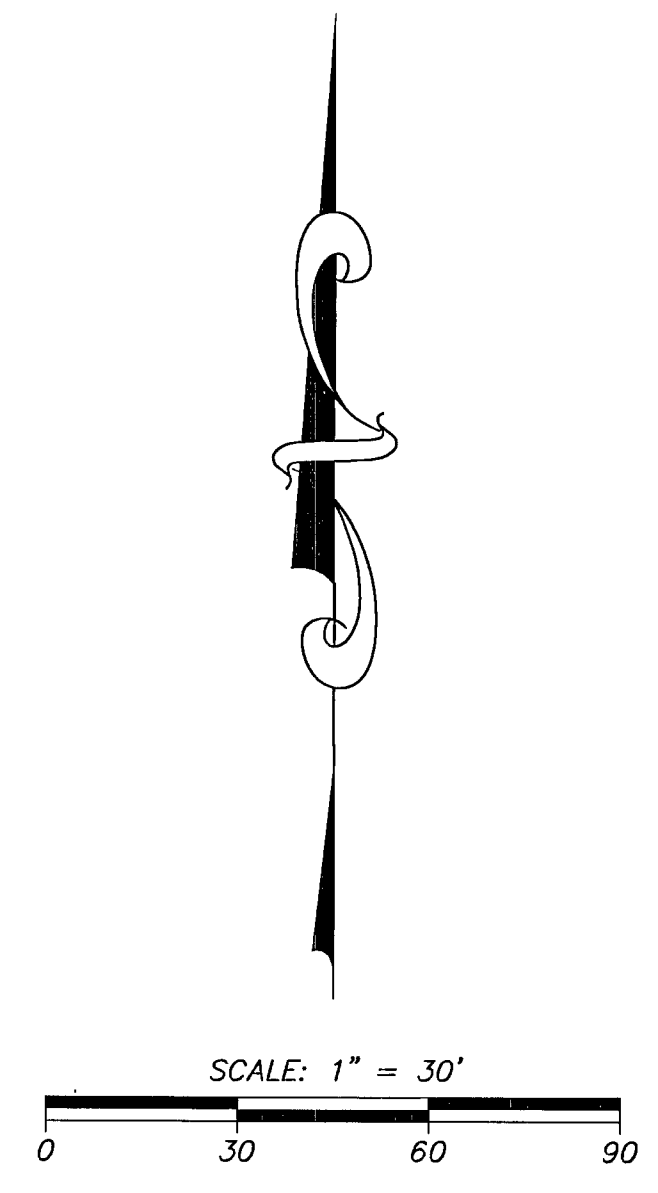

**MONUMENTATION TIE MAP**

**RECORD MAP of SURVEY**  
FOR  
**WELLS CARGO, INC.**  
**GRAND TETON STORM DRAIN**

PORTIONS OF SECTIONS 7, 8, 17, & 18, TOWNSHIP 19 SOUTH, RANGE 60 EAST, M.D.M., CLARK COUNTY, NEVADA.

**RGD** RGD SURVEYING LLC  
P. O. Box 148 Logandale, NV 89021  
Tele: 01: 397-8250 Fax: 397-8257 Mobile: 429-5224

INSTRUMENT NO. \_\_\_\_\_  
FILED AT THE REQUEST OF  
**RGD Surveying LLC**  
DATE \_\_\_\_\_ AT \_\_\_\_\_  
FILE \_\_\_\_\_ PAGE \_\_\_\_\_  
OF SURVEYS  
OFFICIAL RECORDS BOOK  
NO. \_\_\_\_\_  
CLARK COUNTY, NEVADA RECORDS  
DEBBIE CONWAY, RECORDER  
FEE \$ \_\_\_\_\_ DEPUTY \_\_\_\_\_