

MONUMENTATION MAP OF JAKE'S RANCH UNIT 5

SITUATE IN THE CITY OF LAS VEGAS, CLARK COUNTY, NEVADA BEING A PORTION OF THE NORTHWEST ONE-QUARTER
OF THE NORTHWEST ONE-QUARTER OF SECTION 23, TOWNSHIP 20 SOUTH, RANGE 60 EAST, M.D.M.


RECORDED IN BOOK 72, PAGE 95

LINE DATA TABLE

No.	BEARING	DISTANCE
L1	N89°43'47" W	8.30
L2	N89°43'47" W	8.50
L3	N48°20'54" W	12.82
L4	N89°01'23" W	8.54
L5	S00°16'20" W	3.81
L6	N89°43'40" W	20.00
L7	S89°01'23" E	8.50
L8	S89°43'47" E	19.13
L9	S89°43'47" E	22.81
L10	N89°43'47" W	19.01
L11	N89°43'47" W	19.00
L12	S89°02'00" E	30.00

CURVE DATA TABLE


No.	RADIUS	DELTA	LENGTH	TANGENT
C1	45.50	87°05'18"	53.28	30.17
C2	45.50	40°22'47"	32.07	18.73
C3	45.50	50°15'00"	38.80	21.34
C4	45.50	89°22'13"	70.87	44.00
C5	60.00	28°57'44"	30.35	15.50
C6	60.00	35°13'05"	34.79	17.80
C7	60.00	31°30'32"	33.35	17.12
C8	60.00	35°22'51"	37.05	19.14
C9	60.00	14°48'11"	15.47	7.70
C10	20.00	27°28'21"	9.58	4.88
C11	20.00	87°05'18"	23.42	13.28
C12	45.50	247°05'18"	198.22	118.22
C13	60.00	144°10'25"	150.88	185.62
C14	20.00	89°17'43"	31.17	19.70
C15	15.00	90°00'00"	23.56	15.00
C16	15.00	90°42'24"	23.75	15.19
C17	15.00	89°17'38"	23.38	14.82
C18	424.50	01°25'04"	10.50	5.25
C19	450.00	01°20'14"	10.50	5.25

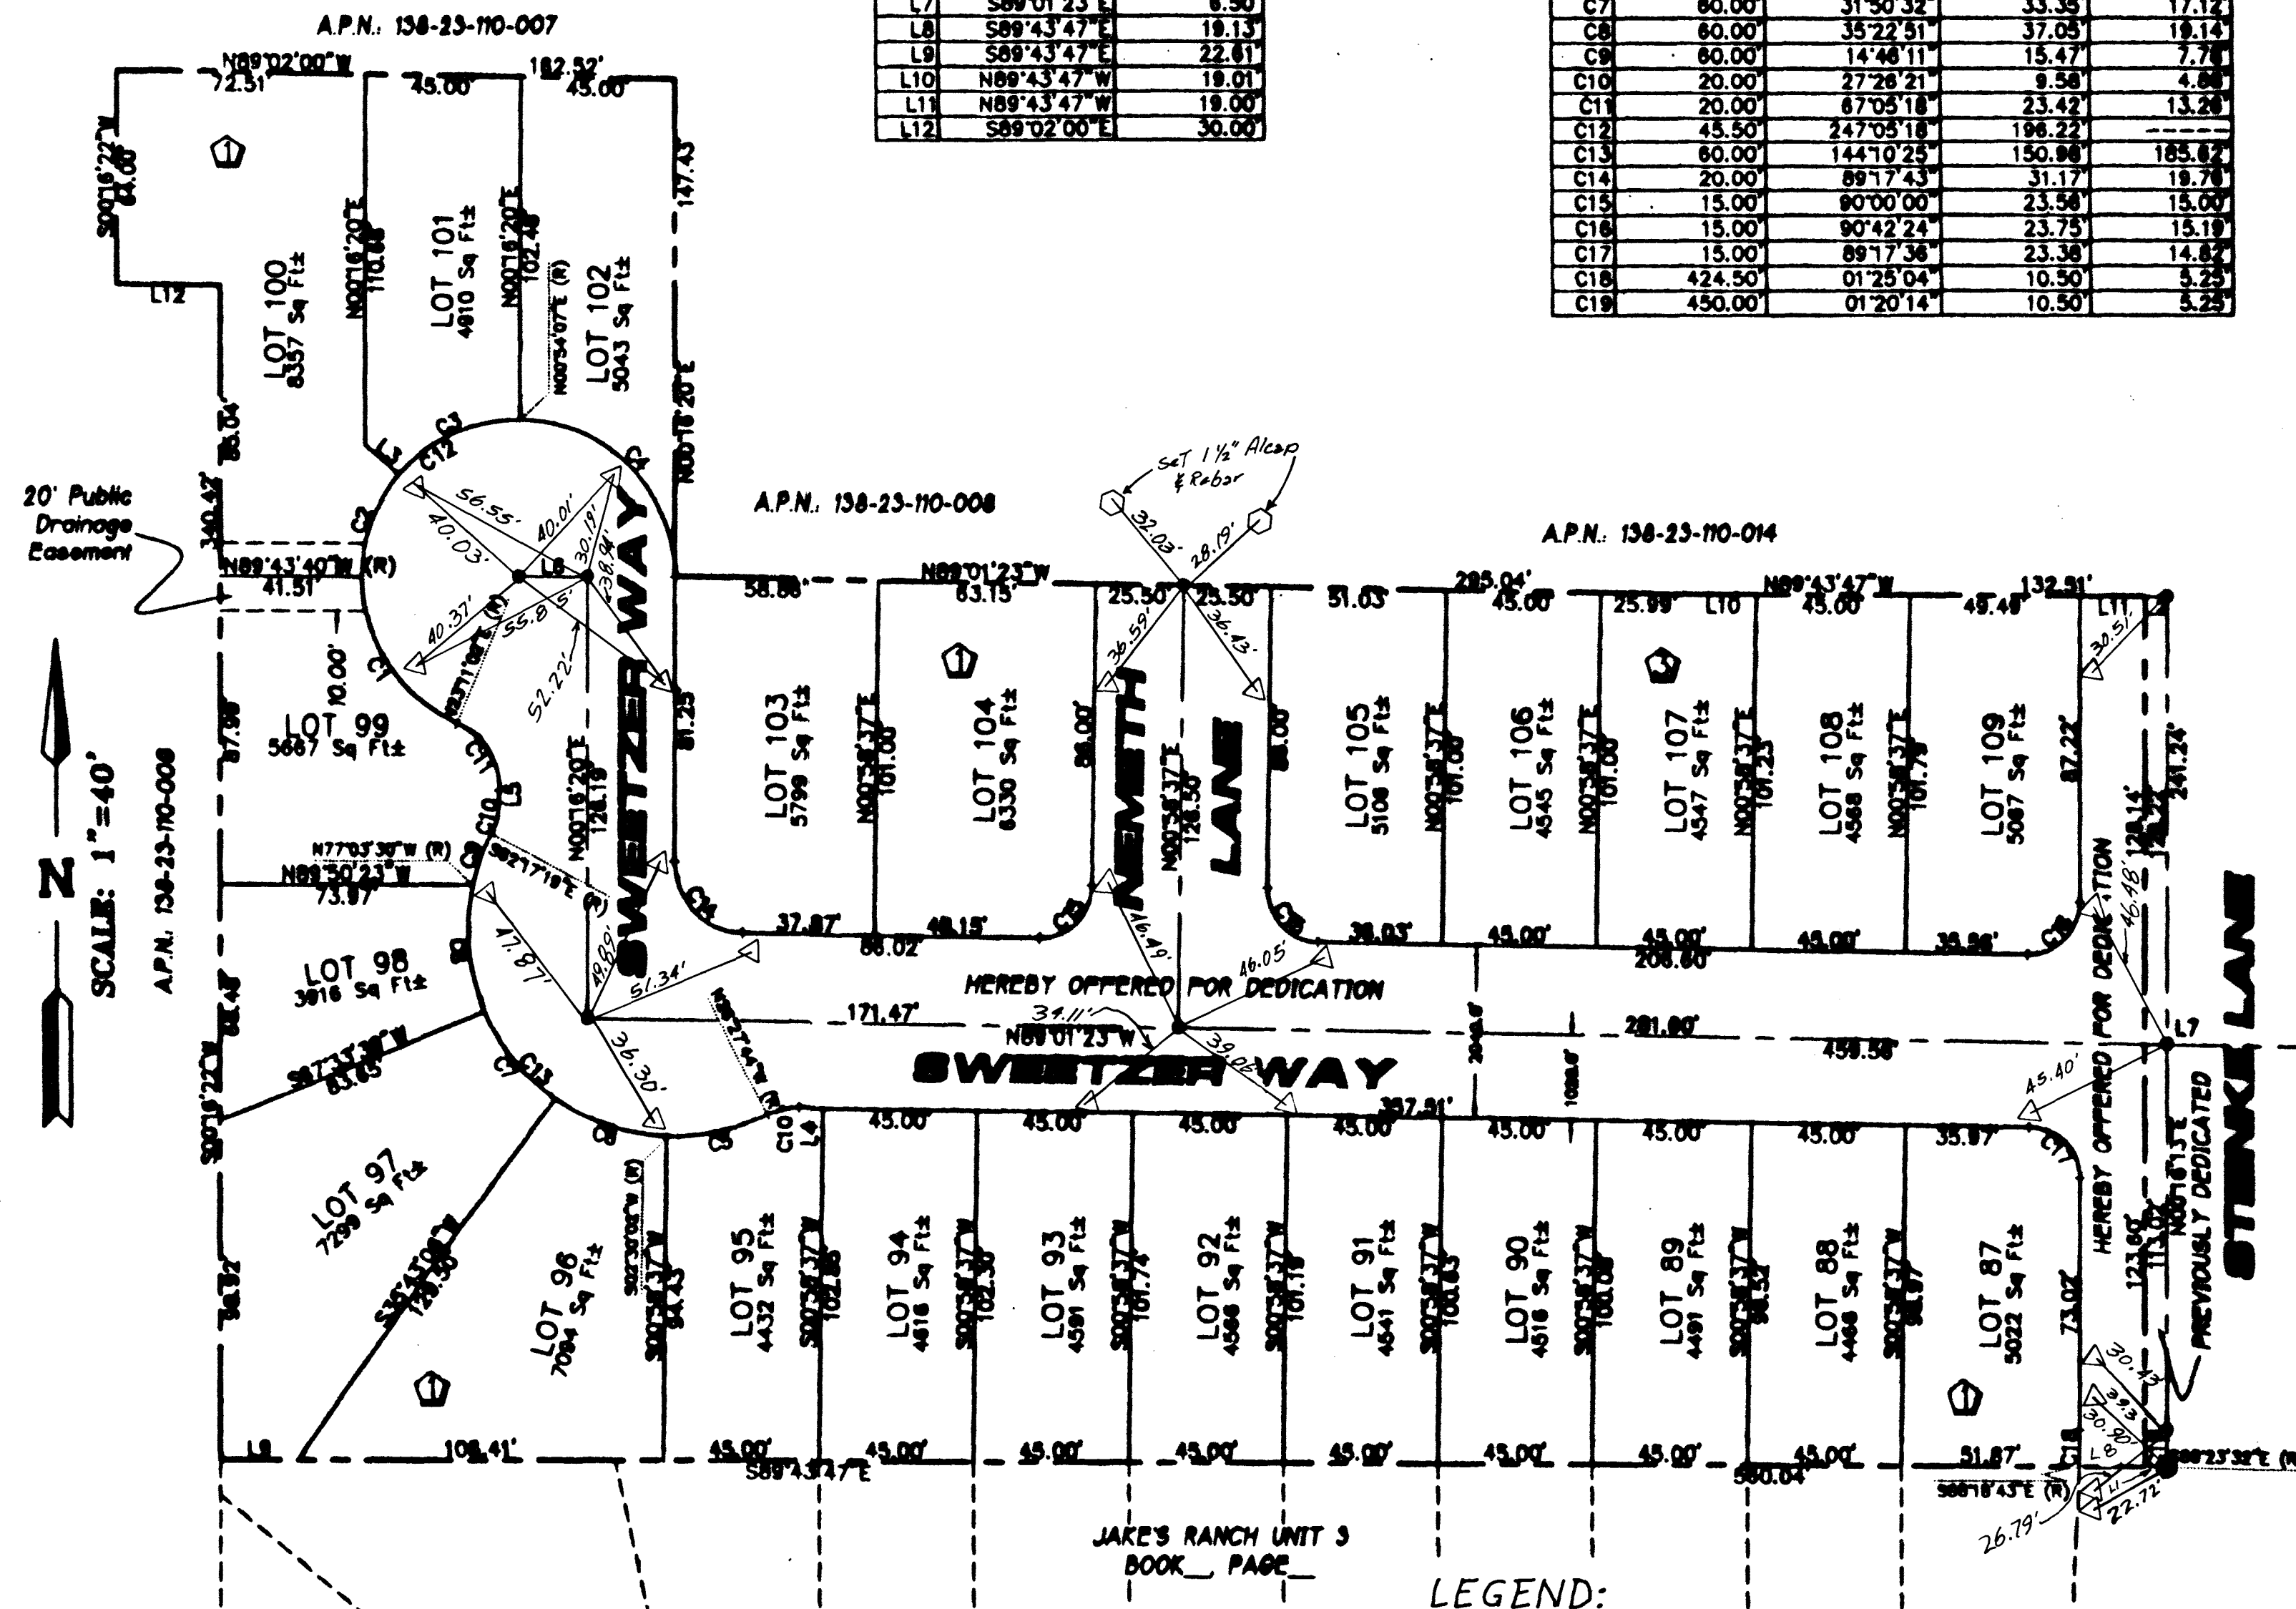

NOTE 1:
PURSUANT TO NRS 278.371, ALL REAR LOT CORNERS SHALL BE SET WITH A NAIL & TAG "PLS 5878" ON BLOCK WALLS AND ALL FRONT OR SIDE LOT CORNERS ADJOINING RIGHT-OF-WAY SHALL BE MARKED BY THE SAWCUTTING OF THE BACK OF CURBS ON THE PROLONGATION OF THE PROPERTY LINES.


LEGEND:

	MONUMENT AS NOTED
	1 1/2" ALUMINUM DISK IN TOP OF CURB; PLS 10114
	5/8" REBAR W/ ALUM. CAP & TIES PLS 10114
	FOUND 5/8" REBAR W/ ALUM. CAP PLS
	FOUND MONUMENT AS INDICATED
	OVERALL PARCEL BOUNDARY LINE
	INTERIOR PROPERTY OR RIGHT-OF-WAY LINE
	STREET CENTERLINE
	EASEMENT LINE
	BLOCK DESIGNATOR
	CURVE TABLE REFERENCE NUMBER
	LINE TABLE REFERENCE NUMBER
	LOT DESIGNATOR

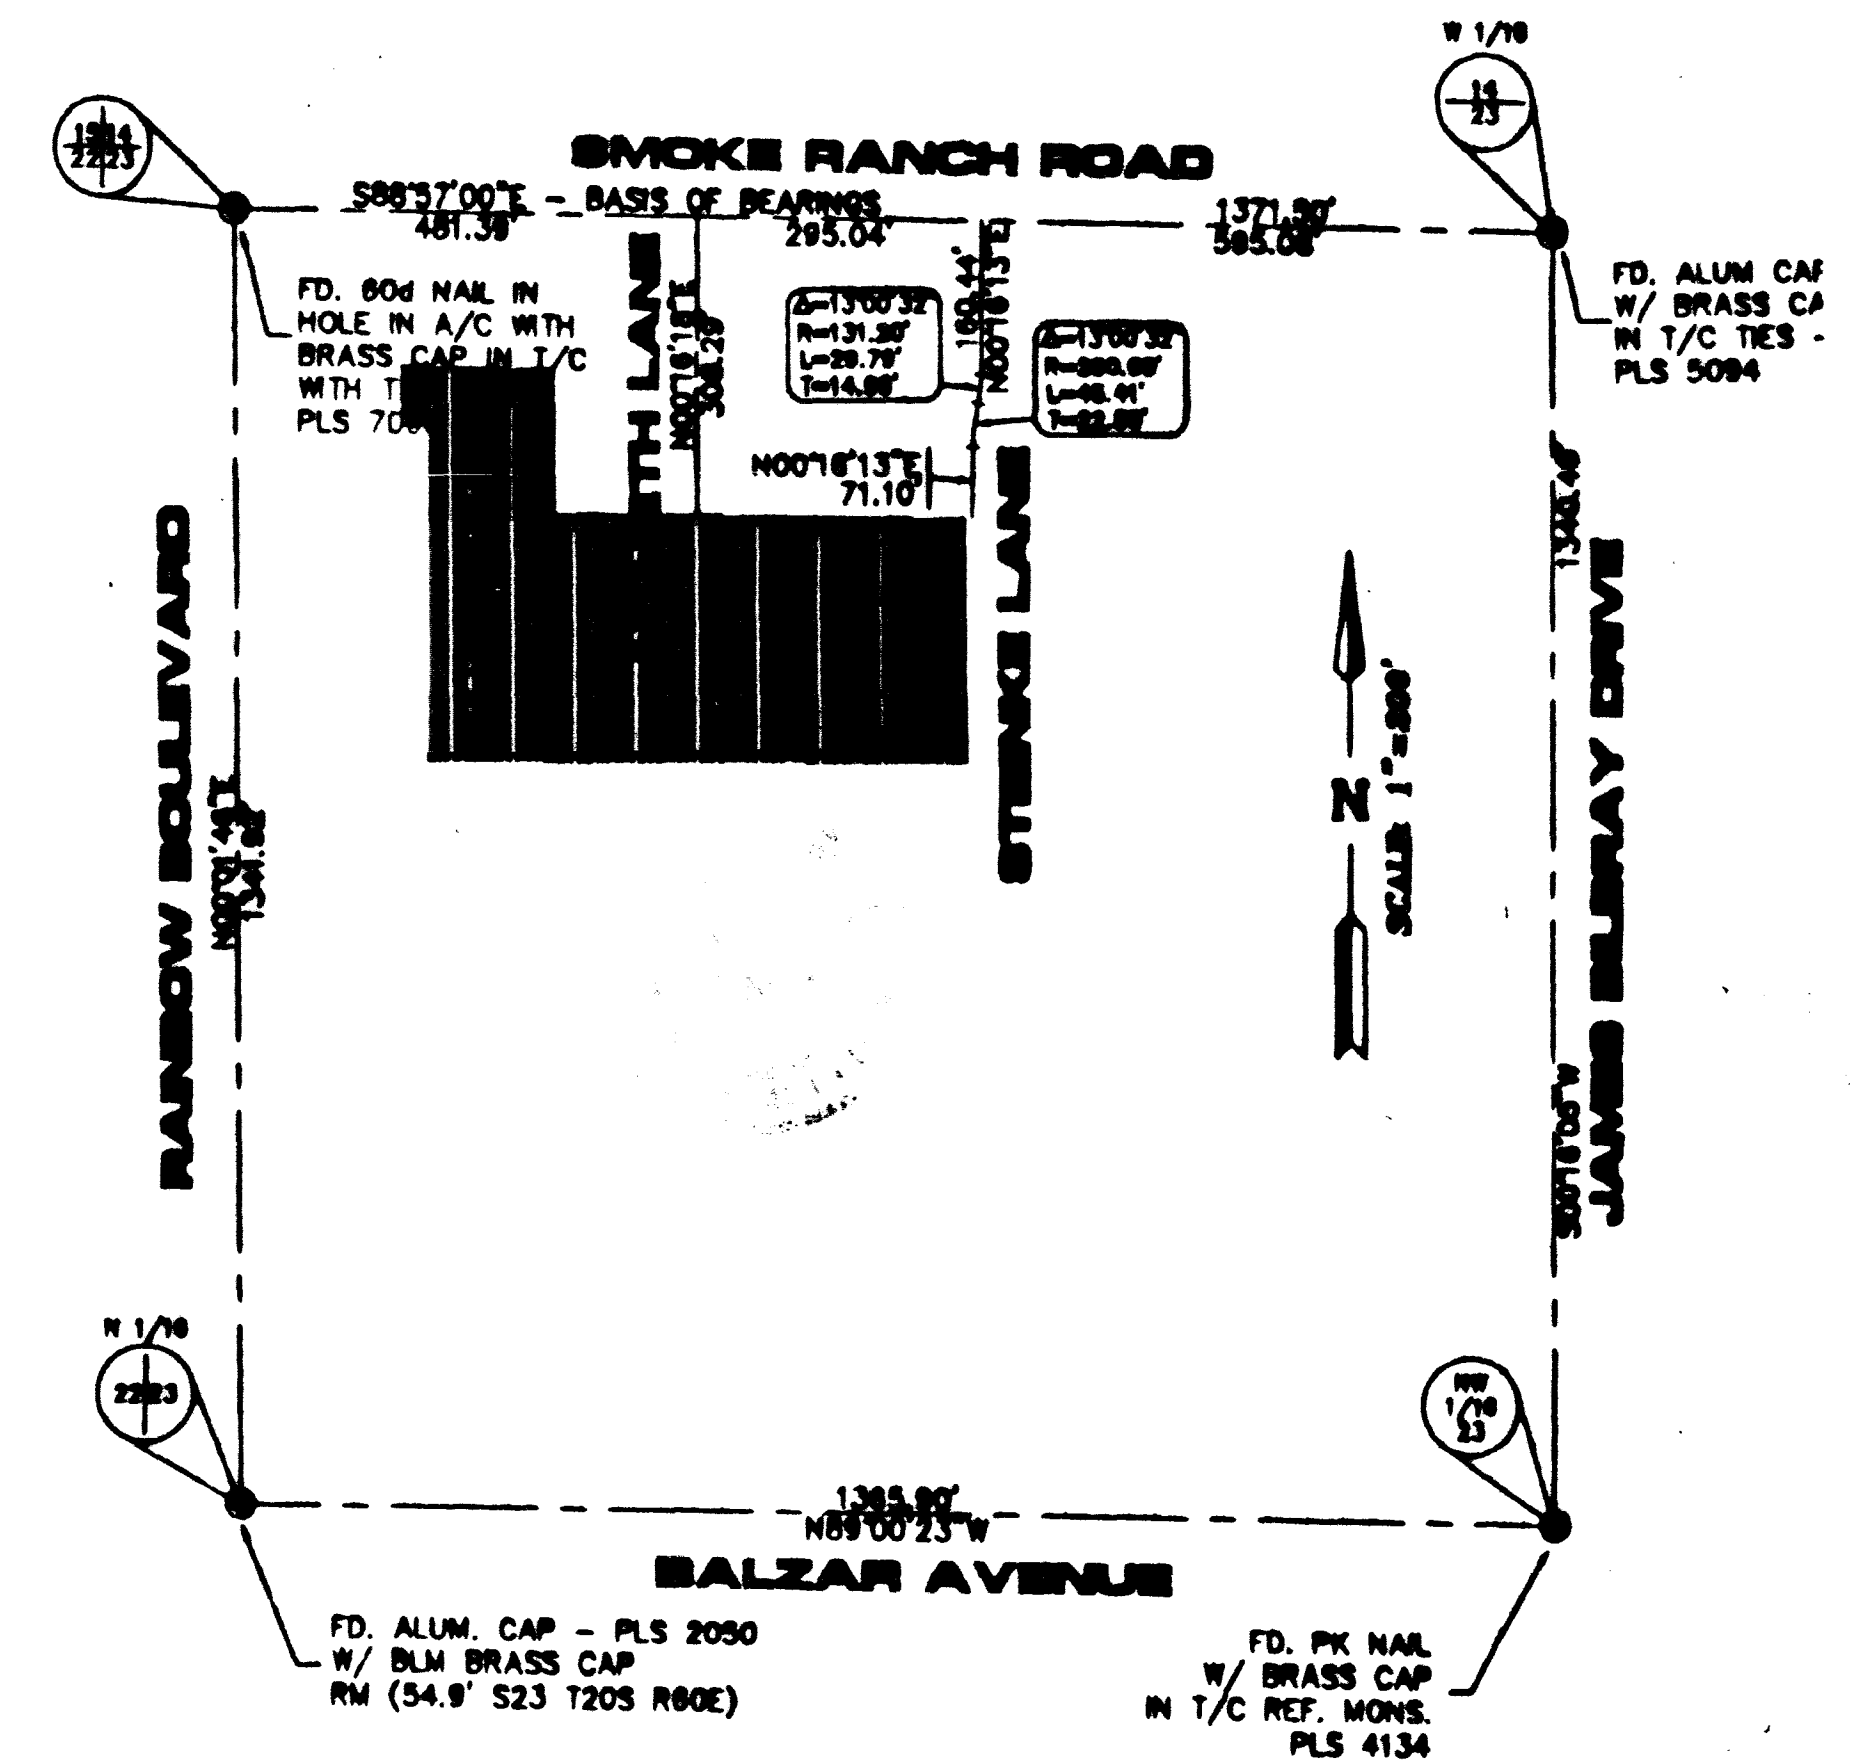

SURVEYOR'S CERTIFICATE:

I, ROBERT C. JOHNSON, A PROFESSIONAL LAND SURVEYOR REGISTERED IN THE STATE OF NEVADA, DO HEREBY CERTIFY THAT THE MONUMENTS HAVE BEEN SET AND THE TIE DISTANCES ESTABLISHED AS SHOWN HEREON. THIS SURVEY WAS COMPLETED ON MARCH 10, 1999.

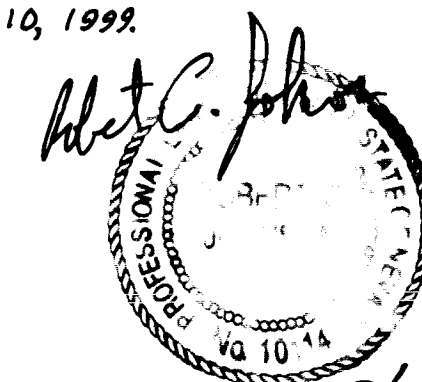

3/19/99


SHEET 1 OF 1

058-4346-5


MONUMENTATION MAP OF

RECORDED IN BOOK 72, PAGE 18

CLIMATE DATA TABLE

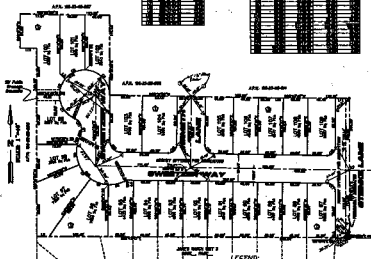

LEGEND:

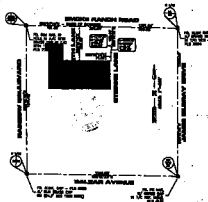[illegible]

4. WANTY'S AFFIDAVIT A PROFESSIONAL LEGAL ADVISOR SUBMITTED IN
THE STATE OF ARIZONA, IN AND BY COURT FILED THE AFFIDAVIT
ON 01/08/2015 BY LAW. THE AFFIDAVIT SUBMITTED ON BEHALF OF WANTY
THE ABOVE IS A COMPLETE AND TRUTHFUL STATEMENT.



SHEET 1 OF 1

754-4144-5