
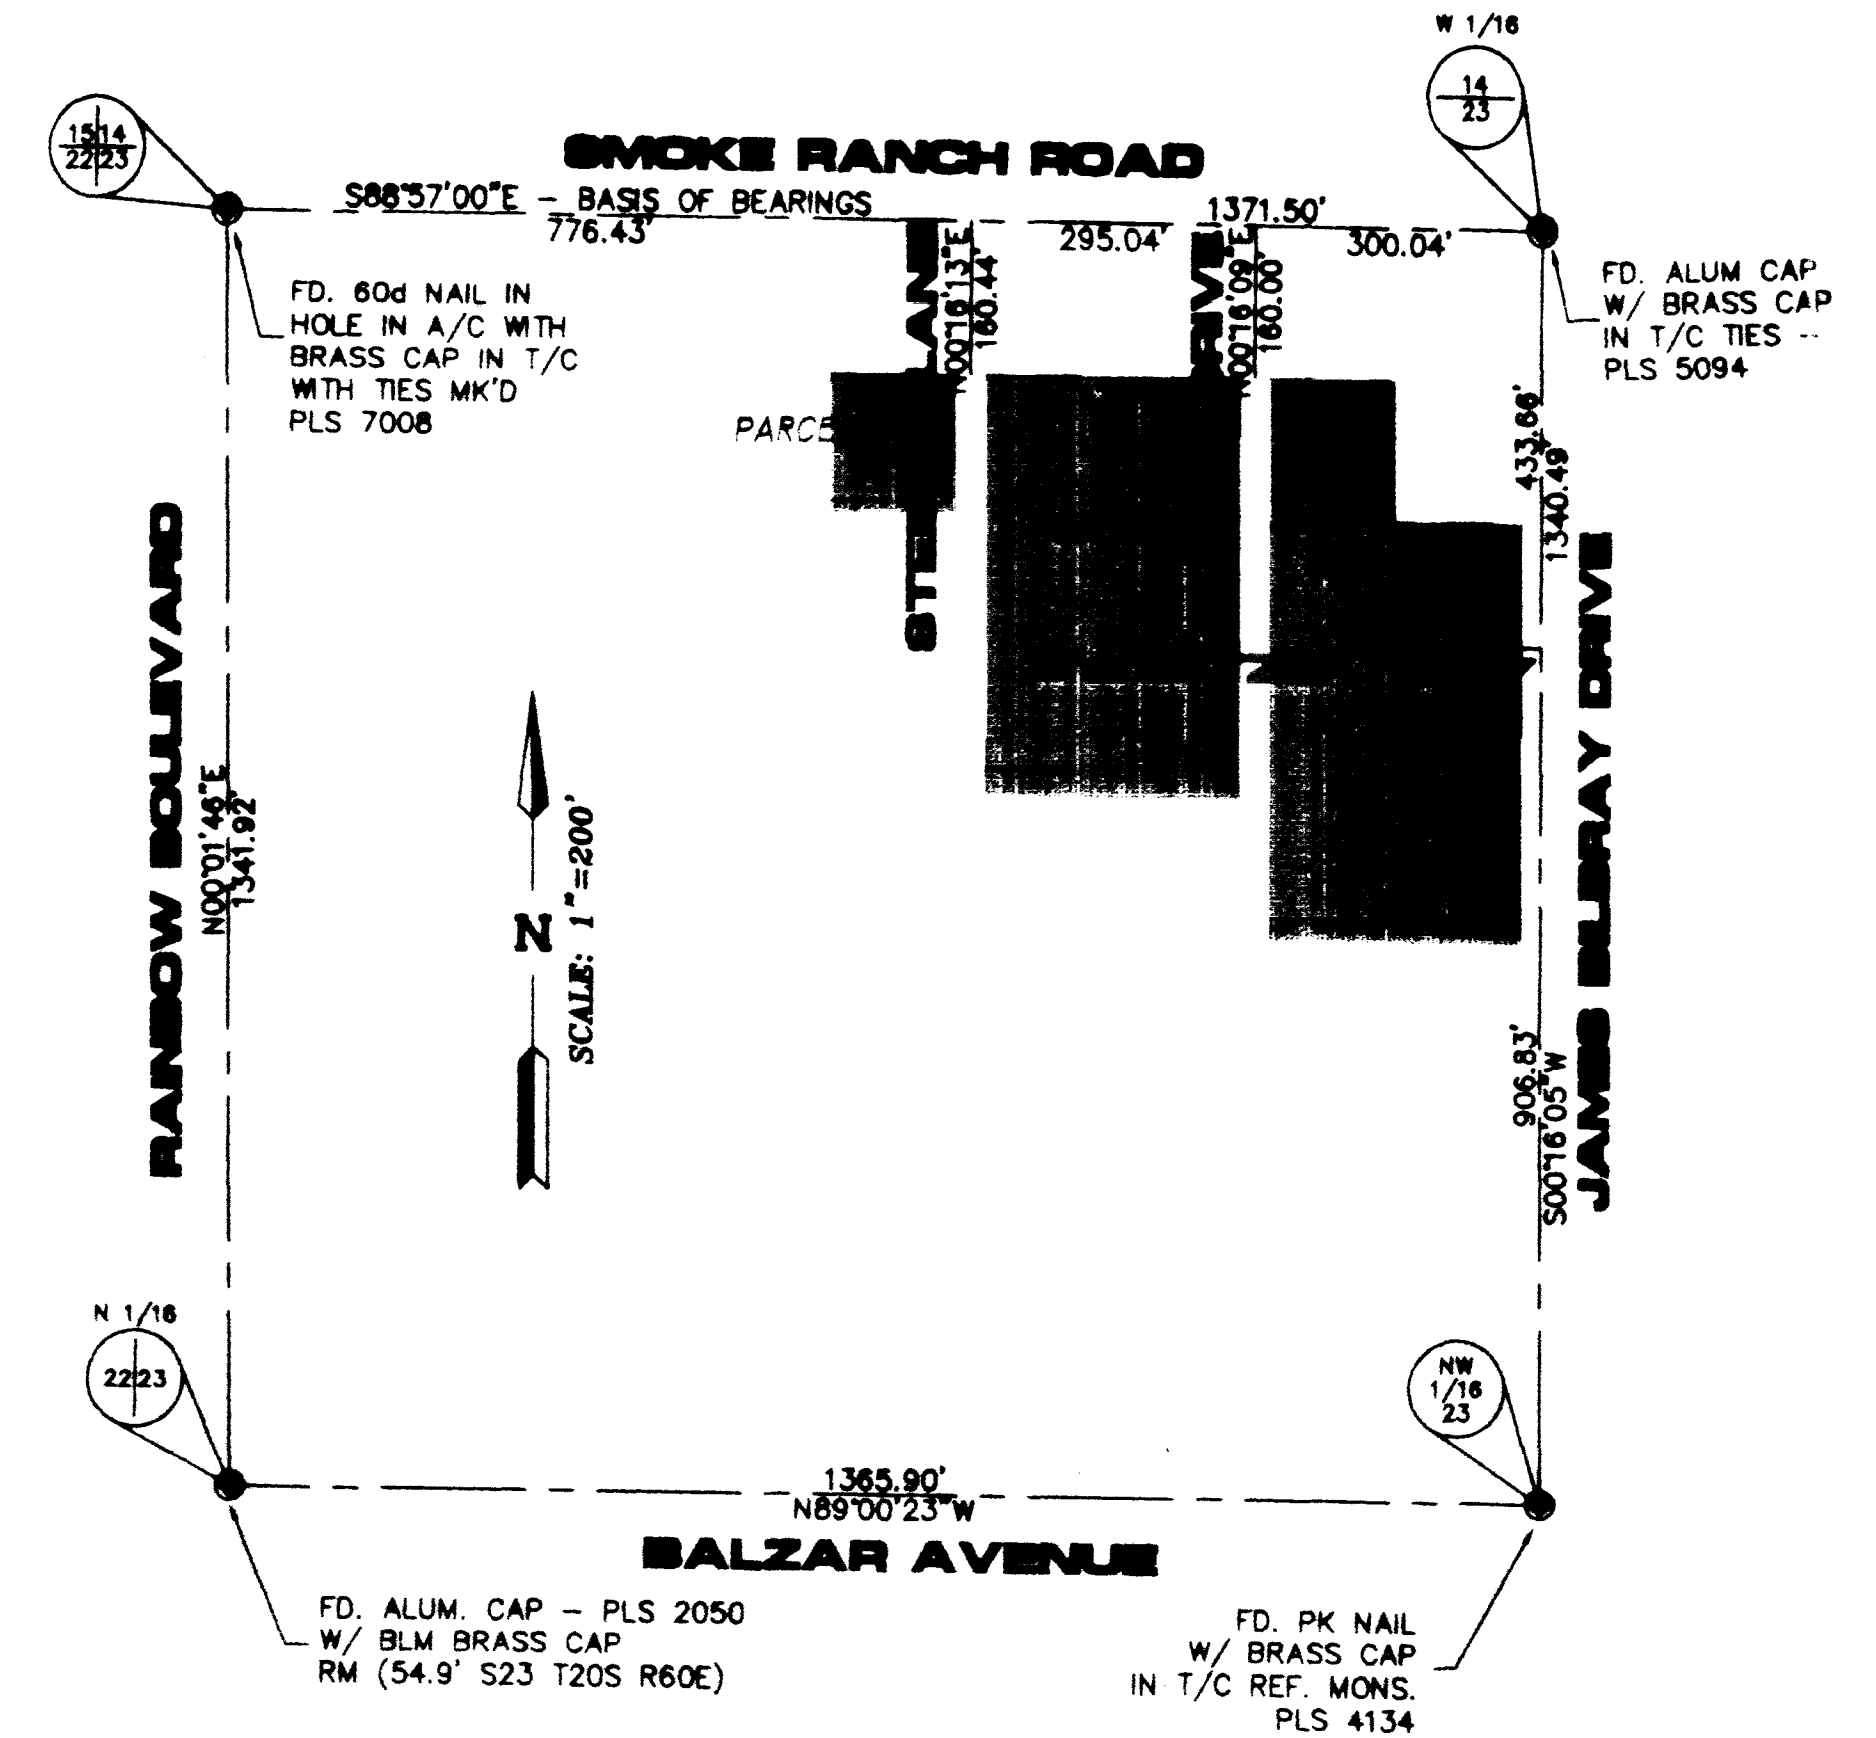


# MONUMENTATION MAP OF JAKE'S RANCH UNIT 6

SITUATE IN THE CITY OF LAS VEGAS, CLARK COUNTY, NEVADA BEING A PORTION OF THE NORTHWEST ONE-QUARTER OF THE NORTHWEST ONE-QUARTER OF SECTION 23, TOWNSHIP 20 SOUTH, RANGE 60 EAST, M.D.M.

RECORDED IN BOOK 74, PAGE 20

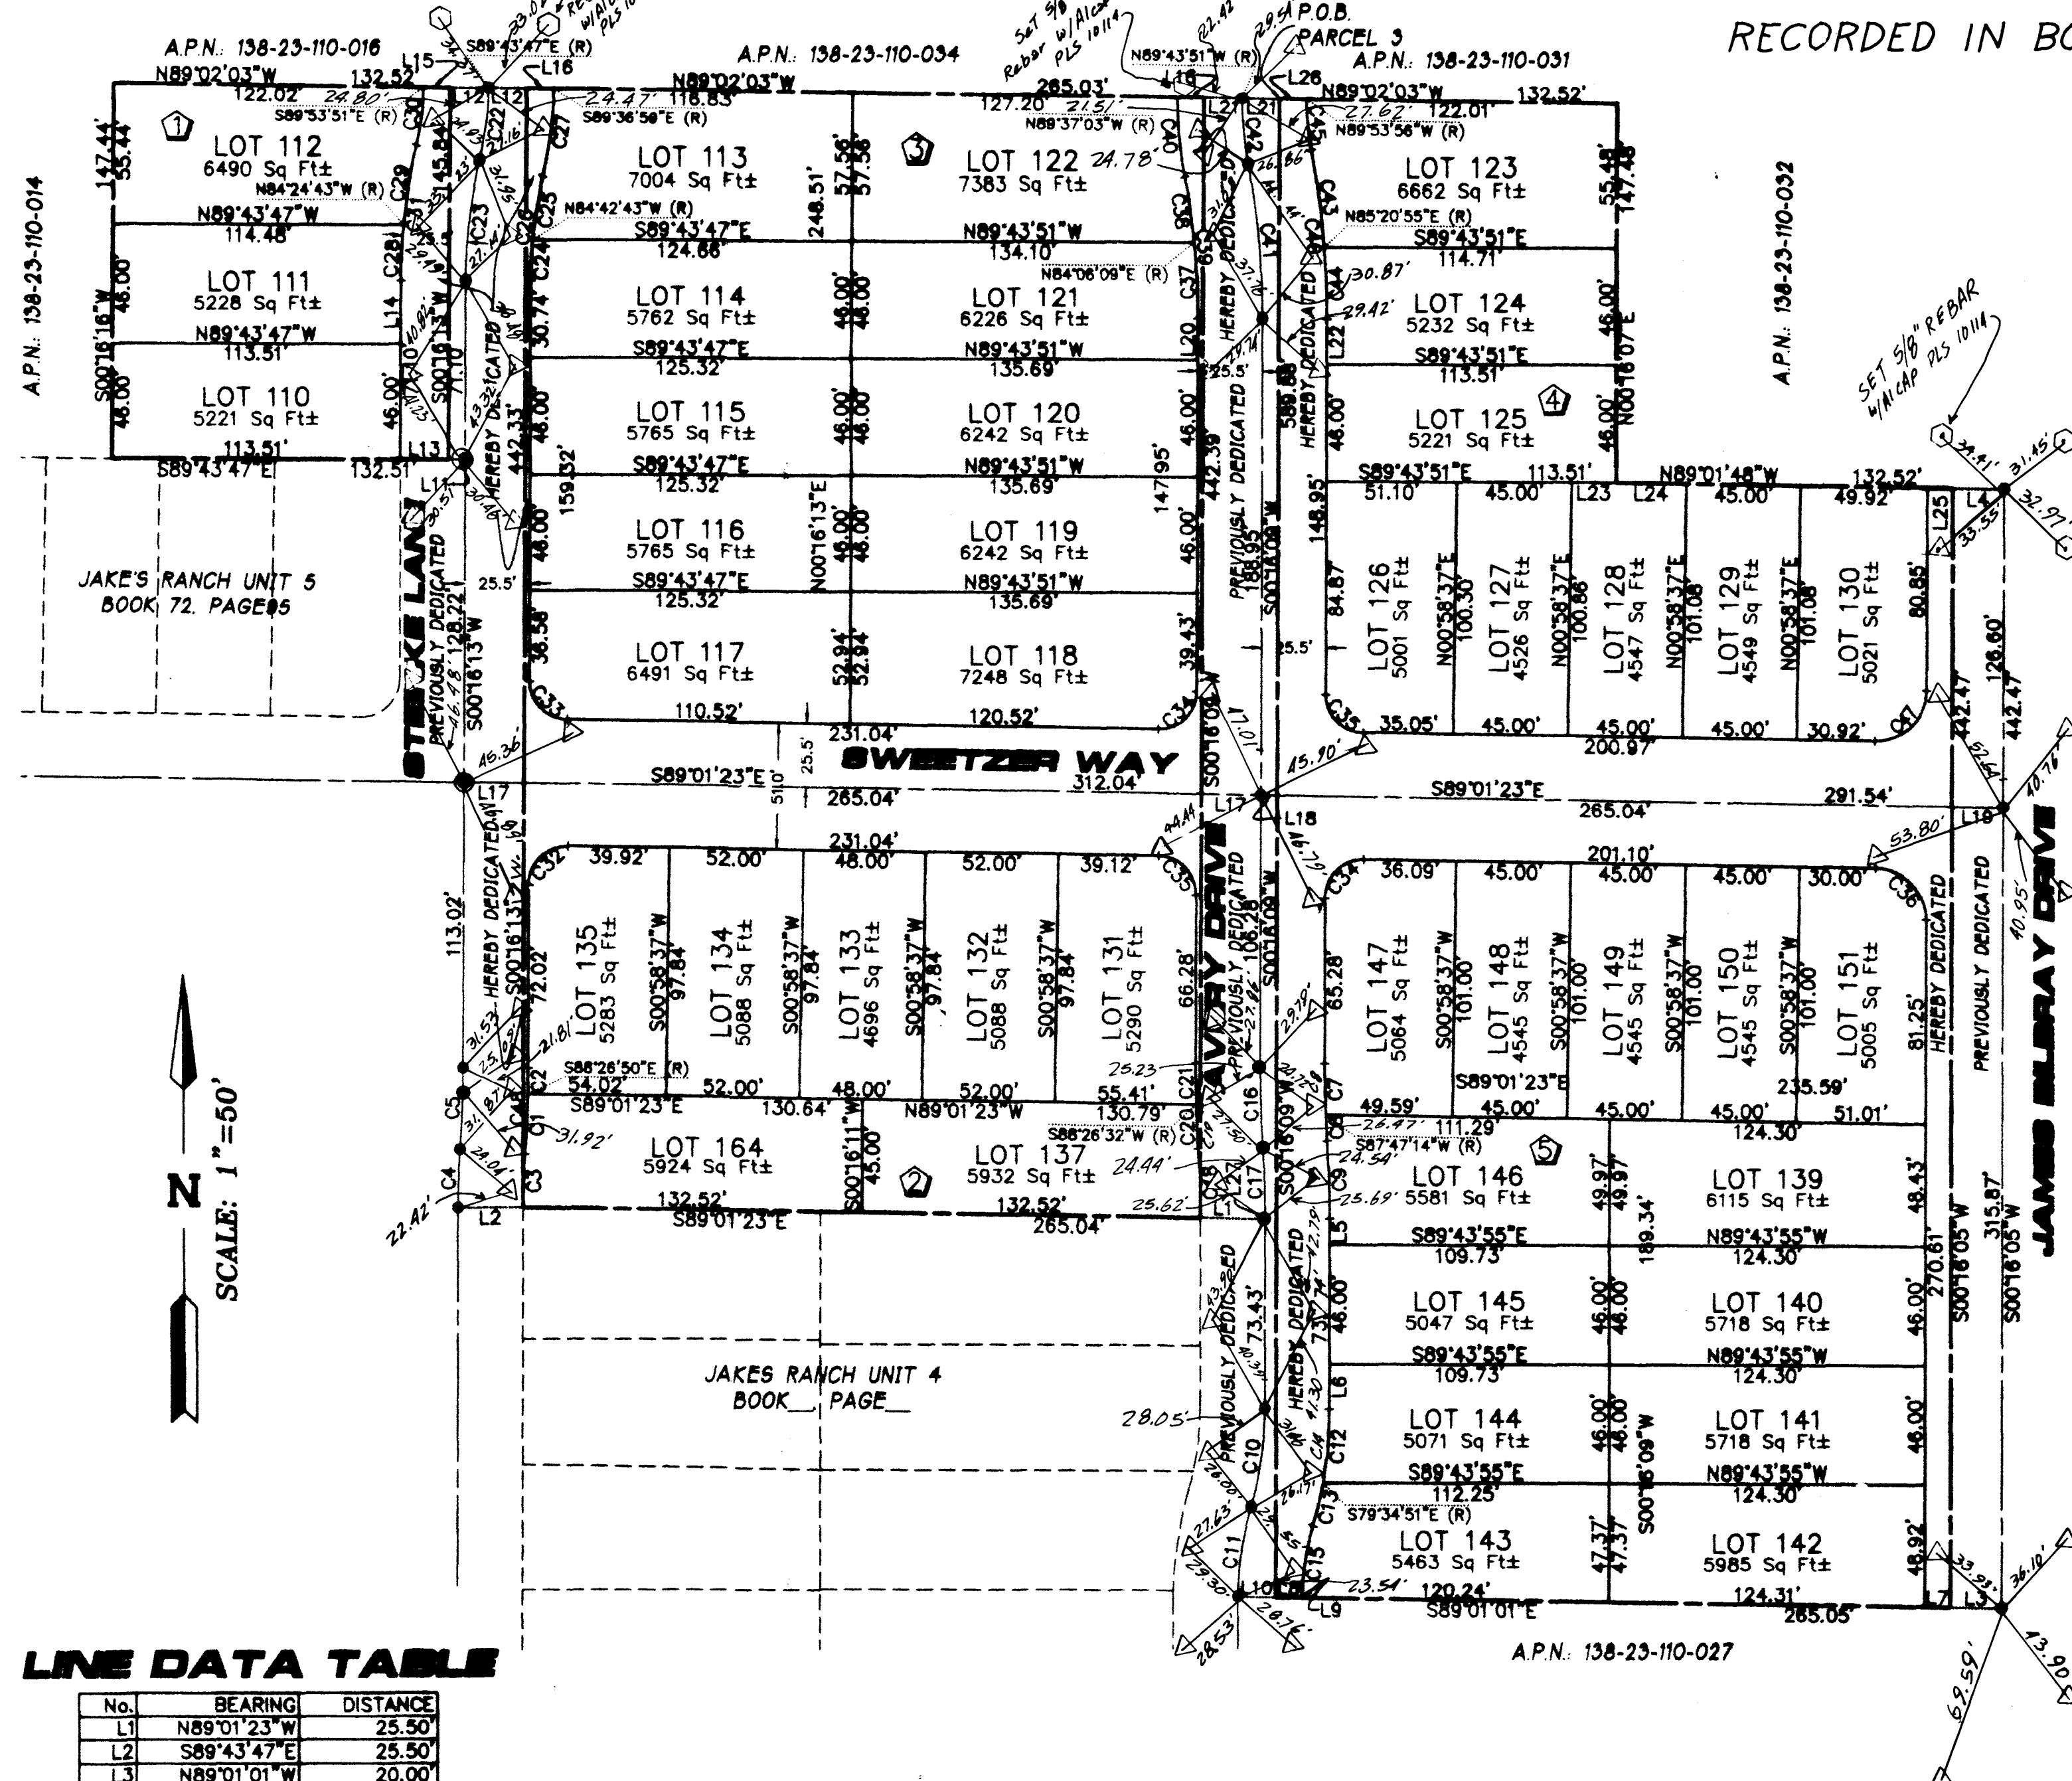

## SURVEYOR'S CERTIFICATE:

I, ROBERT C. JOHNSON, A PROFESSIONAL LAND SURVEYOR REGISTERED IN THE STATE OF NEVADA, DO HEREBY CERTIFY THAT THE MONUMENTS HAVE BEEN SET AND THE DISTANCES ESTABLISHED AS SHOWN HEREON. THIS SURVEY WAS COMPLETED ON MARCH 10, 1999.

ROBERT C. JOHNSON  
3/17/99

## LINE DATA TABLE

| No. | BEARING     | DISTANCE |
|-----|-------------|----------|
| L1  | N89°01'23"W | 25.50'   |
| L2  | S89°43'47"E | 25.50'   |
| L3  | N89°01'01"W | 20.00'   |
| L4  | N89°01'48"W | 20.00'   |
| L5  | N00°16'48"E | 10.11'   |
| L6  | N00°15'58"E | 17.63'   |
| L7  | S89°01'01"E | 10.00'   |
| L8  | S89°01'01"E | 10.50'   |
| L9  | N00°16'09"E | 0.32'    |
| L10 | N89°01'01"W | 15.00'   |
| L11 | N89°43'47"W | 6.50'    |
| L12 | S89°02'03"E | 15.00'   |
| L13 | S89°43'47"E | 19.00'   |
| L14 | N00°16'13"E | 25.10'   |
| L15 | S89°02'03"E | 10.50'   |
| L16 | N89°02'03"W | 10.50'   |
| L17 | N89°01'23"W | 23.50'   |
| L18 | N89°01'23"W | 6.50'    |
| L19 | N89°01'23"W | 20.00'   |
| L20 | S00°16'09"W | 16.51'   |
| L21 | N89°02'03"W | 15.00'   |
| L22 | N00°16'09"E | 18.08'   |
| L23 | N89°43'51"W | 17.40'   |
| L24 | N89°01'48"W | 27.60'   |
| L25 | N89°01'48"W | 10.00'   |
| L26 | N89°02'03"W | 10.50'   |
| L27 | S00°16'09"W | 0.32'    |

## NOTE:

PURSUANT TO NRS 278.371, ALL REAR LOT CORNERS SHALL BE SET WITH A NAIL & TAG "PLS 5878" ON BLOCK WALLS AND ALL FRONT OR SIDE LOT CORNERS ADJOINING RIGHT-OF-WAY SHALL BE MARKED BY THE SAWCUTTING OF THE BACK OF CURBS ON THE PROLONGATION OF THE PROPERTY LINES.

## LEGEND:

|        |                                                |
|--------|------------------------------------------------|
| ○      | MONUMENT AS NOTED.                             |
| △      | 1 1/2" ALUMINUM DISK IN TOP OF CURB; PLS 10114 |
| ●      | 5/8" REBAR W/ ALUM. CAP & TIES PLS 10114       |
| ●      | FOUND MONUMENT AS INDICATED                    |
| ---    | OVERALL PARCEL BOUNDARY LINE                   |
| ---    | INTERIOR PROPERTY OR RIGHT-OF-WAY LINE         |
| ---    | STREET CENTERLINE                              |
| ---    | EASEMENT LINE                                  |
| ---    | BLOCK DESIGNATOR                               |
| C19    | CURVE TABLE REFERENCE NUMBER                   |
| L1     | LINE TABLE REFERENCE NUMBER                    |
| LOT 12 | LOT DESIGNATOR                                 |


## CURVE DATA TABLE

| No. | RADIUS  | DELTA     | LENGTH | TANGENT |
|-----|---------|-----------|--------|---------|
| C1  | 475.50' | 02°50'11" | 23.54' | 11.77'  |
| C2  | 475.50' | 01°16'54" | 10.64' | 5.32'   |
| C3  | 298.94' | 04°07'07" | 21.49' | 10.75'  |
| C4  | 324.44' | 04°07'07" | 23.32' | 11.67'  |
| C5  | 450.00' | 04°07'07" | 32.35' | 16.18'  |
| C6  | 474.50' | 01°13'35" | 10.16' | 5.08'   |
| C7  | 474.50' | 02°28'55" | 20.55' | 10.28'  |
| C8  | 474.50' | 03°42'30" | 30.71' | 15.36'  |
| C9  | 480.66' | 03°42'30" | 31.11' | 15.56'  |
| C10 | 135.50' | 16°10'03" | 38.23' | 19.25'  |
| C11 | 130.00' | 16°10'03" | 36.68' | 18.48'  |
| C12 | 161.00' | 10°09'00" | 28.52' | 14.30'  |
| C13 | 161.00' | 06°01'03" | 16.91' | 8.48'   |
| C14 | 161.00' | 16°10'03" | 45.43' | 22.87'  |
| C15 | 104.50' | 16°10'03" | 29.49' | 14.84'  |
| C16 | 500.00' | 03°42'30" | 32.36' | 16.19'  |
| C17 | 455.16' | 03°42'30" | 29.46' | 14.74'  |
| C18 | 429.66' | 03°42'30" | 27.81' | 13.91'  |
| C19 | 525.50' | 03°42'30" | 34.01' | 17.01'  |
| C20 | 525.50' | 01°52'53" | 17.26' | 8.63'   |
| C21 | 525.50' | 01°49'37" | 16.78' | 8.38'   |
| C22 | 131.20' | 13°00'32" | 29.79' | 14.96'  |
| C23 | 200.00' | 13°00'32" | 45.41' | 22.80'  |
| C24 | 174.50' | 05°01'03" | 15.28' | 7.65'   |
| C25 | 174.50' | 07°59'28" | 24.34' | 12.19'  |

| No. | RADIUS  | DELTA     | LENGTH | TANGENT |
|-----|---------|-----------|--------|---------|
| C26 | 174.50' | 13°00'32" | 39.62' | 19.90'  |
| C27 | 156.70' | 12°53'44" | 35.27' | 17.71'  |
| C28 | 225.50' | 05°19'04" | 20.93' | 10.47'  |
| C29 | 225.50' | 07°41'28" | 30.27' | 15.16'  |
| C30 | 105.70' | 13°10'36" | 24.31' | 12.21'  |
| C31 | 225.50' | 13°00'32" | 51.20' | 25.71'  |
| C32 | 15.00'  | 90°42'24" | 23.75' | 15.19'  |
| C33 | 15.00'  | 89°17'36" | 23.38' | 14.82'  |
| C34 | 15.00'  | 90°42'28" | 23.75' | 15.19'  |
| C35 | 15.00'  | 89°17'32" | 23.38' | 14.82'  |
| C36 | 20.00'  | 89°17'28" | 31.17' | 19.75'  |
| C37 | 274.50' | 06°10'00" | 29.54' | 14.79'  |
| C38 | 274.50' | 05°13'44" | 25.05' | 12.53'  |
| C39 | 274.50' | 11°23'43" | 54.59' | 27.39'  |
| C40 | 156.69' | 11°30'32" | 31.47' | 15.79'  |
| C41 | 300.00' | 11°23'43" | 59.67' | 29.93'  |
| C42 | 131.19' | 11°23'43" | 26.09' | 13.09'  |
| C43 | 325.50' | 06°28'30" | 36.78' | 18.41'  |
| C44 | 325.50' | 04°55'14" | 27.95' | 13.99'  |
| C45 | 105.69' | 11°13'38" | 20.71' | 10.39'  |
| C46 | 325.50' | 11°23'43" | 64.74' | 32.48'  |
| C47 | 20.00'  | 90°42'32" | 31.66' | 20.25'  |
| C48 | 475.50' | 04°07'07" | 34.18' | 17.10'  |

## JAKE'S RANCH UNIT 6


RECORDED IN BOOK 74, PAGE 20

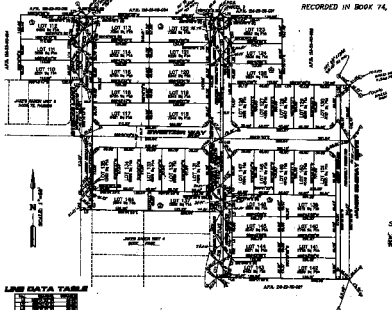

## LINE DATA TABLE

||
||
||

### LEGEND

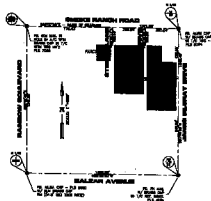[illegible]

### SURVEYOR'S CERTIFICATE:

1. DEWITT C. JOHNSON, a Professor, was formerly married to  
his first wife, and has since been married to his second wife.  
He was born in 1911, and is now living in the city of New York.  
He is a member of the New York State Bar Association, and is  
also a member of the New York State Bar Association.



### CLUTTER DATA TABLE

