


REVISION	REVISION DATE	APPROVAL DATE	BY	COMMENTS
1	3/10/97	5/6/97	AW	REVISED BUILDING DIMENSIONS
2	5/11/98	6/8/98	KDF	REVISED BUILDING LOCATION
3	5/11/98	6/9/98	KDF	REVISED PARKING SPACES

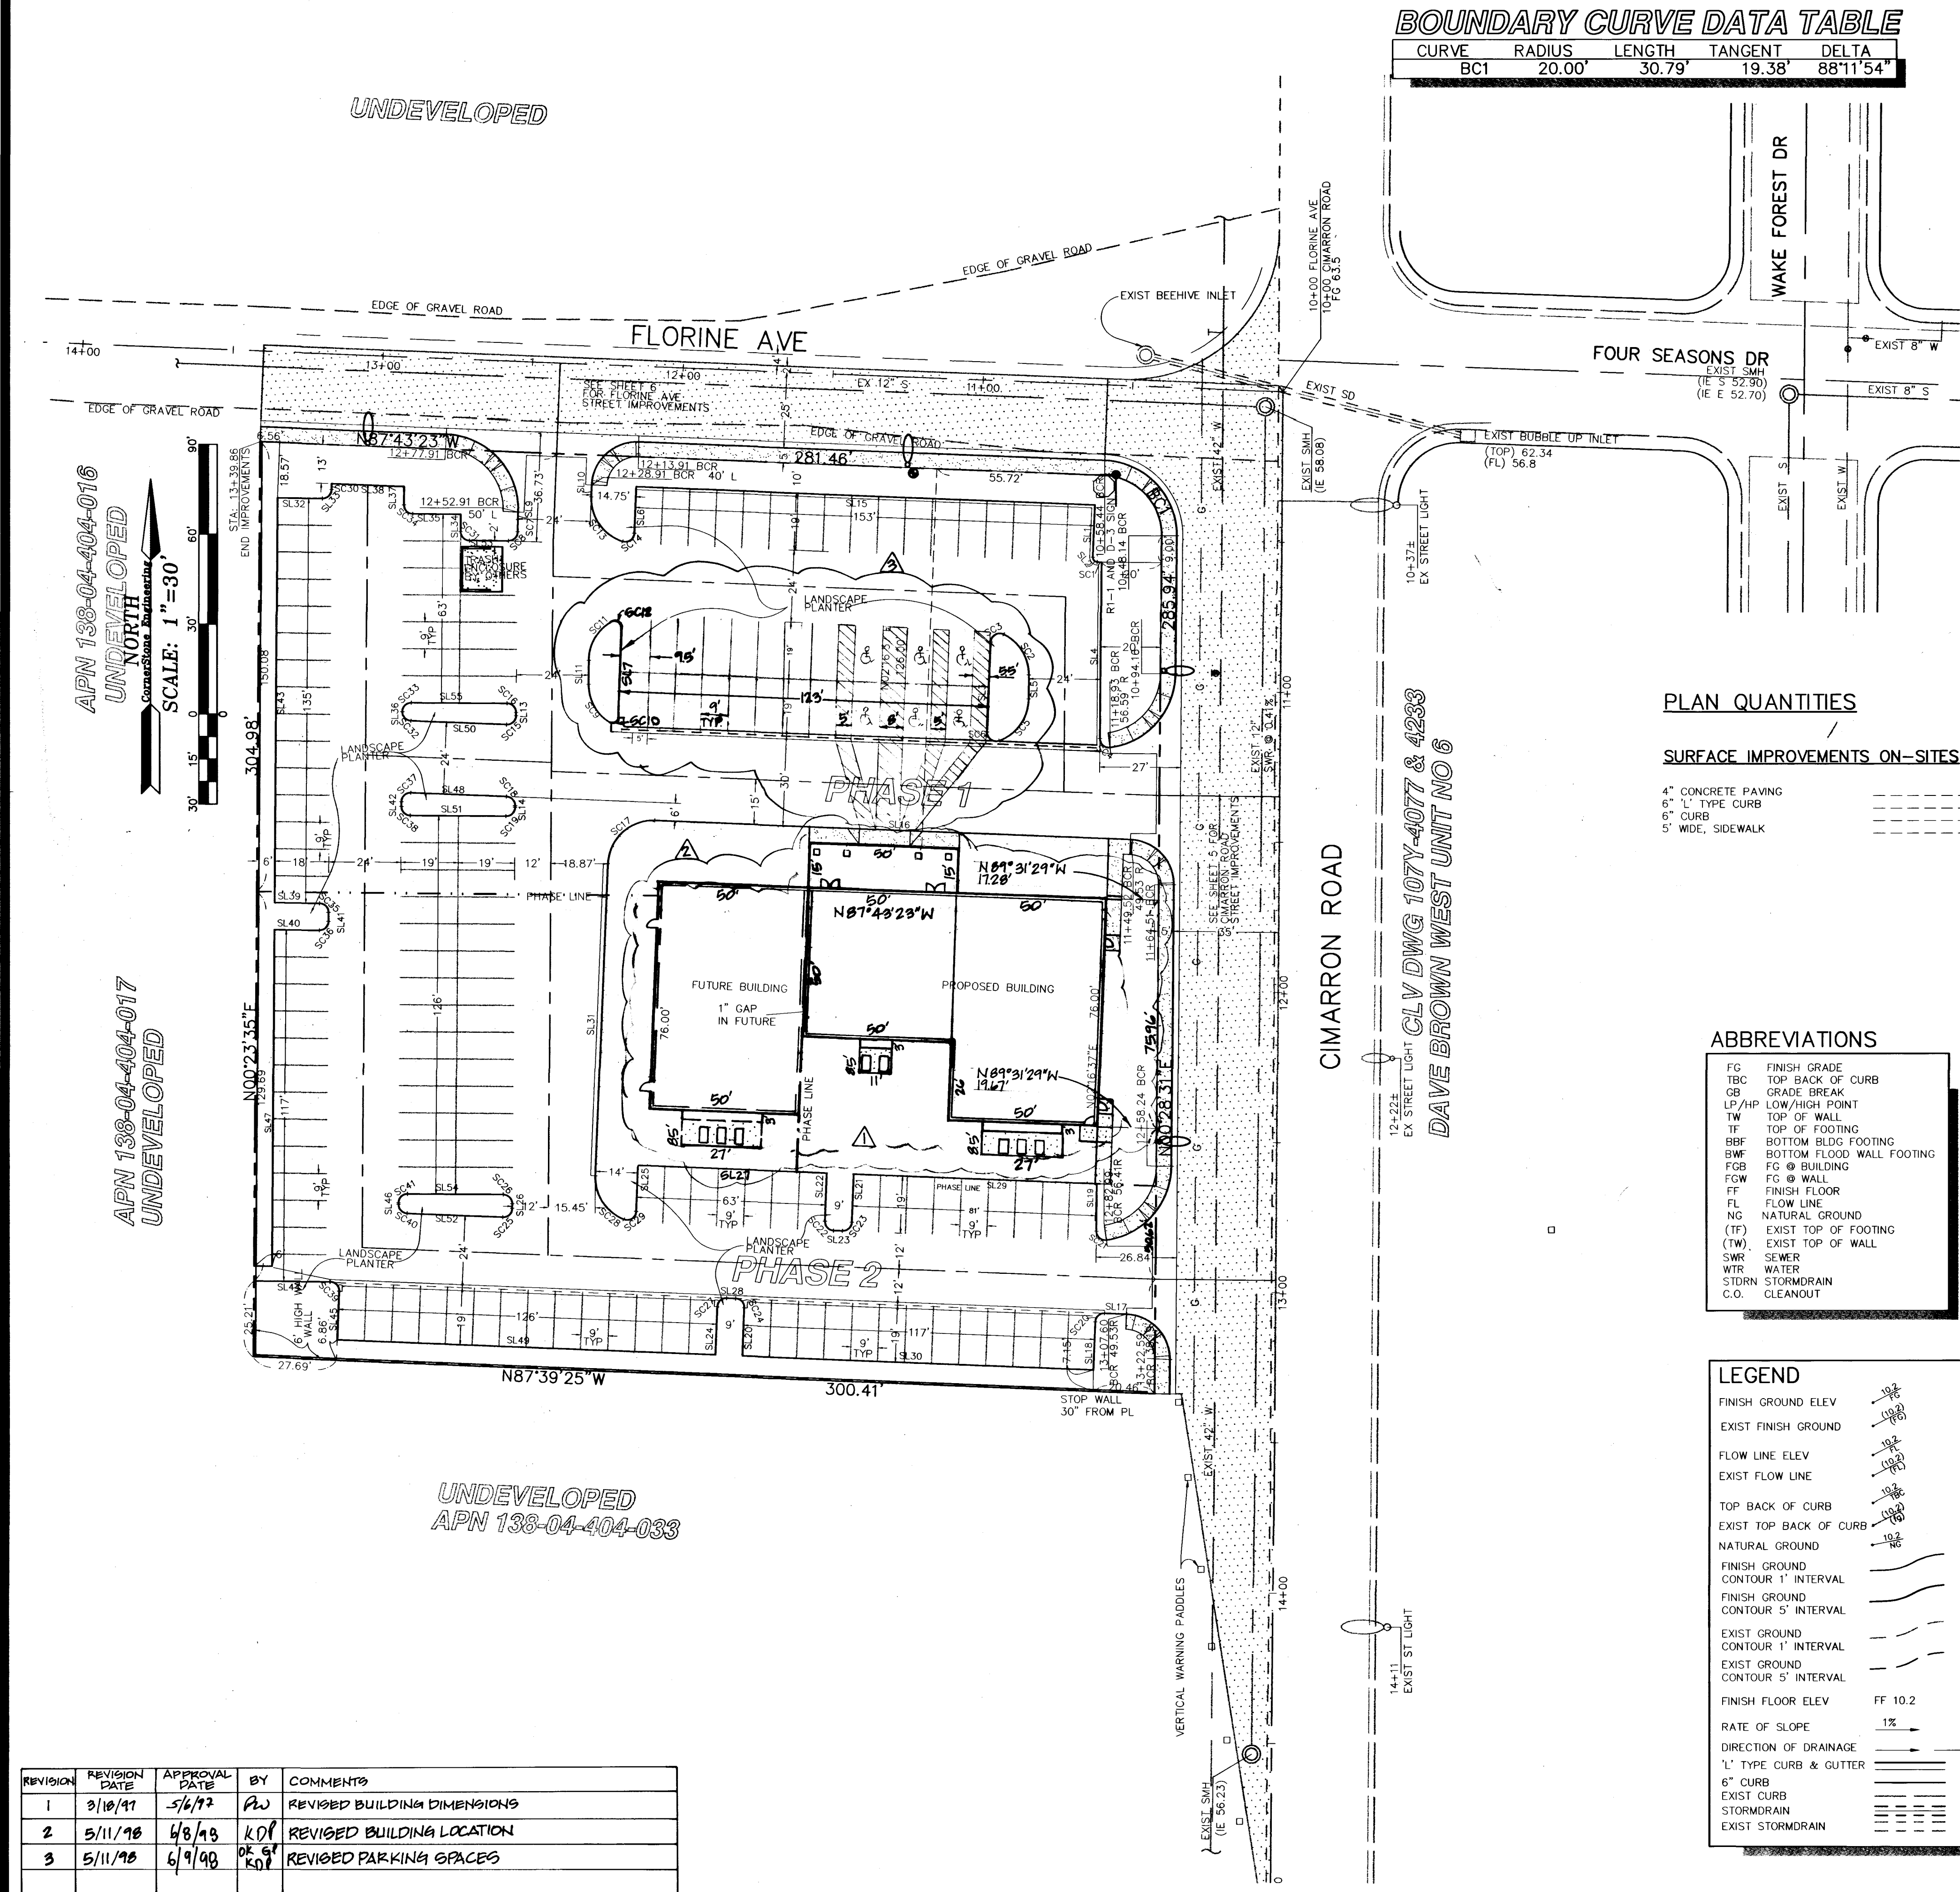

CURVE	RADIUS	LENGTH	TANGENT	DELTA
BC1	20.00'	30.79'	19.38'	88°11'54"

LEGAL DESCRIPTION

NE 1/4 OF THE SE 1/4 OF THE SE 1/4 OF THE SW 1/4 SECTION 4, TOWNSHIP 20 SOUTH, RANGE 60 EAST, M.D.M.

SETBACK REQUIREMENTS

FRONT: 50'
SIDE: 10'
REAR: 50' OR 25% OF LOT WIDTH, WHICH EVER IS LESS, IN NO CASE SHALL IT BE LESS THAN 30'.

BOUNDARY SHOWN PER
RECORD OF SURVEY NO. 01307
DATE 5-4-94 FILE 70 PAGE 84
OFFICIAL RECORDS BOOK 940504

SITE CURB DATA TABLE

LINE	DIRECTION	DISTANCE
SL1*	N02°16'37"E	17.50'
SL2*	N87°43'23"W	1.48'
SL3	N02°16'37"E	30.00'
SL4*	N00°28'31"E	58.81'
SL5	N00°28'31"E	8.00'
SL6	N02°16'37"E	15.55'
SL7	N02°16'37"E	30.00'
SL8	N02°16'37"E	2.48'
SL10	N02°16'37"E	4.00'
SL11	N00°23'35"E	8.00'
SL13	N00°23'35"E	1.08'
SL14	N00°23'35"E	0.53'
SL15*	N87°43'23"W	153.00'
SL16	N87°43'23"W	158.71'
SL17	N87°43'23"W	7.33'
SL18	N02°16'37"E	16.00'
SL19	N00°27'28"E	15.77'
SL20	N02°16'37"E	16.00'
SL21	N02°16'37"E	16.00'
SL22	N02°16'37"E	16.00'
SL23	N87°43'23"W	3.00'
SL24	N02°16'37"E	16.00'
SL25	N02°16'37"E	15.31'
SL26	N00°23'35"E	1.55'
SL27	N87°43'23"W	63.00'
SL28	N87°43'23"W	3.00'
SL29	N87°43'23"W	81.00'
SL30	N87°43'23"W	117.00'
SL31*	N02°16'37"E	104.00'
SL32	N89°36'25"W	15.00'
SL33	N00°23'35"E	1.98'
SL34	N00°23'35"E	5.80'
SL35	N89°36'25"W	16.00'
SL36	N00°23'35"E	0.03'
SL37	N00°23'35"E	6.11'
SL38	N87°43'23"W	24.11'
SL39	N89°36'25"W	15.00'
SL40	N89°36'25"W	15.00'
SL41	N00°23'35"E	3.00'
SL42	N00°23'35"E	1.58'
SL43	N00°23'35"E	135.00'
SL44	N89°36'25"W	19.46'
SL45	N02°16'37"E	16.21'
SL46	N00°23'35"E	0.48'
SL47	N00°23'35"E	117.00'
SL48	N87°43'23"W	32.02'
SL49	N87°43'23"W	126.00'
SL50	N87°43'23"W	32.02'
SL51	N89°36'25"W	32.00'
SL52	N87°43'23"W	32.02'
SL53	N89°36'25"W	13.00'
SL54	N89°36'25"W	32.00'
SL55	N89°36'25"W	12.00'

* 6" L' TYPE CURB

PLAN QUANTITIES

SURFACE IMPROVEMENTS ON-SITES

4" CONCRETE PAVING	60,985 SF
6" L' TYPE CURB	342 LF
6" CURB	1,666 LF
5' WIDE, SIDEWALK	2,750 SF

ABBREVIATIONS

FG	FINISH GRADE
TBC	TOP BACK OF CURB
GB	GRADE BREAK
LP/HP	LOW/HIGH POINT
TW	TOP OF WALL
TF	TOP OF FOOTING
BBF	BOTTOM BLDG FOOTING
BWF	BOTTOM FLOOR WALL FOOTING
FG	FG @ BUILDING
FW	FG @ WALL
FF	FINISH FLOOR
FL	FLOW LINE
NG	NATURAL GROUND
(TF)	EXIST TOP OF FOOTING
(TW)	EXIST TOP OF WALL
SWR	SEWER
WTR	WATER
SDR	STORM DRAIN
C.O.	CLEANOUT

LEGEND

FINISH GROUND ELEV	
EXIST FINISH GROUND	
FLOW LINE ELEV	
EXIST FLOW LINE	
TOP BACK OF CURB	
EXIST TOP BACK OF CURB	
NATURAL GROUND	
FINISH GROUND	
CONTOUR 1' INTERVAL	
FINISH GROUND	
CONTOUR 5' INTERVAL	
EXIST GROUND	
CONTOUR 1' INTERVAL	
EXIST GROUND	
CONTOUR 5' INTERVAL	
FINISH FLOOR ELEV	FF 10.2
RATE OF SLOPE	1%
DIRECTION OF DRAINAGE	
L' TYPE CURB & GUTTER	
6" CURB	
EXIST CURB	
STORM DRAIN	
EXIST STORM DRAIN	

SITE CURB CURVE DATA TABLE

CURVE	RADIUS	LENGTH	TANGENT	DELTA
SC1*	1.50'	2.36'	1.50'	90°00'00"
SC2	15.00'	16.07'	8.90'	61°22'16"
SC3	3.00'	4.18'	1.80'	116°41'58"
SC4*	3.00'	5.12'	3.44'	97°50'15"
SC5	15.00'	15.52'	7.80'	64°18'41"
SC6	3.00'	4.05'	1.80'	115°24'14"
SC7	100.00'	4.13'	2.07'	02°22'02"
SC9	15.00'	15.47'	8.50'	54°06'58"
SC10	3.00'	4.10'	2.40'	110°02'38"
SC11	15.00'	16.81'	9.41'	64°11'29"
SC12	3.00'	4.11'	2.31'	117°41'55"
SC13	15.00'	19.45'	11.36'	74°17'51"
SC14	3.00'	5.53'	3.96'	105°42'09"
SC15	3.00'	4.81'	3.10'	91°53'02"
SC16	3.00'	4.71'	3.00'	90°00'00"
SC17	15.00'	23.56'	15.00'	90°00'00"
SC18	3.00'	4.61'	2.90'	88°06'58"
SC19	3.00'	4.71'	3.00'	90°00'00"
SC20	3.00'	4.71'	3.00'	90°00'00"
SC21	3.00'	5.14'	3.47'	98°14'12"
SC22	3.00'	4.71'	3.00'	90°00'00"
SC23	3.00'	4.71'	3.00'	90°00'00"
SC24	3.00'	4.71'	3.00'	90°00'00"
SC25	3.00'	4.81'	3.10'	91°53'02"
SC26	3.00'	4.71'	3.00'	90°00'00"
SC27	3.00'	4.71'	3.00'	90°00'00"
SC28	15.00'	18.46'	10.61'	70°31'44"
SC29	3.00'	5.73'	4.24'	109°28'16"
SC30	3.00'	4.71'	3.00'	90°00'00"
SC31	3.00'	4.71'	3.00'	90°00'00"
SC32	3.00'	4.61'	2.90'	88°06'58"
SC33	3.00'	4.71'	3.00'	90°00'00"
SC34	3.00'	4.71'	3.00'	90°00'00"
SC35	3.00'	4.71'	3.00'	90°00'00"
SC36	3.00'	4.71'	3.00'	90°00'00"
SC37	3.00'	4.61'	3.10'	91°53'02"
SC38	3.00'	4.71'	3.00'	90°00'00"
SC39	3.00'	4.81'	3.10'	91°53'02"
SC40	3.00'	4.61'	2.90'	88°06'58"
SC41	3.00'	4.71'	3.00'	90°00'00"

* 6" L' TYPE CURB



SITE PLAN

LONE MOUNTAIN KINGDOM HALL


SHEET 3
OF 6

CORNERSTONE SOLUTIONS
ENGINEERING BY DESIGN

JOB NUMBER: 109-00
DATE: 8-28-96
APPROVAL DATE:
FILENAME: 109-SIT.DWG
XREF FILES: 109-MST.DWG
XREF FILES:

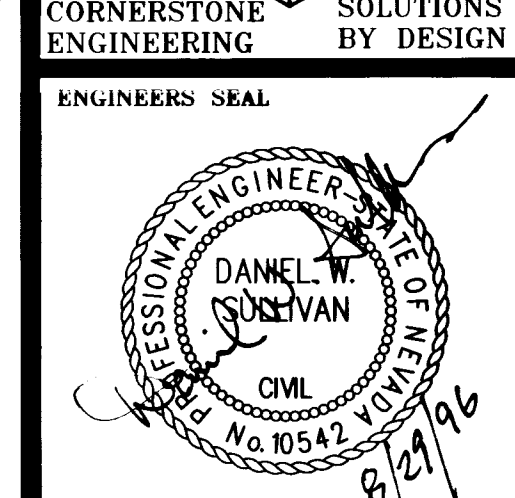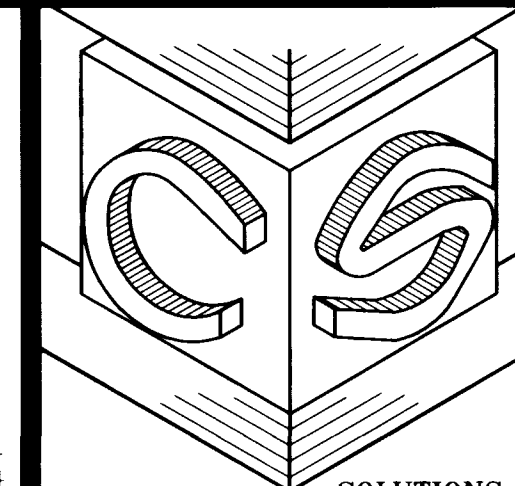

Cornerstone Engineering
3690 SOUTH EASTERN AVE, S 213
LAS VEGAS, NV 89109
(702)731-4711 FAX(702)737-7599

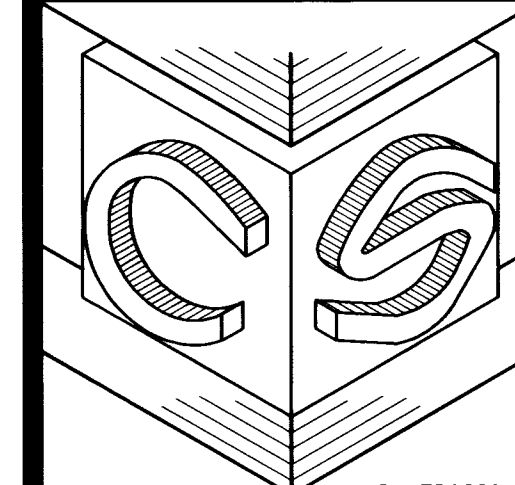

NO.	DATE	BY	REVISION
1	10/1/88	J. L. HARRIS	PRELIMINARY DESIGN
2	10/1/88	J. L. HARRIS	DESIGN & CONSTRUCTION
3	10/1/88	J. L. HARRIS	FINAL DESIGN REVIEW

UNDEVELOPED
APR 1988-04-04-000

APR 1988-04-04-000
UNDEVELOPED

APR 1988-04-04-000
UNDEVELOPED

UNDEVELOPED

BOUNDARY CURVE DATA TABLE

STATION	CHORD BEARING	CHORD DISTANCE	CHORD BEARING	CHORD DISTANCE	CHORD BEARING	CHORD DISTANCE
1	N 0° 0' 0" E	100.00	S 0° 0' 0" E	100.00	N 0° 0' 0" E	100.00

LEGAL DESCRIPTION

NE 1/4 OF THE SE 1/4 OF THE NE 1/4 OF THE NW 1/4
SECTION 4, TOWNSHIP 26 NORTH,
RANGE 80 EAST, 8 DIA.

SETBACK REQUIREMENTS

MIN. 10' ON 300' OF LOT WIDTH, MIN. 10' ON 100' OF LOT WIDTH, MIN. 10' ON 50' OF LOT WIDTH, MIN. 10' ON 25' OF LOT WIDTH

SITE CURVE DATA TABLE

STATION	CHORD BEARING	CHORD DISTANCE	CHORD BEARING	CHORD DISTANCE	CHORD BEARING	CHORD DISTANCE
1	N 0° 0' 0" E	100.00	S 0° 0' 0" E	100.00	N 0° 0' 0" E	100.00

SITE CURVE DATA TABLE

STATION	CHORD BEARING	CHORD DISTANCE	CHORD BEARING	CHORD DISTANCE	CHORD BEARING	CHORD DISTANCE
1	N 0° 0' 0" E	100.00	S 0° 0' 0" E	100.00	N 0° 0' 0" E	100.00

PLAN CHANGES

REVISIONS TO BE MADE

NO.	DATE	BY	REVISION
1	10/1/88	J. L. HARRIS	PRELIMINARY DESIGN

ABBREVIATIONS

SYMBOL	DESCRIPTION
1	100' 0" 0" E
2	100' 0" 0" E
3	100' 0" 0" E
4	100' 0" 0" E
5	100' 0" 0" E
6	100' 0" 0" E
7	100' 0" 0" E
8	100' 0" 0" E
9	100' 0" 0" E
10	100' 0" 0" E

SYMBOL	DESCRIPTION
1	100' 0" 0" E
2	100' 0" 0" E
3	100' 0" 0" E
4	100' 0" 0" E
5	100' 0" 0" E
6	100' 0" 0" E
7	100' 0" 0" E
8	100' 0" 0" E
9	100' 0" 0" E
10	100' 0" 0" E

SITE PLAN
LONE MOUNTAIN
KINGDOM HALL

NO.	DATE	BY	REVISION
1	10/1/88	J. L. HARRIS	PRELIMINARY DESIGN

SCALE
1" = 100'