



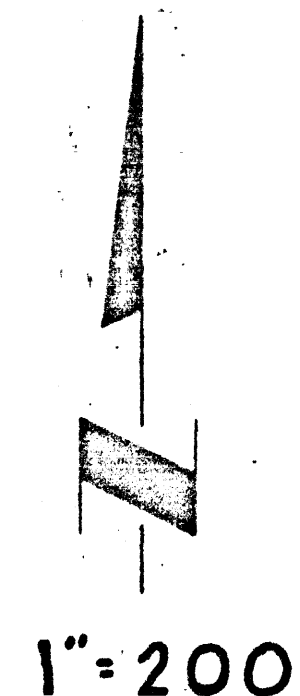

1"=200'

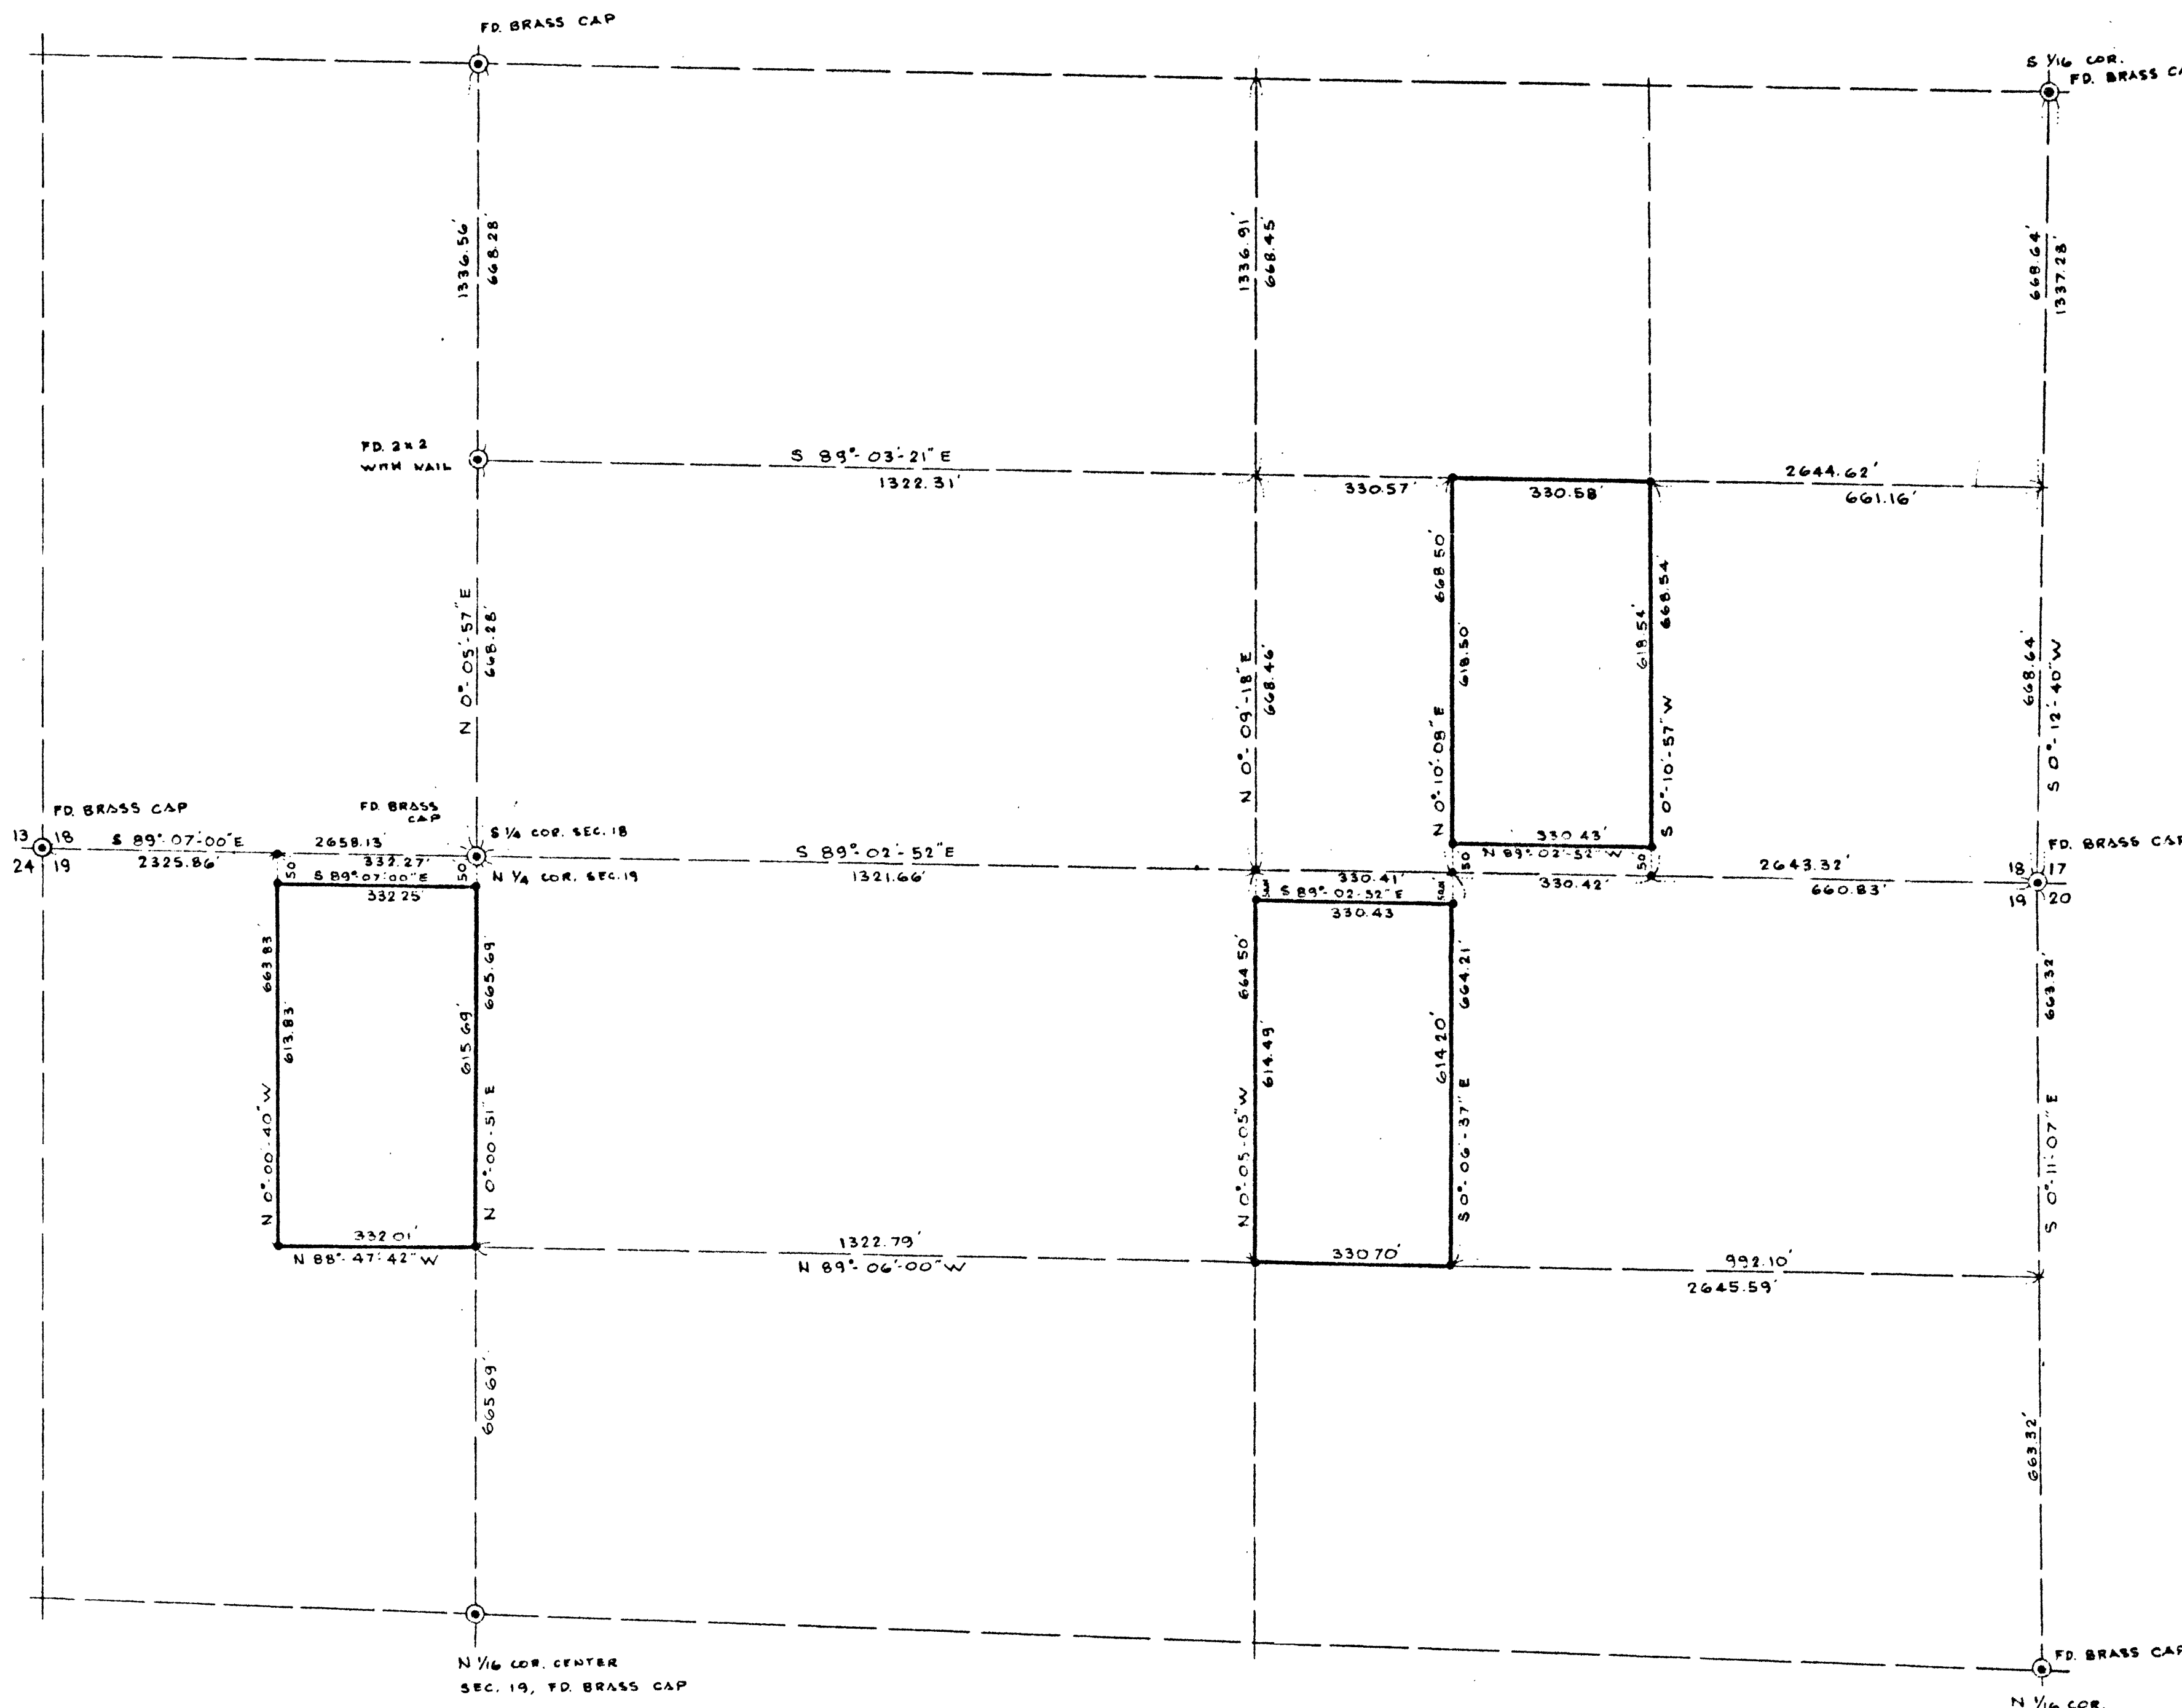

ENGINEER'S CERTIFICATE

I, JAY M. RASSLER, A REGISTERED PROFESSIONAL ENGINEER AND LAND SURVEYOR, DO HEREBY CERTIFY THAT THIS MAP, CONSISTING OF ONE SHEET, ACCURATELY DELINEATES THE RESULTS OF A SURVEY MADE BY ME AT THE INSTANCE OF JOHN WELLS AND WAS COMPLETED ON APRIL 24, 1973, THAT THE POINTS FOUND AND SET ARE CORRECTLY SHOWN HEREON AND THIS MAP DOES NOT CONSTITUTE A SUB-DIVISION UNDER NEVADA REVISED STATUTES.

Jay M. Rassler
JAY M. RASSLER, REGISTERED
CIVIL ENGINEER AND LAND
SURVEYOR NO. 1624

LEGEND

- ⊙ MONUMENT FOUND
- MONUMENT SET

LEGAL DESCRIPTIONS

THE E 1/2 OF THE SW 1/4 OF THE SE 1/4 OF THE SE 1/4 OF SEC. 18 AND THE W 1/2 OF THE NW 1/4 OF THE NE 1/4 OF THE NE 1/4 OF SEC. 19 AND THE E 1/2 OF THE NE 1/4 OF THE NE 1/4 OF THE NW 1/4 OF SEC. 19, T19S, R60E, M.D.B. & M. CLARK COUNTY, NEVADA.

BASIS OF BEARINGS

THE BEARING (S 89° 07' 00" E) OF THE WEST HALF OF THE SOUTH LINE OF SEC. 18, T19S, R60E, M.D.B. & M. AS SHOWN ON FILE 8, PAGE 83, OF RECORDS OF THE CLARK COUNTY RECORDER'S OFFICE.

NO. 301499
RECORDED AT THE REQUEST OF
JAY M. RASSLER
DATE 6-29-73 3:34 P.M.
FILE 26, PAGE 37
OF SURVEYS
OFFICIAL RECORDS BOOK NO. 342
CLARK COUNTY RECORDS
PAUL E. HORN, RECORDER
FEE 2.50 G.V. DEPUTY 5.

RECORD OF SURVEY
OF A PORTION OF SEC. 18 & 19
T 19 S, R 60 E, M.D.B. & M.
CLARK COUNTY, NEVADA
FOR:
JOHN WELLS