
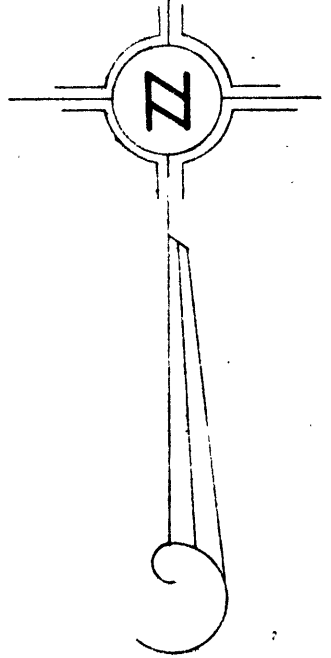


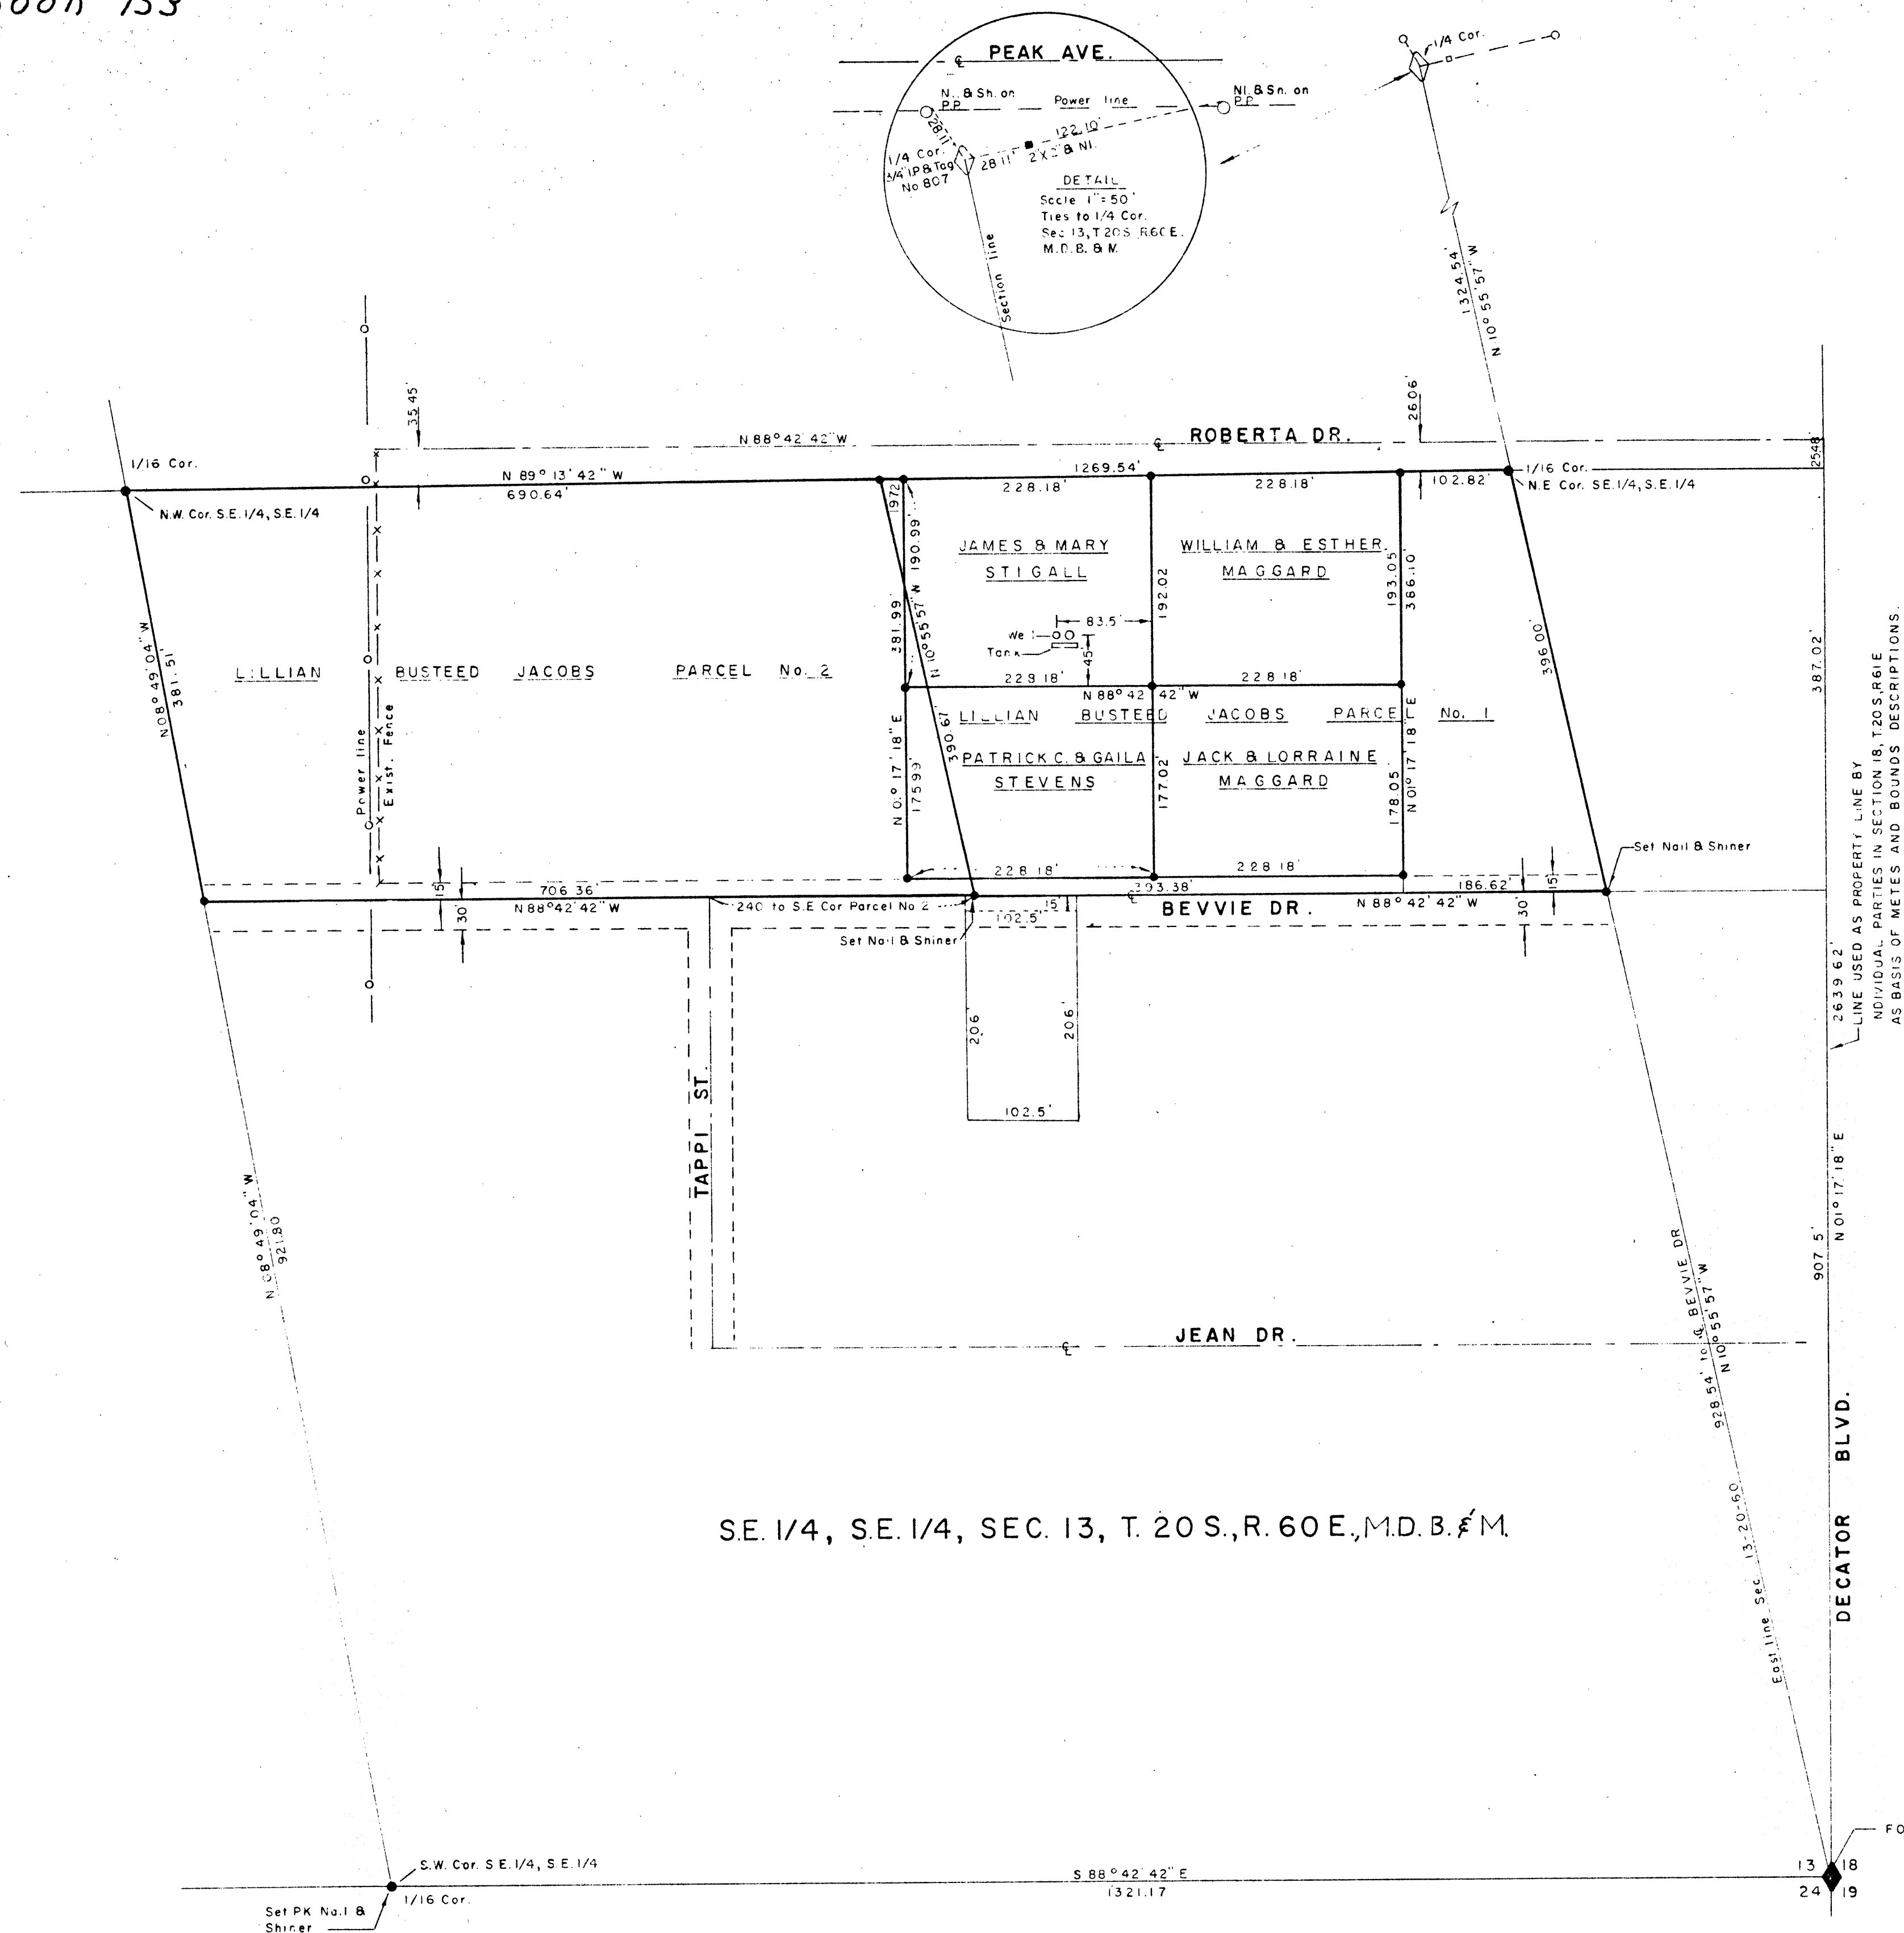

SCALE 1" = 100'

NOTE

BASIS OF BEARINGS: (S 88° 42' 42" E) SOUTH LINE OF SE 1/4, SEC. 13, T20 S, R. 60E. M.D.M. AS SHOWN BY MAP THEREOF IN FILE 2 PAGE 23 CLARK COUNTY RECORDS, NEVADA.

LEGEND

• INDICATES MONUMENTS FOUND & SET.

SURVEYOR'S CERTIFICATE

I, ROBERT H. CORDILL, A DULY REGISTERED LAND SURVEYOR, NEVADA No. 720, DO HEREBY CERTIFY THAT THIS MAP IS A TRUE AND CORRECT PLAT OF THE LAND SURVEYED BY ME OR UNDER MY DIRECT SUPERVISION AT THE INSTANCE OF LILLIAN BUSTEED JACOBS, AND DESCRIBED AS A POR. OF THE SE 1/4, SEC. 13, T. 20 S., R. 60 E. M.D.M. THIS SURVEY WAS COMPLETED THIS 24th DAY OF MAY, 1969, AND IS NOT INTENDED TO BE A SUBDIVISION.

Robert H. Cordill
ROBERT H. CORDILL — R.L.S. NEV No. 720.

NOTE:

The East line of Section 13 has been the subject of dispute. The section line as shown hereon is based upon evidence from many sources. The possession lines are in conflict with the actual section line. It is the opinion of this surveyor that the intent of past conveyances and consequently the intent of annexation is based upon possession as opposed to the true section line. This surveyor has no authority to render a judicial decision on the facts concerning the difference between the possessed line and the section line and cannot therefore assume liability for the correctness of the interpretation made hereon, until such time as a judicial decision is rendered in a court of law.

REFERENCE SURVEYS
REGISTERED PROFESSIONAL ENGINEER'S FILE
CLARK COUNTY, NEVADA, RECORDS

FILE 1, PAGE 3 FILE 1, PAGE 61
FILE 1, PAGE 37 FILE 1, PAGE 73
FILE 2, PAGE 23 FILE 5, PAGE 62
FILE 12, PAGE 87 FILE 15, PAGE 61

MAP FOR RECORD OF SURVEY
FOR
LILLIAN BUSTEED JACOBS
POR. SE. 1/4, SEC. 13, T. 20 S., R. 60 E.
M.D.B. & M.

No. 765269
RECORDED AT THE REQUEST OF
ROBERT H. CORDILL
Dated 6-2-69 at 12:06 P.M.
File 19 Page 28
OF SURVEYS
OFFICIAL RECORDS BOOK No. 953
CLARK COUNTY NEVADA RECORDS
PAUL E. HORN RECORDER
Fee \$2.50 — E.M. Deputy

FILE 19 PAGE 28

055-519