

**LEGEND**

⊛	FIRE HYDRANT
⊙	TELEPHONE MANHOLE
○	STREET LIGHT POLE
□	STREET LIGHT POLE BOX
⊞	DRAIN INLET
⊞	ELECTRIC VAULT
*	Power Pole


**PLANTING LEGEND**

SYMBOL	QTY	SPECIES NAME	COMMON NAME	SIZE	
□	32	Cercidium microphyllum	Little-leaf Palo Verde	24" Box	
⊙	43	Chilopsis linearis	Desert Willow	24" Box	
+	70	Fraxinus velutina 'Rio Grande'	Rio Grande Ash	24" Box	
⊙	61	Pinus halepensis	Aleppo Pine	5 Gal.	
+	46	Prosopis chilensis (Sid.)	Chilean Mesquite	24" Box	
⊙	49	Pinus carresifera 'Krauter Vesuvius'	Krauter Vesuvius Pin	24" Box	
⊙	21	Vitex agnus-castus	Chesta Tree	24" Box	
⊙	77	Baccharis 'Centennial'	Centennial Broom	5 Gal.	
⊙	31	Fouquieria splendens	Occotillo	5'-6"	
⊙	61	Hesperaloe parviflora	Red Yucca	5 Gal.	
⊙	142	Leucophyllum frutescens 'Green Cloud'	Green Cloud Texas Ranger	5 Gal.	
⊙	30	Muhlenbergia rigens	Deer Grass	5 Gal.	
⊙	141	Oenothera bielandieri	Mexican Evening Primrose	1 Gal.	
⊙	76	Pennisetum setaceum 'Cuprum'	Ruby Red Fountain Grass	5 Gal.	
⊙	11	Salvia greggii 'Red Star'	Red Autumn Sage	5 Gal.	
⊙	120	Pink Coral Granite Boulders		See Spcch.	
⊙	123	River Rock • 6" Depth in Areas Indicated		1'-3"	
⊙	124	River Rock • 9" Depth in Areas Indicated		3'-6"	
⊙	125	Pink Coral Decomposed Granite		1/2" Minus	
⊙	126	Pink Coral Decomposed Granite		• 2" Depth in Areas Indicated	

NOTE: Plant Quantities Are For Convenience Only. Please Verify.

NOTE: Compact Subgrade To 85% And Apply A Preemergent Herbicide To The Soil Before Placing Granite At Required Depth. Rake Smooth, Wet To Entire Depth, Roll With A 150lb Roller, Then Lightly Scarify Surface With A Leaf Rake. Keep Top Of Granite 1" Below Adjacent Walks, Curbs Or Other Hard Surfaces.


Planting Plan  
Scale 1"=30'-0"

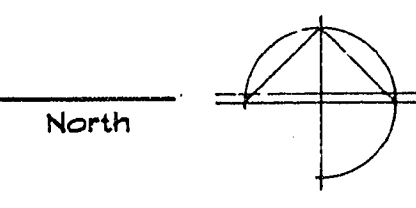

**REVISIONS**


REV	DESCRIPTION	DATE	BY

© DOMINGO CAMBEIRO CORPORATION 1994



DEPARTMENT OF PUBLIC WORKS  
ARCHITECTURAL SERVICES SECTION  
CITY ENGINEER DENNIS ANDERSON, P.E.

All designs, arrangements and plans indicated or presented by this drawing, as instruments of service, are owned by and the property of DOMINGO CAMBEIRO CORPORATION. The plans and/or specifications shall be restricted to the original site for which they were prepared and publication therefore is expressly limited to such use. Reproduction, publication or re-use by any method in whole or in part, is prohibited. None of such designs, arrangements or plans shall be used by or disclosed to any person, firm, agency, or corporation without the written permission of DOMINGO CAMBEIRO CORPORATION. Visual contact with these plans and specifications shall constitute prima facie evidence of acceptance of these restrictions.

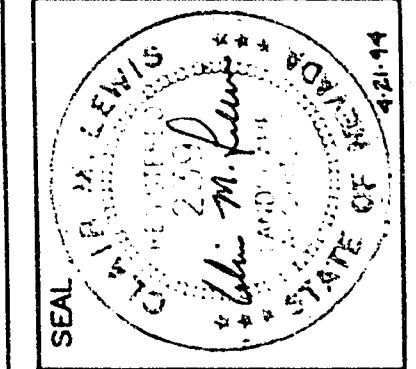


DRAWN BY	CML
CHECKED BY	CML
ISSUED DATE	FEBRUARY 1994

OPEN SPACE WEST  
PLANTING PLAN

LAS VEGAS TECHNOLOGY CENTER  
OPEN SPACES AND ENTRY FEATURES,  
PHASE II AND III

**Domingo Cambeiro Corporation**  
ARCHITECTURE • ENGINEERING • PLANNING • INTERIORS  
3555 PECOS-McLEOD IC. LAS VEGAS, NEVADA 89121-3805 (702) 732-0084

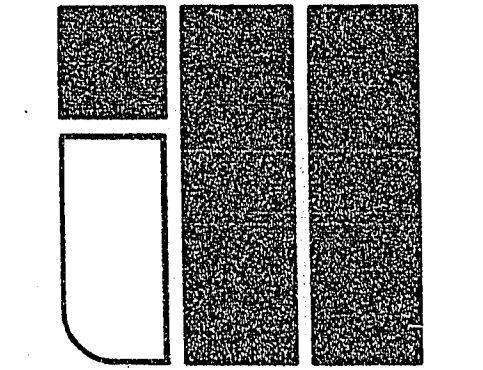

SHEET NO.  
**L1.02**

JOB NO. 93197  
FILE NO. 530-V1J

"As-Built"