




SITE PLAN (WEST)
SCALE: 1"=30'-0"

SEE NOTES ON AS1.01

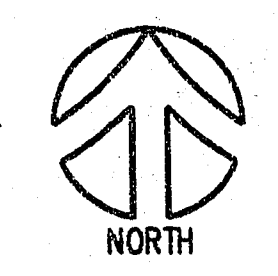

REVISIONS			
REV	DESCRIPTION	DATE	BY

© DOMINGO CAMBEIRO CORPORATION 1994

DO NOT SCALE DRAWINGS

All designs, arrangements and plans indicated or presented by this drawing, as instruments of service, are owned by and the property of DOMINGO CAMBEIRO CORPORATION. The plans and/or specifications shall be restricted to the original site for which they were prepared and publication therefore is expressly limited to such use. Reproduction, publication or re-use by any method in whole or in part, is prohibited. None of such designs, arrangements or plans shall be used by or disclosed to any person, firm, agency, or corporation without the written permission of DOMINGO CAMBEIRO CORPORATION. Visual contact with these plans and specifications shall constitute prima facie evidence of acceptance of these restrictions.

SEAL

DRAWN BY


CHECKED BY

ISSUED DATE
FEBRUARY 1994

ARCHITECTURAL
SITE PLAN
WEST

PROJECT
**LAS VEGAS TECHNOLOGY CENTER
OPEN SPACES AND ENTRY FEATURES,
PHASES II AND III**

Domingo Cambeiro Corporation
ARCHITECTURE • ENGINEERING • PLANNING • INTERIORS
LAS VEGAS, NEVADA 89121-3805 (702) 732-0084
3555 PECOS-MCLEOD IC.

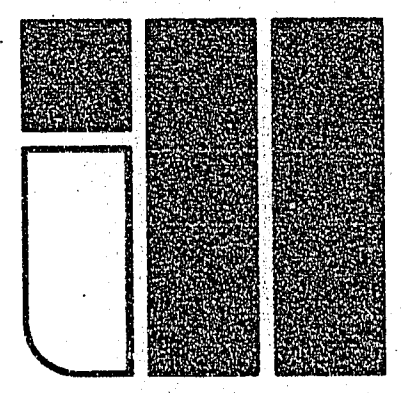

SHEET NO.

AS1.02

JOB NO. 93197
FILE NO. 9197AS02.DWG 530-V1J

"As-Built"