

Book 890630

LEWIS HOMES - RAINBOW VISTA NO. 10



00842

BEING A PORTION OF THE NORTH HALF (N1/2) OF SECTION 26,
TOWNSHIP 20 SOUTH, RANGE 60 EAST, M.D.M., CITY OF
LAS VEGAS, CLARK COUNTY, NEVADA

SURVEYORS CERTIFICATE

I, R. GUY DOTY, A PROFESSIONAL LAND SURVEYOR REGISTERED IN THE STATE OF NEVADA, DO HEREBY CERTIFY THAT THE MONUMENTS HAVE BEEN SET AND TIES ESTABLISHED AS SHOWN HEREON.

R. GUY DOTY
PROFESSIONAL LAND SURVEYOR
NEVADA CERTIFICATE NO. 7635

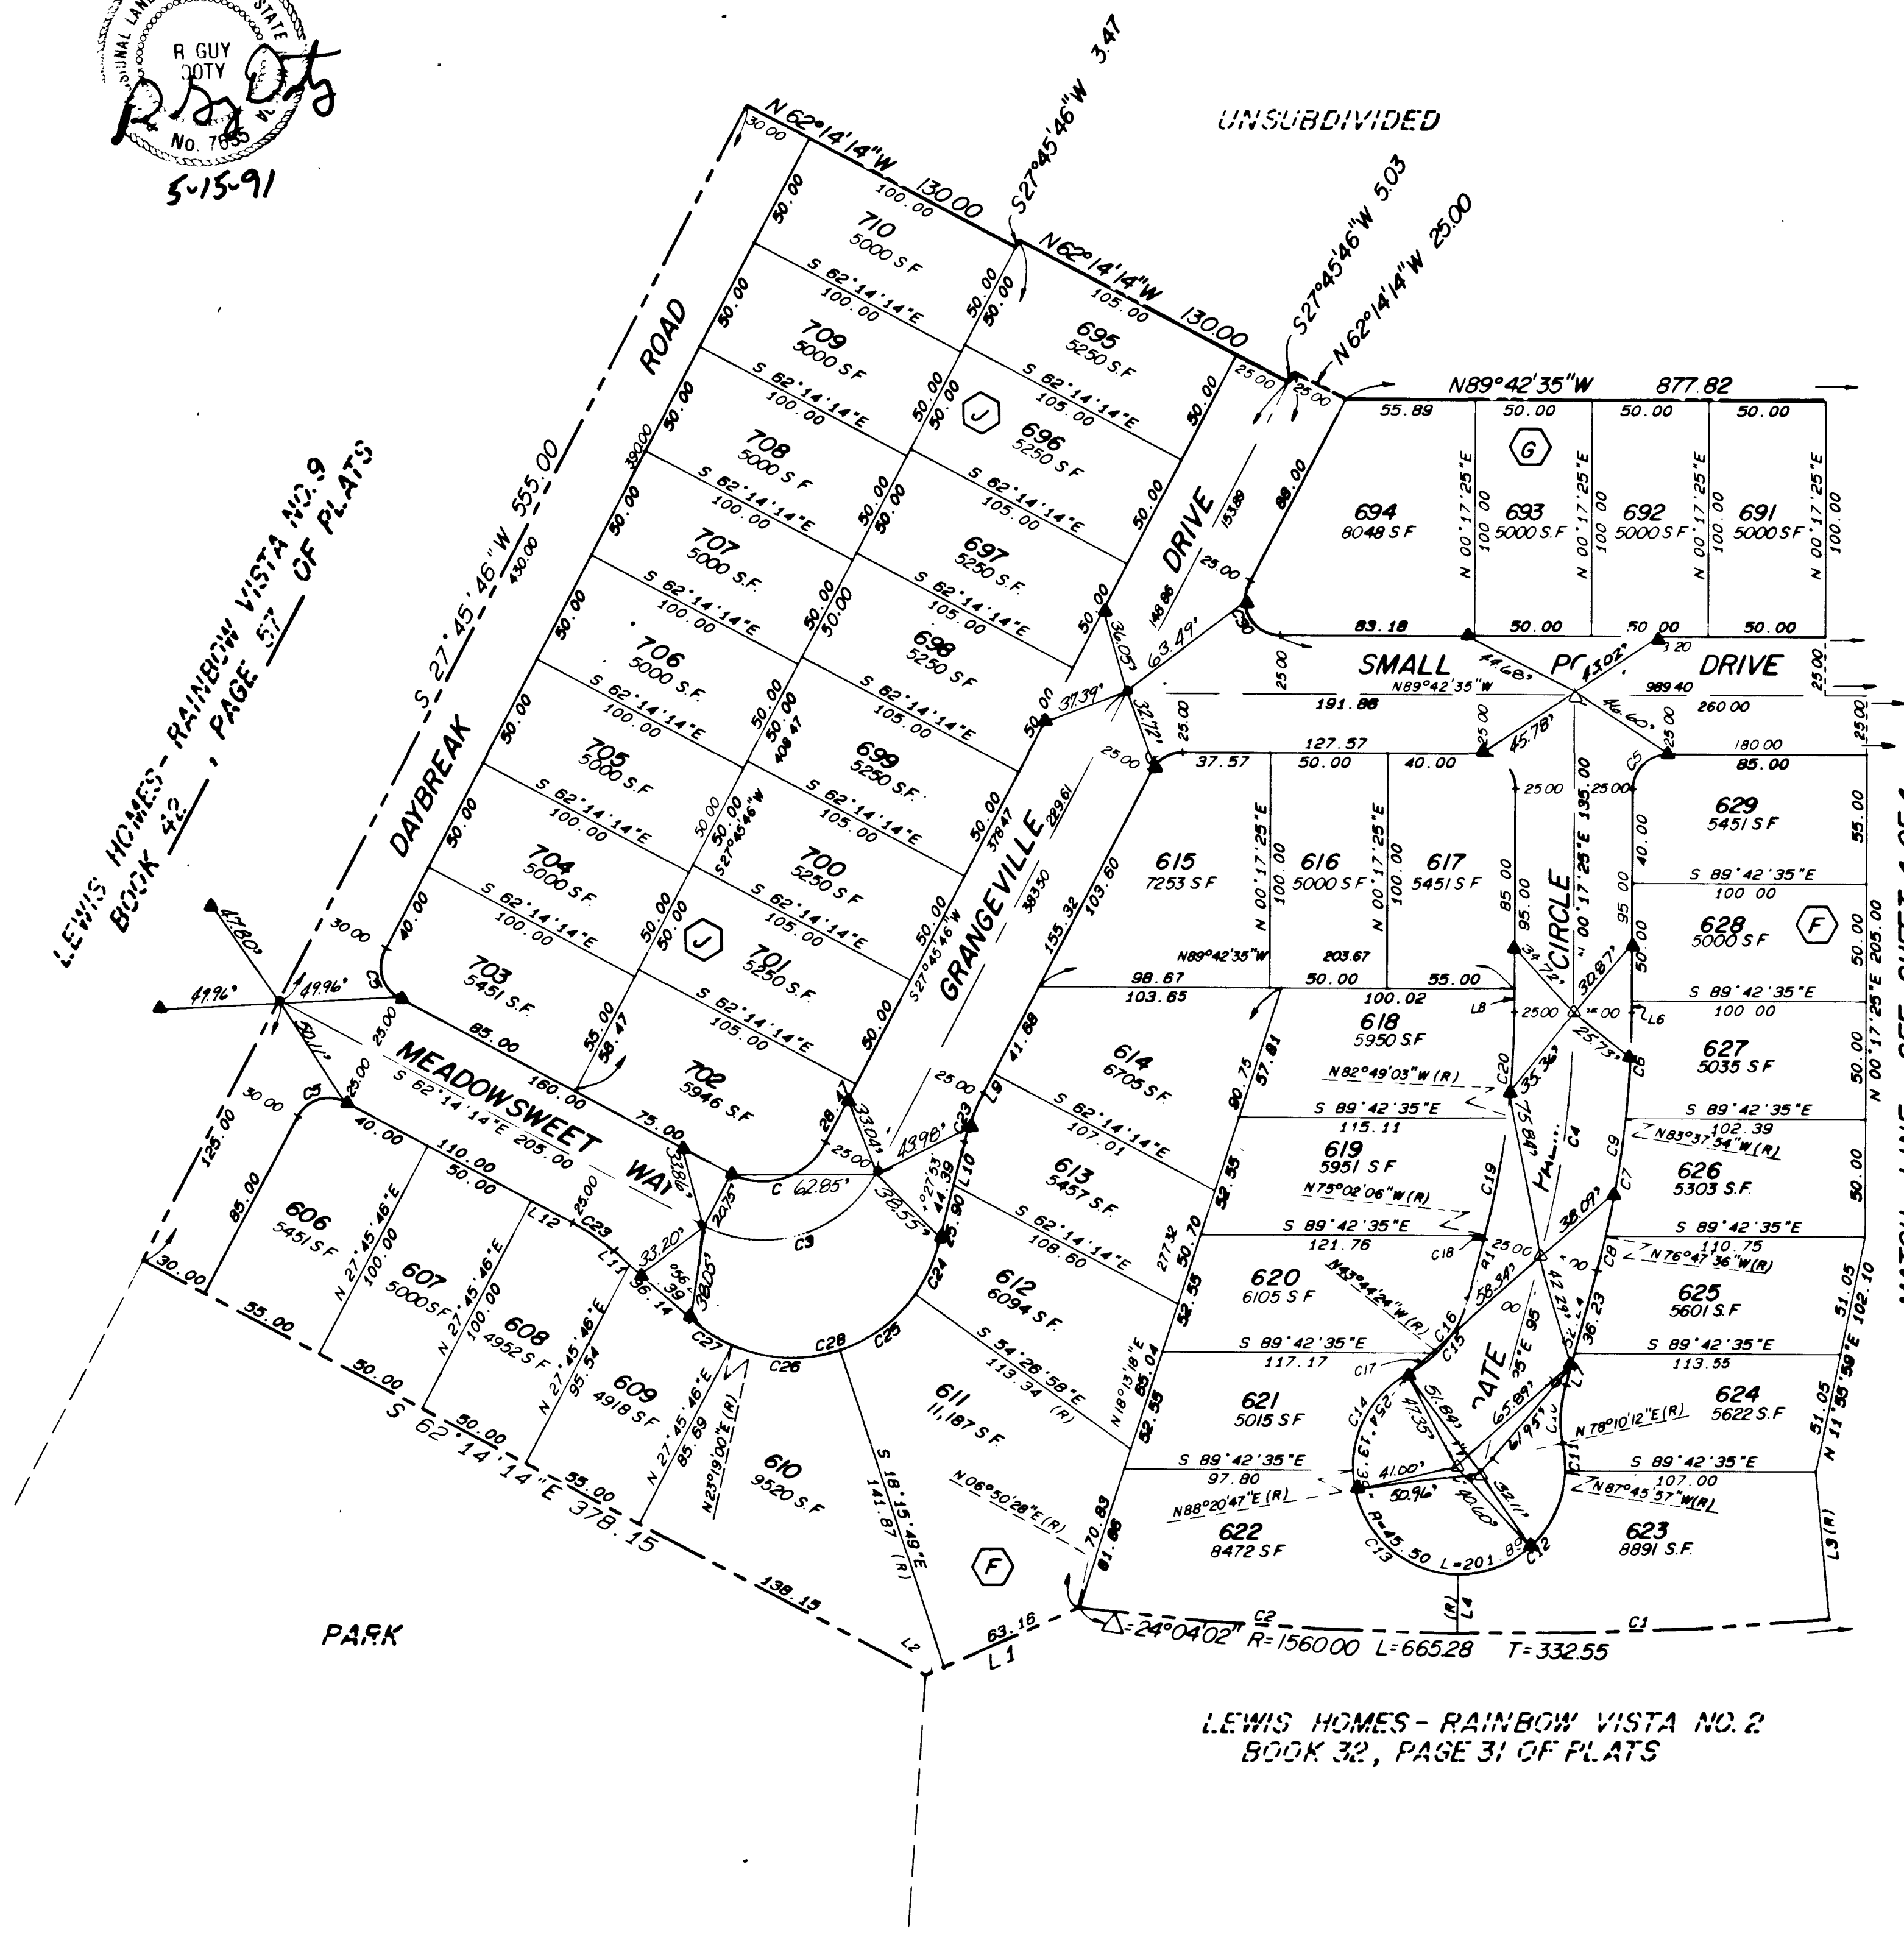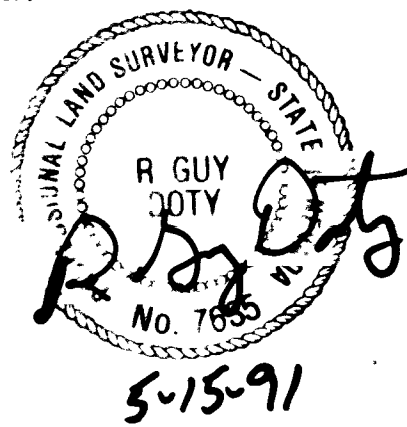

LINE	BEARING	DISTANCE	CURVE	DELTA	RADIUS	LENGTH	ANGENT
1	S 66°23'10"W	71.75	1	5°50'43"	1560.00	159.15	79.64
2	S 56°23'10"W	8.59	2	5°56'55"	1560.00	161.96	81.05
3	N 04°57'10"W	62.77	3	90°00'00"	50.00	86.39	55.00
4	N 00°53'33"E	25.00	4	15°00'00"	400.00	104.72	52.66
5	S 74°42'35"E	10.00	5	90°00'00"	15.00	23.56	15.00
6	N 00°17'25"E	5.00	6	6°04'41"	425.00	45.08	22.56
7	N 15°17'25"E	16.01	7	6°50'18"	425.00	50.72	25.39
8	S 00°17'25"W	10.00	8	2°05'01"	425.00	15.46	7.73
9	N 27°45'46"E	10.04	9	15°00'00"	425.00	111.26	55.95
10	N 14°27'53"E	19.49	10	27°07'13"	50.00	23.67	12.06
11	S 48°56'21"E	8.25	11	14°03'51"	45.50	11.17	5.61
12	S 62°14'14"E	20.00	12	88°39'30"	45.50	70.41	44.45
			13	87°27'14"	45.50	69.45	43.52
			14	64°03'04"	45.50	50.86	28.46
			15	47°06'26"	50.00	41.11	21.80
			16	30°58'11"	50.00	27.03	13.85
			17	16°08'15"	50.00	14.08	7.09
			18	0°19'31"	375.00	2.13	1.06
			19	7°46'57"	375.00	50.94	25.51
			20	6°53'32"	375.00	45.11	22.58
			21	15°00'00"	375.00	99.17	49.37
			22	62°31'39"	15.00	16.37	9.11
			23	13°17'53"	95.50	22.17	11.13
			24	21°05'09"	64.50	23.74	12.00
			25	36°11'09"	64.50	40.74	21.07
			26	41°34'49"	64.50	46.81	24.49
			27	17°44'39"	64.50	19.98	10.07
			28	116°35'46"	64.50	131.26	104.43
			29	90°00'00"	30.00	47.12	30.00
			30	117°28'21"	15.00	30.75	24.71

- LEGEND**
- △ SET 5/8" REBAR & ALCAP PLS 7635
 - 12 LOT NUMBER
 - ⬡ BLOCK NUMBER
 - C1 CURVE NUMBER
 - SUBDIVISION BOUNDARY
 - ⊙ MONUMENT FOUND AS SHOWN
 - FND 5/8" REBAR & AL CAP R L S 2050
 - ▲ SET 2" ALUMINUM REFERENCE MONUMENT IN TOP OF CURB PLS 7635

MINIMUM SETBACKS:
 FRONT 10'
 GARAGE DOOR 16'
 SIDE 5'
 SIDE ON CORNER 10'
 REAR 10'

Scale: 1"=50'

MONUMENT TIE MAP

SHEET 3 OF 4

2769

5-6-99

Book 890630 Page 2

058-2032-10

