

961016

01757

FINAL MAP OF MILAN - UNIT 3

BEING A SUBDIVISION OF A PORTION OF THE NORTH HALF (N 1/2) OF THE NORTHEAST QUARTER (NE 1/4) OF
SECTION 9, TOWNSHIP 20 SOUTH, RANGE 60 EAST, M.D.M., CITY OF LAS VEGAS, CLARK COUNTY, NEVADA

LEGEND

- SET 5/8" REBAR AND ALUM. CAP STAMPED PLS. 7755W/BRASS REFERENCE TIES IN TOP OF CURB (UNLESS OTHERWISE NOTED)
- ⊙ FOUND MONUMENTATION AS SHOWN AND DESCRIBED
- REFERENCE POINT
- 1 LOT NUMBER
TOTAL RESIDENTIAL LOTS = 63
- A BLOCK NUMBER
- ① CURVE NUMBER
- SUBDIVISION BOUNDARY LINE
- STREET CENTERLINE
- MATCH LINE
- ▲ SET 2" BRASS CAP IN SPOT IN TOP OF CURB PLS 7755
- △ FOUND BRASS CAP IN TOP OF CURB STAMPED W/PLS 8431 AND DISTANCE SHOWN


CURVE	DELTA	RADIUS	LENGTH	TANGENT
1	03°04'06"	300.00'	16.07'	8.03'
2	90°00'00"	15.00'	23.56'	15.00'
3	86°55'59"	15.00'	22.76'	14.22'
4	25°08'29"	25.00'	10.97'	5.57'
5	89°59'13"	25.00'	39.26'	24.99'
6	89°59'13"	50.50'	79.31'	50.49'

LINE	BEARING	DISTANCE
L1	N26°58'37"E	31.53'
L2	S61°13'49"W	31.53'

NOTE

FOR SIDE PROPERTY LINES SET CONCRETE NAIL AND BRASS TAG STAMPED PLS 9390 IN THE REAR WALL ON THE PROPERTY LINE PROJECTED. SET SAWCUT IN THE BACK OF CURB AT THE FRONT OF THE LOT ON THE PROPERTY LINE PROJECTED. SET 2"x2" HUB AND TACK AT LOT CORNERS WHERE THERE IS NO BLOCK WALL.

SCALE: 1" = 40'

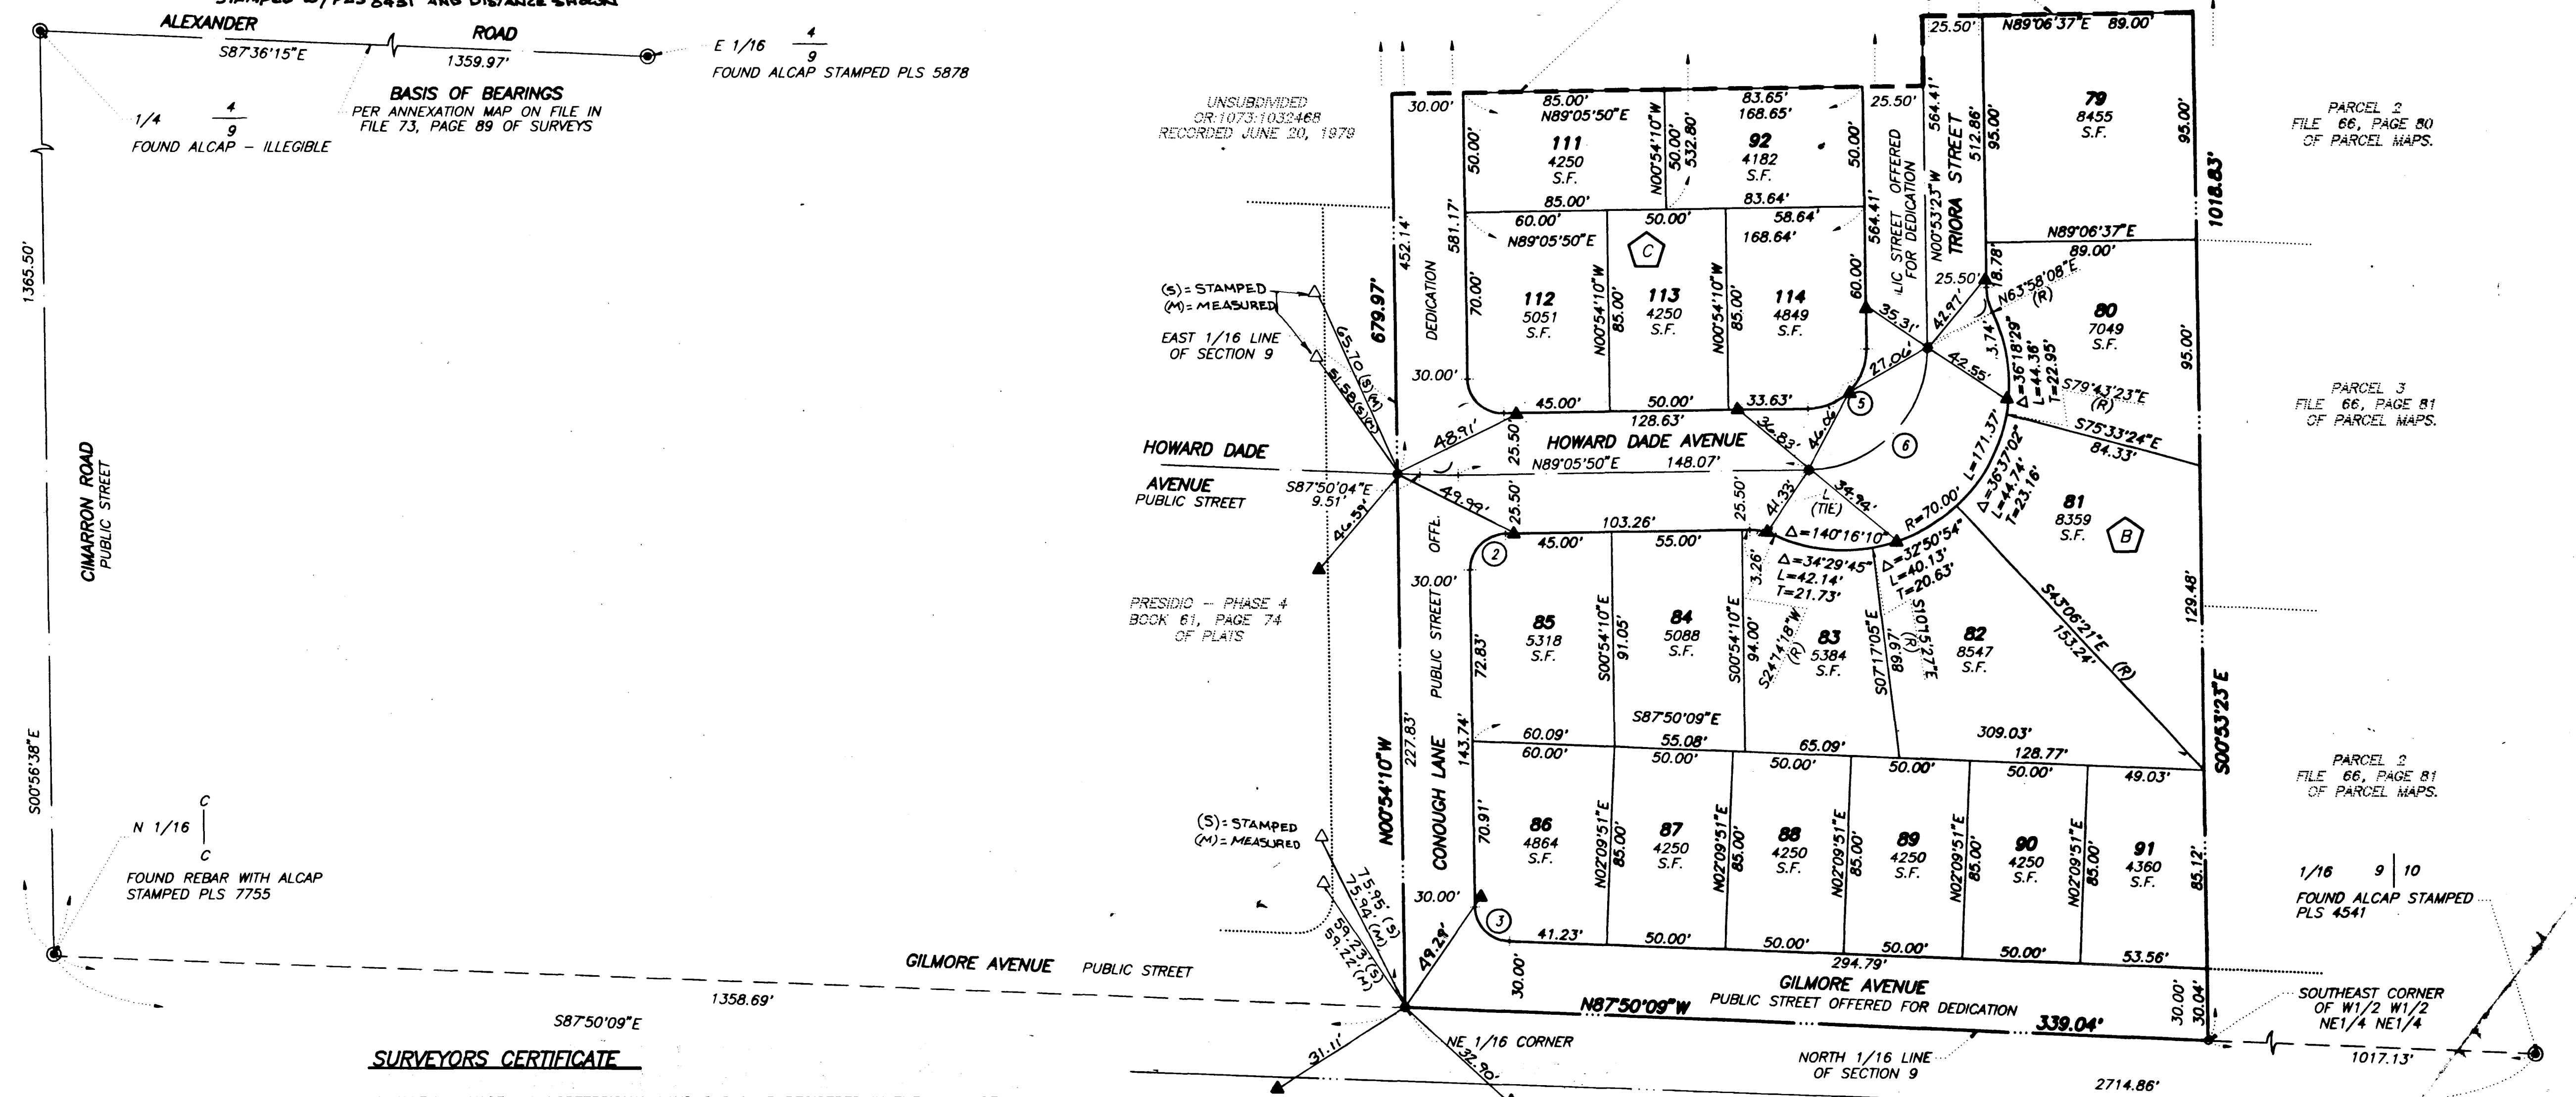

SURVEYORS CERTIFICATE

I, ALLEN L. HAGEN, A PROFESSIONAL LAND SURVEYOR REGISTERED IN THE STATE OF NEVADA, DO HEREBY CERTIFY THAT THE MONUMENTS HAVE BEEN SET AND PLACES ESTABLISHED AS SHOWN HEREON.

ALLEN L. HAGEN
PROFESSIONAL LAND SURVEYOR
NEVADA CERTIFICATE NO. 7755



MONUMENT TIE MAP

SHEET 4 OF 4

783.000C

9440

