


Job No. _____

FILE No. _____

REUSE OF DOCUMENTS

THIS DOCUMENT, AND THE IDEAS AND DESIGNS INCORPORATED HEREIN, AS AN INSTRUMENT OF PROFESSIONAL SERVICE, IS THE PROPERTY OF DRYER ENGINEERING, INC. AND IS NOT TO BE USED, IN THE WHOLE OR IN PART, FOR ANY OTHER PROJECT WITHOUT THE WRITTEN AUTHORIZATION OF DRYER ENGINEERING, INC.

	BUILDING NUMBER (TOTAL 46) BUILDING TYPE
_____	PROPERTY LINE
_____	STREET CENTERLINE
_____	BACK OF CURB
_____	EXISTING SANITARY SEWER

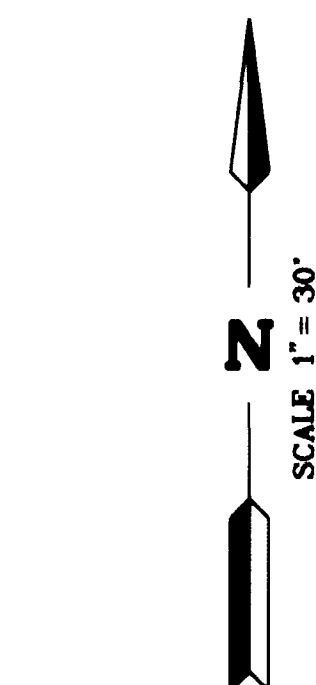


DYER ENGINEERING INC.
CIVIL ENGINEERS
LAND SURVEYORS
LAND USE PLANNING
(708) 254-2300
fax: (708) 254-2526
710 GRACE BLVD., SUITE E
LAS VEGAS, NEVADA 89128

OFFSITE SEWER AS-BUILT PLAN
MARIPOSA CONDOMINIUMS
RAINBOW BOULEVARD

JOB No. 98041
DATE: 03/25/99
VERT. SCALE:
HORIZ. SCALE: 1"=30'
DRAWN BY: NJ
CHECKED BY: TH
SHEET 1 OF 1


FILE NO. 307Y-4311

"A S BUILT

MARIPOSA CONDOMINIUMS OFF-SITE SEWER AS-BUILT

LEGEND

-  SEWER MANHOLE
-  PROPERTY LINE
-  STREET CENTERLINE
-  RIGHT OF WAY
-  EXISTING BUILDING FOOTPRINT

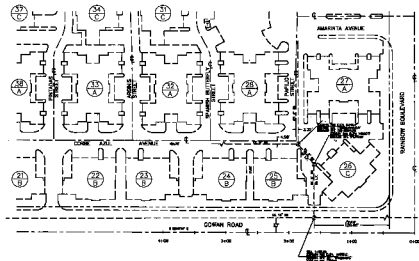

NOTE: SEWER PIPES ARE 18" DIA. AND
SHOWN AS DASHED LINES.

PROJECT: MARIPOSA CONDOMINIUMS
LOCATION: RAINBOW BOULEVARD
DATE: 10/1/88
DRAWN BY: J. L. BROWN
CHECKED BY: J. L. BROWN
APPROVED BY: J. L. BROWN