
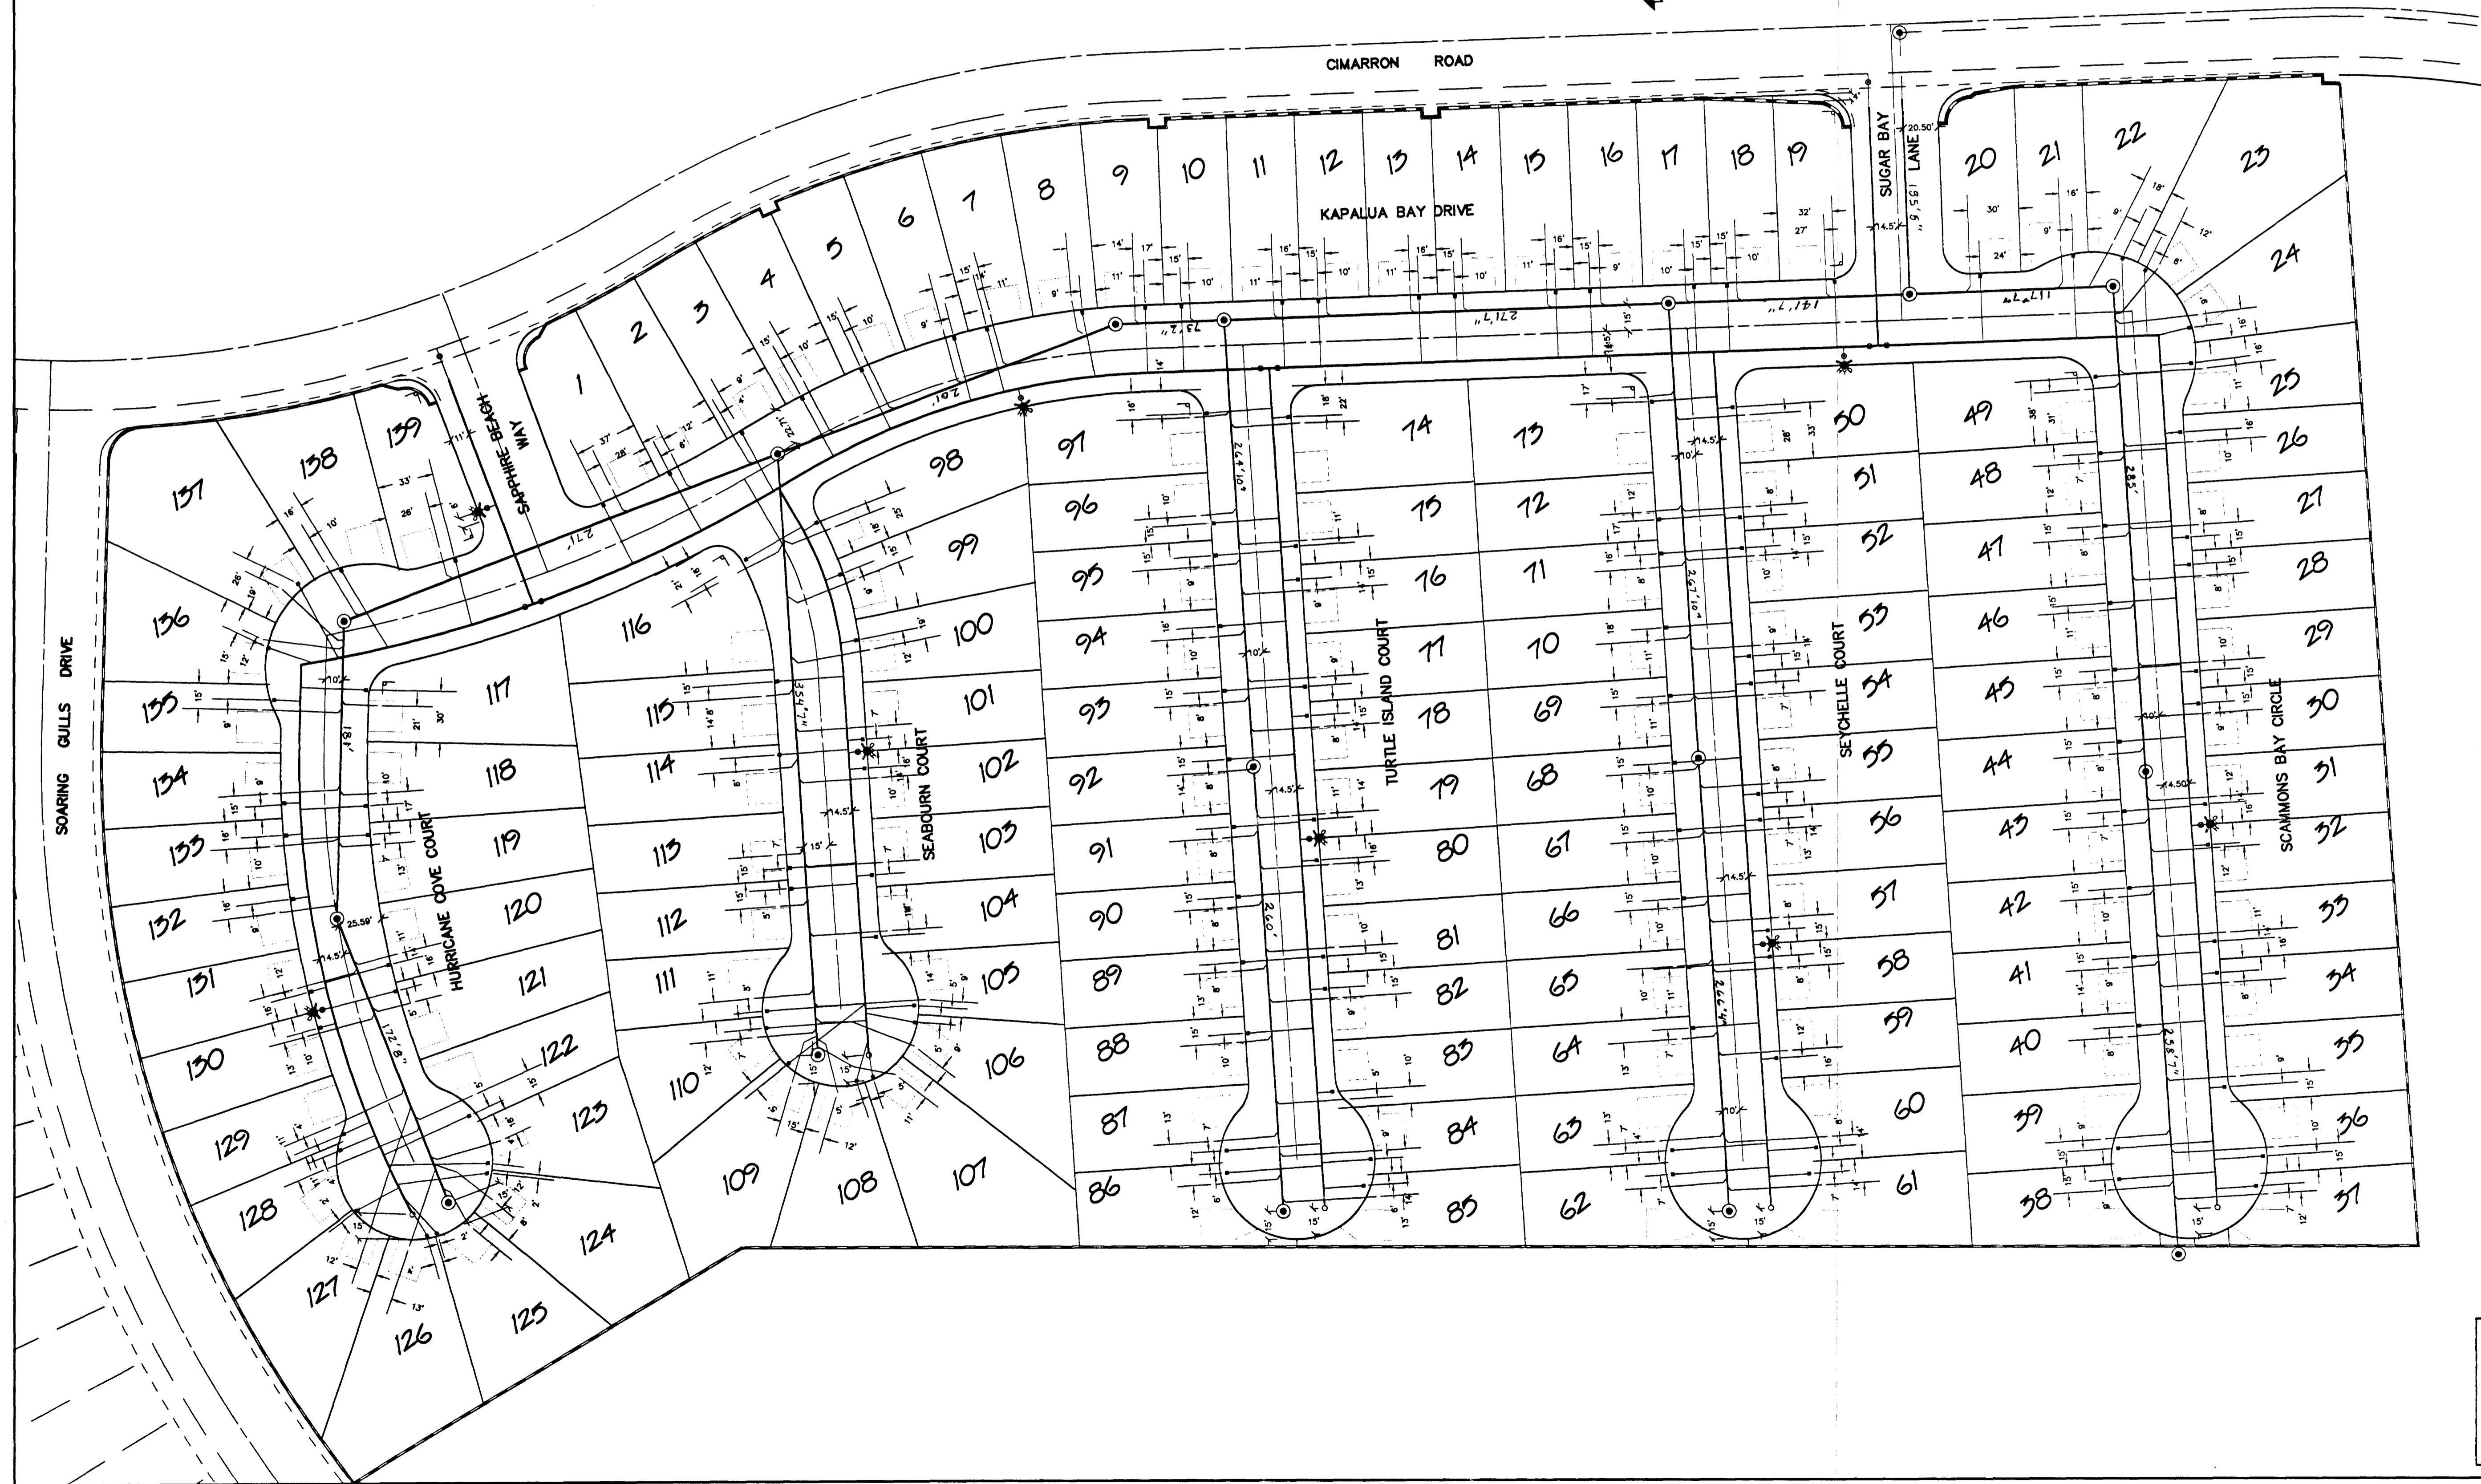


WATER & SEWER AS-BUILTS

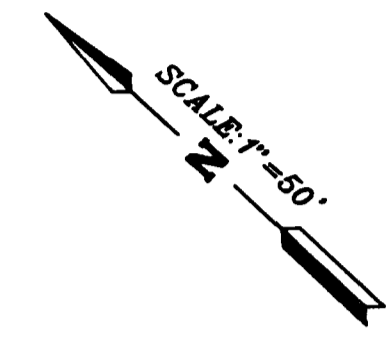

-937611A40111 Tue May 06 15:32:15 1997 Plotted by Mimie

4649

NOTICE!
EXISTING UTILITIES ARE SHOWN ON PLANS FOR THE CONVENIENCE OF THE CONTRACTOR ONLY. THE CONTRACTOR IS RESPONSIBLE FOR THE PROTECTION OF ALL UTILITIES. THE ENGINEER BEARS NO RESPONSIBILITY FOR UTILITIES NOT SHOWN OR SHOWN INCORRECTLY.

AND SETTING BACKGROUND UTILITIES TO CORRECT.

Call BEFORE YOU Dig
1-800-227-2900
UNDERGROUND SERVICE ORGANIZATION

RECEIVED
Mark J. White
6-15-97

<p>REVISION</p> <p>DATE</p> <p>BY</p> <p>APPROVED</p>	<p>SUBMITTED BY:</p> <p style="text-align: center;">ALPHA <i>Engineering</i> ENGINEERING COMPANY</p> <p style="font-size: small; text-align: right;">50 So. Jones #204, Los Angeles, CA 90027 Telephone: (213) 427-1900</p>
<p>WATER & SEWER AS-BUILTS</p> <p>NORTHSHORE PREMIER II</p>	
<p>TITLE</p> <p>PROJECT</p>	
<p>JOB # N3-76-11</p> <p>NAME VERT/NU</p> <p>DATE 4.29.97</p> <p>SCALE 1" = 50'</p>	
<p>PAGE</p> <p style="font-size: 2em;">1</p>	

307-4316

