


NO. NO.	4430
BY	JM, WJR
DATE	12/18/23
SCALE	HORIZ. 1" = 20'
VERT.	1" = 4'
SHEET	23
OF	25 SHEETS

PROJECT: NORTHSHORE PHASE 1A
 TITLE: SEWER AS-BUILTS SOARING GULLS DRIVE
 CLIENT: NORTHWEST PARTNERS CITY OF LAS VEGAS, NEVADA
 CONSULTING ENGINEERS: PLANNERS • LAND SURVEYORS
 2727 SOUTH RAINBOW BOULEVARD LAS VEGAS, NEVADA 89102-5148 PHONE (702) 873-7550 FAX (702) 362-2597

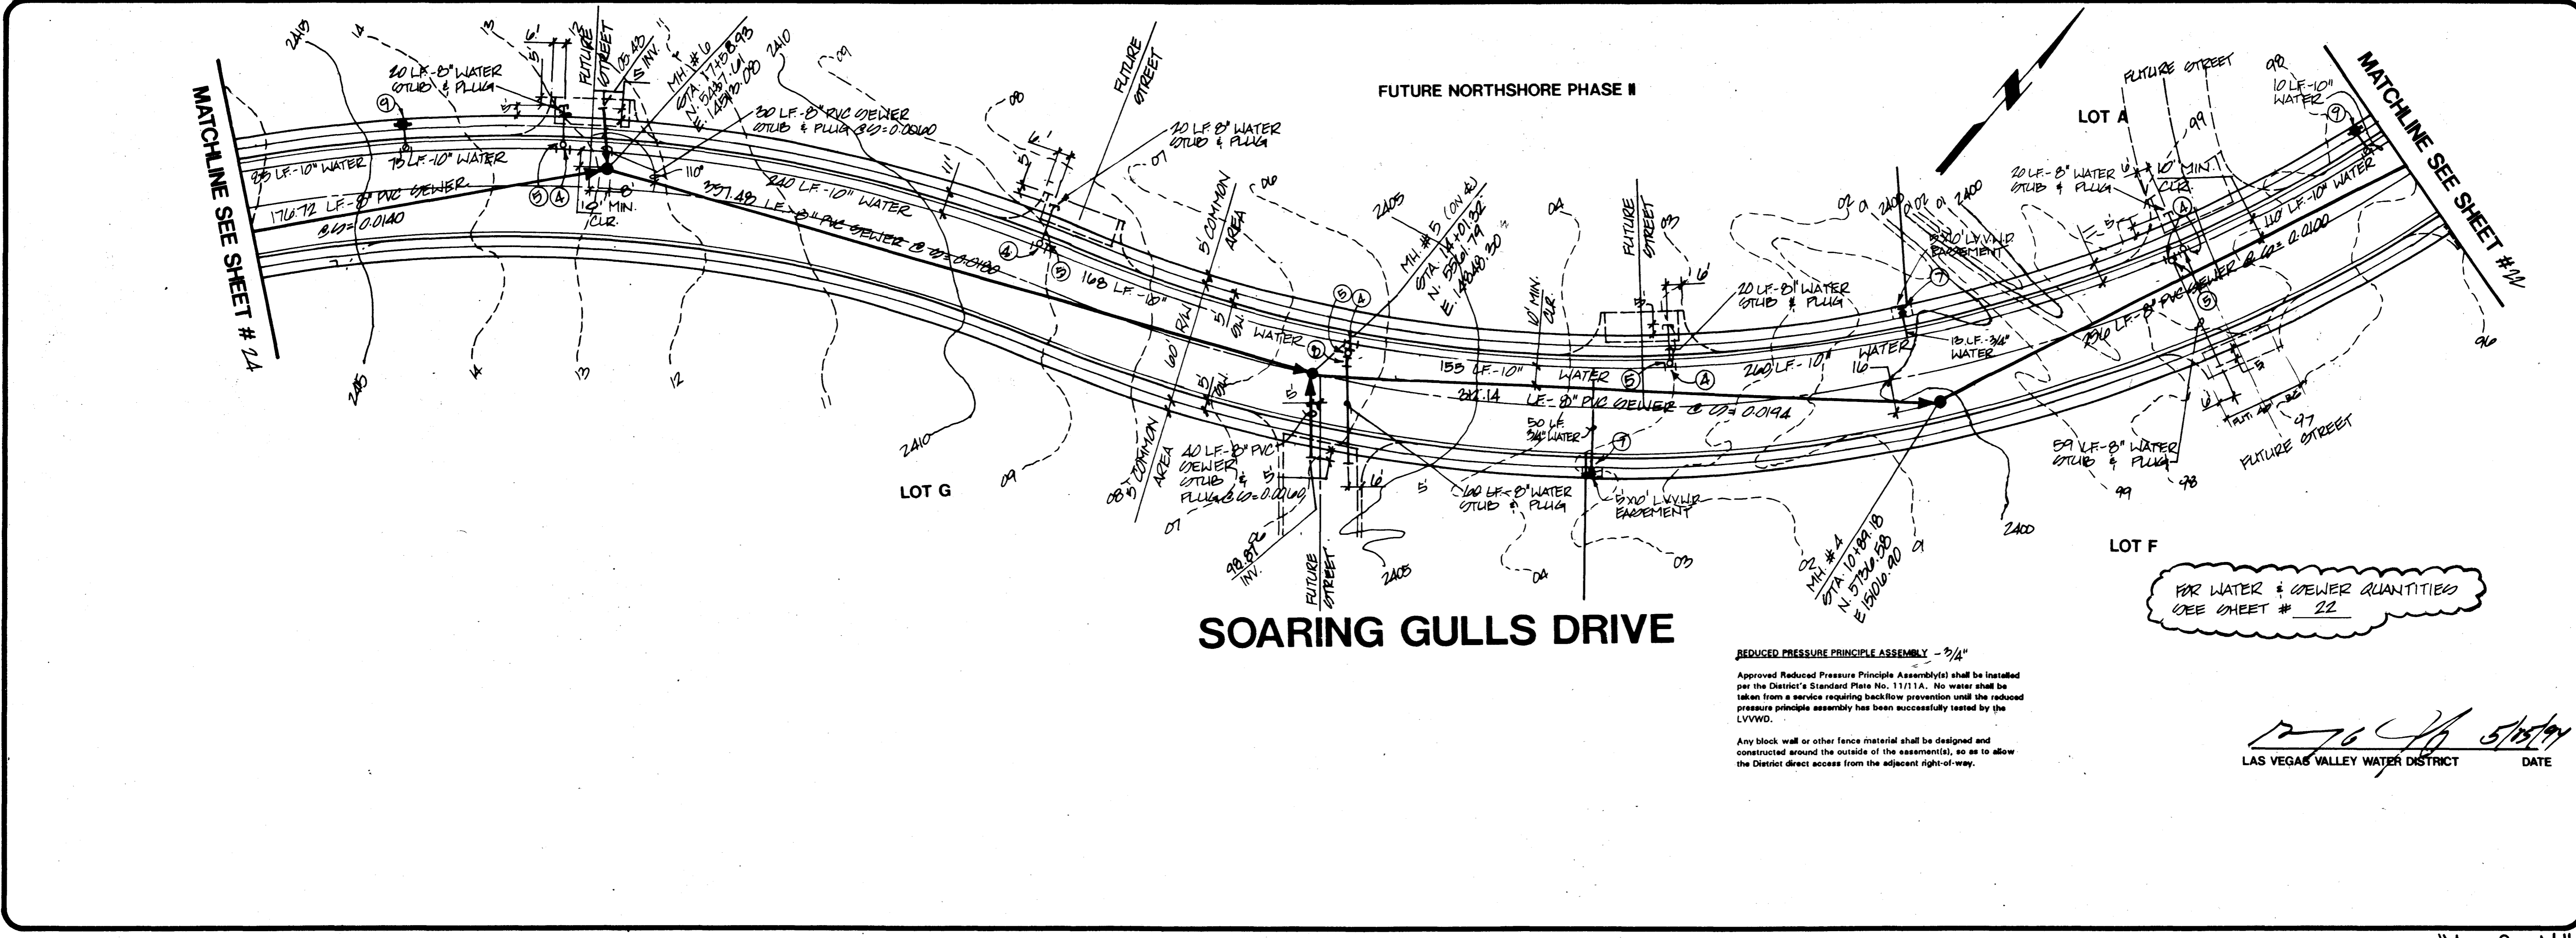

NO. NO.	4430
BY	JM, WJR
DATE	12/18/23
SCALE	HORIZ. 1" = 20'
VERT.	1" = 4'
SHEET	23
OF	25 SHEETS

PROJECT: NORTHSHORE PHASE 1A
 TITLE: SEWER AS-BUILTS SOARING GULLS DRIVE
 CLIENT: NORTHWEST PARTNERS CITY OF LAS VEGAS, NEVADA
 CONSULTING ENGINEERS: PLANNERS • LAND SURVEYORS
 2727 SOUTH RAINBOW BOULEVARD LAS VEGAS, NEVADA 89102-5148 PHONE (702) 873-7550 FAX (702) 362-2597

