

SEWER QUANTITIES (THIS CAT. ONLY)

STD MANHOLE	2 EA
8" SEWER MAIN	749 LF

**BENCHMARK**  
 CITY OF LAS VEGAS BENCHMARK  
 RIVET AND PLATE IN TOP OF CURB, SOUTHWEST -  
 RETURN OF CHEYENNE AVENUE AND RAMPART BLVD.  
 CIV. BM # 05007085  
 ELEVATION = 2448.335'

REVISIONS

REV	DATE	BY	REVISION
1	9/10/94	WLR	PER. PER. CL. COMMENTED

DATE: 9/10/94  
 BY: WLR  
 REVISION: PER. PER. CL. COMMENTED

NORTHWEST PARTNERS  
 CITY OF LAS VEGAS, NEVADA

CONSULTING ENGINEERS • PLANNERS • LAND SURVEYORS  
 2727 SOUTH RAINBOW BOULEVARD  
 LAS VEGAS, NEVADA 89102-5148 PHONE (702) 873-7550 FAX (702) 382-2597



vtm nevada

SEWER AS-BUILTS  
 CONOUGH LANE  
 NORTHSHORE  
 PHASE 1A

PROJECT

NO. 4420  
 BY: JTM, WLR  
 DATE: 12/19/93  
 SCALE: HORIZ. = 1"=20'  
 VERT. = 1"=4'

SHEET  
**25** OF 25 SHEETS

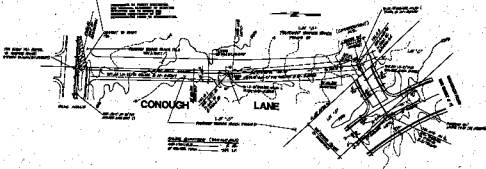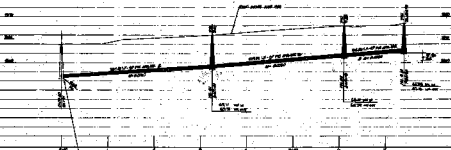

DRAWN BY: [Name]  
 CHECKED BY: [Name]  
 DATE: [Date]

VTI  
 VERTICAL CURVE DATA  
 COLLECTING ENGINEER'S RELEASE & LEGAL REPRESENTATION  
 USE THESE SEWER LAYOUTS ONLY WITH THE TYPED JOB SHEET

SEWER AS-BUILTS  
 CONOUGH LANE  
 NORTHSHORE  
 PANEL 1A

25  
 2017-2018-14